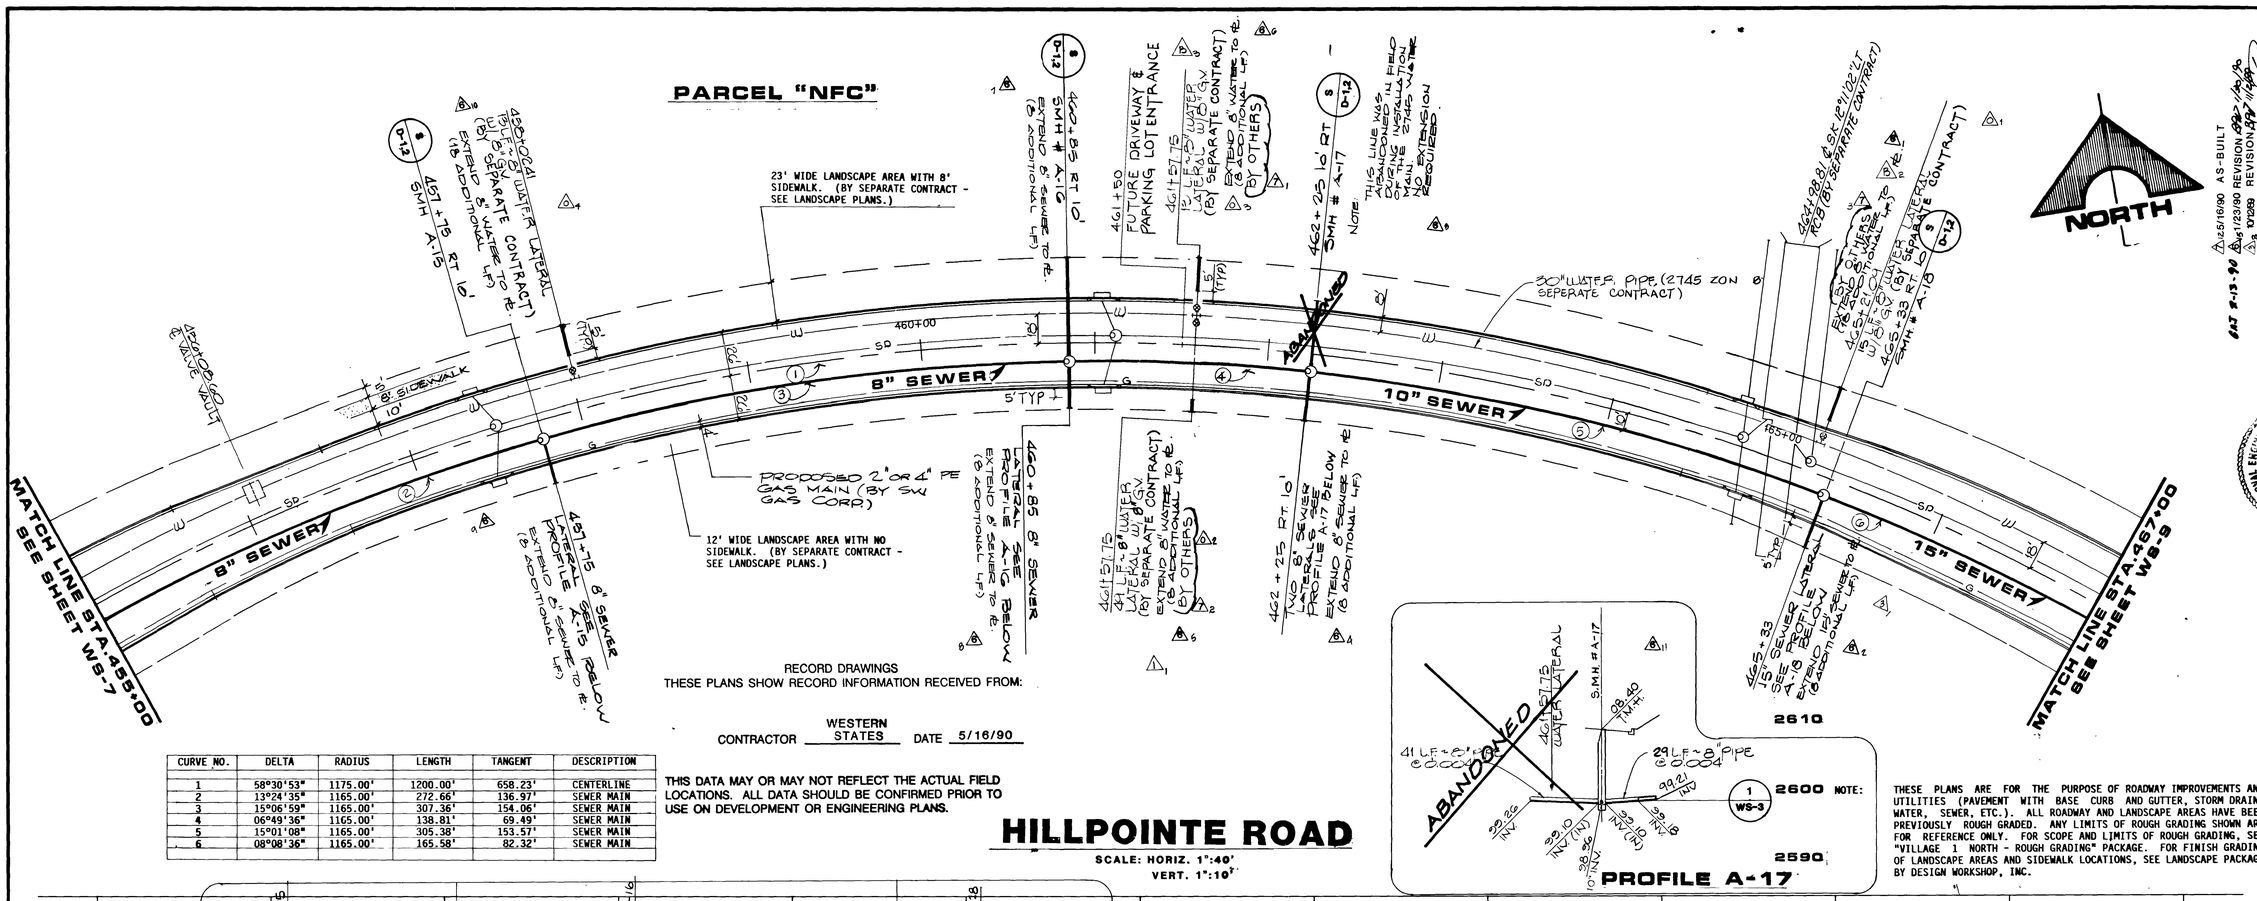

RECORD DRAWINGS
THESE PLANS SHOW RECORD INFORMATION RECEIVED FROM:

CONTRACTOR WESTERN STATES DATE 5/16/90

CURVE NO.	DELTA	RADIUS	LENGTH	TANGENT	DESCRIPTION
1	58°30'53"	1175.00'	1200.00'	658.23'	CENTERLINE
2	13°24'35"	1165.00'	272.66'	136.97'	SEWER MAIN
3	15°06'59"	1165.00'	307.36'	154.06'	SEWER MAIN
4	06°49'36"	1165.00'	138.81'	69.49'	SEWER MAIN
5	15°01'08"	1165.00'	305.38'	153.57'	SEWER MAIN
6	08°08'36"	1165.00'	165.58'	82.32'	SEWER MAIN

THIS DATA MAY OR MAY NOT REFLECT THE ACTUAL FIELD LOCATIONS. ALL DATA SHOULD BE CONFIRMED PRIOR TO USE ON DEVELOPMENT OR ENGINEERING PLANS.

HILLPOINTE ROAD

SCALE: HORIZ. 1":40'
VERT. 1":10'

THESE PLANS ARE FOR THE PURPOSE OF ROADWAY IMPROVEMENTS AND UTILITIES (PAVEMENT WITH BASE CURB AND GUTTER, STORM DRAIN, WATER, SEWER, ETC.). ALL ROADWAY AND LANDSCAPE AREAS HAVE BEEN PREVIOUSLY ROUGH GRADED. ANY LIMITS OF ROUGH GRADING SHOWN ARE FOR REFERENCE ONLY. FOR SCOPE AND LIMITS OF ROUGH GRADING, SEE "VILLAGE 1 NORTH - ROUGH GRADING" PACKAGE. FOR FINISH GRADING OF LANDSCAPE AREAS AND SIDEWALK LOCATIONS, SEE LANDSCAPE PACKAGE BY DESIGN WORKSHOP, INC.

REV	DATE	DESCRIPTION
A	6/22/88	ISSUE TO BID WATER/SEWER
3	7/3/89	ADDENDUM #2
2	7/20/89	ISSUE FOR CONSTRUCTION /
1	7/31/89	CHANGE ORDER #0

1 5/16/90 AS-BUILT
2 1/23/90 REVISION
3 12/2/89 REVISION
4 8/2/89 REVISIONS LVVWD

G.C. WALLACE, INC.
Engineering/Architecture
1555 SOUTH RAINBOW BLVD. / LAS VEGAS, NEVADA 89102

HOWARD HUGHES PROPERTIES
VILLAGE 1 NORTH
WATER AND SEWER PLAN & PROFILE
HILLPOINTE ROAD
STA. 455+00 TO 467+00

SHEET 11
WS-8
11 OF 24 SHEETS

LAS VEGAS VALLEY WATER DISTRICT — DATE 8-30-89

JOB NO. 620.314

8/84 DIETERICH-POST 6532B

307-V651

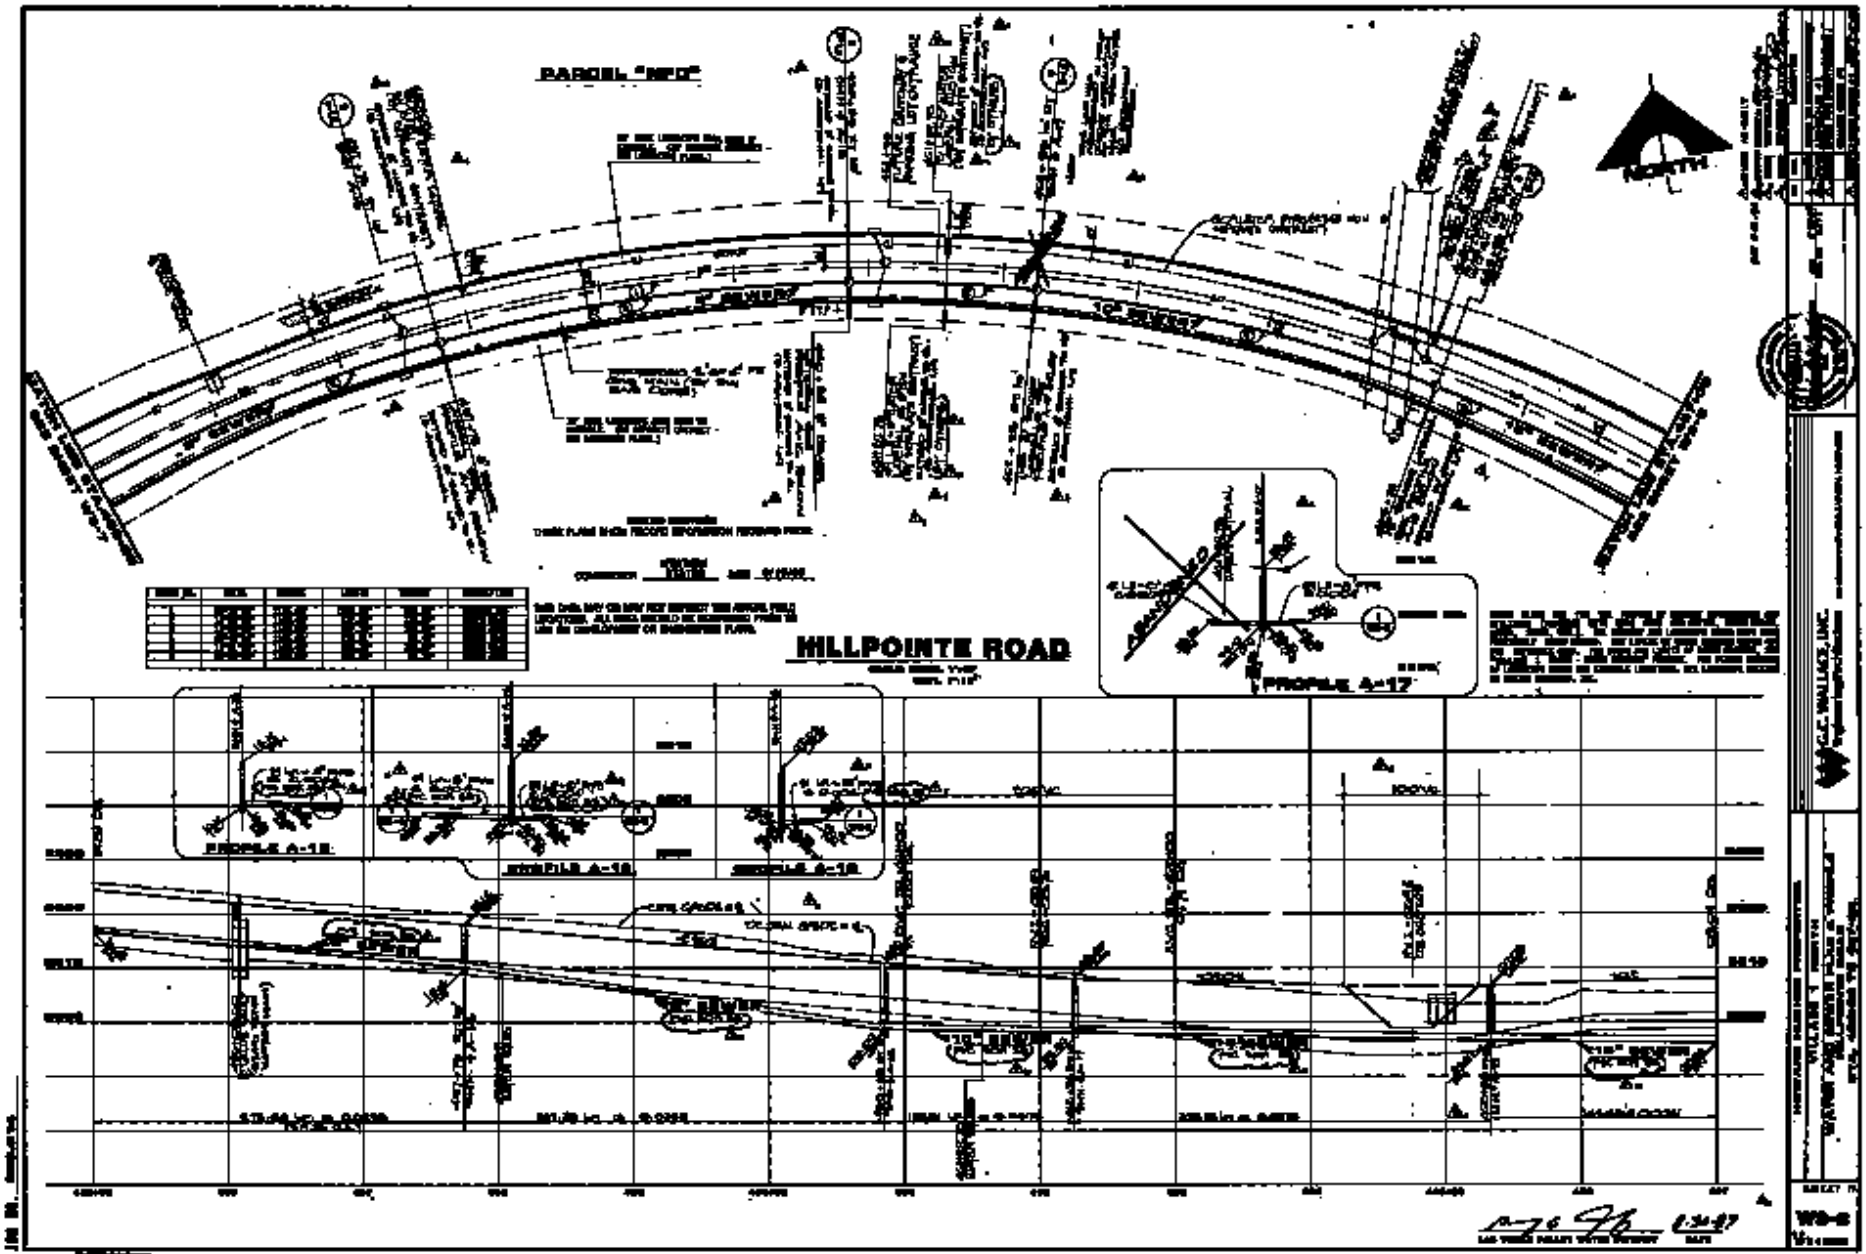
PARCEL "NFO"
HILLPOINTE ROAD
PROFILE A-17
PROFILE A-18
PROFILE A-19
PROFILE A-20
NORTH
C.C. WALLACE, INC.
WS-2