


1-30

SHEETS




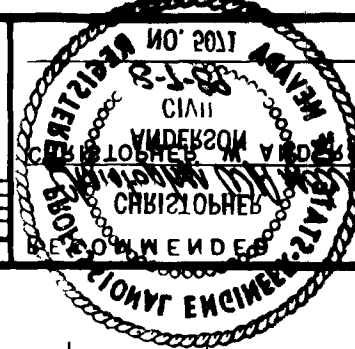

SEE NO. DATE
103-W-0022


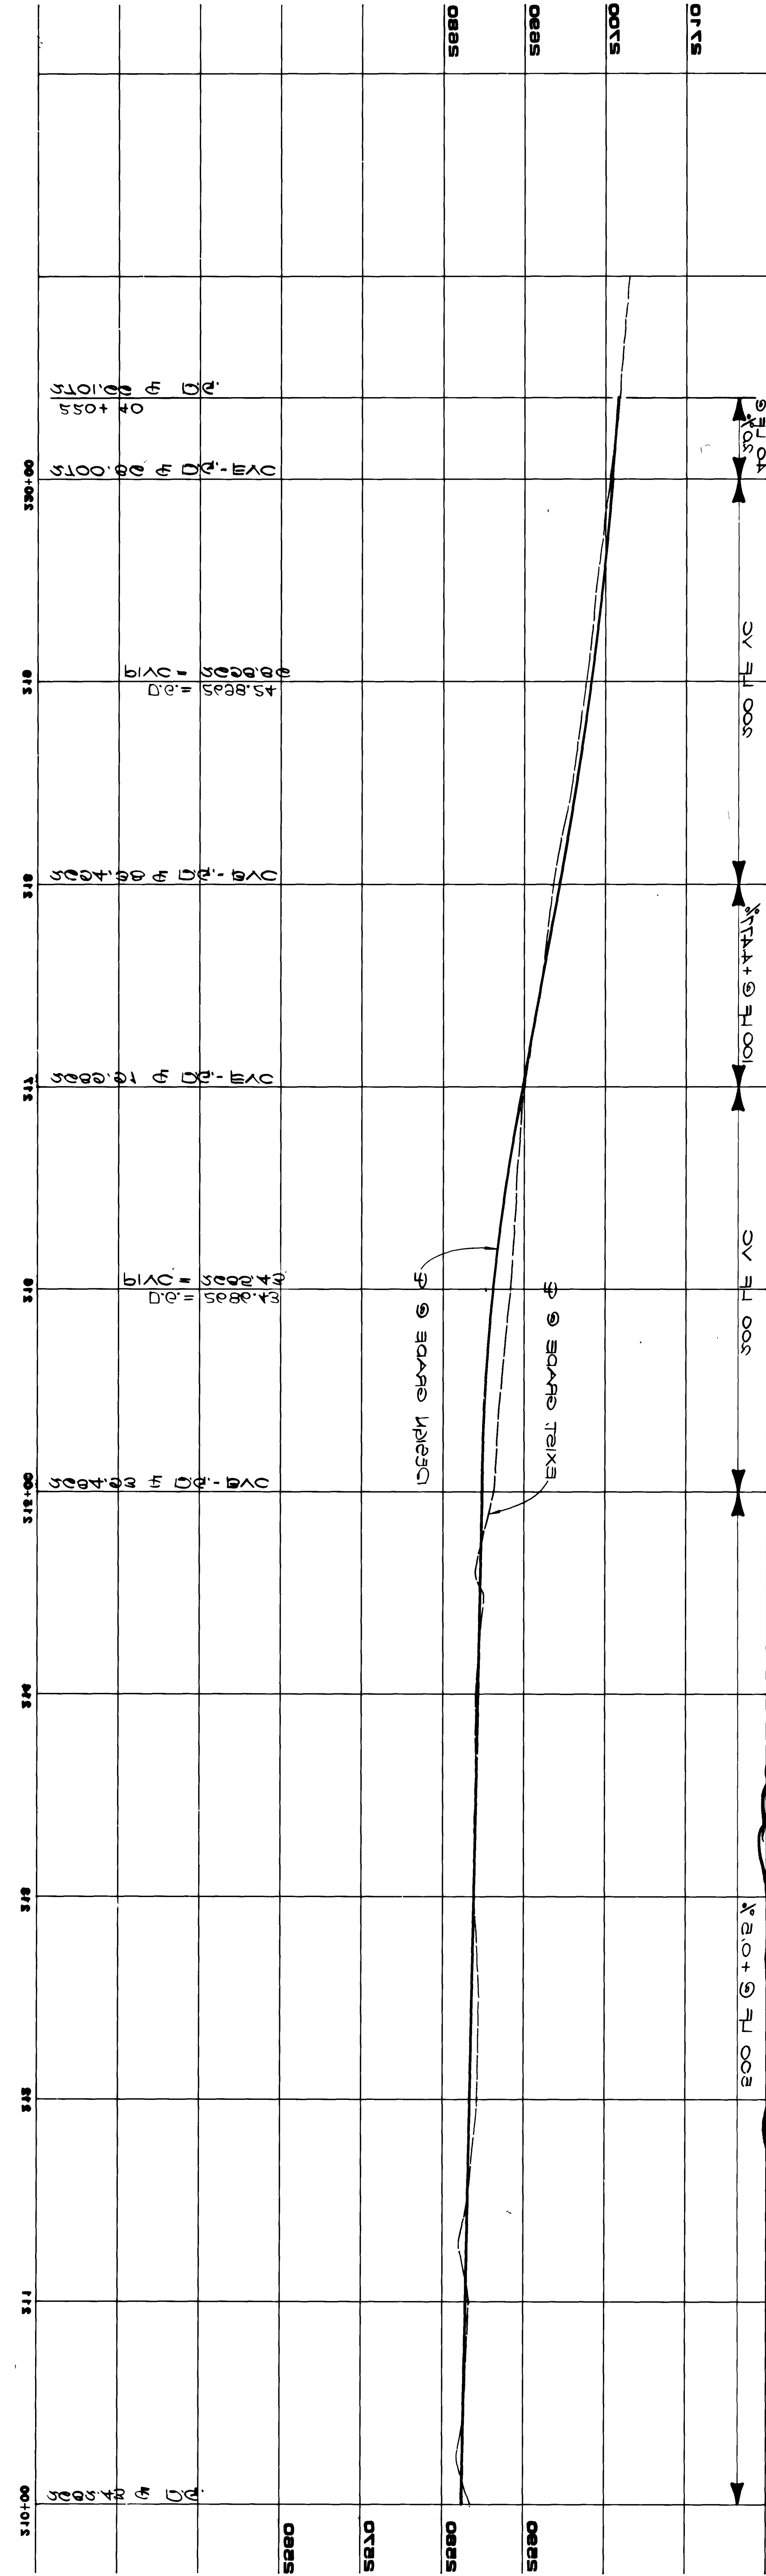





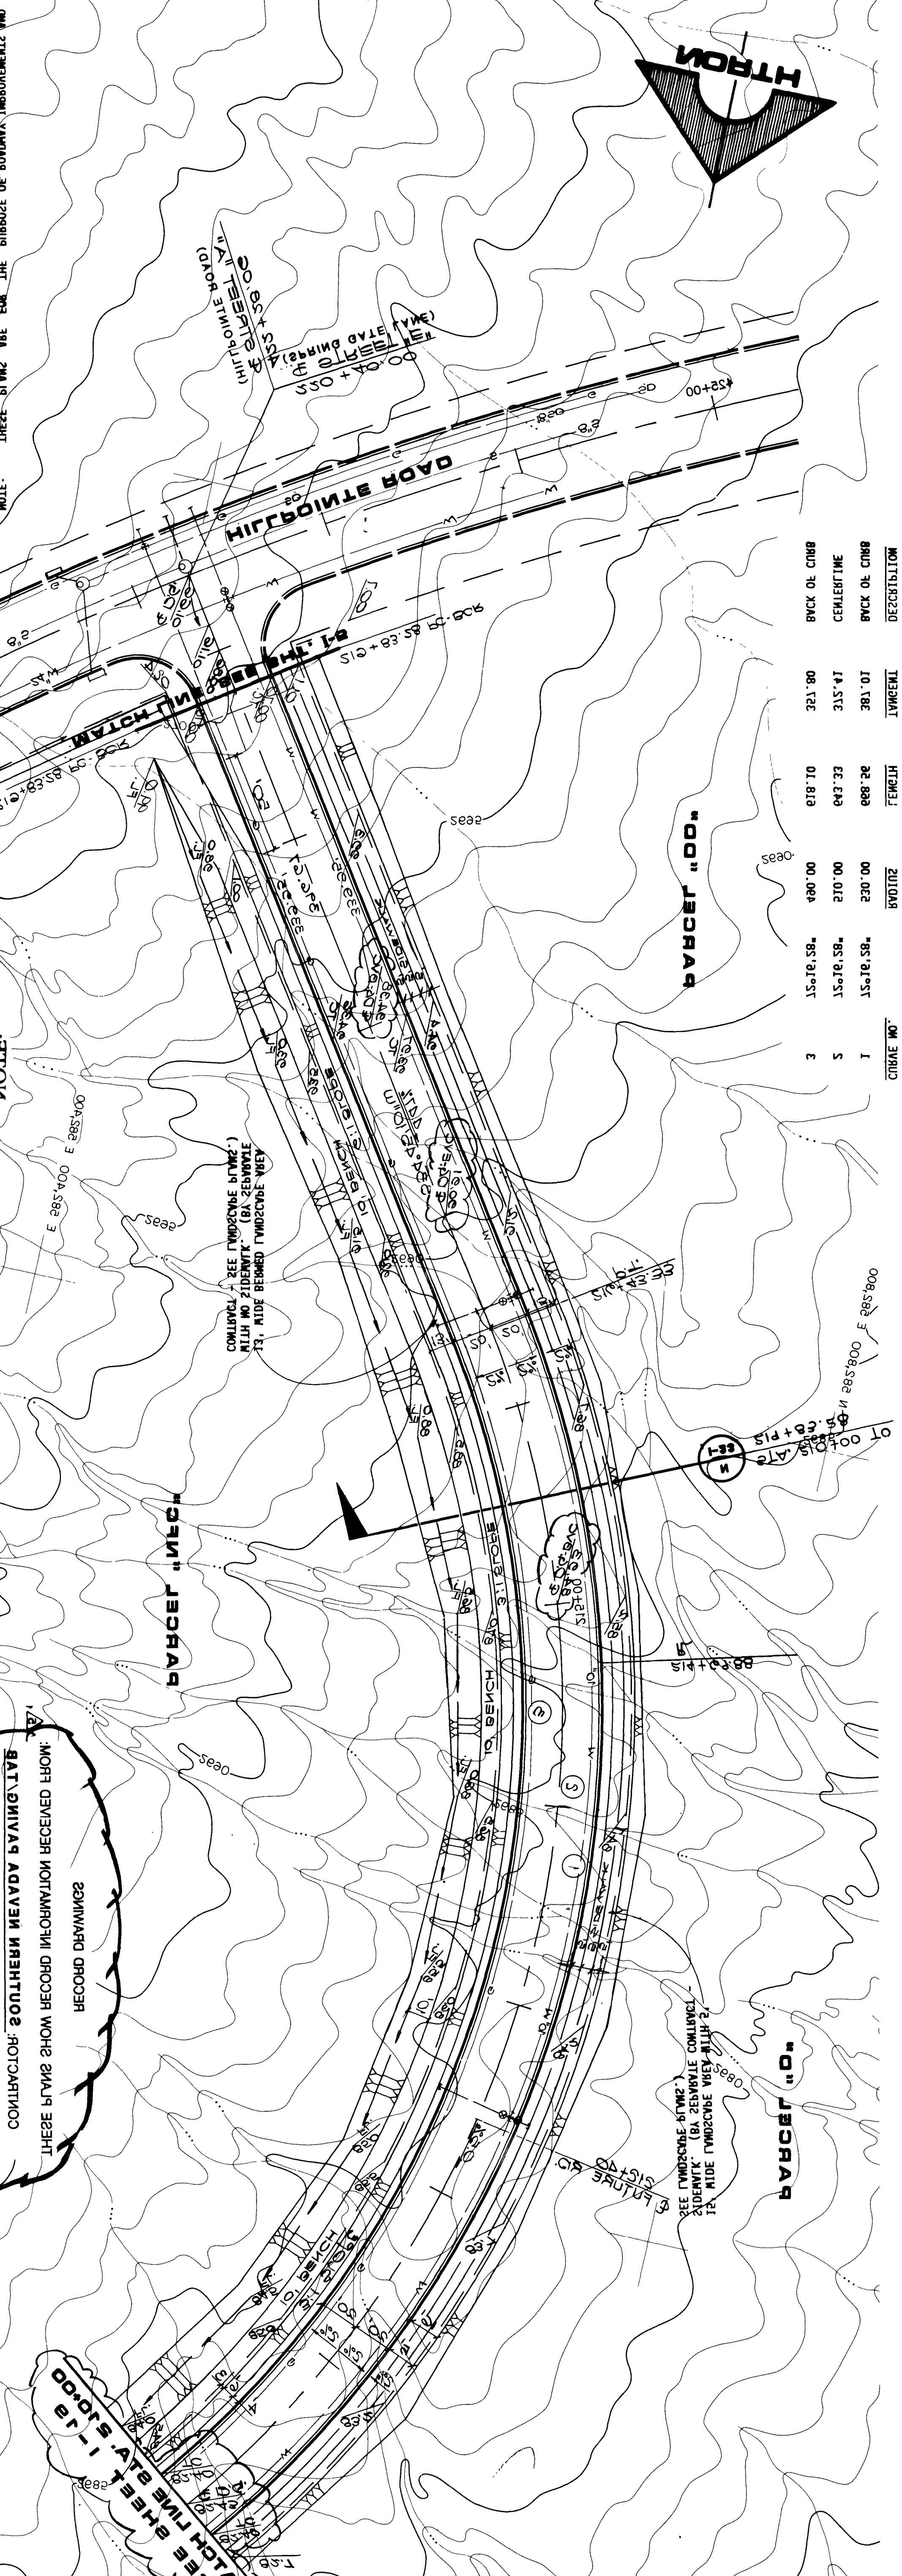

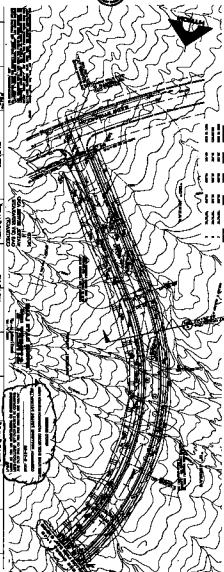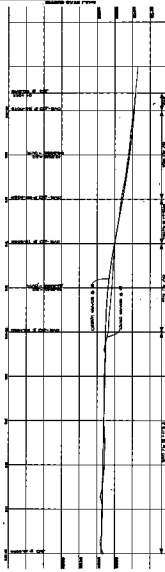

