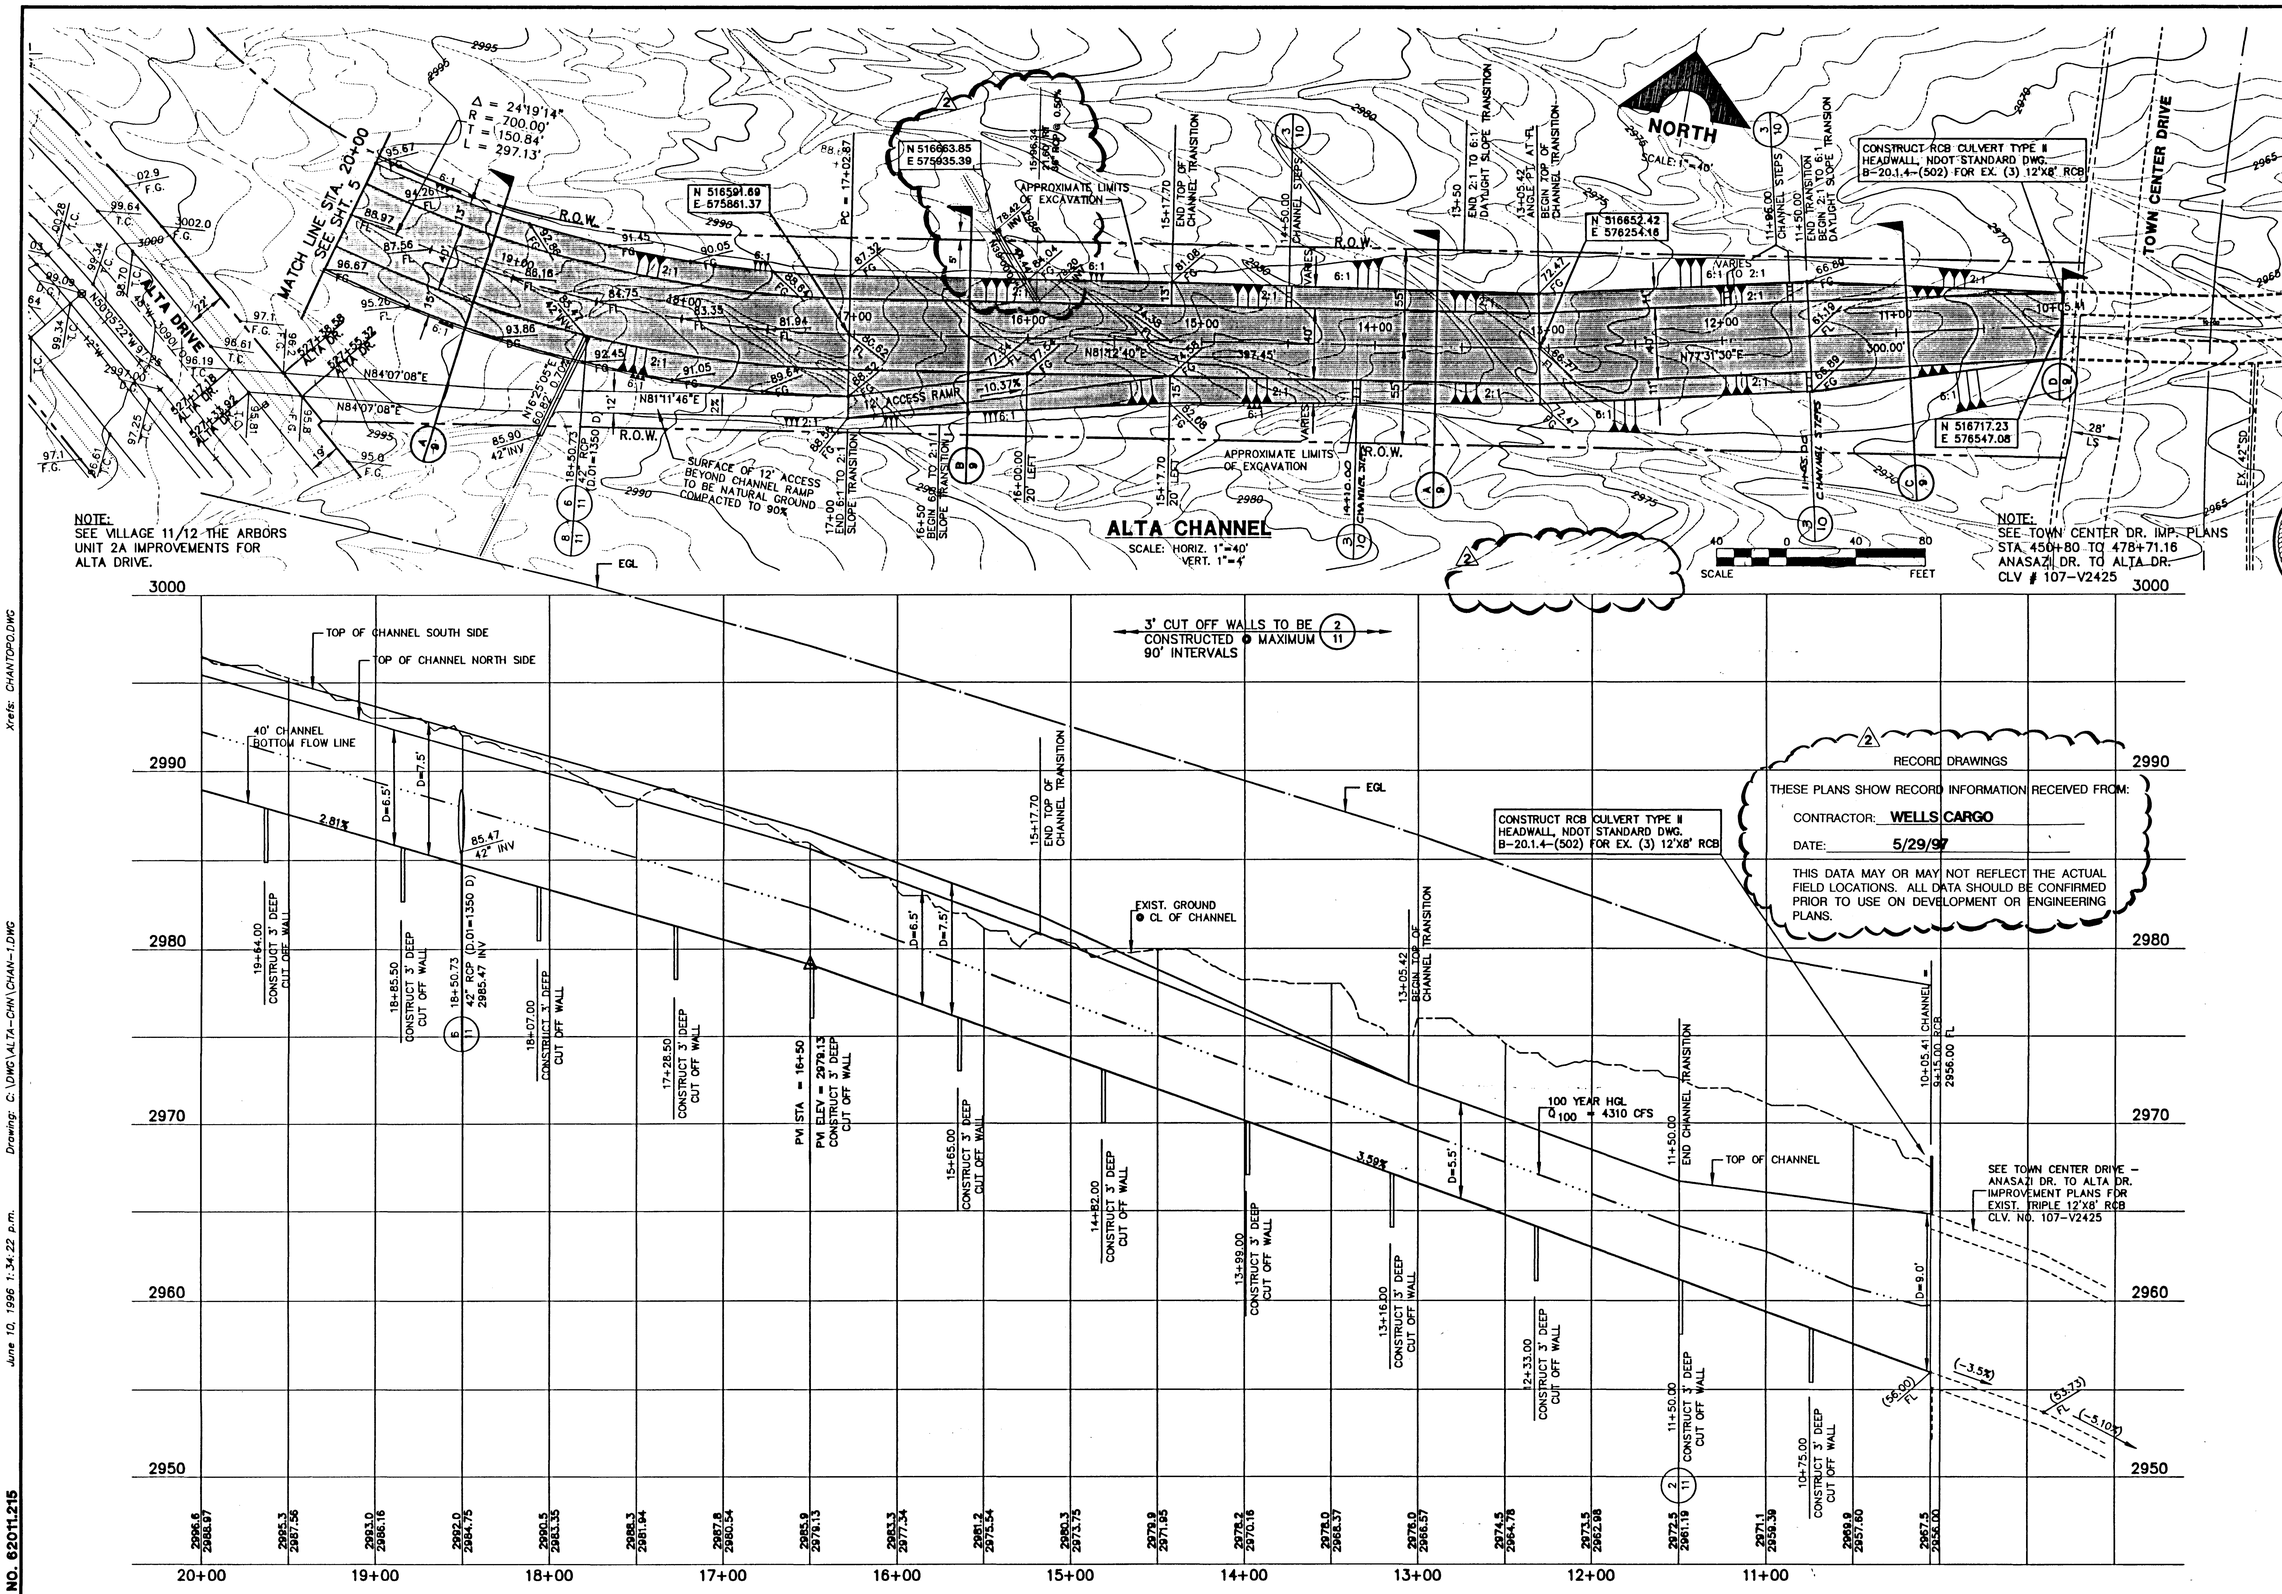

FINAL SUBMITTAL

REV.	DATE	DESCRIPTION	APPROVAL DATE
A	5-29-97	RECORD DRAWING	

RECOMMENDED: ROY A. DAVIS III — DATE 6-14-96

PROFESSIONAL ENGINEER - STATE OF NEVADA — REGISTERED — 9314

R.P.E. NO. 9314

G.C. WALLACE, INC.
Engineering/Architecture 1555 SOUTH RAINBOW BLVD./LAS VEGAS, NEVADA 89102

SUMMERLIN
VILLAGE 11/12 ALTA DRIVE
DRAINAGE CHANNEL
PLAN & PROFILE
STA. 10+05.41 TO 20+00

SHEET 4
SHT 4 OF 11

JOB NO. 62011.215

Xrefs: CHANTOPO.DWG

Drawing: C:\DWG\ALTA-CHN\CHAN-1.DWG

June 10, 1996 1:34:22 p.m.

3310

S.I.D. 707 PROJECT NO. 22

731-62

 
FINAL SUBMITTAL
ALTA DRAINAGE
SHEET
4
731-62