


035- 449 83079 42532

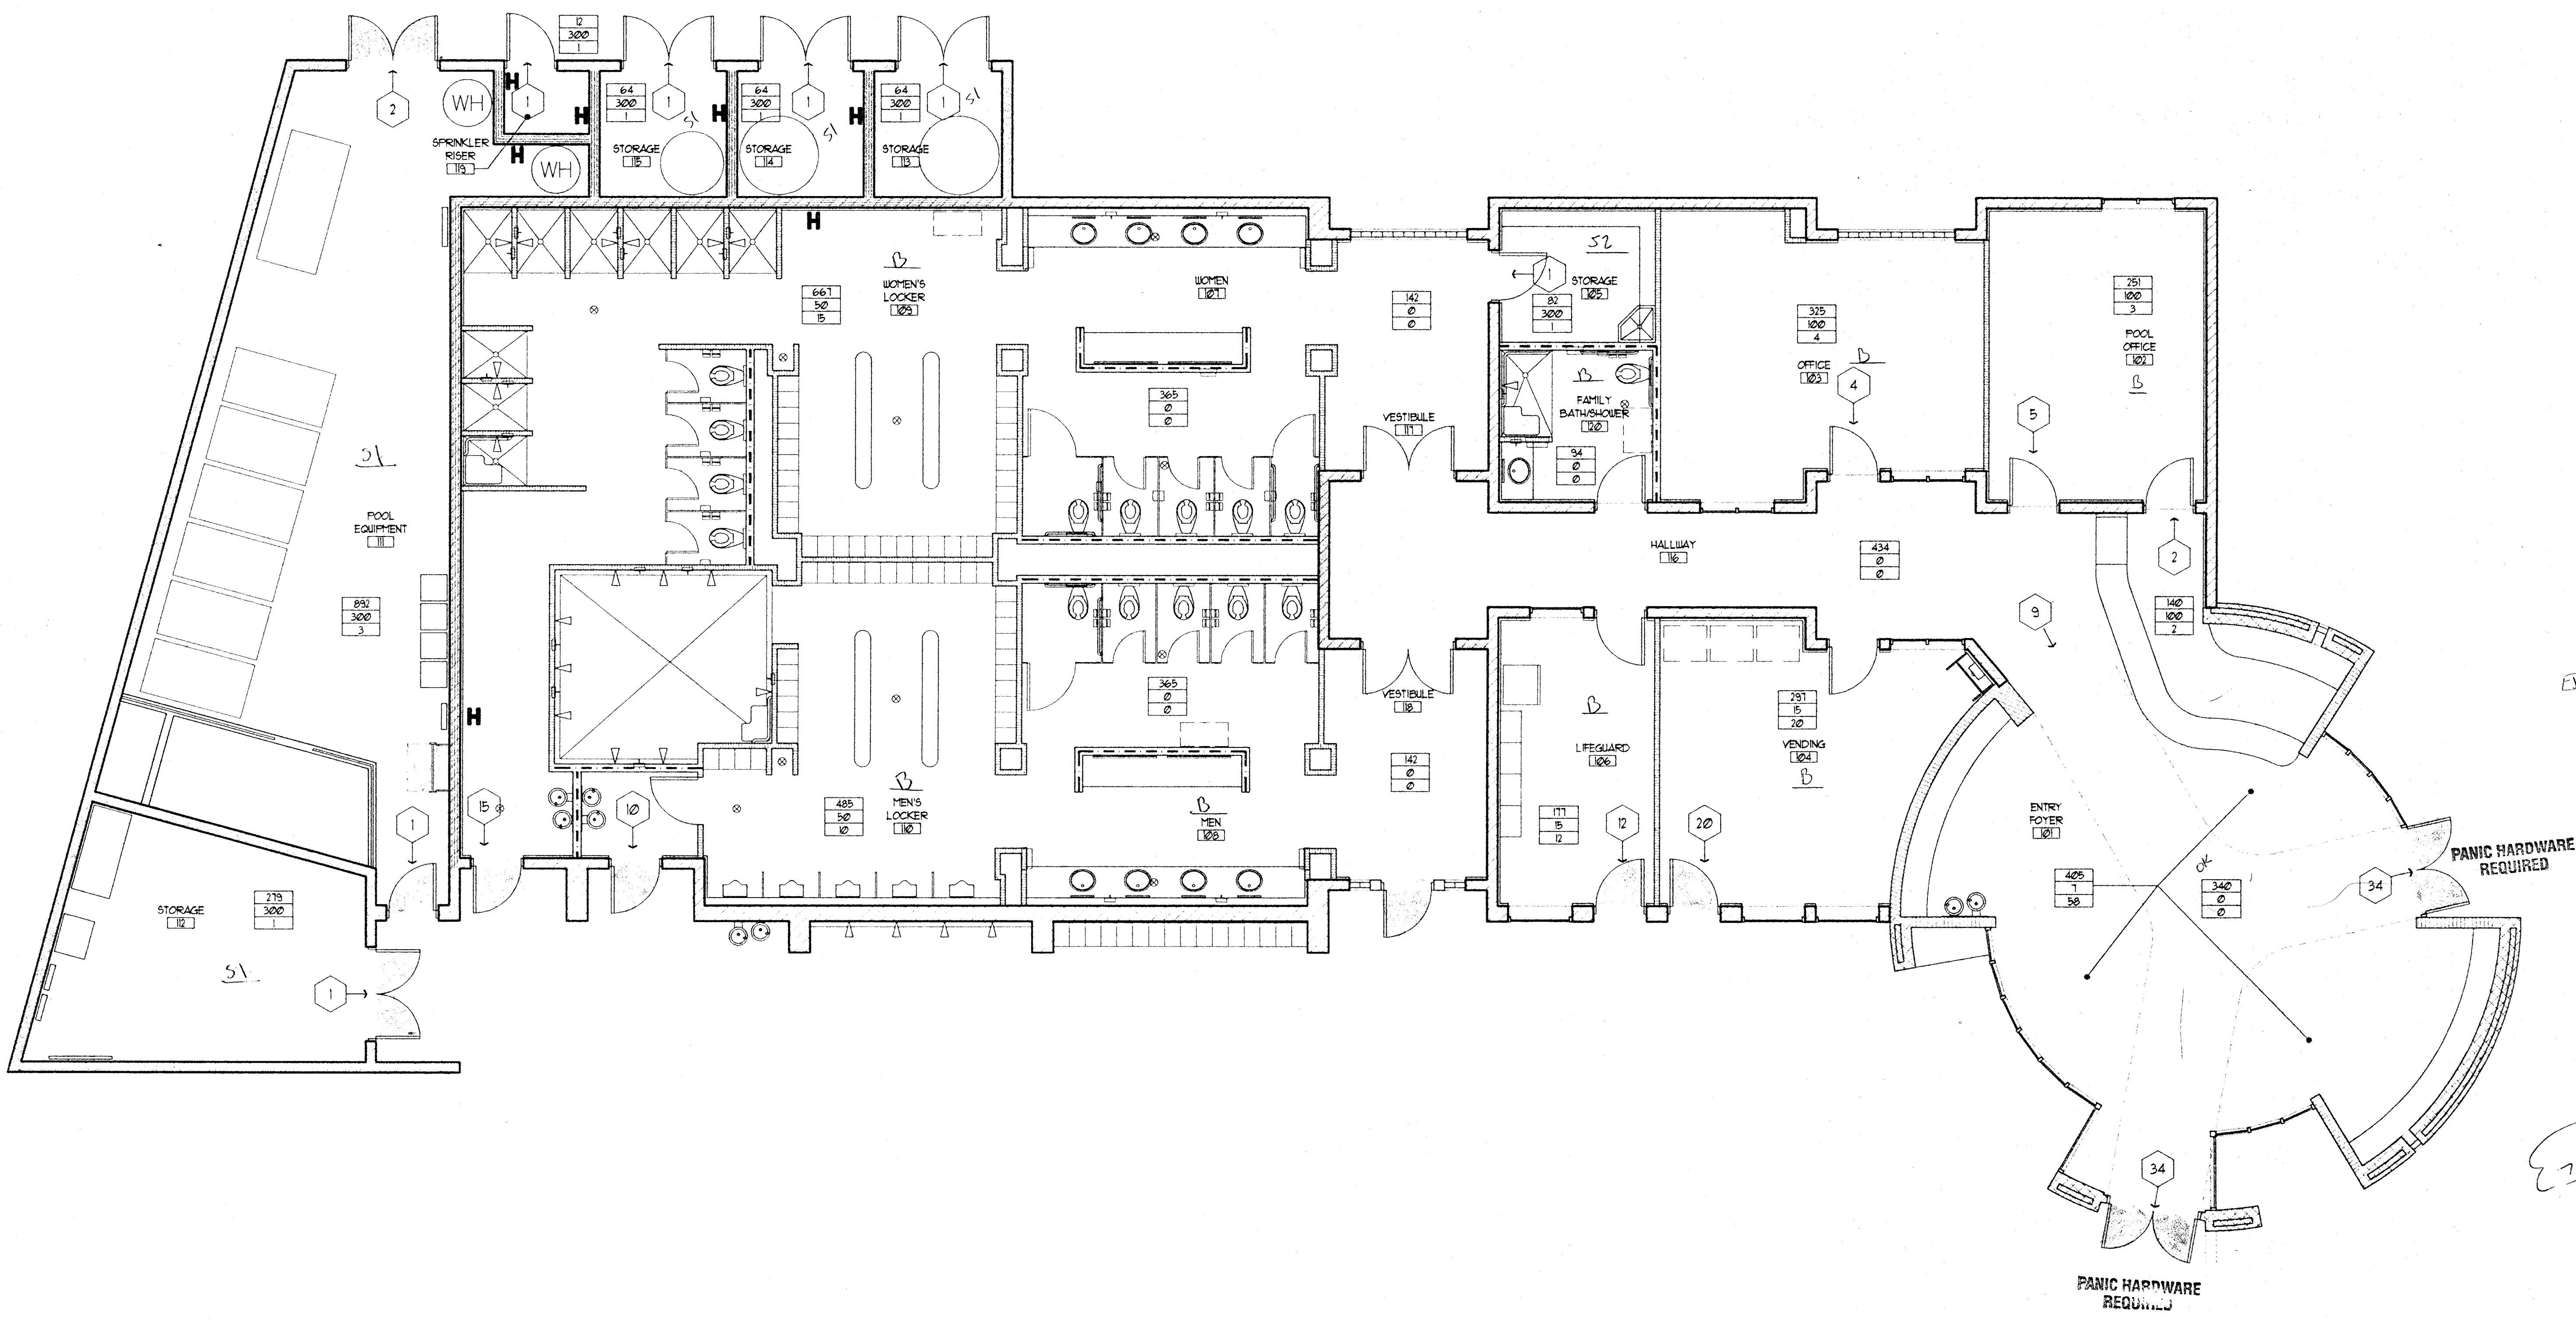

EXITING FLOOR PLAN
SCALE: 3/16" = 1'-0"

LEGEND

X

INDICATES NUMBER OF OCCUPANTS PER SPACE

XXX

INDICATES NUMBER OF OCCUPANTS EXITING THROUGH A DOOR AND DIRECTION OF TRAVEL

X

FIRE EXTINGUISHER CABINET LOCATIONS, FULLY RECESSED AT STUD WALL LOCATIONS

H

INDICATES 1 HOUR CONSTRUCTION

XXX

TOTAL SQUARE FOOTAGE

XXX

SQUARE FOOT PER OCCUPANT

XXX

TOTAL OCCUPANTS


NOTE:
REFER TO SITE PLAN, SHEET A101, FOR POOL DECK EXITING.

PLANS APPROVED
ARCHITECTURAL
Building & Safety Dept.
City of Las Vegas, Nevada
JOC JUN 31 2000
Does Not Indicate Structure, Elevation,
Planting, Landscaping or Site Site
Improvements Made via Change
When in Use, it is
Not a Permit to Violate Any Ordinance

**ONE HOUR
FIRE - RESISTIVE
CONSTRUCTION
THROUGHOUT**

EXITING OK 2-2-2000
JJC

7131 SF

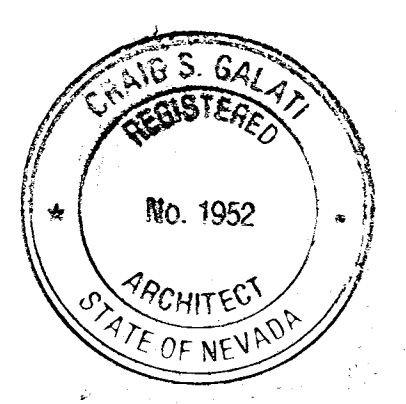

EXITING FLOOR PLAN

**SUMMERLIN ARBORS PARK
POOL AND POOL BUILDING**

Sheet Number:

G1.02

Date: October 22, 1999

Project No. 99035.00

Scale: 3/16" = 1'-0"

Drawn By: DDT

Revisions:

1

2

