


**GENERAL NOTES**

1. REFER TO CIVIL, ELECTRICAL, PLUMBING, AND LANDSCAPING PLANS FOR ADDITIONAL INFORMATION.
2. CONCRETE WALKWAY AND CURBS BY OTHERS.
3. REFER TO EXISTING PLAN, SHEET G102, FOR EXISTING SYMBOLS LEGEND.

**KEYNOTES**

- 1 ASPHALT PAVING - REFER TO CIVIL
- 2 CONCRETE CURB & PLANTER - REFER TO CIVIL
- 3 CONCRETE SIDEWALK - REFER TO CIVIL
- 4 FUTURE SHADE CANOPY - REFER TO CIVIL/LANDSCAPE PLANS
- 5 EXISTING AND FUTURE SPORTS COURTS
- 6 TERRACED RETAINING AND PLANTER WALLS - REFER TO LANDSCAPE PLANS
- 7 LIMITS OF PROJECT/ASSUMED PROPERTY LINE
- 8 50 METER x 25 YARD COMPETITION SWIMMING POOL
- 9 1 METER AND 3 METER DIVING BOARDS
- 10 BATH HOUSE - REFER TO SHEET A201
- 11 POSSIBLE FUTURE POOL COVER
- 12 STAINED CONCRETE DECK
- 13 FUTURE ARBOR TRELLIS - REFER TO CIVIL/LANDSCAPE PLANS
- 14 TURF AREA
- 15 REMOVABLE HANDICAP SIGN
- 16 6" THICK 1' WIDE CONCRETE ACCESS DRIVE
- 17 SWALE - REFER TO CIVIL DRAWINGS
- 18 POSSIBLE FUTURE HVAC EQUIPMENT
- 19 SURGE CHAMBER - REFER TO POOL DRAWINGS
- 20 TRASH ENCLOSURE - REFER TO LANDSCAPE
- 21 ACCESSIBLE ROUTE PER UBC - NOT TO EXCEED 5% SLOPE IN DIRECTION OF TRAVEL OR 2% CROSS SLOPE

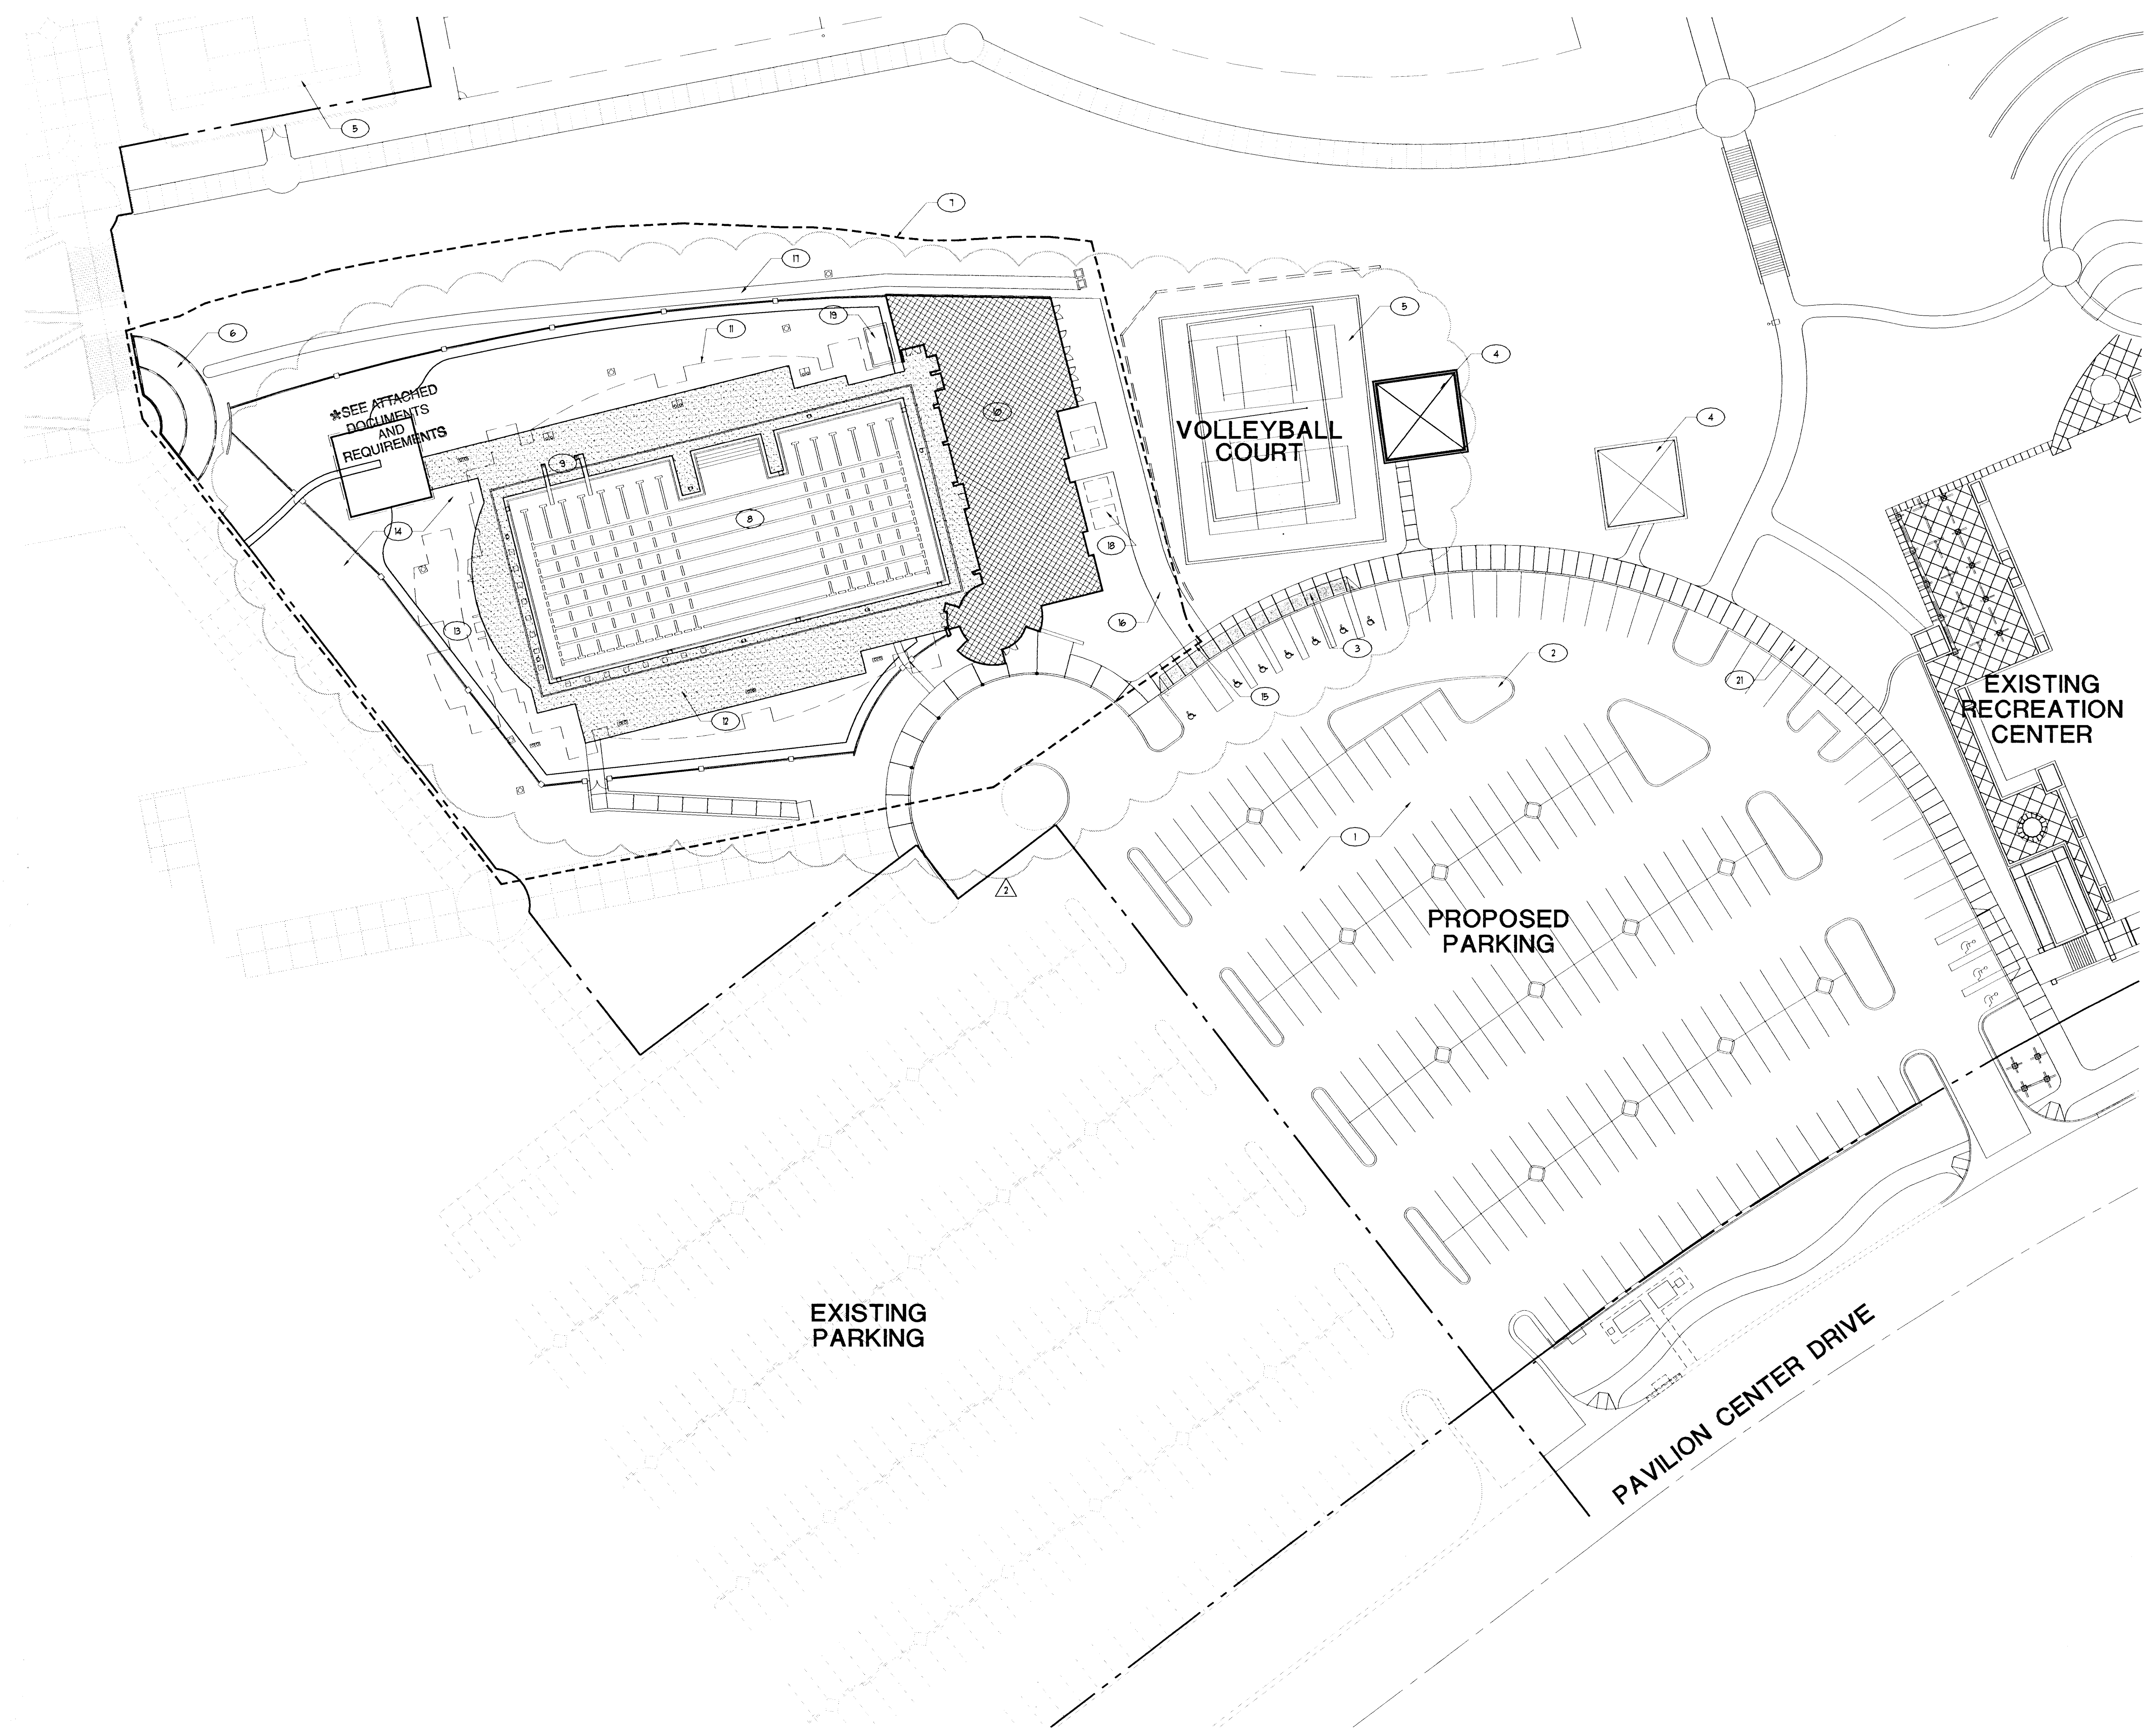

APPROVED  
BY: [Signature]  
LUCCHESI GALATI ARCHITECTS  
CITY OF LAS VEGAS


THIS IS A NEW SHEET

PLANS APPROVED  
ARCHITECTURAL  
Building & Safety Dept.  
City of Las Vegas, Nevada  
JCC JUL 31 2000  
Does Not Include Structural, Electrical,  
Plumbing/Mechanical or CE, S&B  
Improvements. Initial No Change  
Without Approval. Sign is  
Not a Permit to Violate Any Ordinance.

**ONE HOUR  
FIRE - RESISTIVE  
CONSTRUCTION  
THROUGHOUT**

RECEIVED  
MAY - 1 2000  
CITY OF LAS VEGAS  
BUILDING & SAFETY DEPARTMENT

**OVERALL ARCHITECTURAL SITE PLAN**  
SCALE: 1" = 30'-0"

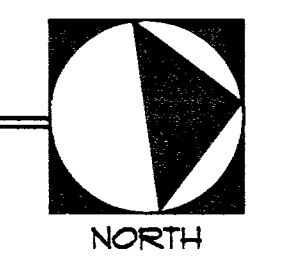

**OVERALL ARCHITECTURAL SITE PLAN**

**SUMMERLIN ARBORS PARK  
POOL AND POOL BUILDING**

Revisions:  
 1. 10/00 - CIVIL COMMENTS  
 2. 1/00 - CIVIL COMMENTS

Date: October 22, 1999  
 Project No. 9903500  
 Scale: 1" = 20'-0"  
 Drawn By:

Sheet Number:  
**A1.01A**