


GENERAL NOTES

1. XXX







GLAZING NOTES

1. TG = TEMPERED GLASS
 2. WG = WIRED GLASS
 3. XXX

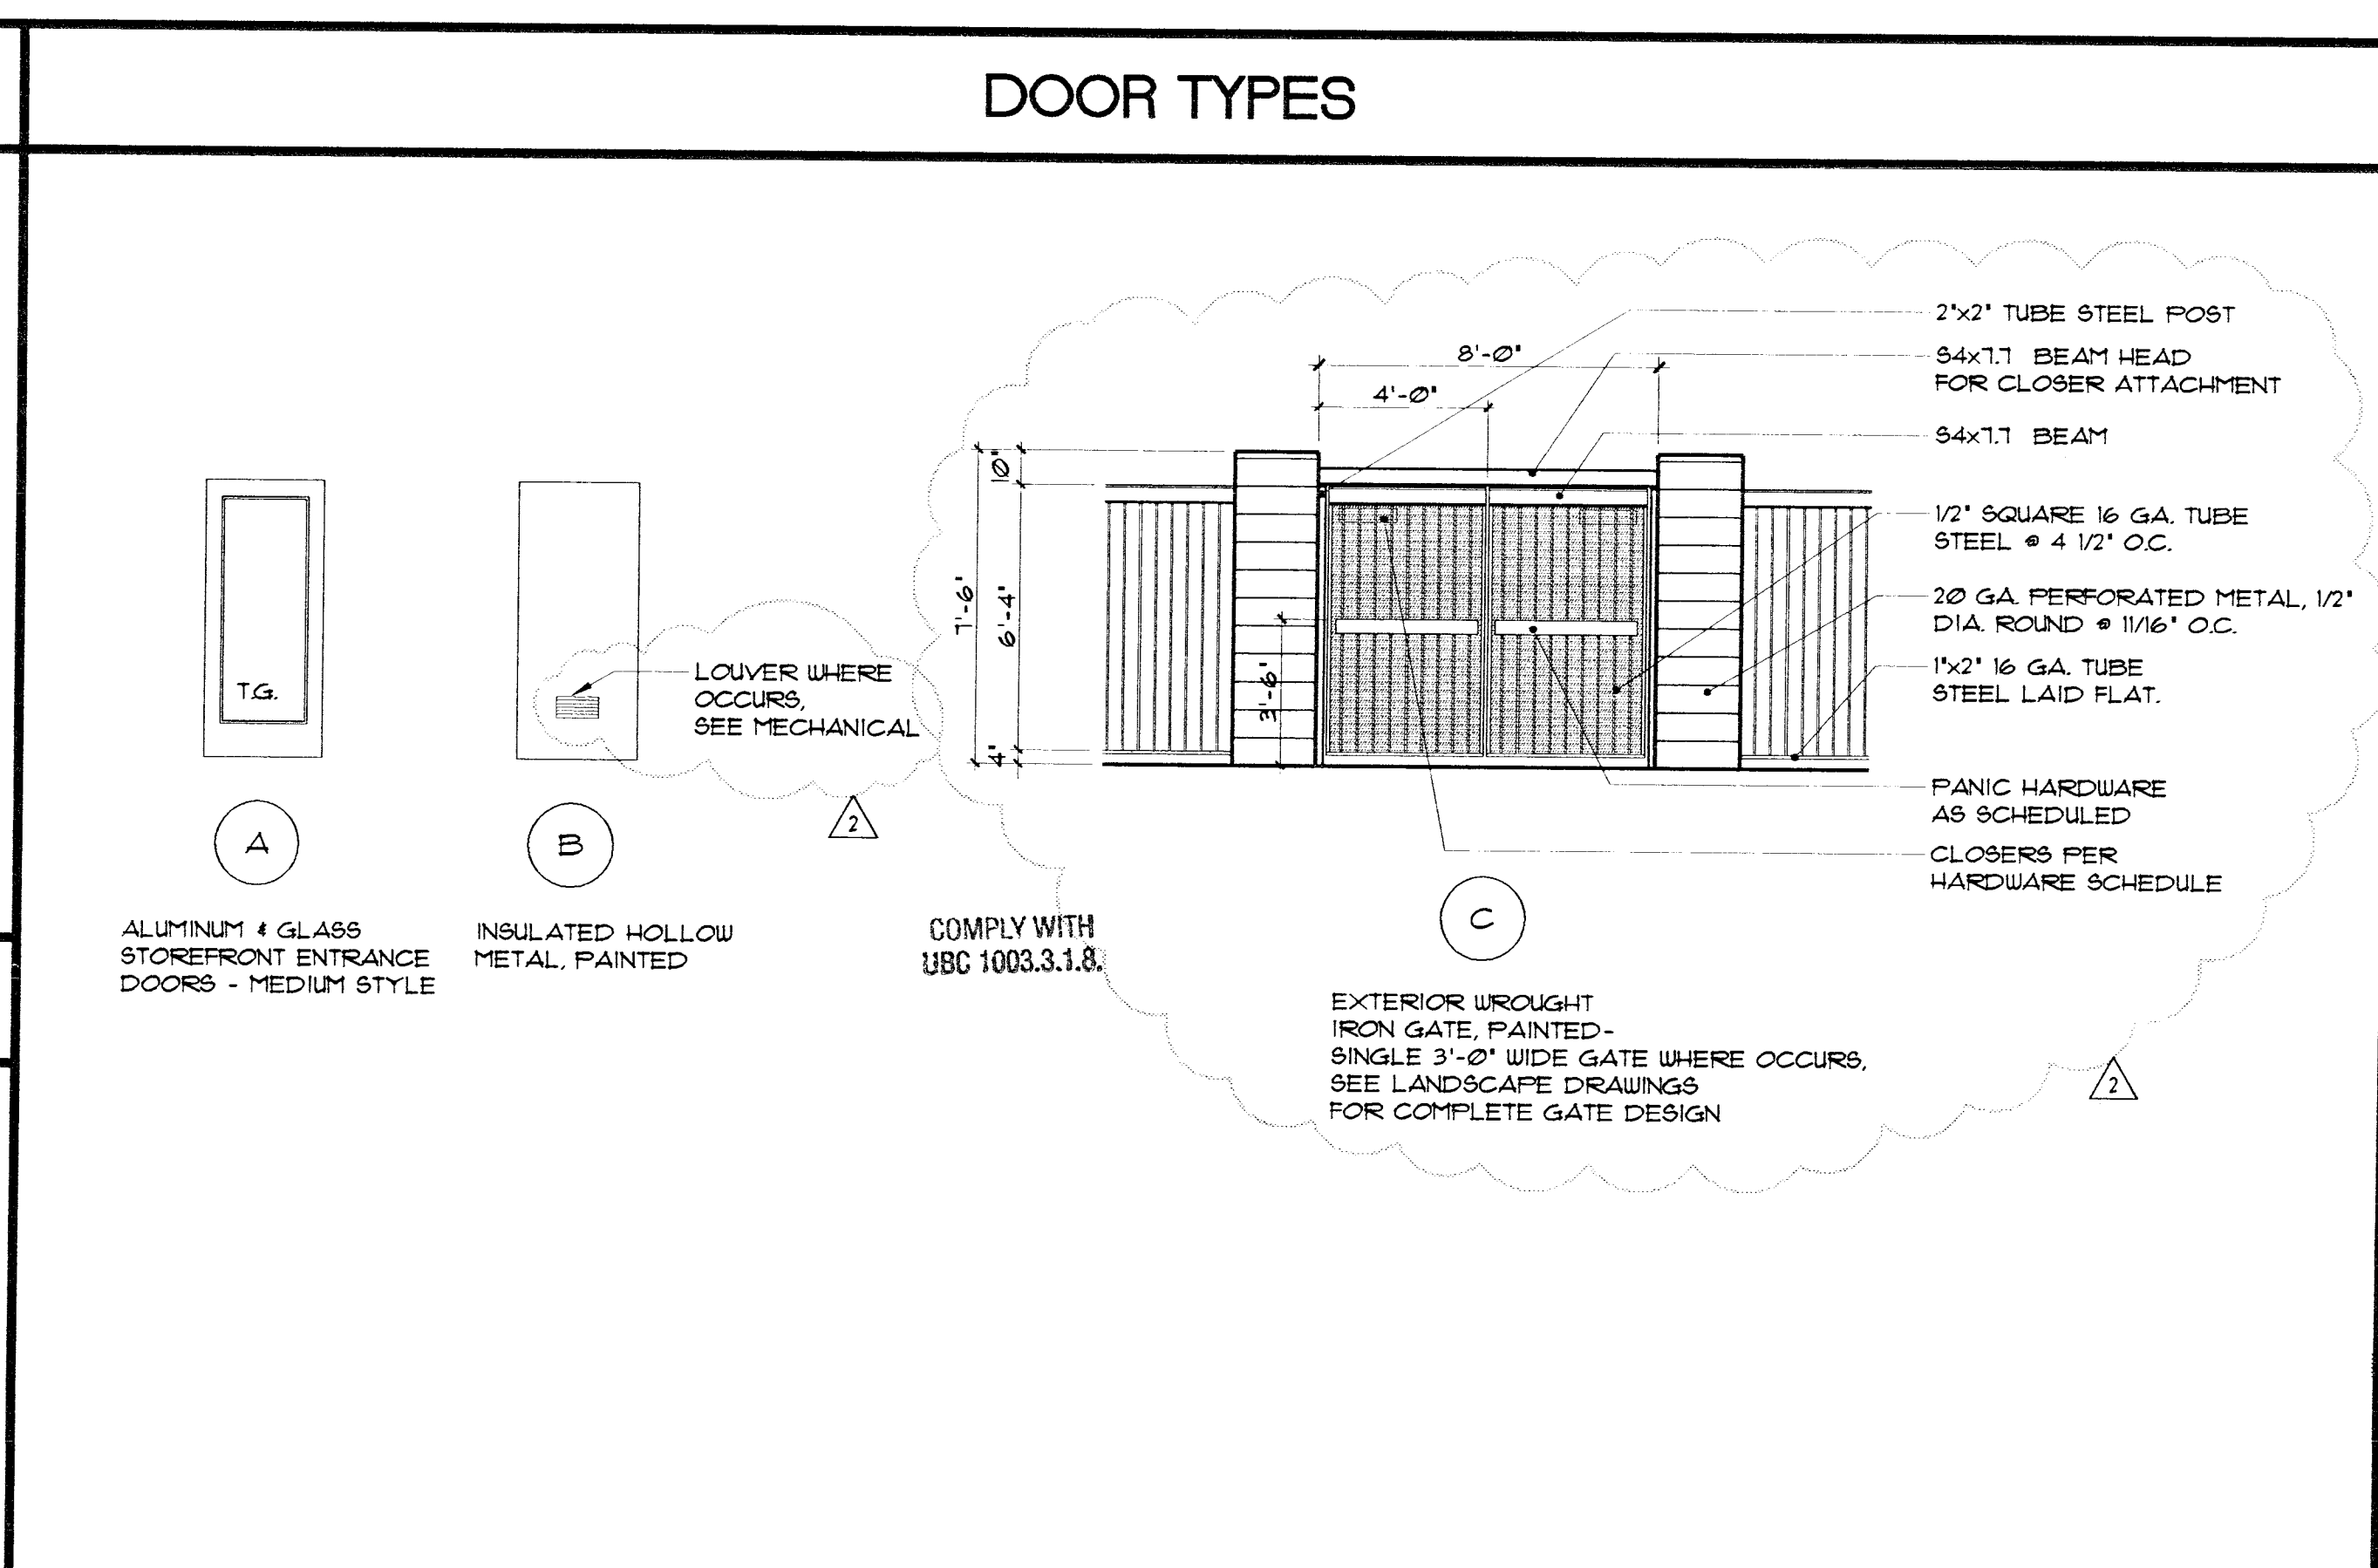

COMPLY WITH UBC 1003.3.1.8. **DOOR SCHEDULE**

DOOR				FRAME				HOUR GROUP	REMARKS
DOOR NO.	ROOM NO.	SIZE	TYPE	HEAD	JAMB	SILL	MAT.		
101A	101	FR 2'-10" X 7'-0"	A	2/A251	2/A251	3/A251	AL		
101B	101	FR 2'-10" X 7'-0"	A	2/A251	2/A251	3/A251	AL		
102A	102	3'-0" X 7'-0"	B	1/A251	1/A251	-	HM		
102B	102	3'-0" X 7'-0"	B	1/A251	1/A251	-	HM		
103	103	3'-0" X 7'-0"	B	1/A251	1/A251	-	HM		
104A	104	3'-0" X 7'-0"	B	1/A251	1/A251	-	HM		
104B	104	3'-0" X 7'-0"	A	1/A251	1/A251	4/A251	HM	△	
105	105	3'-0" X 7'-0"	B	1/A251	1/A251	-	HM		
106A	106	3'-0" X 7'-0"	B	1/A251	1/A251	-	HM		
106B	106	3'-0" X 7'-0"	A	1/A251	1/A251	4/A251	HM	△	
109	109	3'-0" X 7'-0"	B	1/A251	1/A251	4/A251	HM		
110A	110	3'-0" X 7'-0"	B	1/A251	1/A251	4/A251	HM		
110B	110	3'-0" X 7'-0"	B	5/A250	5/A250	-	HM		
111A	111	3'-0" X 7'-0"	B	1/A251	1/A251	4/A251	HM		
111B	111	FR 2'-10" X 7'-0"	B	1/A251	1/A251	4/A251	HM		
112	112	FR 2'-10" X 7'-0"	B	1/A251	1/A251	4/A251	HM		
113	113	FR 2'-10" X 7'-0"	B	1/A251	1/A251	4/A251	HM		
114	114	FR 2'-10" X 7'-0"	B	1/A251	1/A251	4/A251	HM	LOUVER	
115	115	FR 2'-10" X 7'-0"	B	1/A251	1/A251	4/A251	HM	LOUVER	
116A	116	FR 2'-10" X 7'-0"	B	1/A251	1/A251	-	HM		
116B	116	FR 2'-10" X 7'-0"	B	1/A251	1/A251	-	HM		
118	118	3'-0" X 7'-0"	B	8/A251	8/A251	4/A251	HM	SPECIAL HEIGHT	
119	119	3'-0" X 7'-0"	B	1/A251	1/A251	4/A251	HM		
120	120	3'-0" X 7'-0"	B	1/A251	1/A251	-	HM		
201	ENCL.	FR 4'-0" X 6'-8"	C					SEE LANDSCAPE DRAWINGS FOR DETAILS	
202	ENCL.	FR 4'-0" X 6'-8"	C					SEE LANDSCAPE DRAWINGS FOR DETAILS	
203	ENCL.	3'-0" X 6'-8"	C					SEE LANDSCAPE DRAWINGS FOR DETAILS	

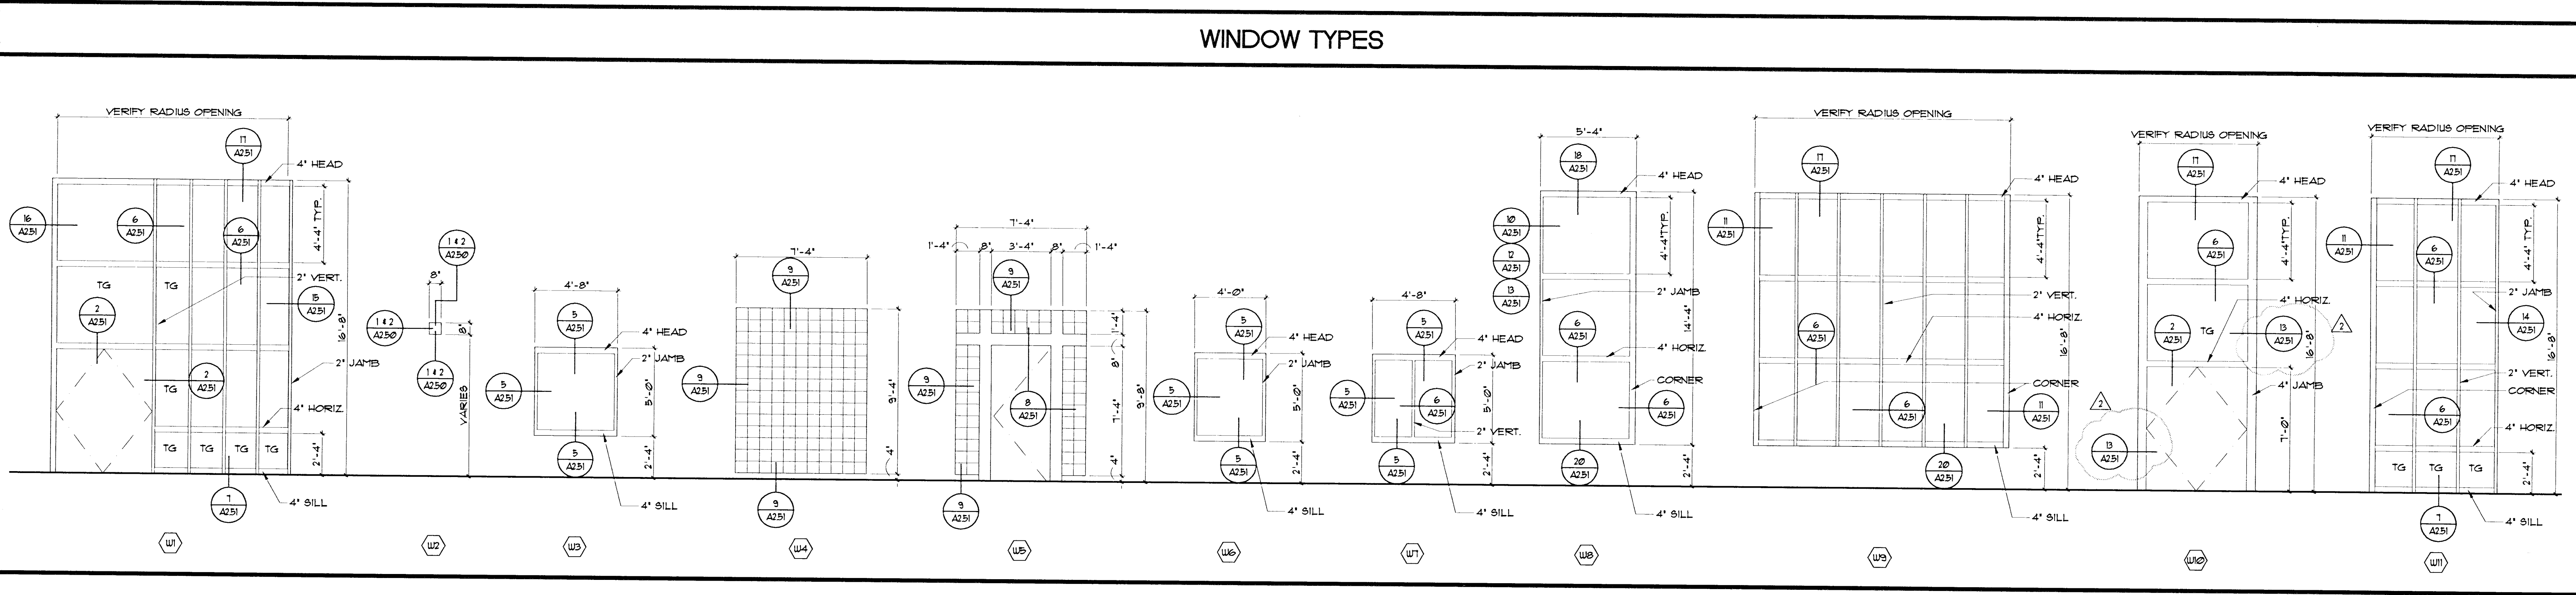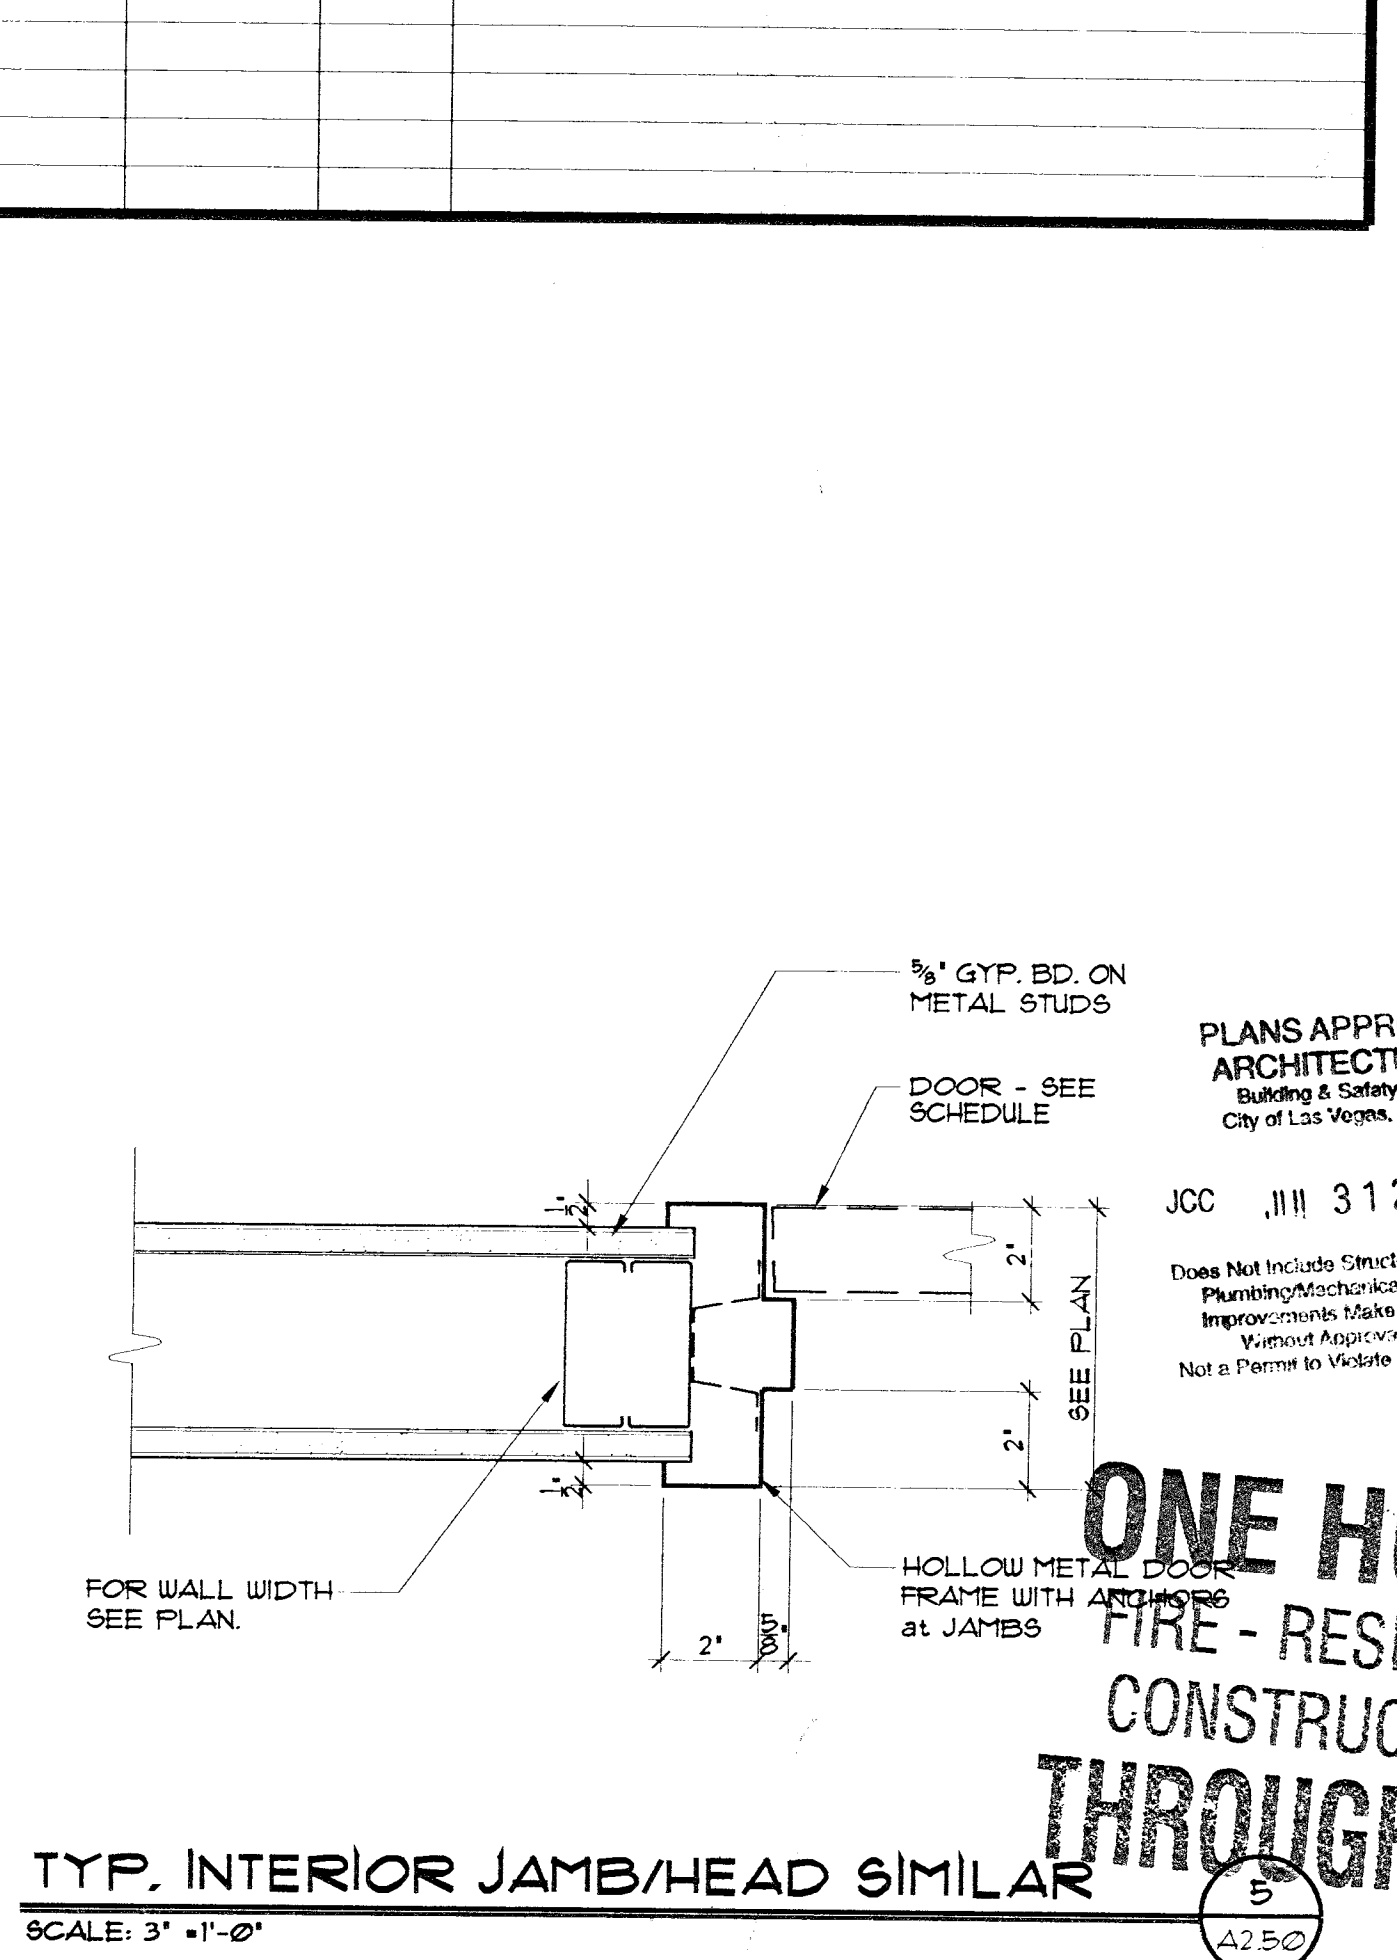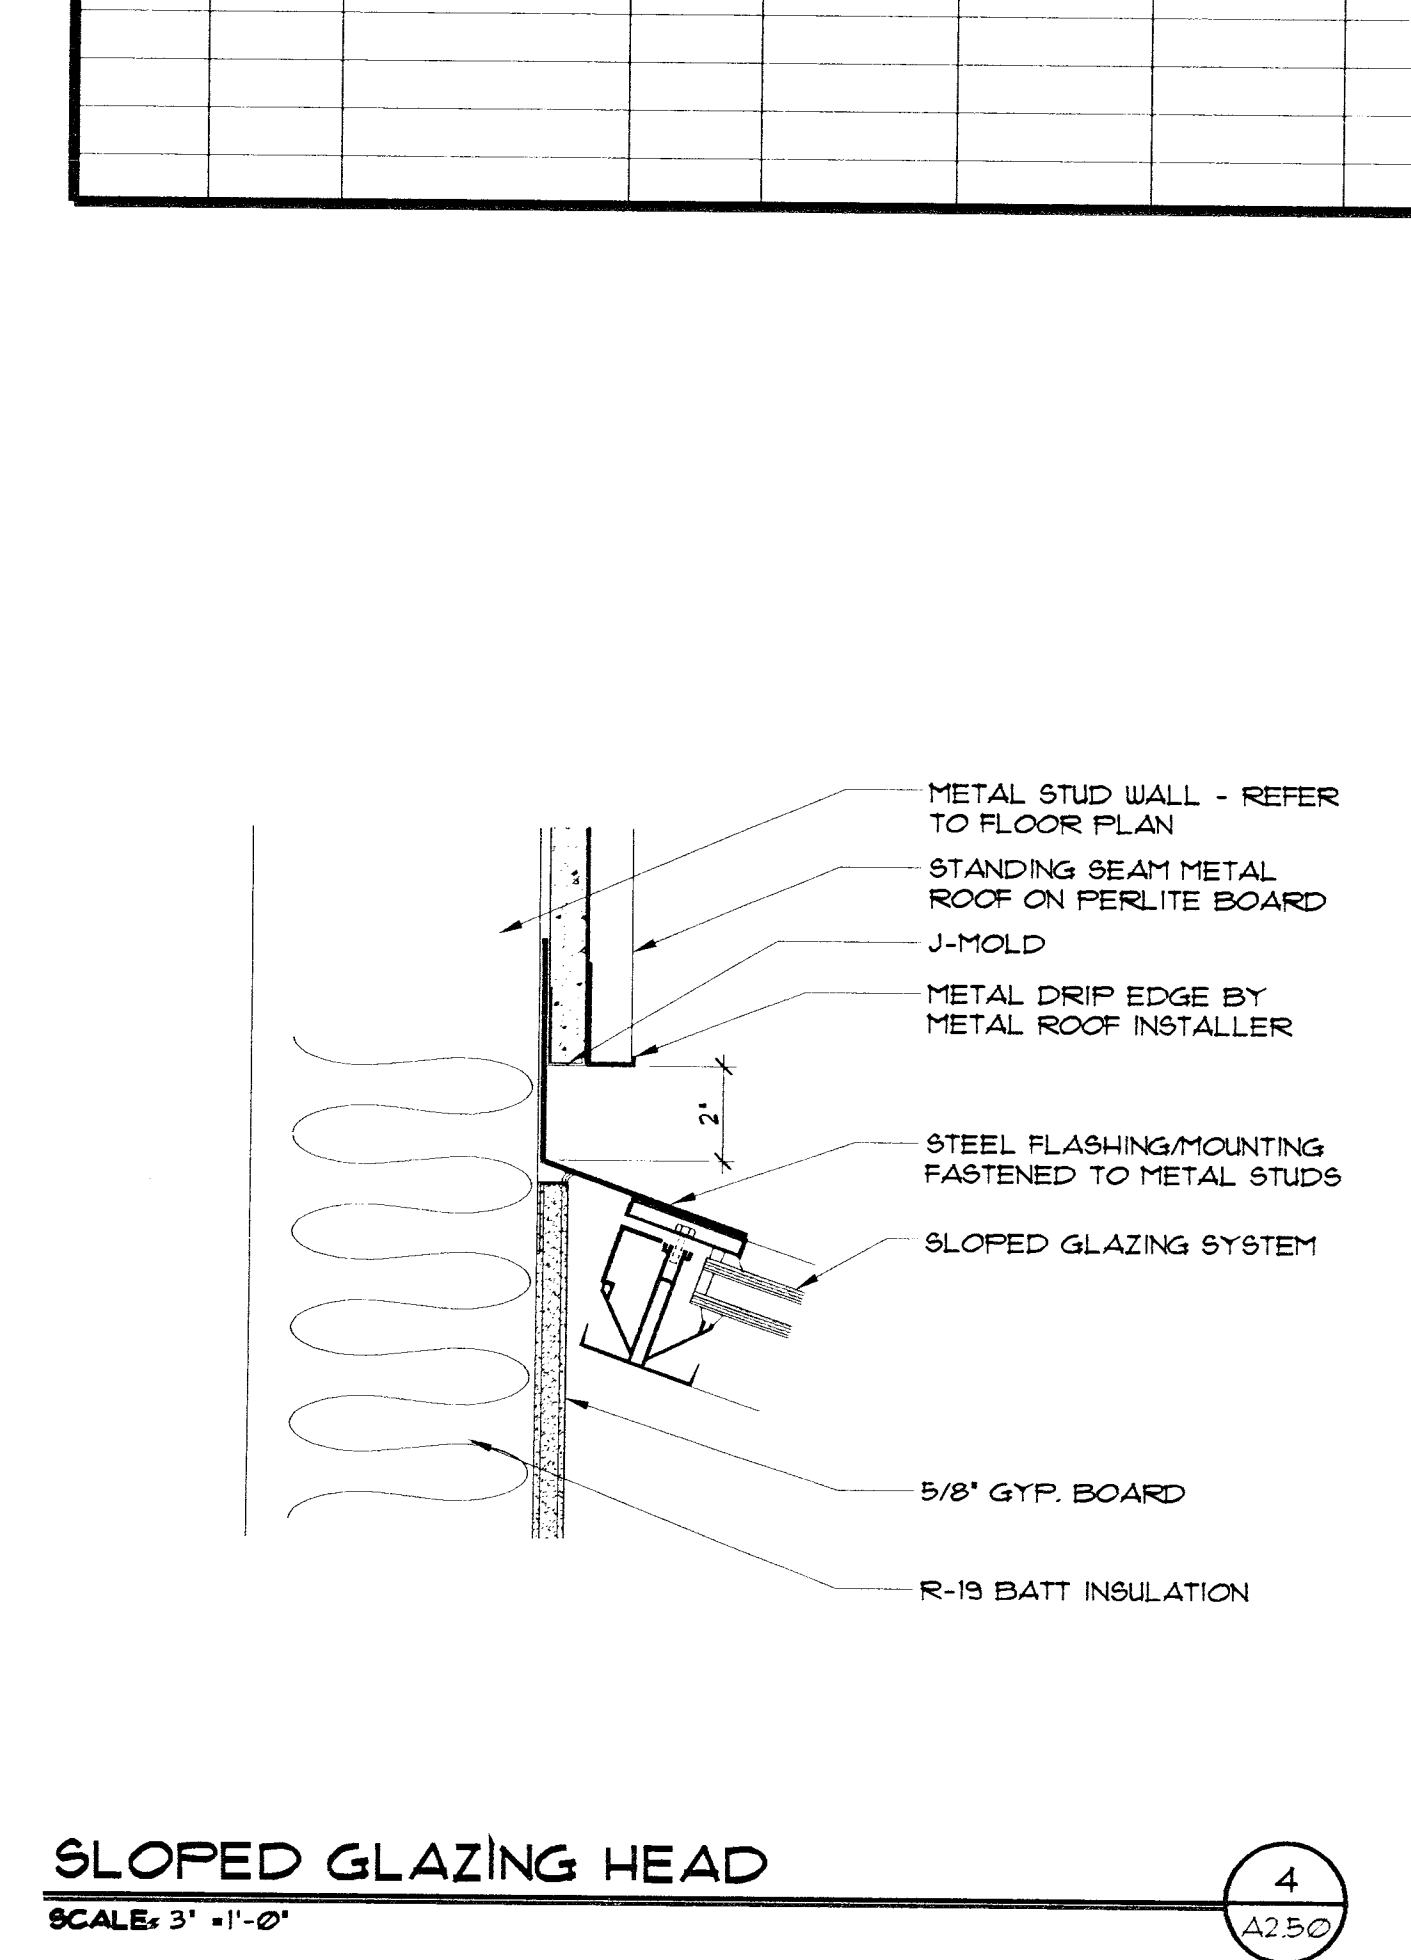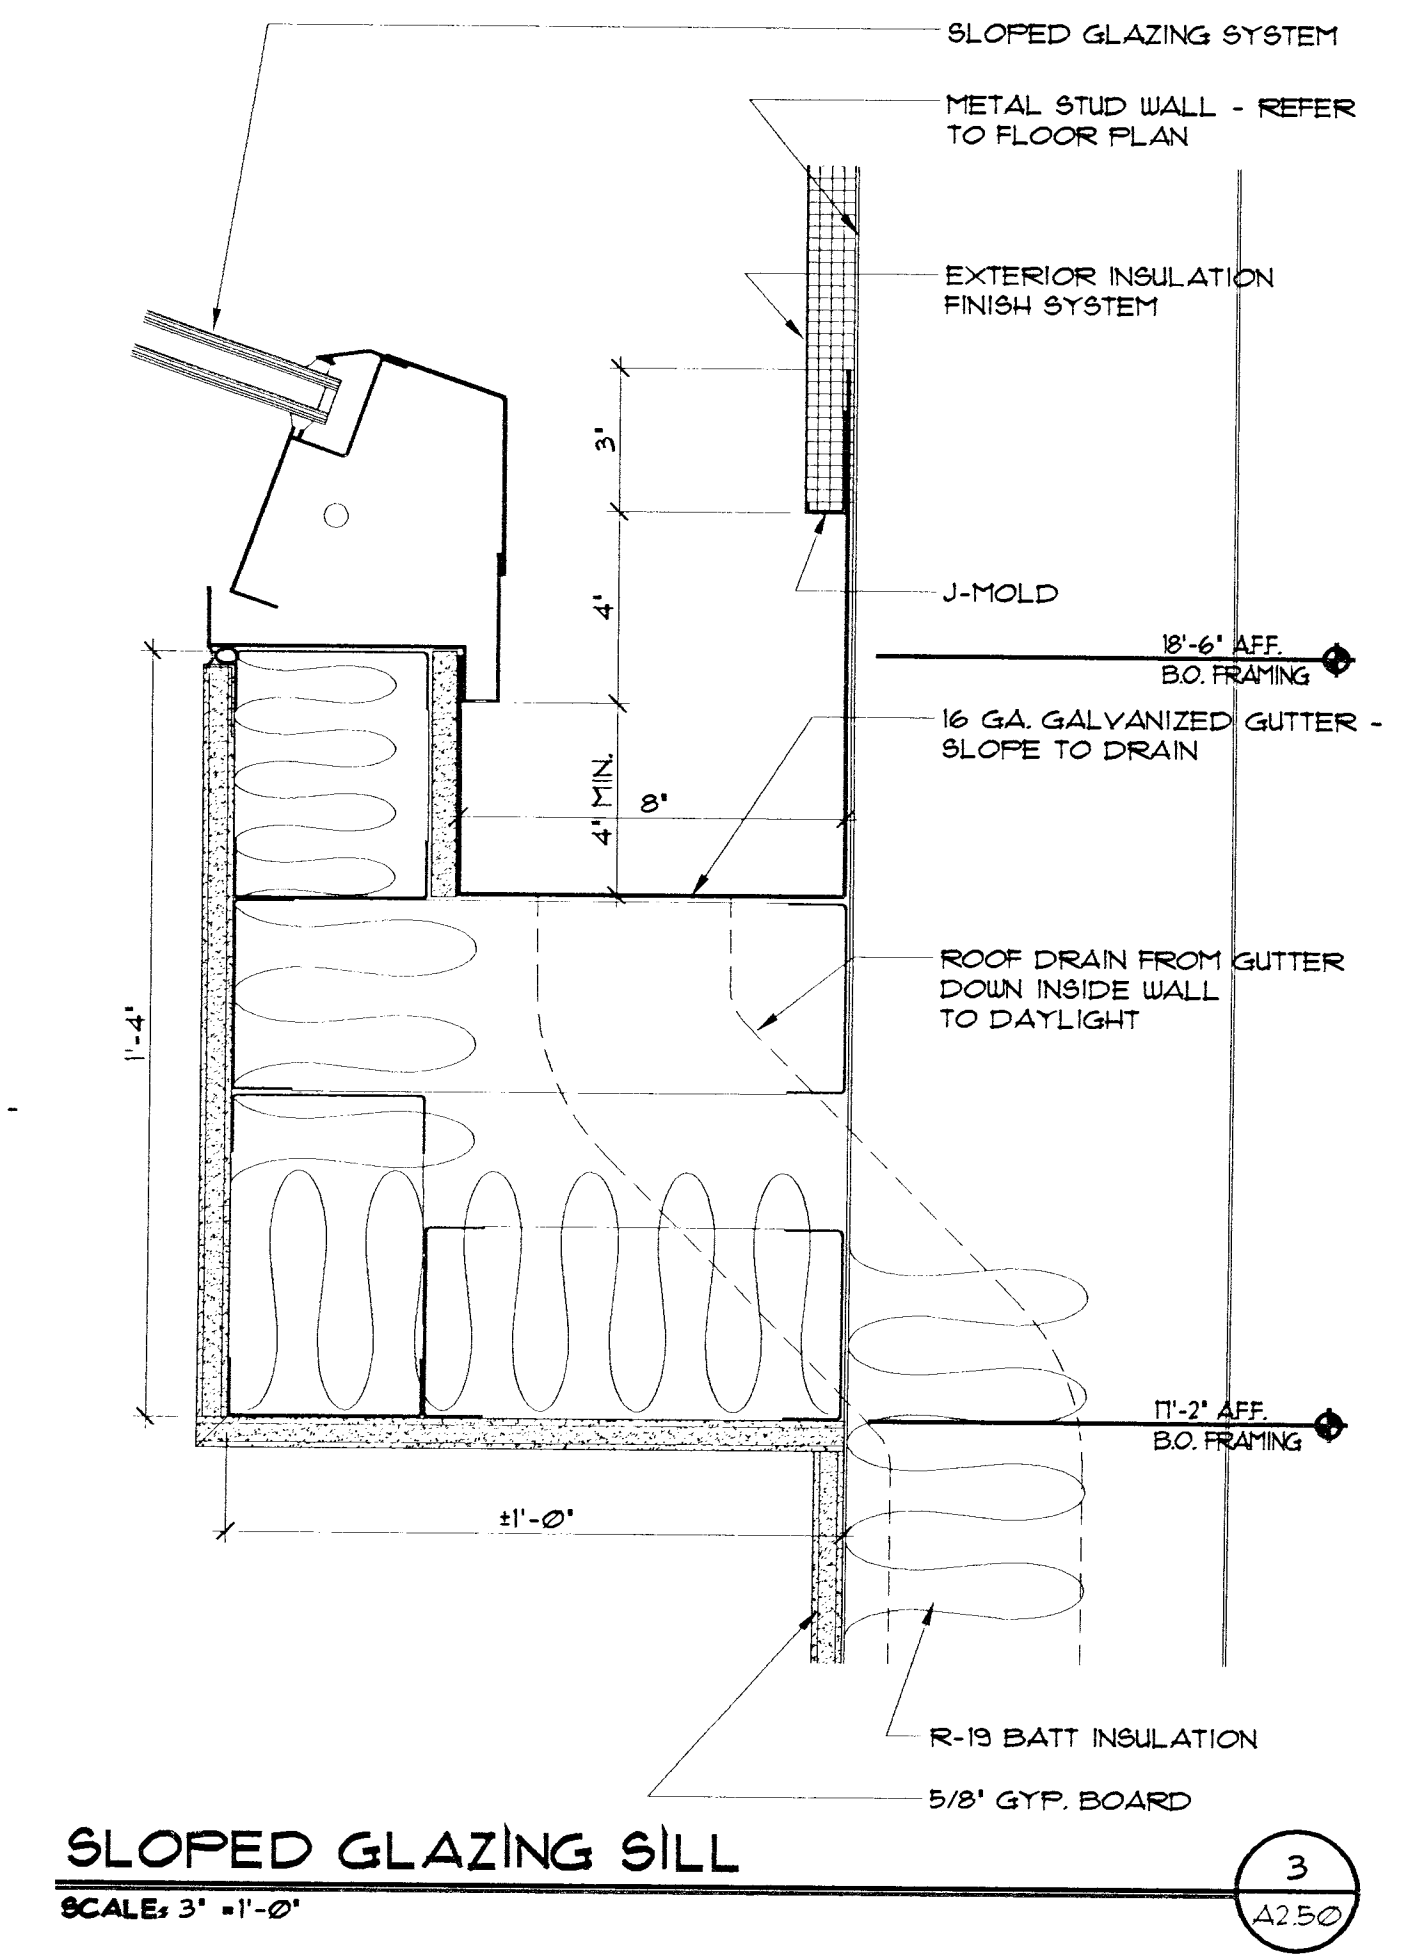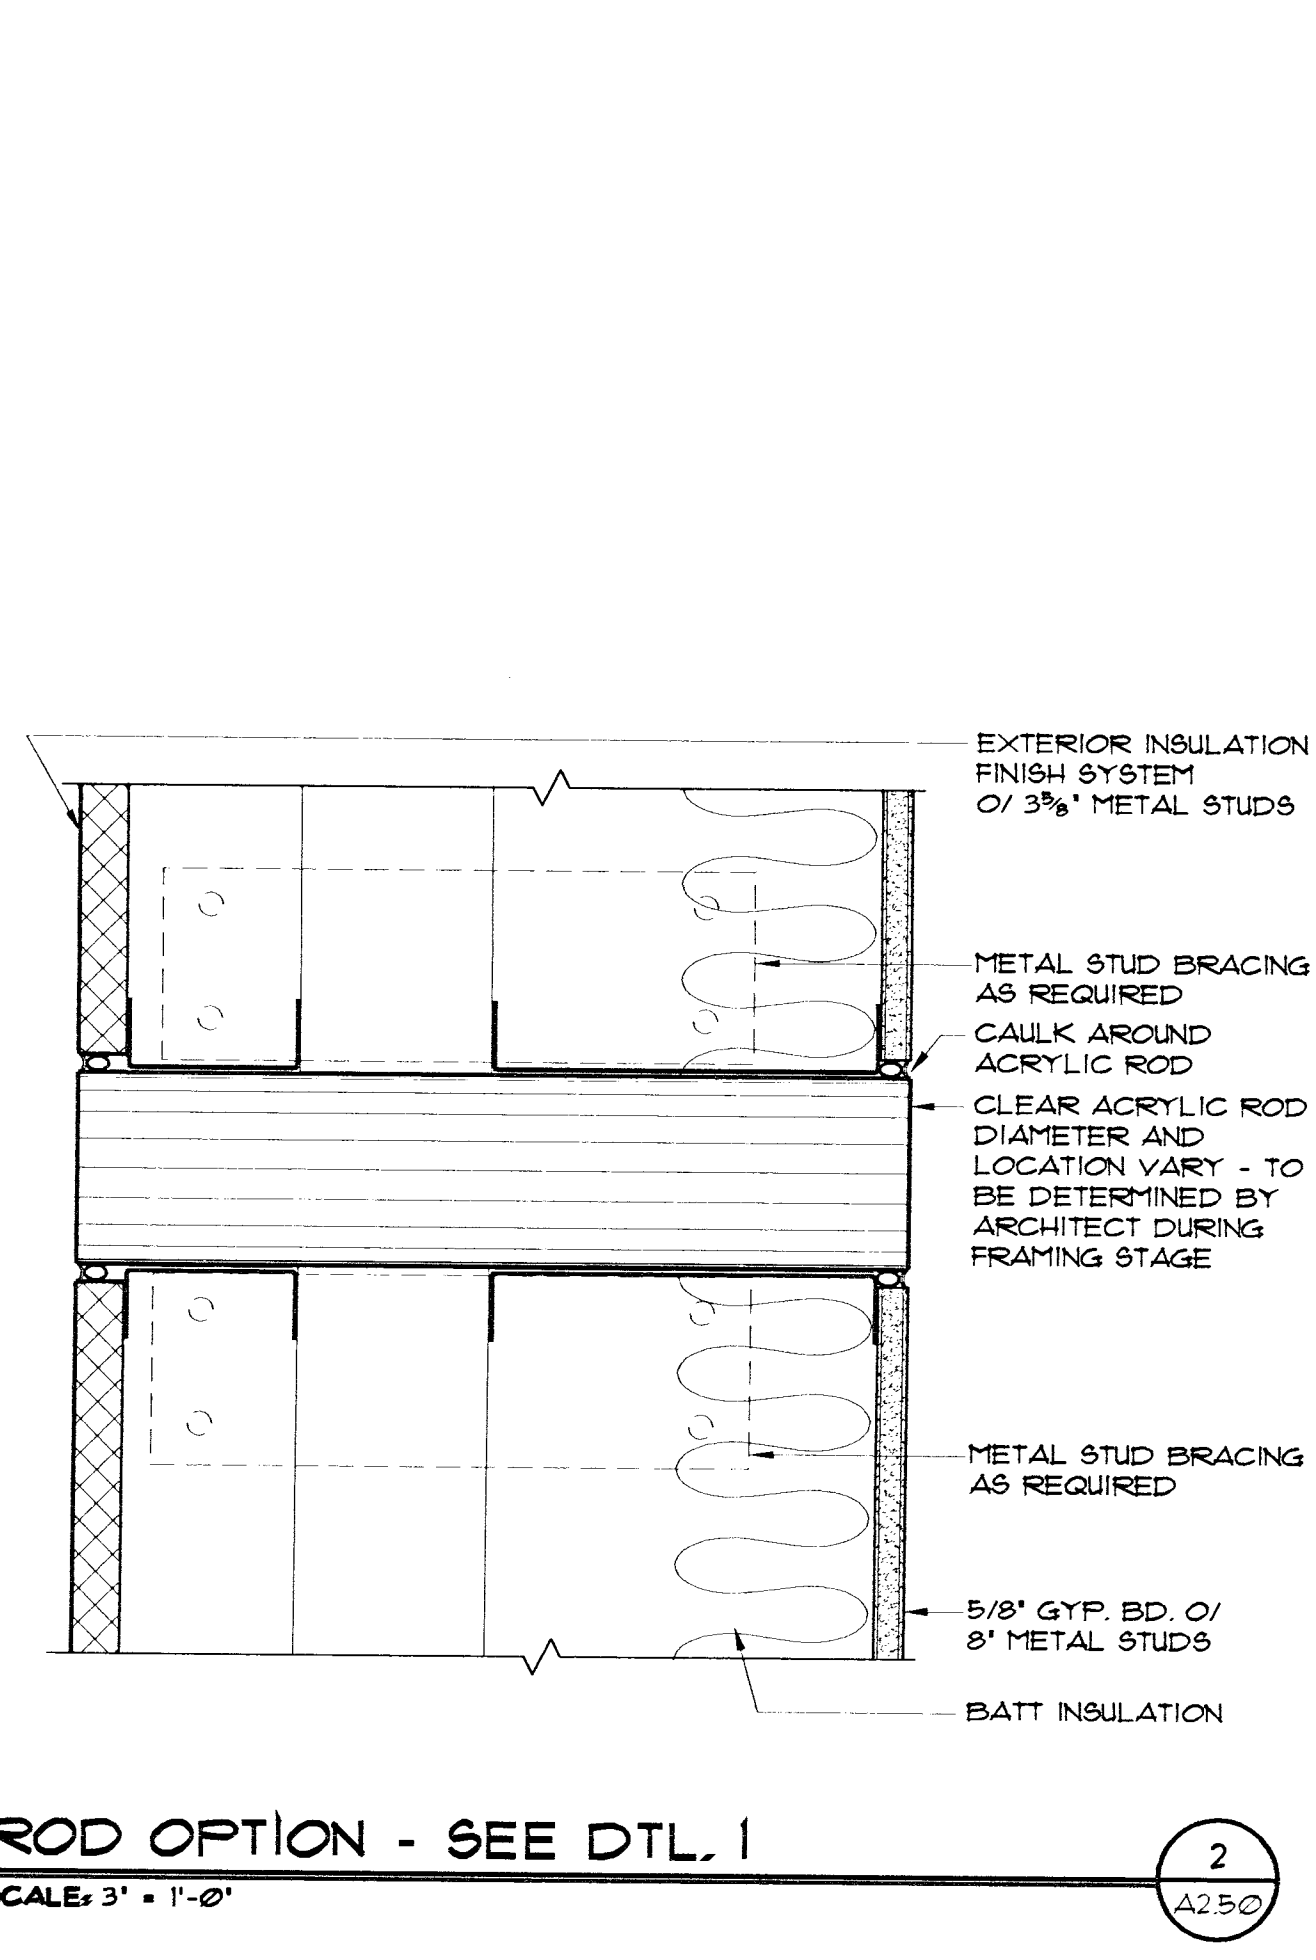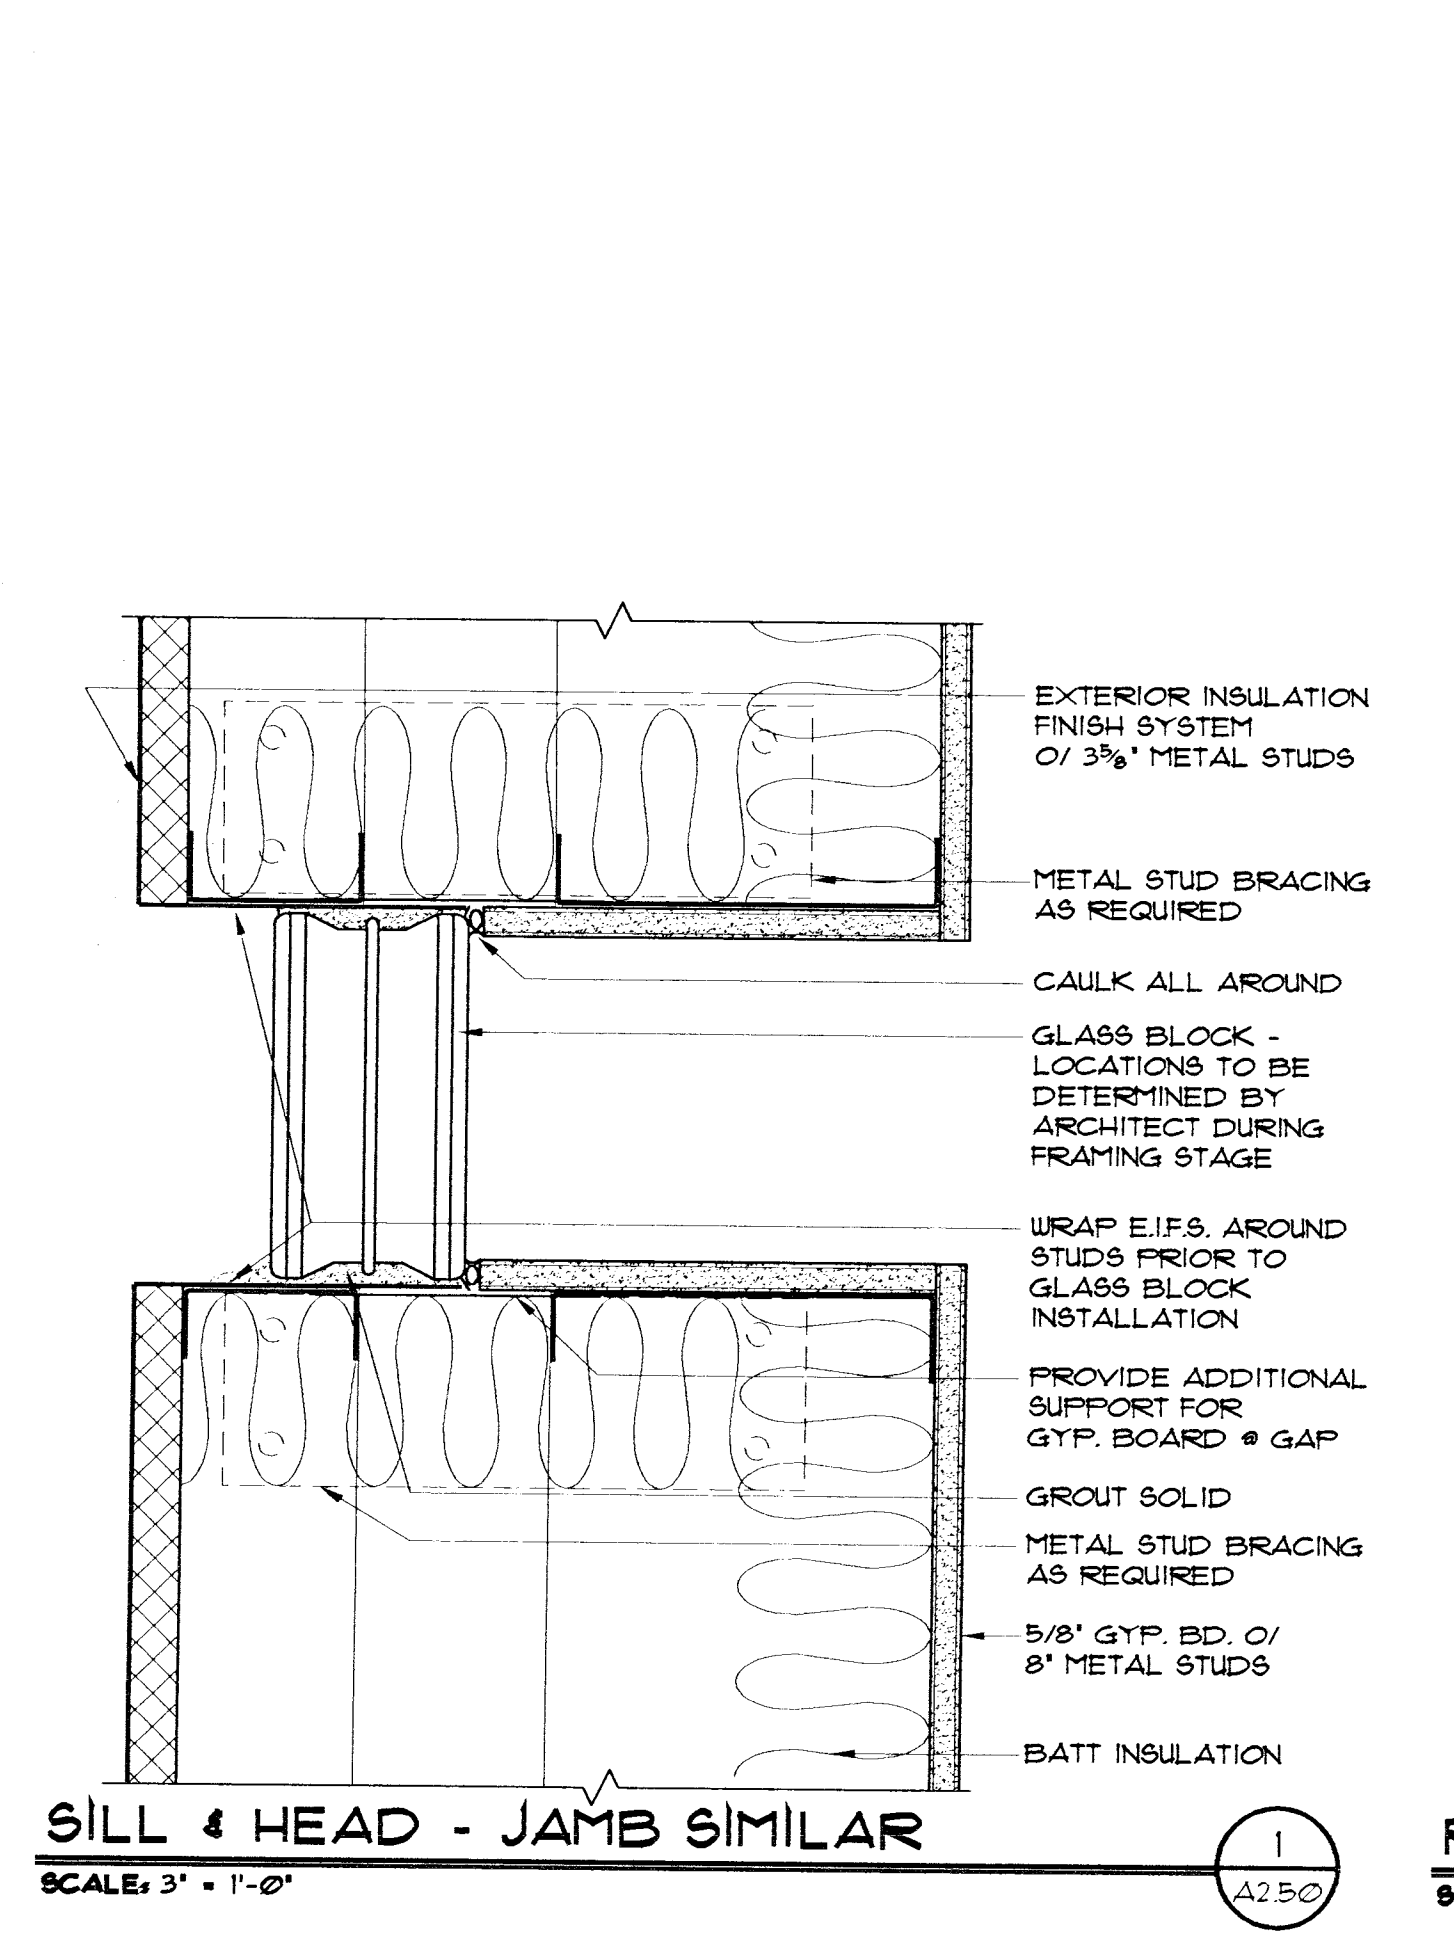

500 PILOT ROAD • SUITE A • LAS VEGAS, NEVADA 89119 • PHONE (702) 263-7111

LUCCHESI GALATI

DOOR SCHEDULE AND TYPES, WINDOW TYPES

SUMMERLIN ARBORS PARK POOL AND POOL BUILDING

PLANS APPROVED ARCHITECTURAL Building & Safety Dept. City of Las Vegas, Nevada

JCC JUN 31 2000

Does Not Include Structural, Electrical, Plumbing/Mechanical or Off-Site Improvements. Make No Change Without Approval. This is Not a Permit to Violate Any Ordinance.

ONE HOUR FIRE-RESISTIVE CONSTRUCTION THROUGHOUT

RECEIVED MAY - 8 2000 CITY OF LAS VEGAS CIVIL ENGINEERING PERMITS

Date: October 22, 1999

Project No. 9903500

Scale: NONE

Drawn By: DDT

Sheet Number: **A2.50**