


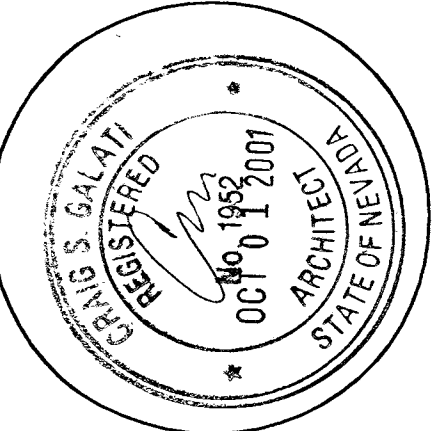

WALL SECTIONS

SUMMERLIN ARBORS PARK
POOL AND POOL BUILDING

APPROVAL IS FOR CLOUDED
AREAS OR LATEST REVISIONS
ONLY SEE ORIGINALS FOR
OTHER REQUIREMENTS.

PLANS APPROVED
ARCHITECTURAL
Building & Safety Dept.
City of Las Vegas, Nevada
JCG DEC 03 2001

Does Not Include Structural, Electrical,
Plumbing, Mechanical or Civil
Improvements. Make No Change
Without Approved Plan Is
Not a Permit to Violate Any Ordinance

Revisions:

Date: October 22, 1999

Project No. 9903500

Scale: 1/4" = 1'-0"

Drawn By: DDT

Sheet Number:

A7.01

387023

RECEIVED
OCT 08 2001
CITY OF LAS VEGAS
GENERAL PERMITS

