




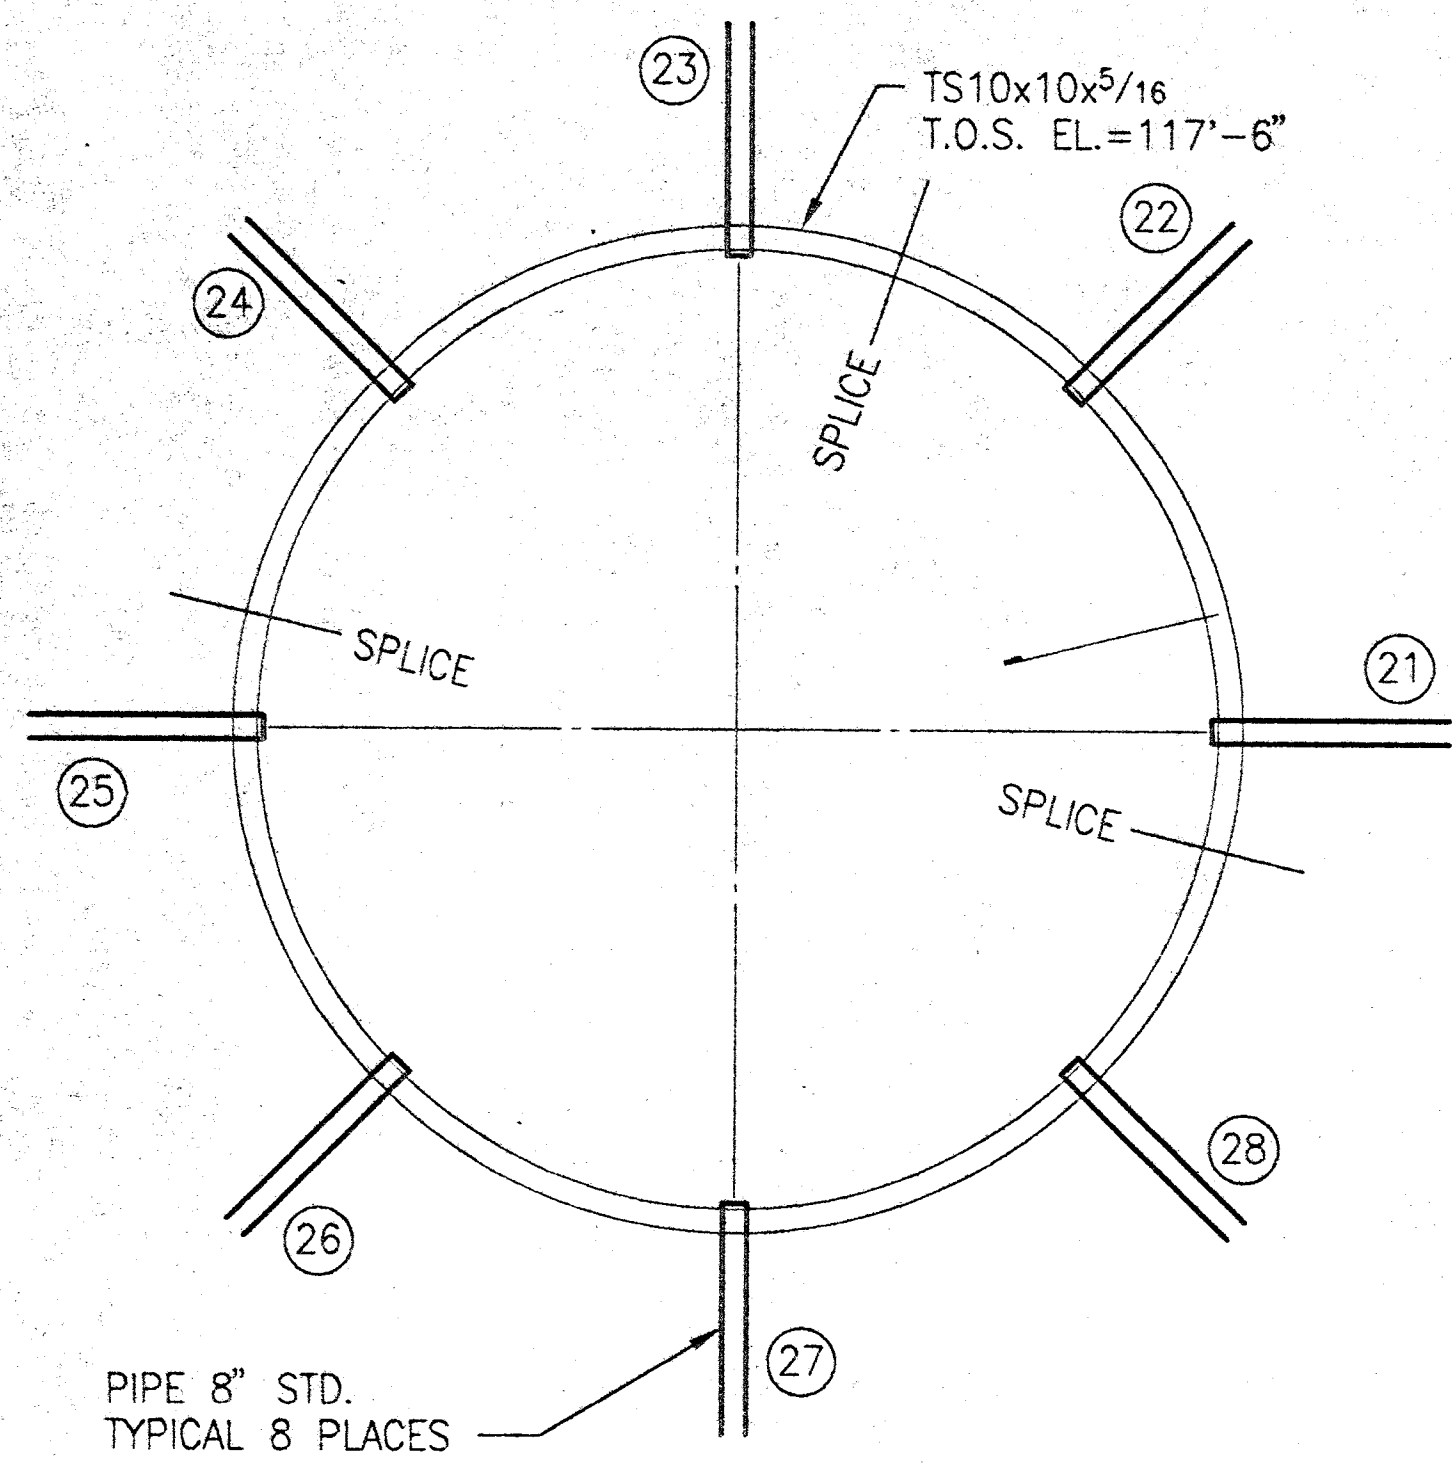


LOW INNER RING HORIZ. FRAMING ③
SCALE : 3/16" = 1'-0"

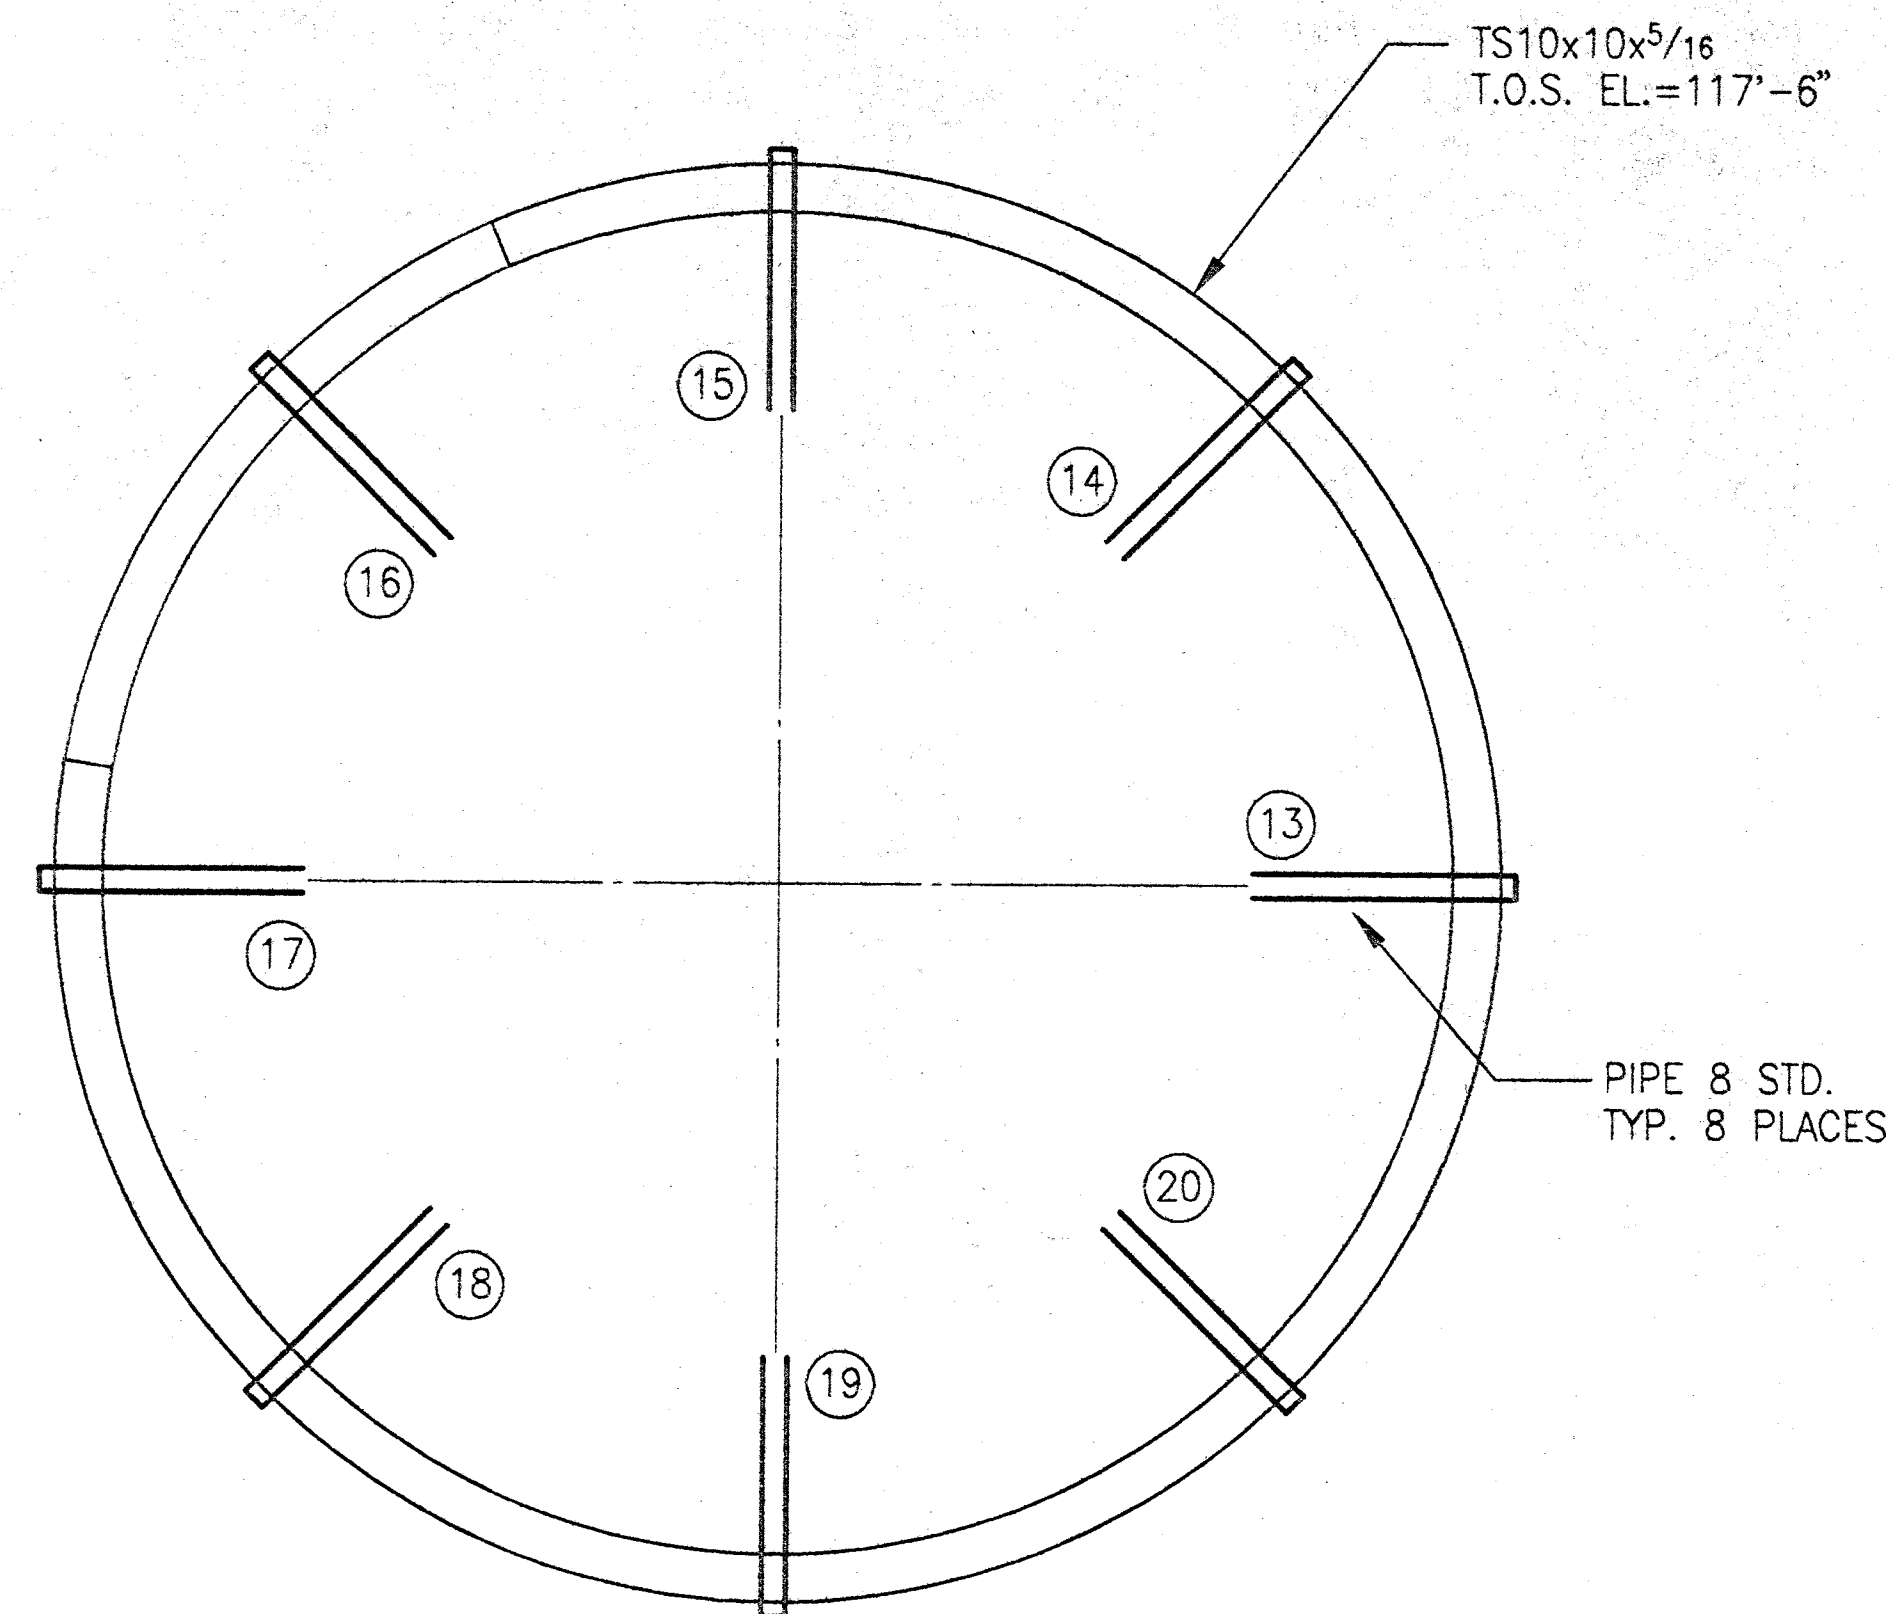


LOW OUTER RING HORIZ. FRAMING ②
SCALE : 3/16" = 1'-0"

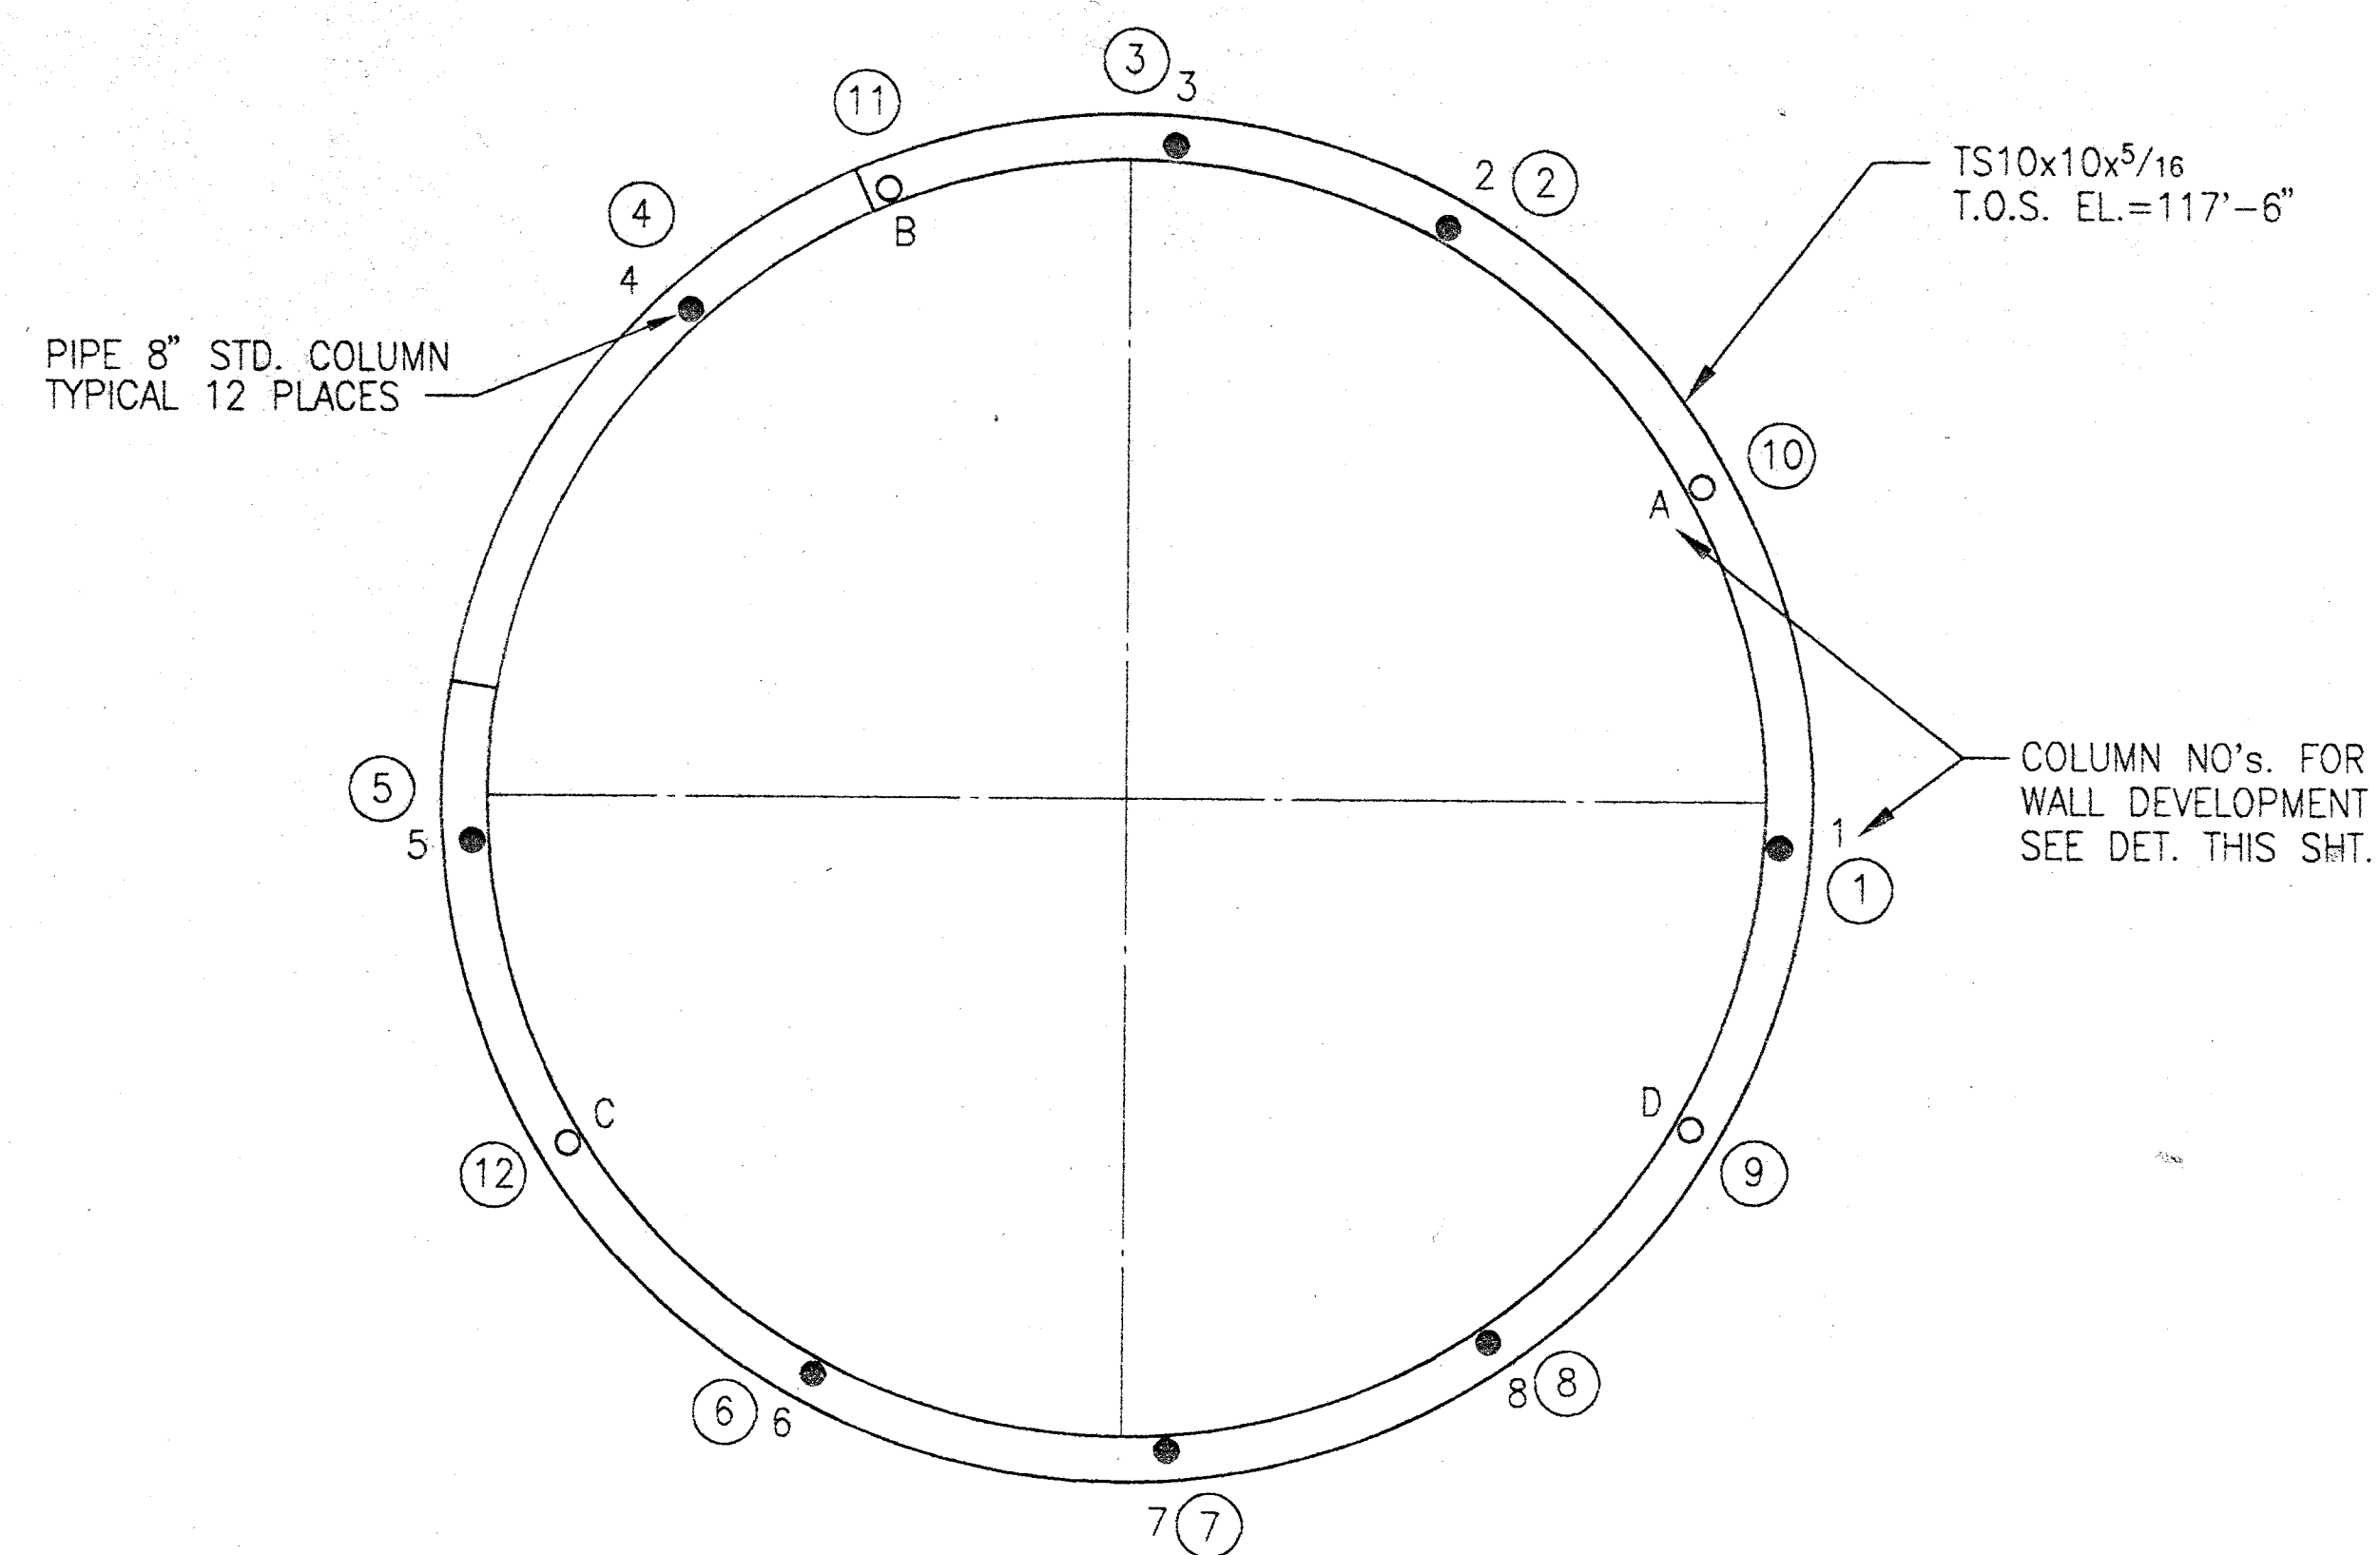


LOW OUTER RING VERT. FRAMING ①
SCALE : 3/16" = 1'-0"

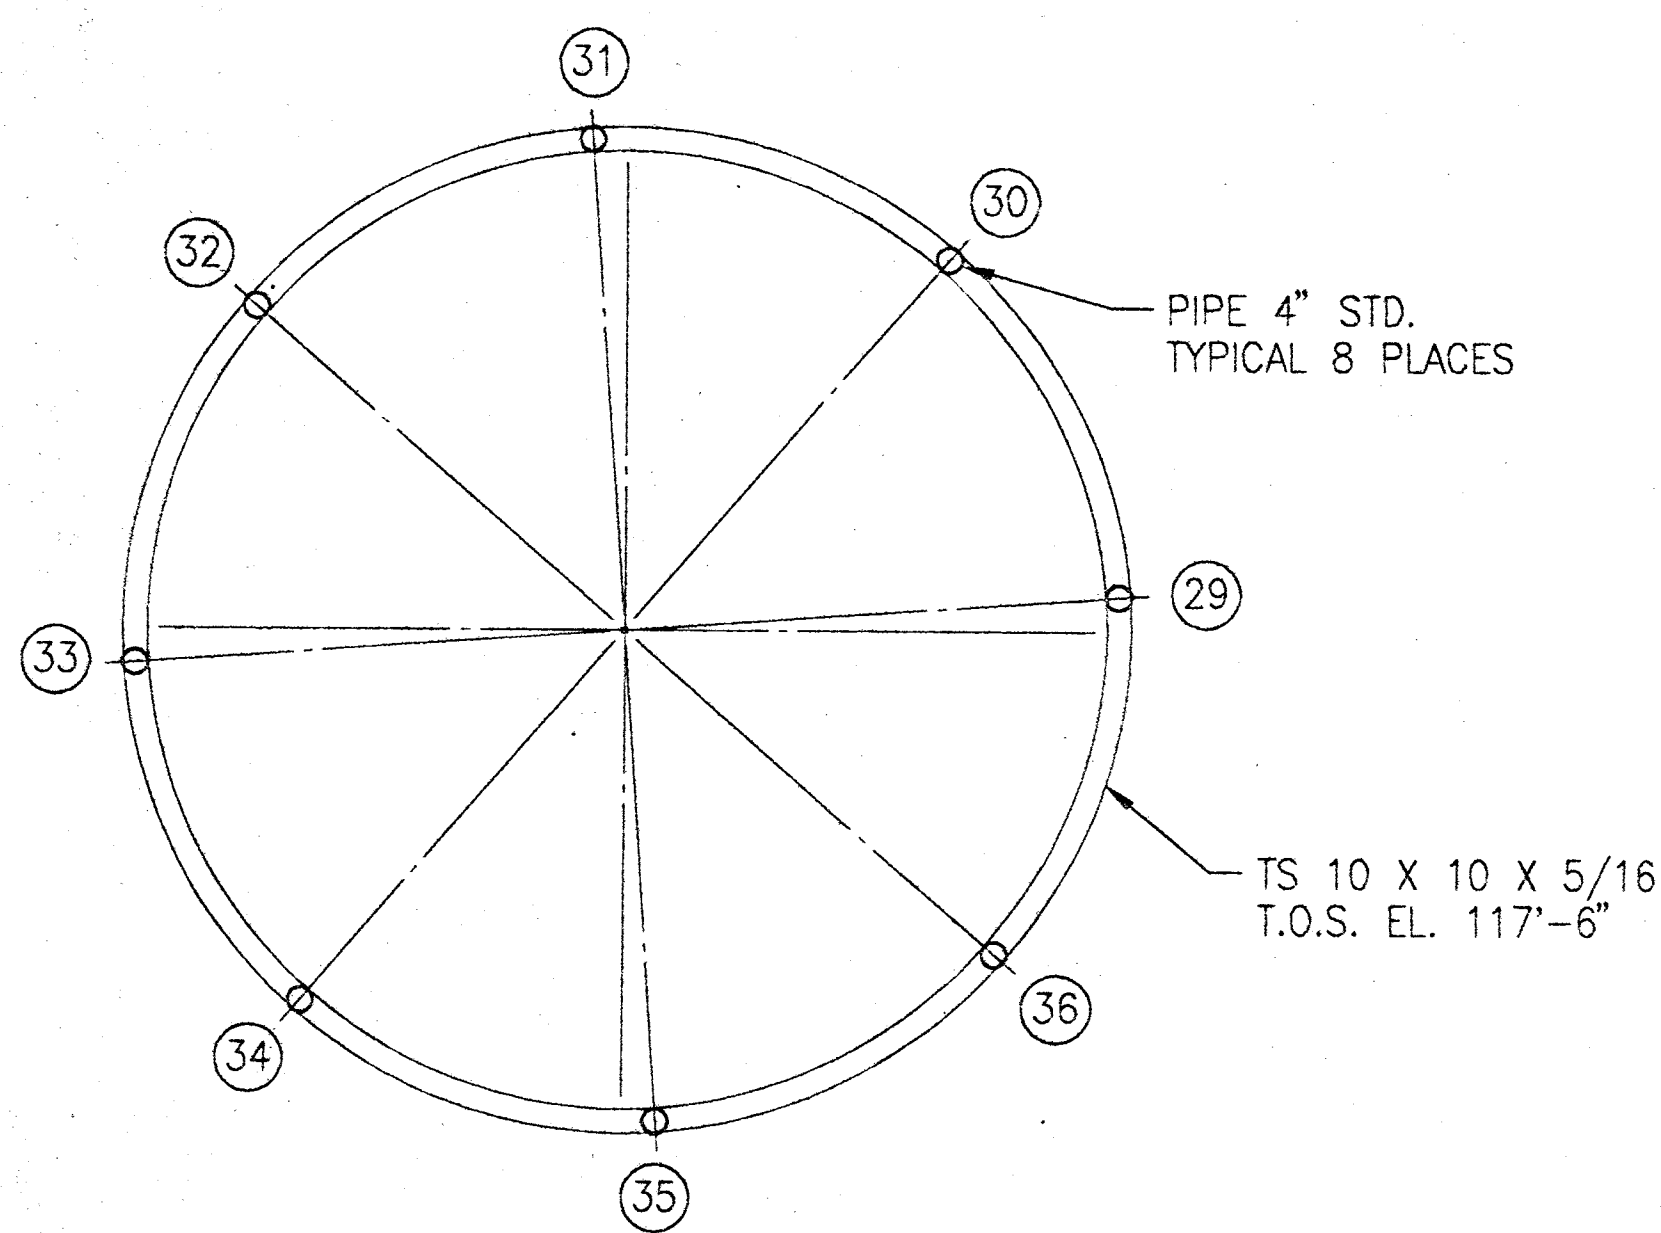

LOW INNER RING VERT. FRAMING ④
SCALE : 3/16" = 1'-0"

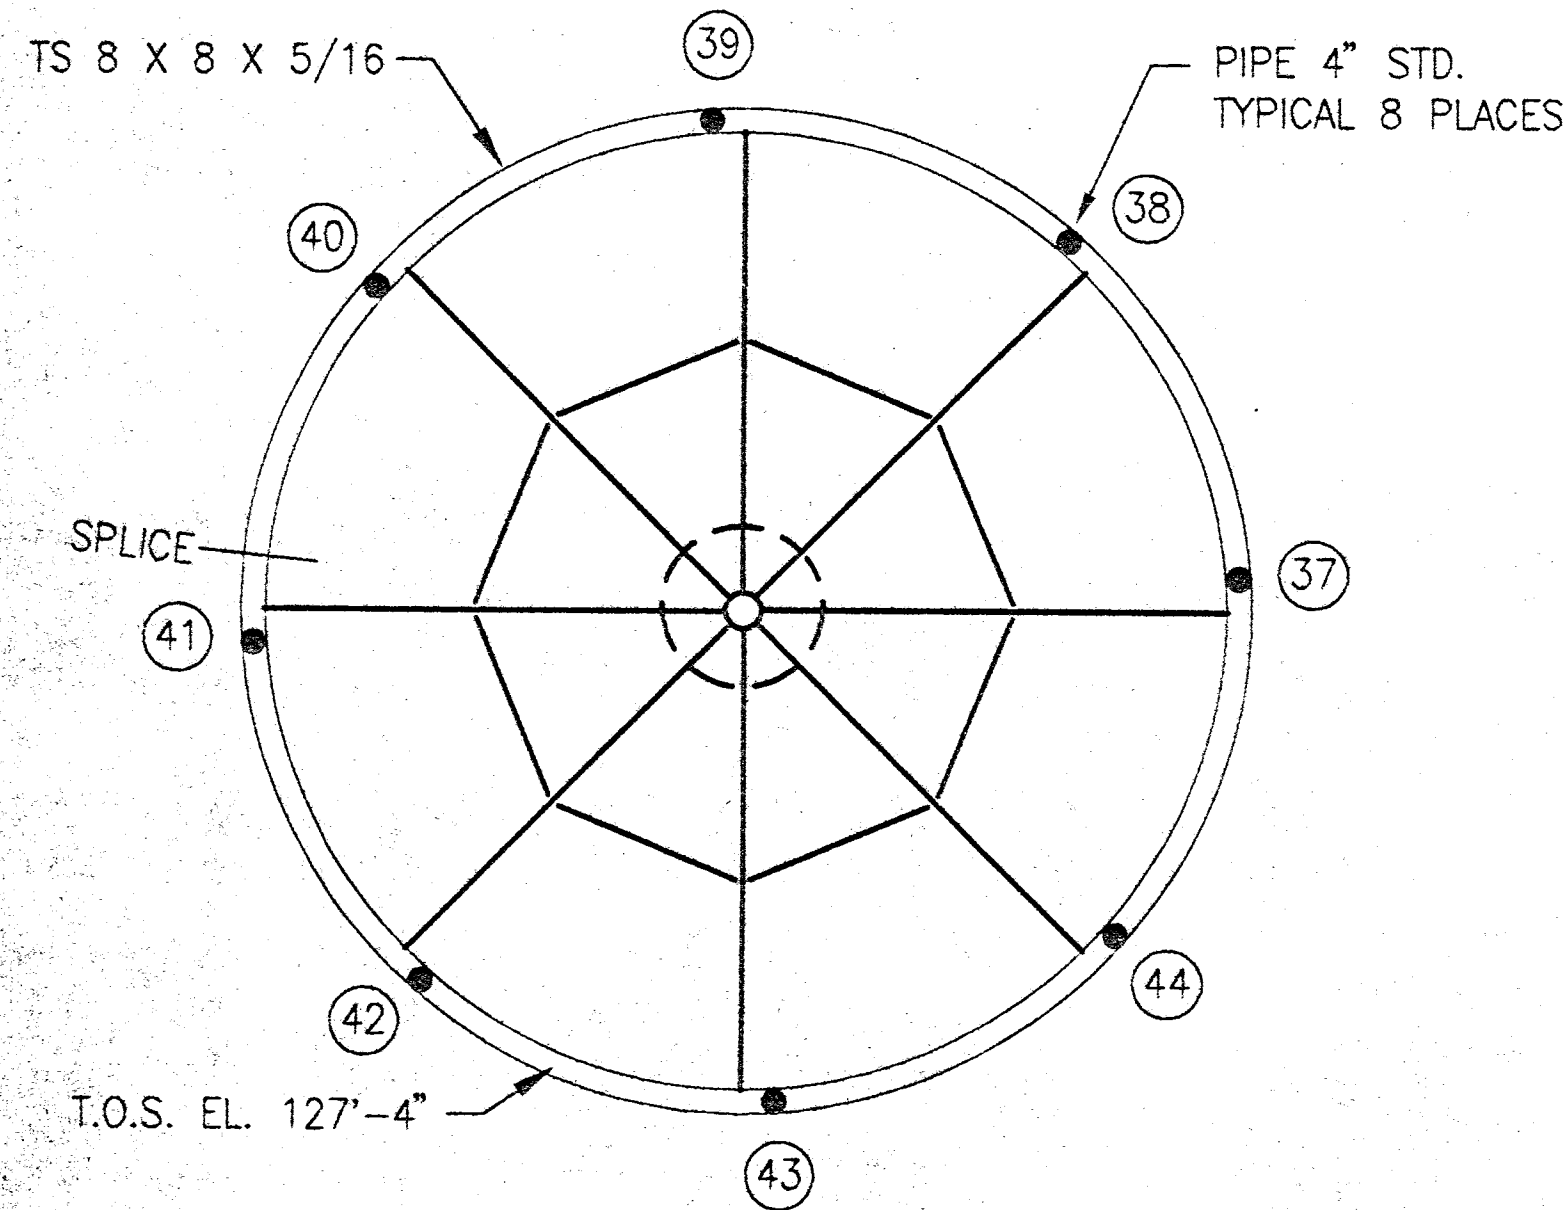

HIGH INNER RING FRAMING ⑤
SCALE : 3/16" = 1'-0"

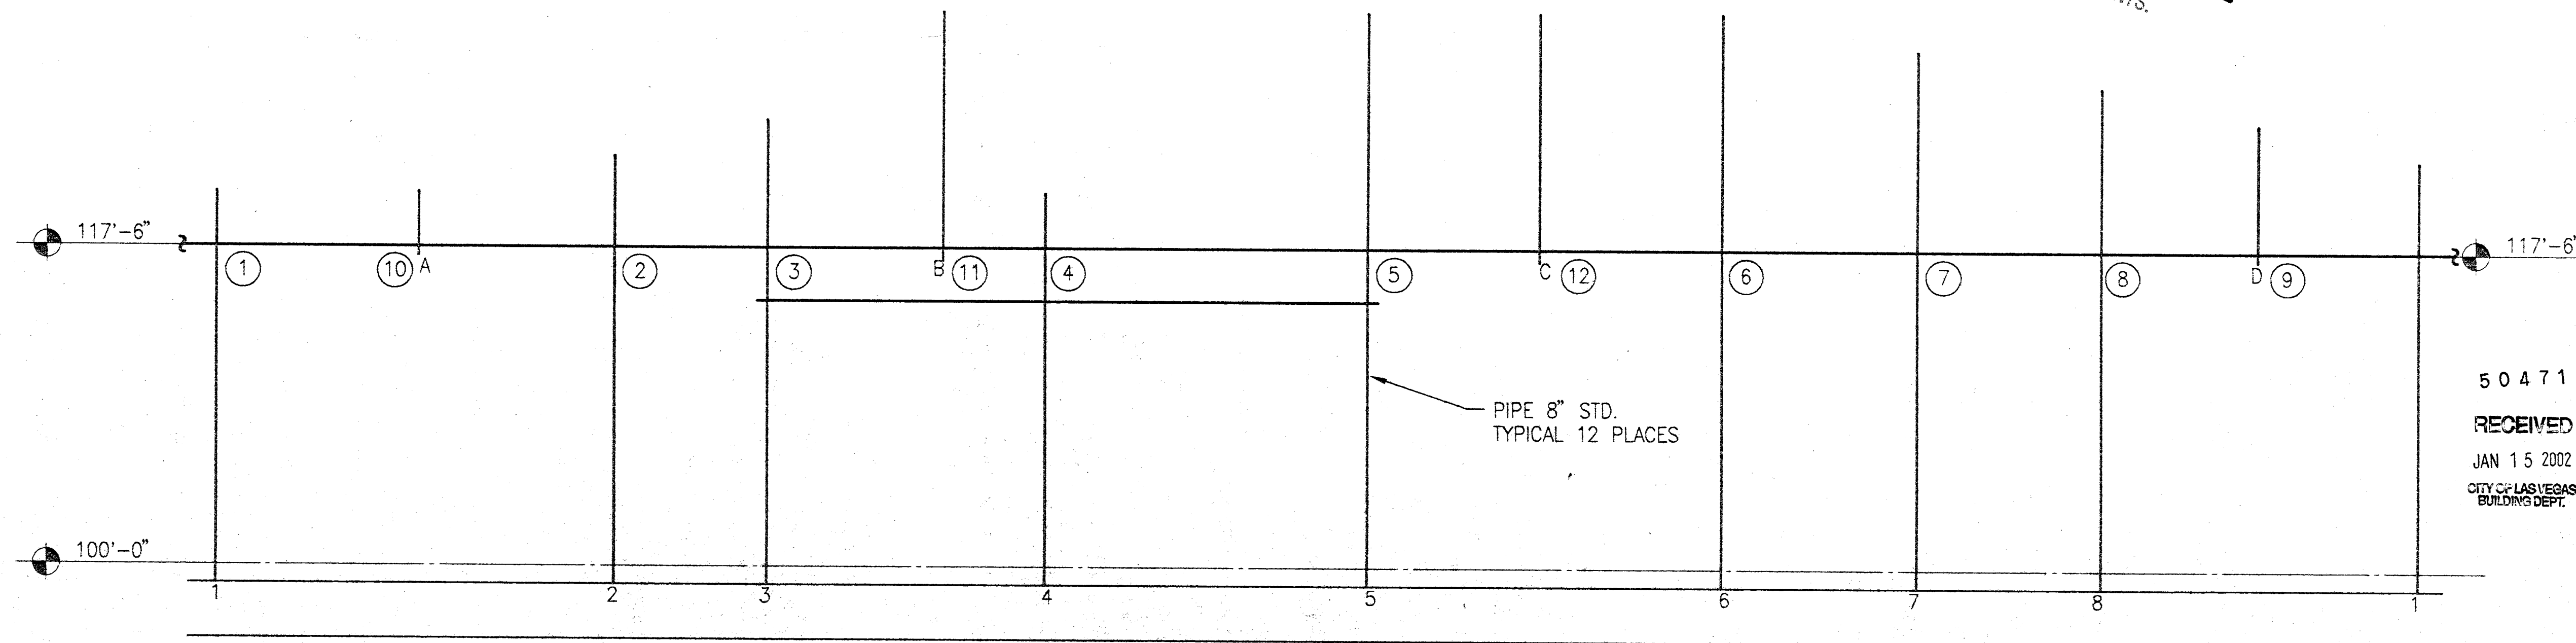

PARTIAL DEVELOPMENT of WALL (LOOKING FROM OUTSIDE, COUNTER CLOCKWISE FROM COL. #1) ⑥

PLANS APPROVED
STRUCTURAL
JAN 30 2002

ALL REMOVAL IS FOR CLOUDED
AREAS ONLY. SEE DETAILS FOR
OTHER REQUIREMENTS.

504717
RECEIVED
JAN 15 2002
CITY OF LAS VEGAS
BUILDING DEPT.

BENNETT & JIMENEZ INC.
STRUCTURAL ENGINEERS
2401 N. Decatur Blvd.
Suite 8
Las Vegas, NV 89108
B&J JOB NO. 11008
Phone (702) 631-0200
Fax (702) 631-0205

LUCCHESI • GALATI •
ARCHITECTS
DEC 07 2001

JOINT REPAIRS

SUMMERLIN SPORT PARK

POOL BUILDING

Sheet Number: **S5.05**

Date: December 05, 2001
Project No.:
Scale: 3/16" = 1'-0"
Drawn By: REB

Revisions:

18 '98

11008.S5.05 PLOTTED BY: RYAN DATE: 12/06/01 TIME: 11:07 SCALE FACTOR: 1.00 PLOT: 04/01