


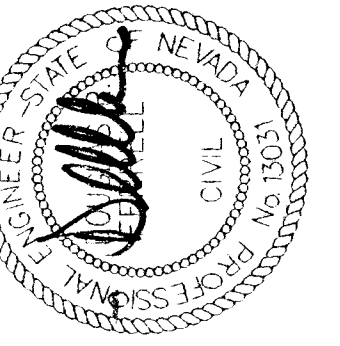

AQUATIC GROUP
90 BELLEGG AVE.
LAS VEGAS, NEVADA 89119
TEL: 702-488-4400
FAX: 702-488-4401

SWIMMING POOL SECTIONS

**SUMMERLIN ARBORS PARK
POOL AND POOL BUILDING**

RECEIVED
MAY - 4 2000
CITY OF LAS VEGAS
CENTRAL PLUMBING

Revisions:
4/03/00 HD, CORR

Sheet Number:


Date: OCTOBER 22, 1999

Project No. 98035-00


Scale: 1/8" = 1'-0"

Drawn By: NFC


SP-4

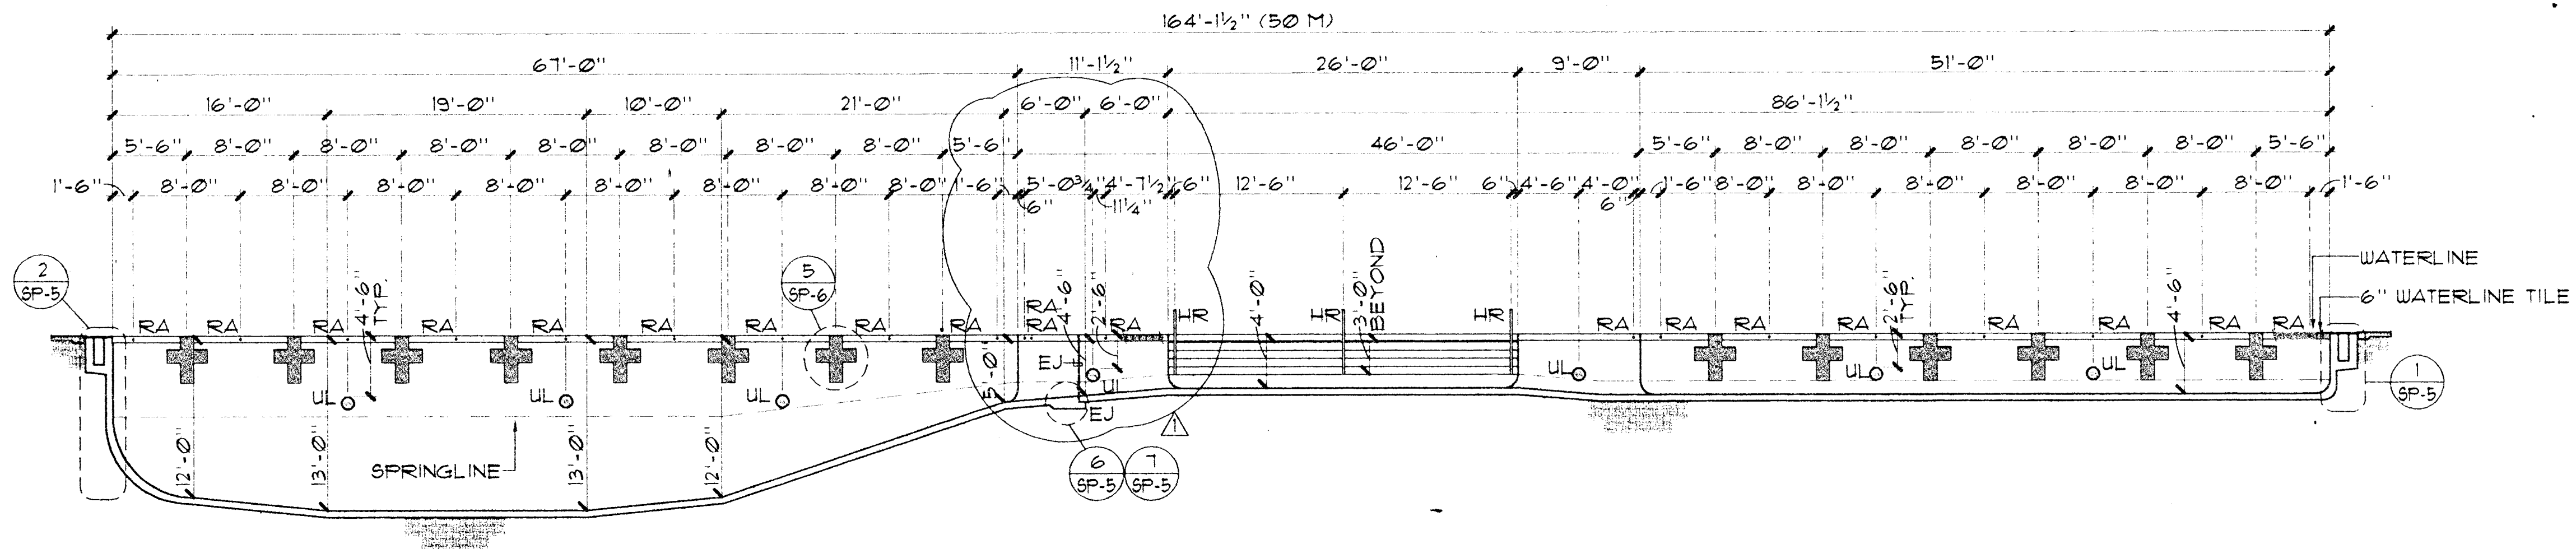


A **SWIMMING POOL SECTION** 1/8" = 1'-0"

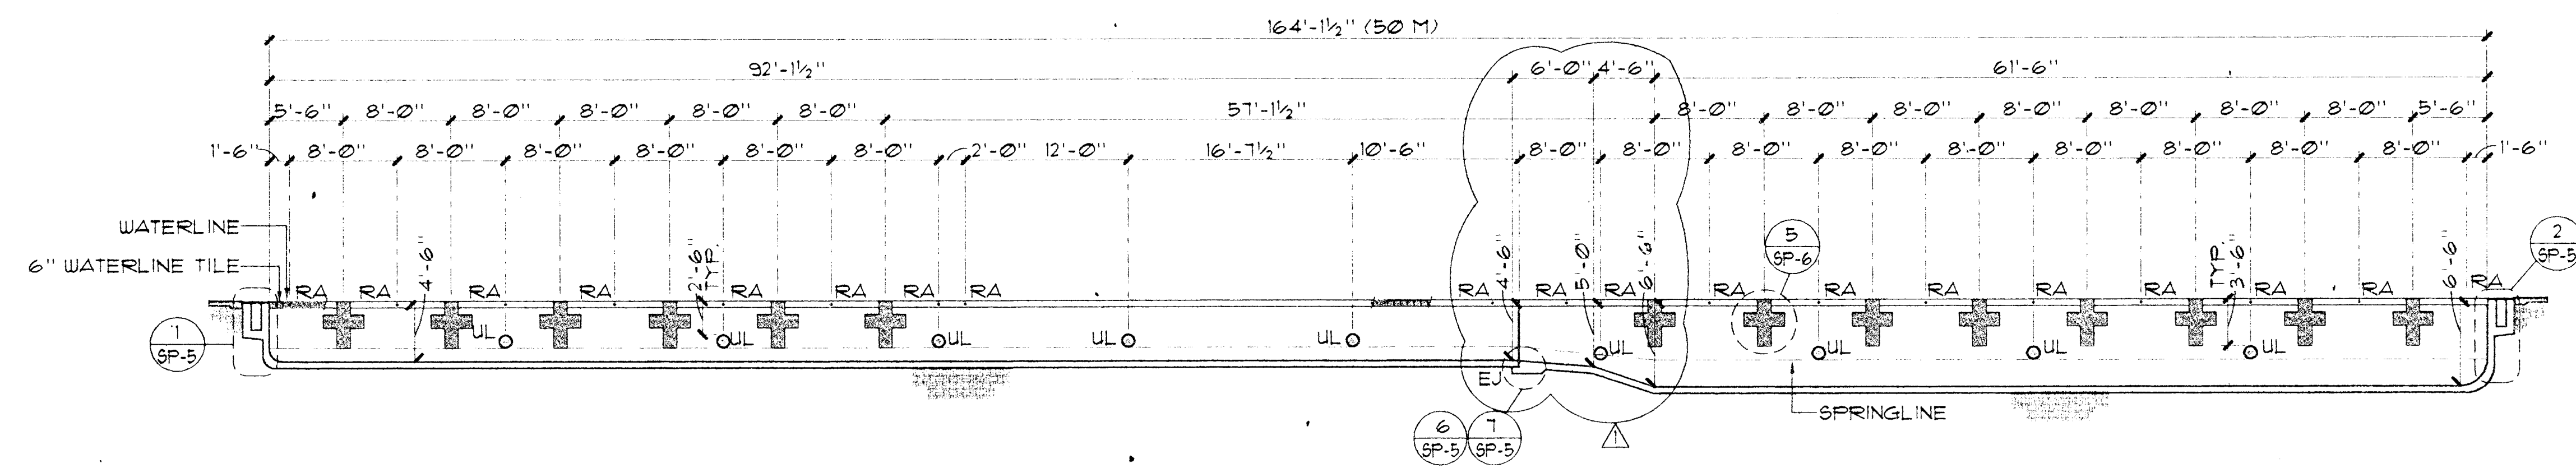


B **SWIMMING POOL SECTION** 1/8" = 1'-0"

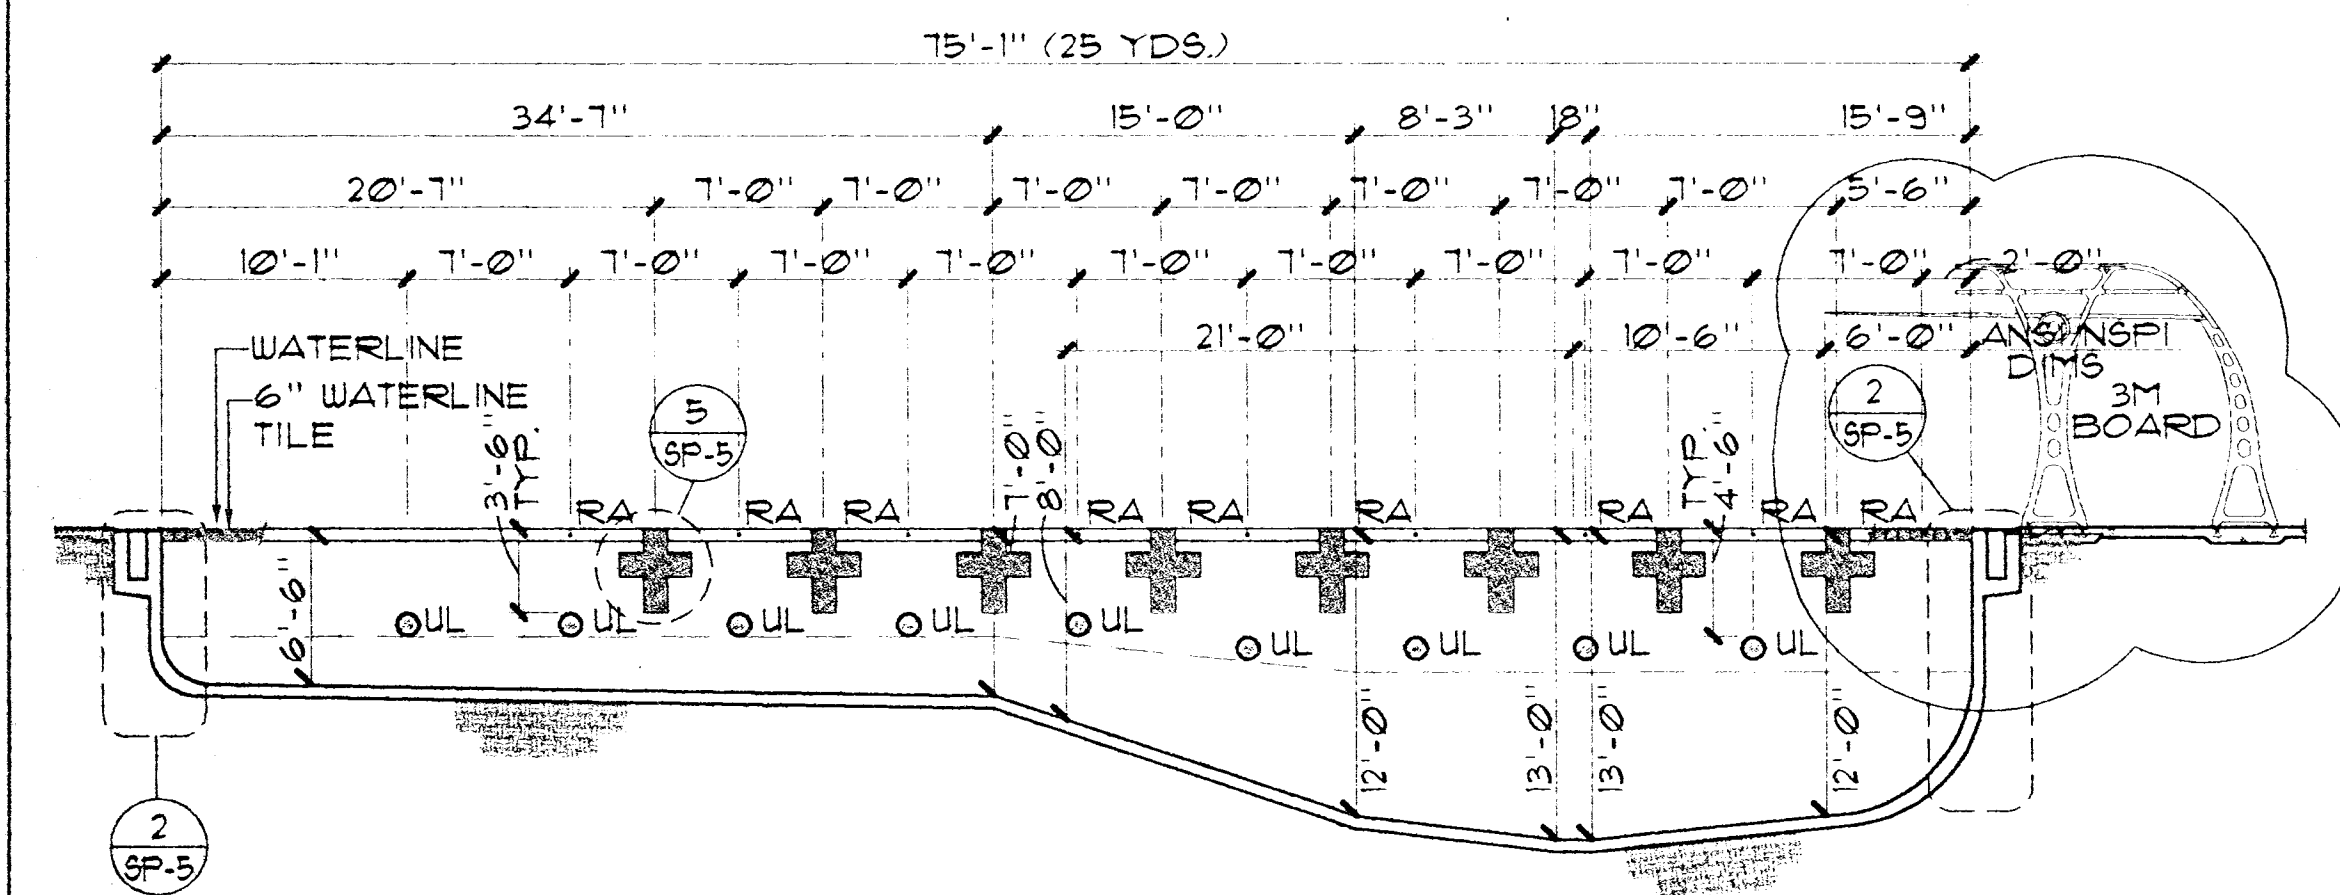

C **SWIMMING POOL SECTION** 1/8" = 1'-0"

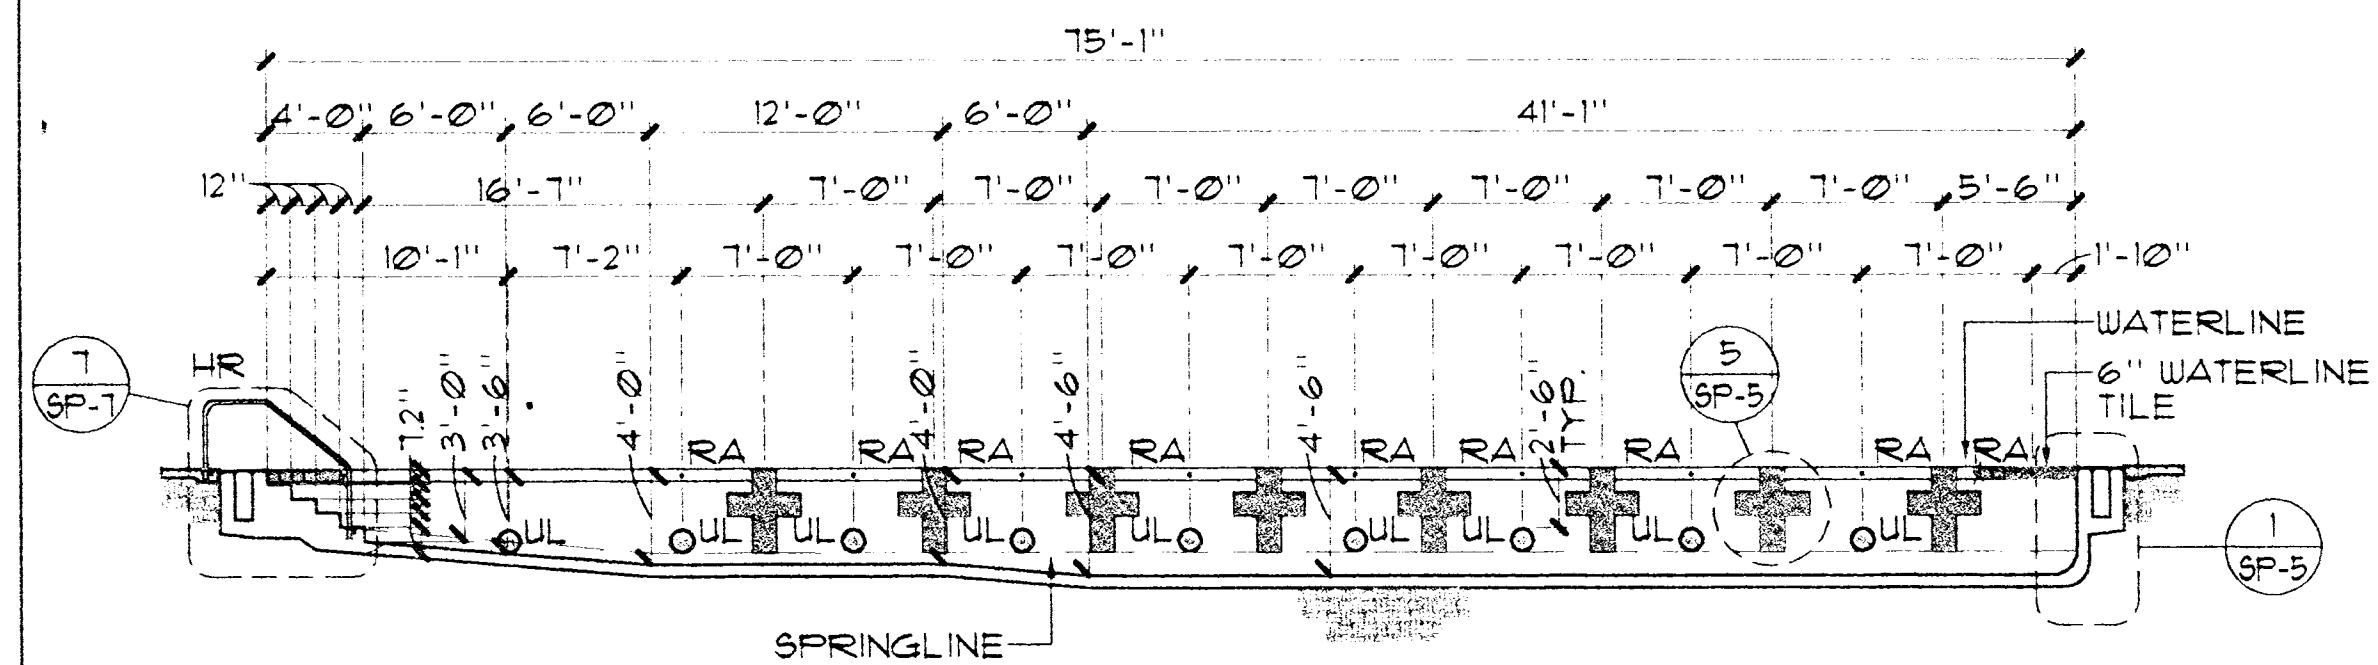

D **SWIMMING POOL SECTION** 1/8" = 1'-0"

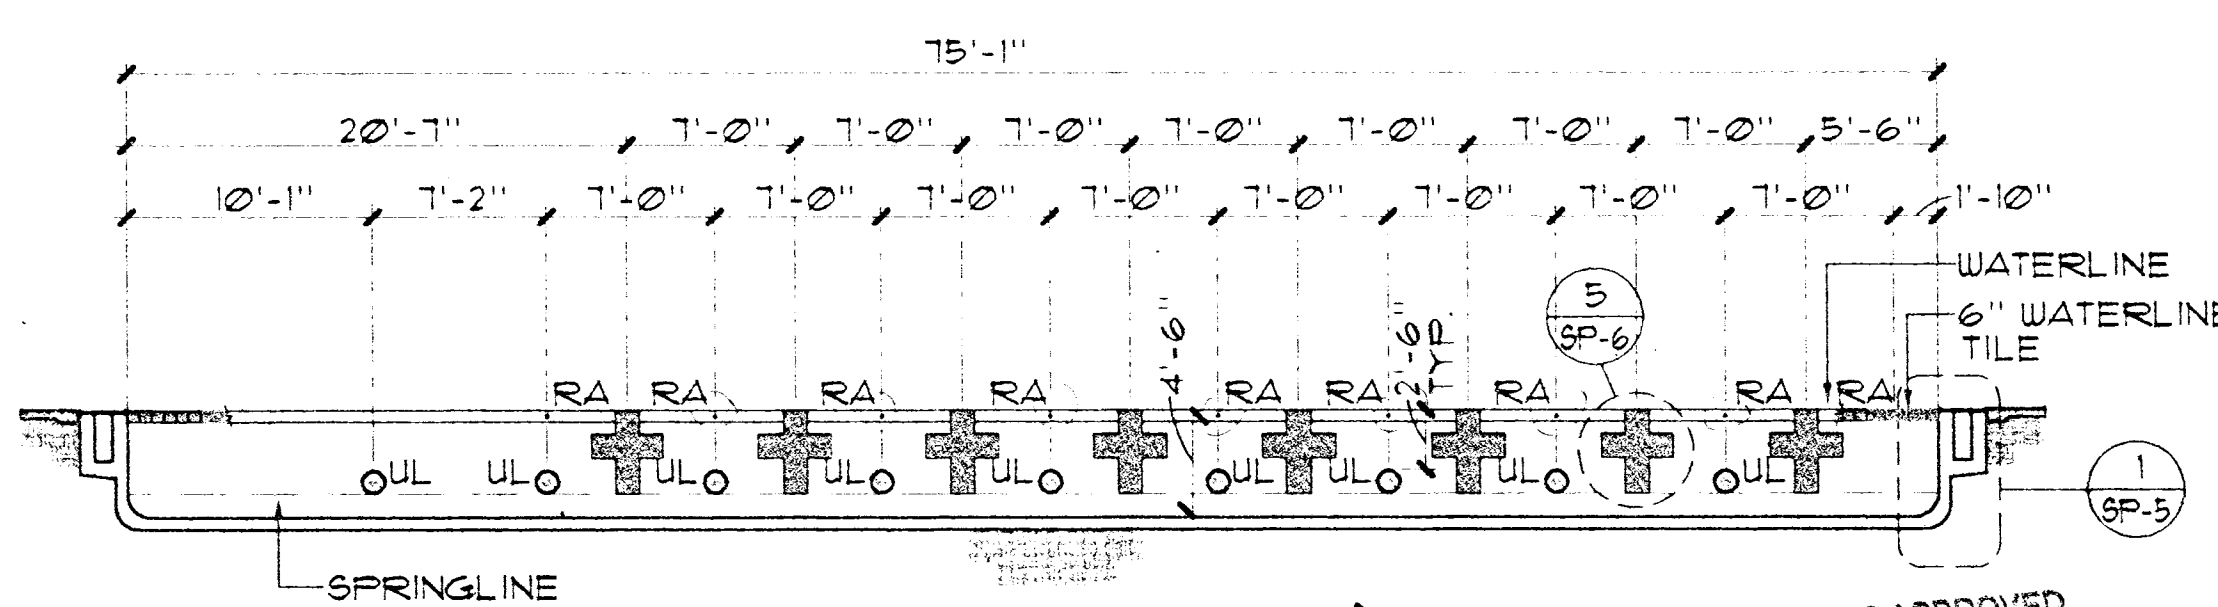

E **SWIMMING POOL SECTION** 1/8" = 1'-0"

PLANS APPROVED
PLUMBING/MECHANICAL
REVISIONS
DATE: AUG 01 2000
BY: [Signature]
DO NOT SCALE DIMENSIONS
FOR CONSTRUCTION
ALL DIMENSIONS ARE TO FACE UNLESS NOTED OTHERWISE
NOT A PERMIT TO VIOLATE ANY CODES