



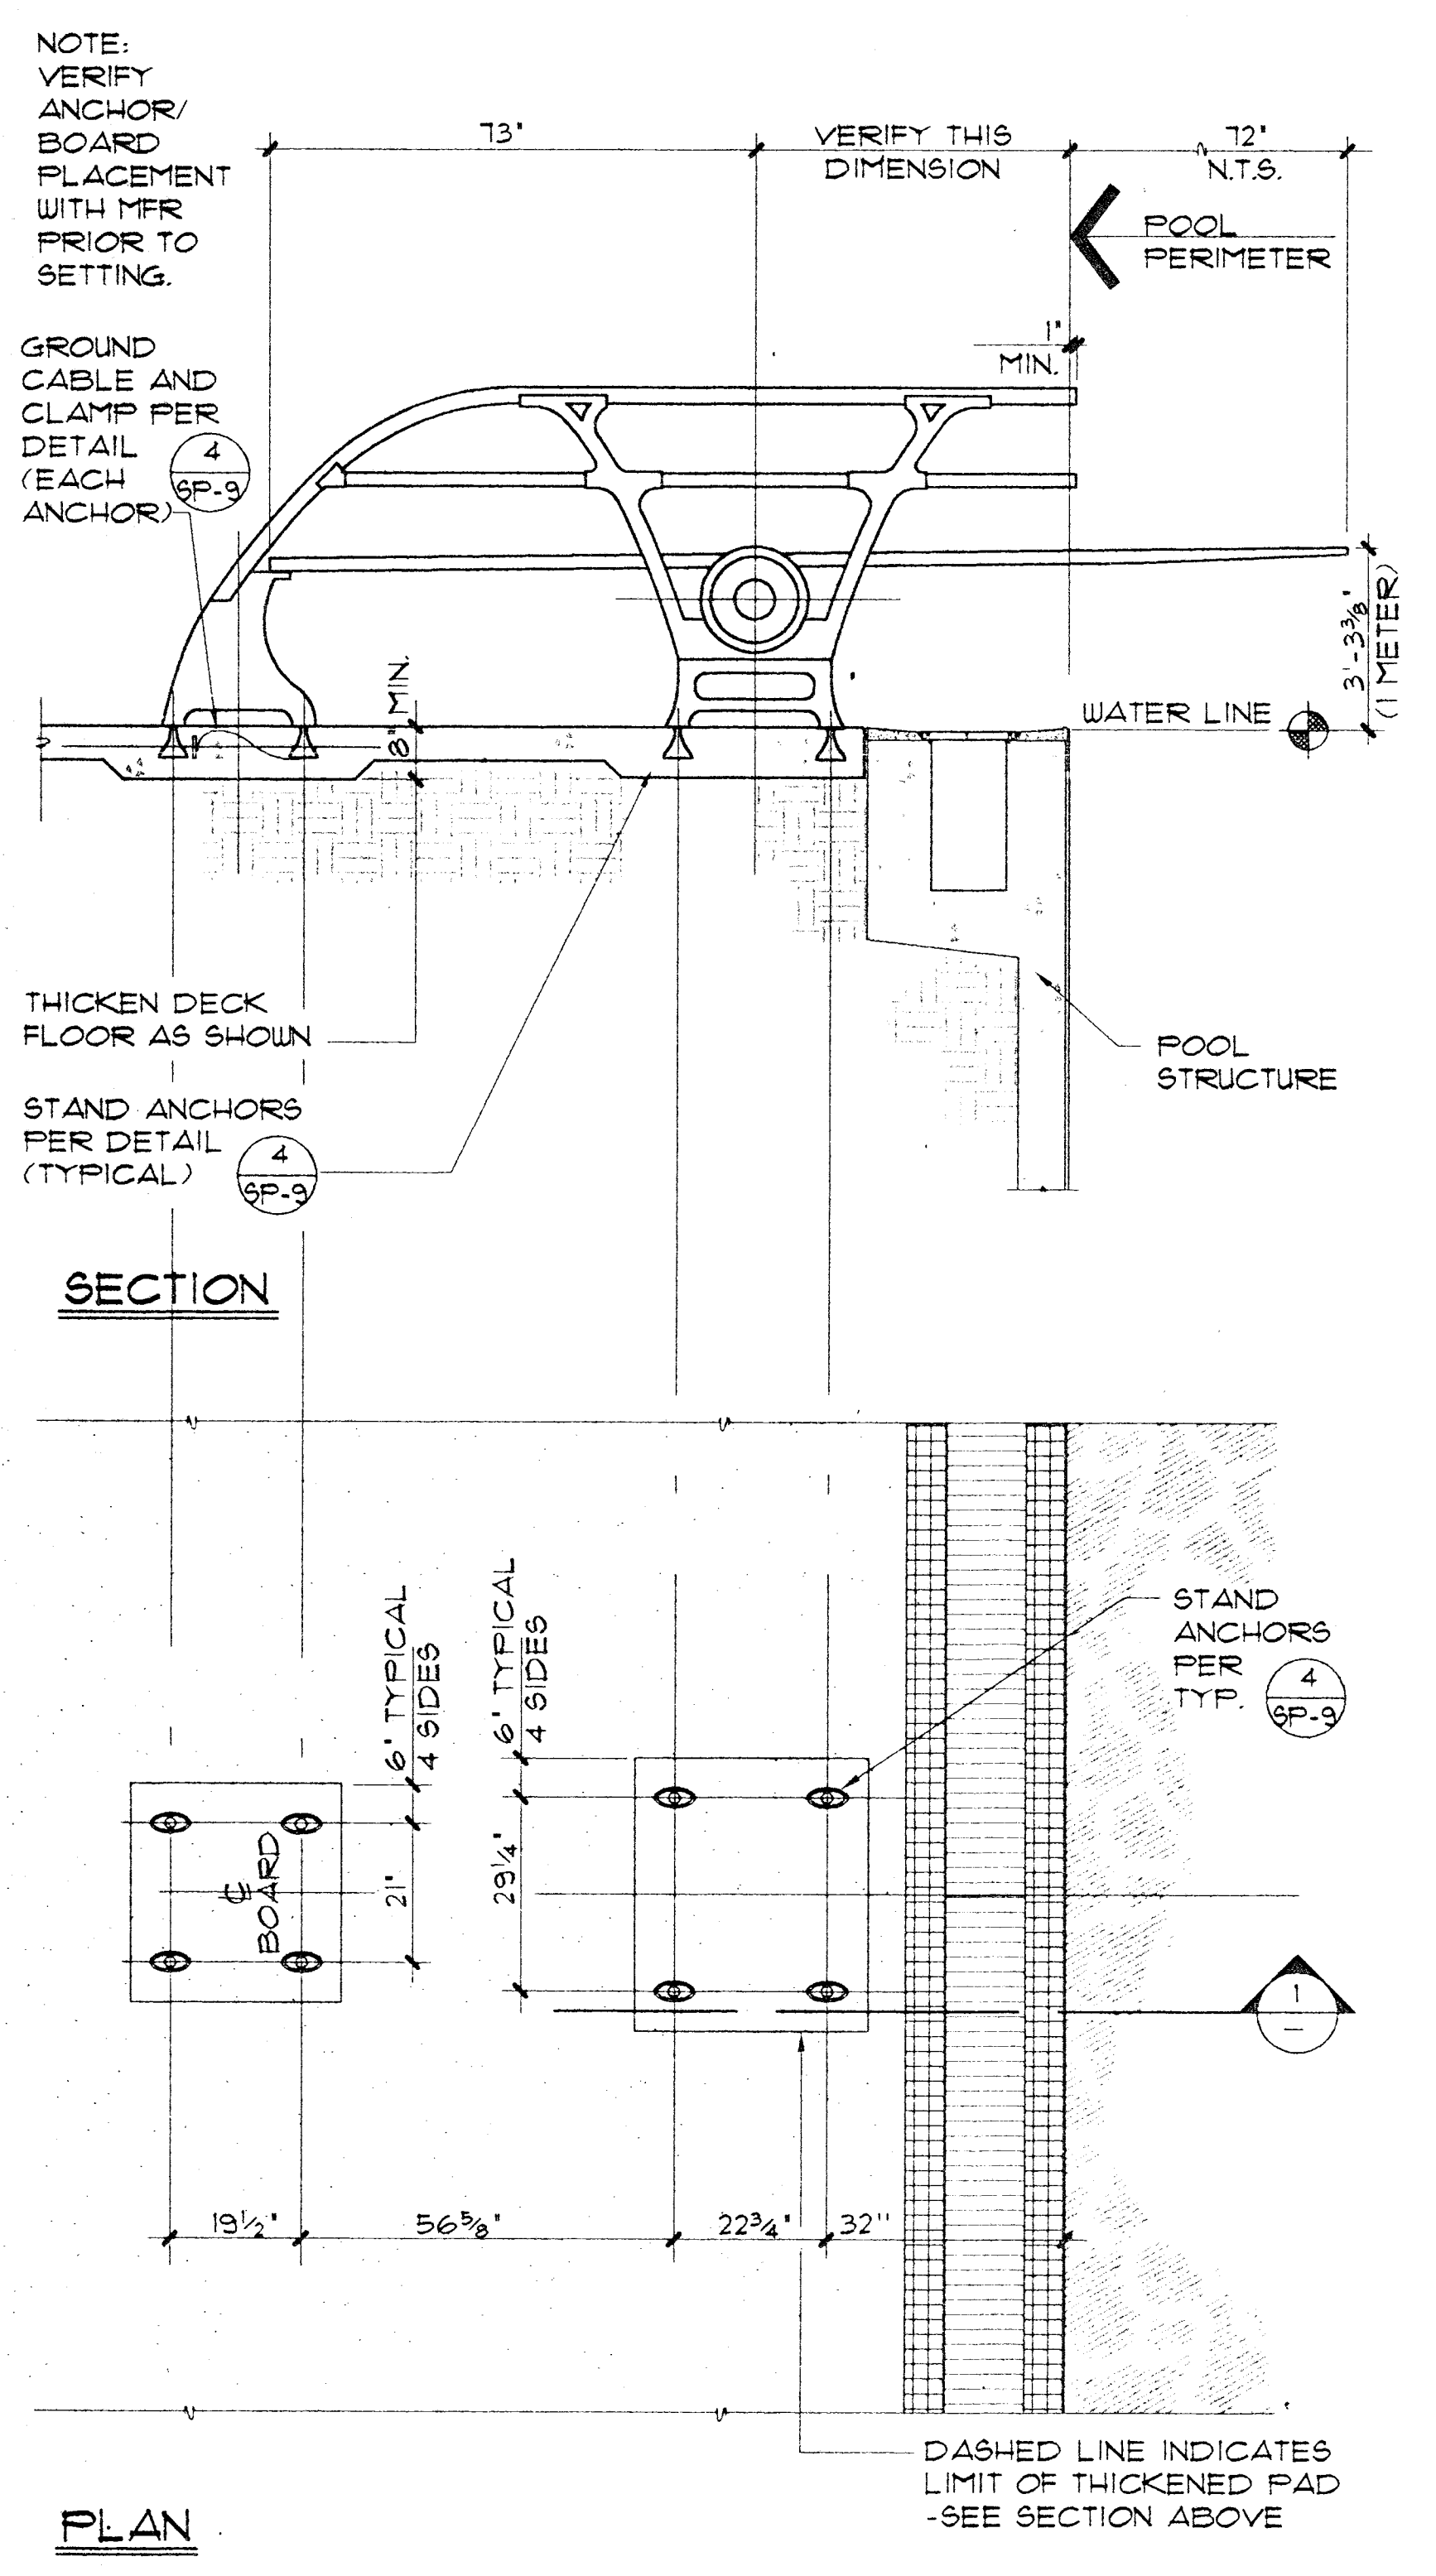


1 METER DIVING BOARD

1/2" = 1'-0"

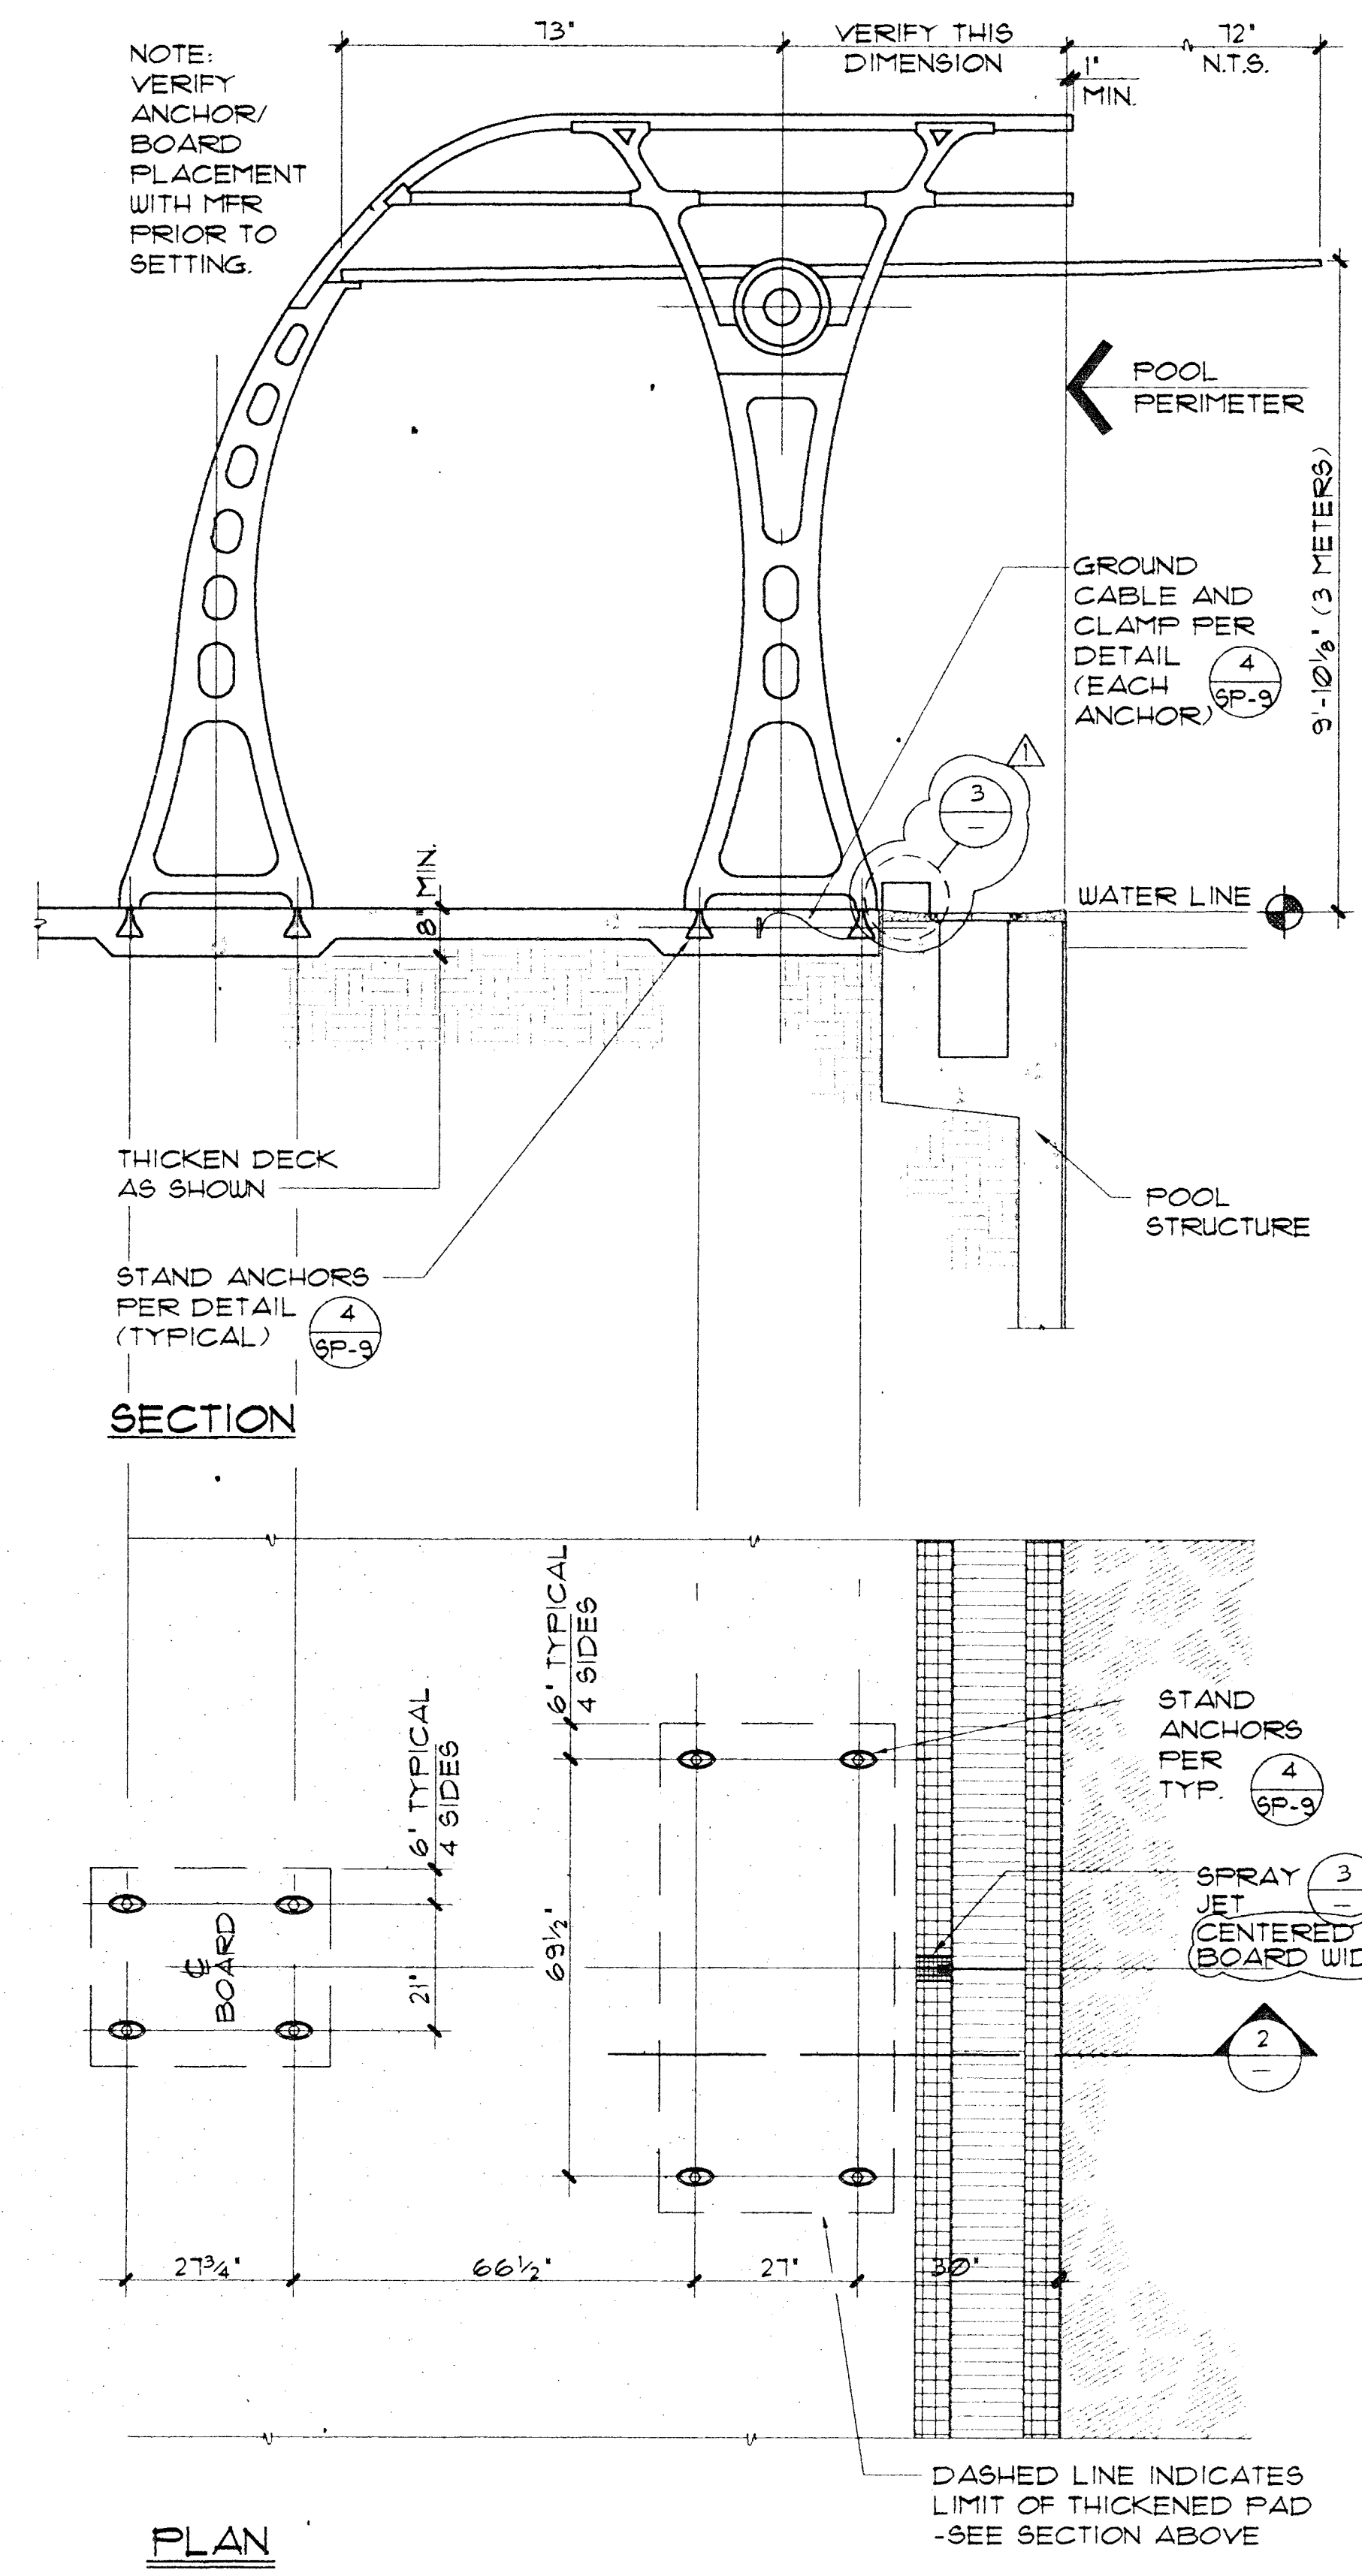


3 METER DIVING BOARD

1/2" = 1'-0"

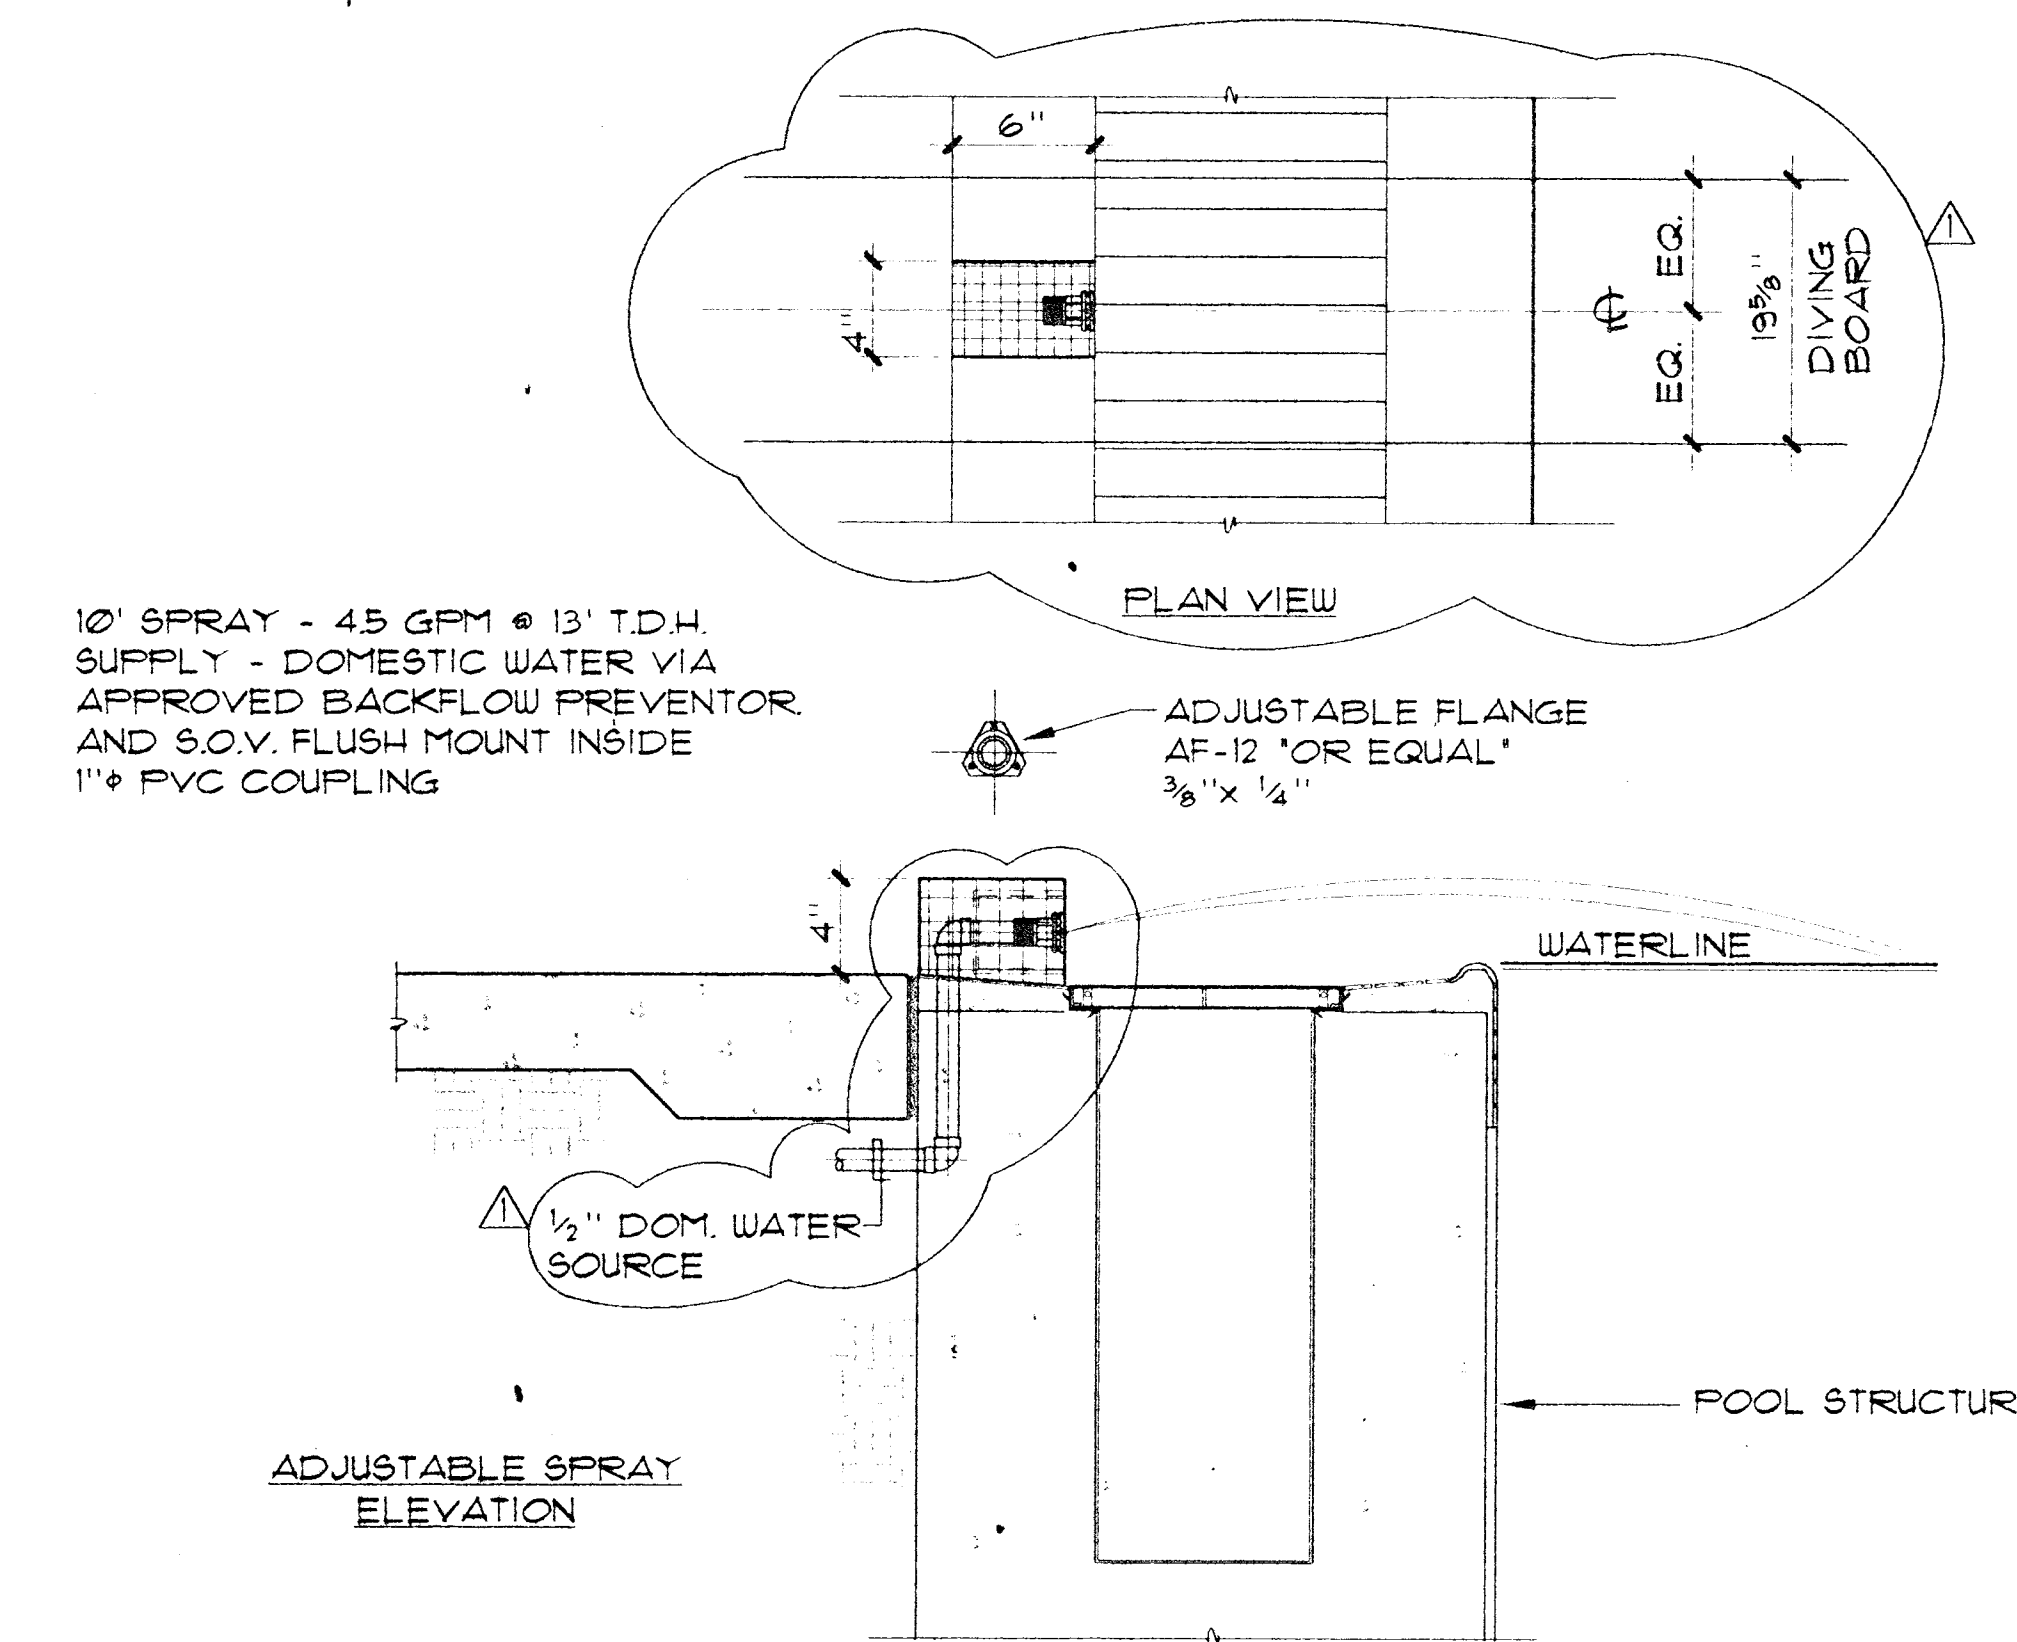


DIVING BOARD SPRAY JET

1 1/2" = 1'-0"

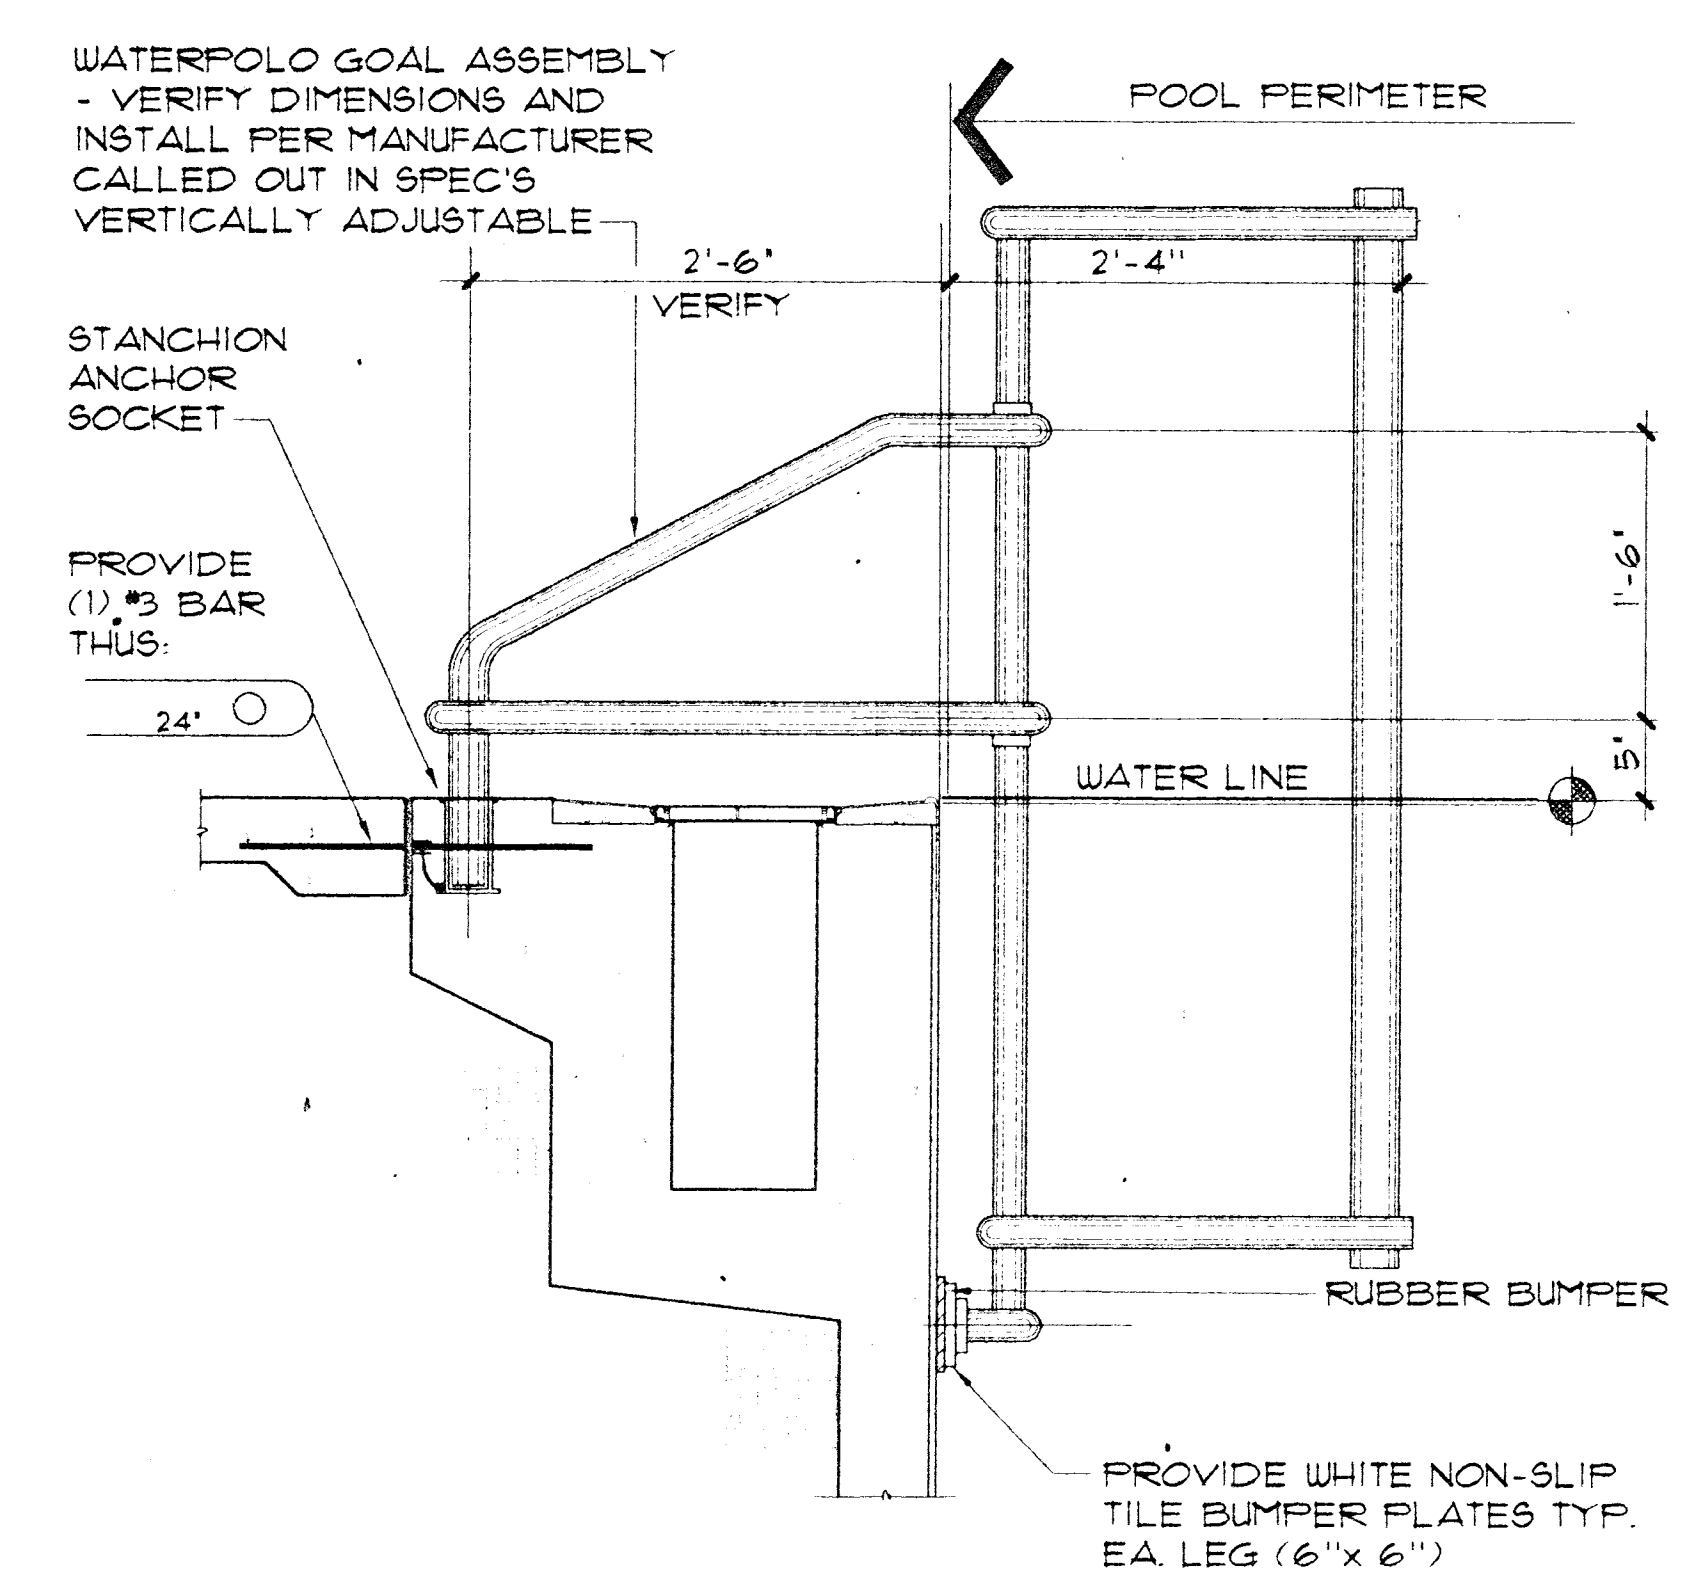


WATERPOLO GOAL

1" = 1'-0"

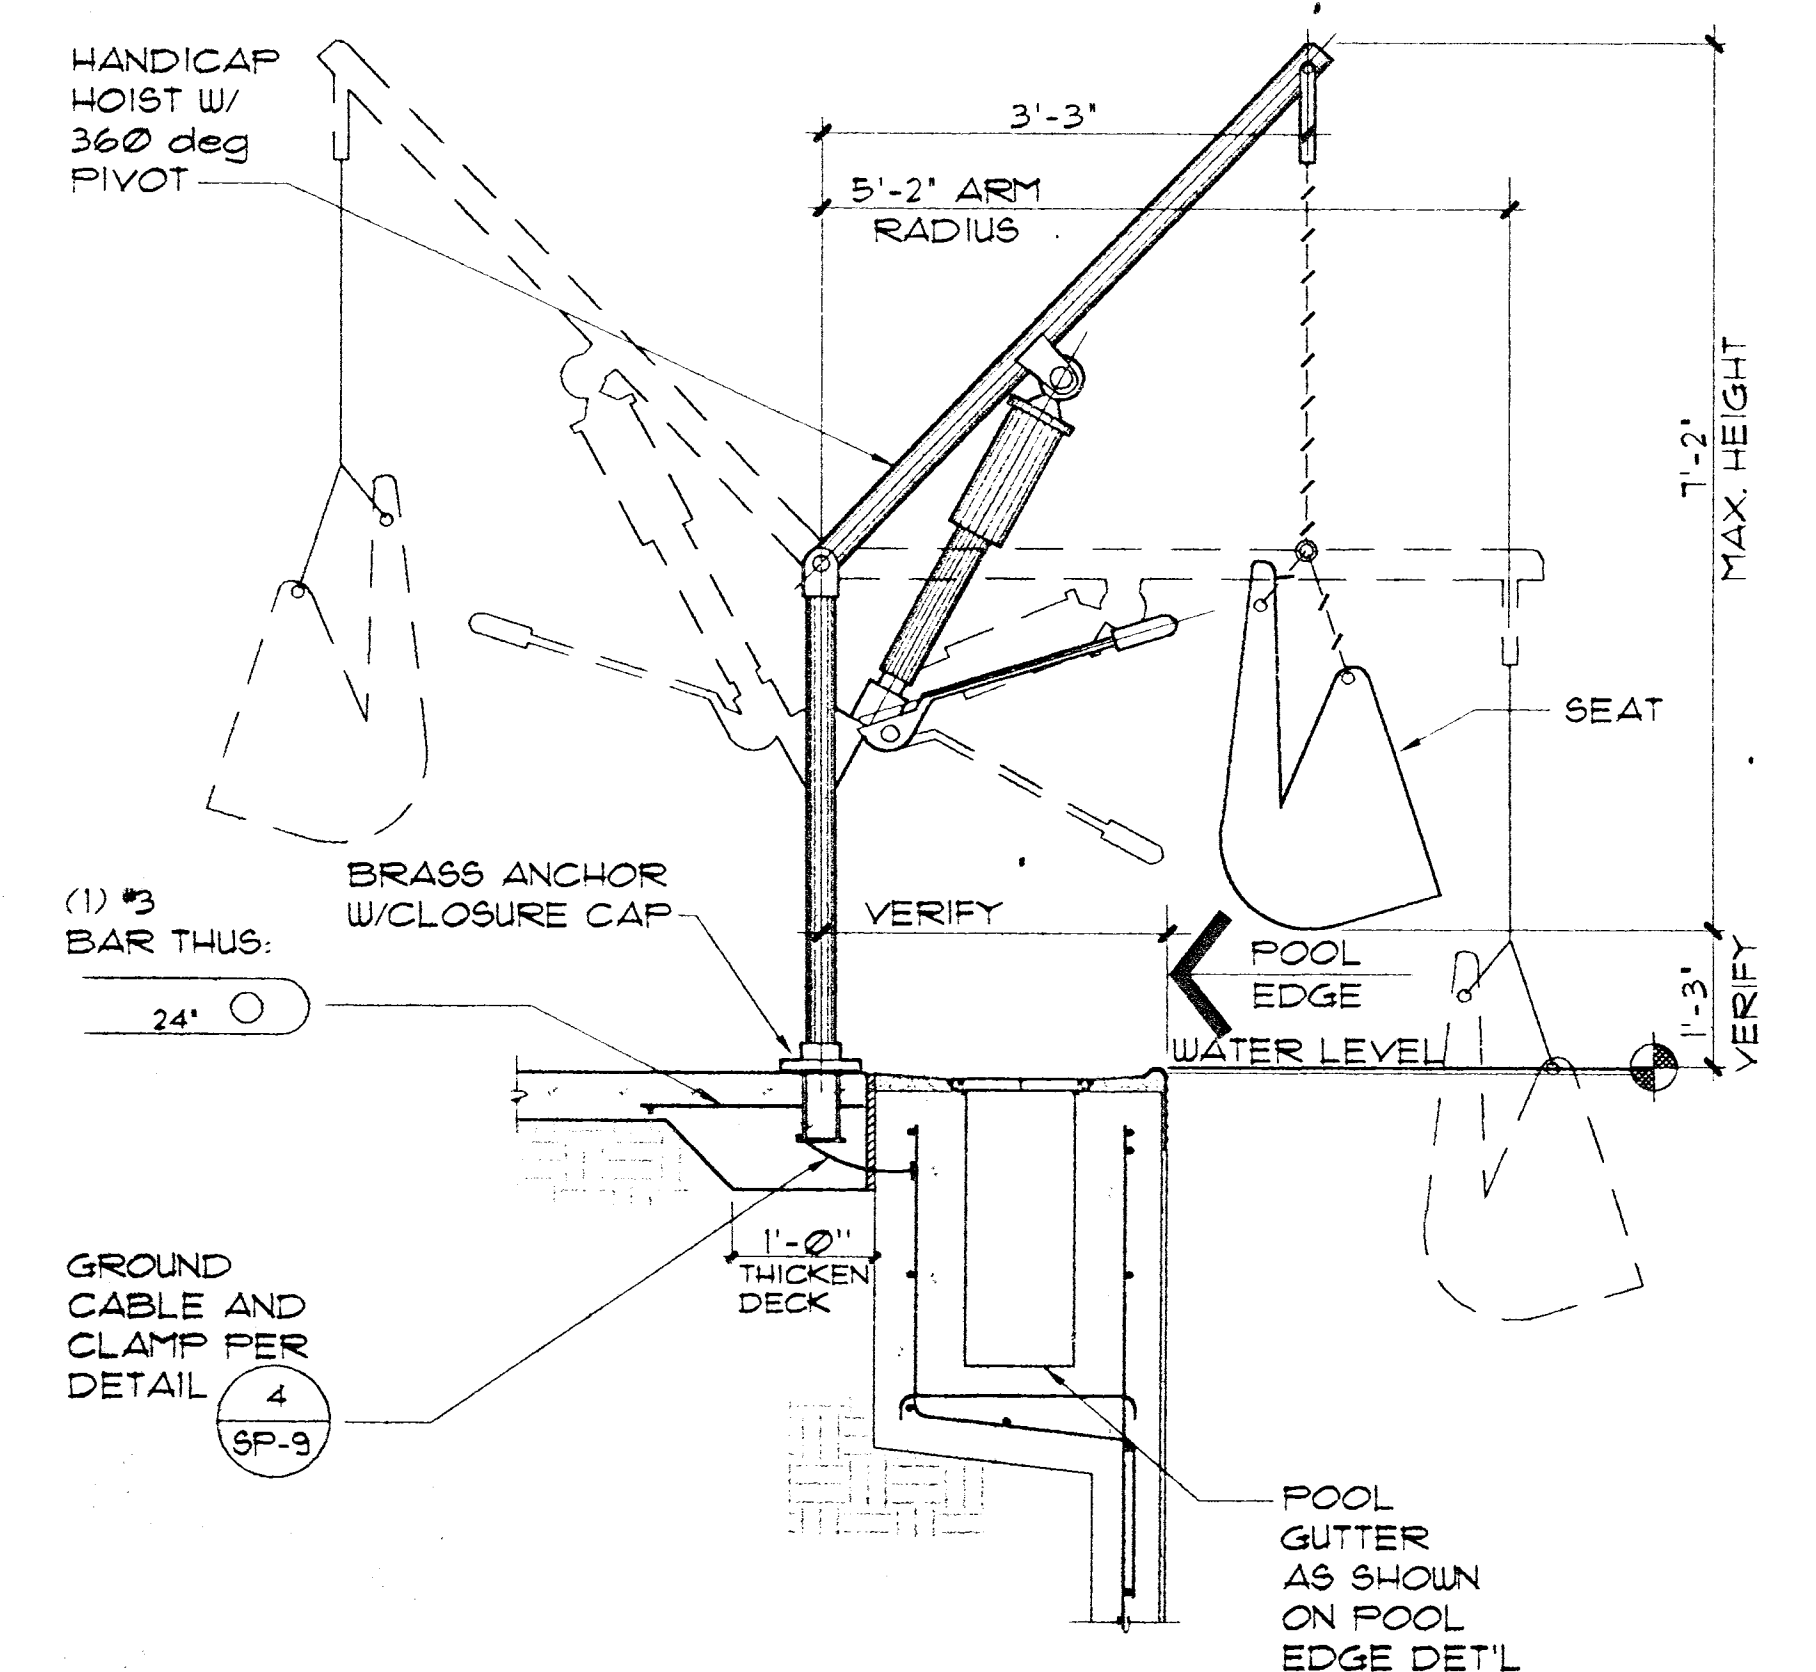

DISABLED LIFT

1" = 1'-0"

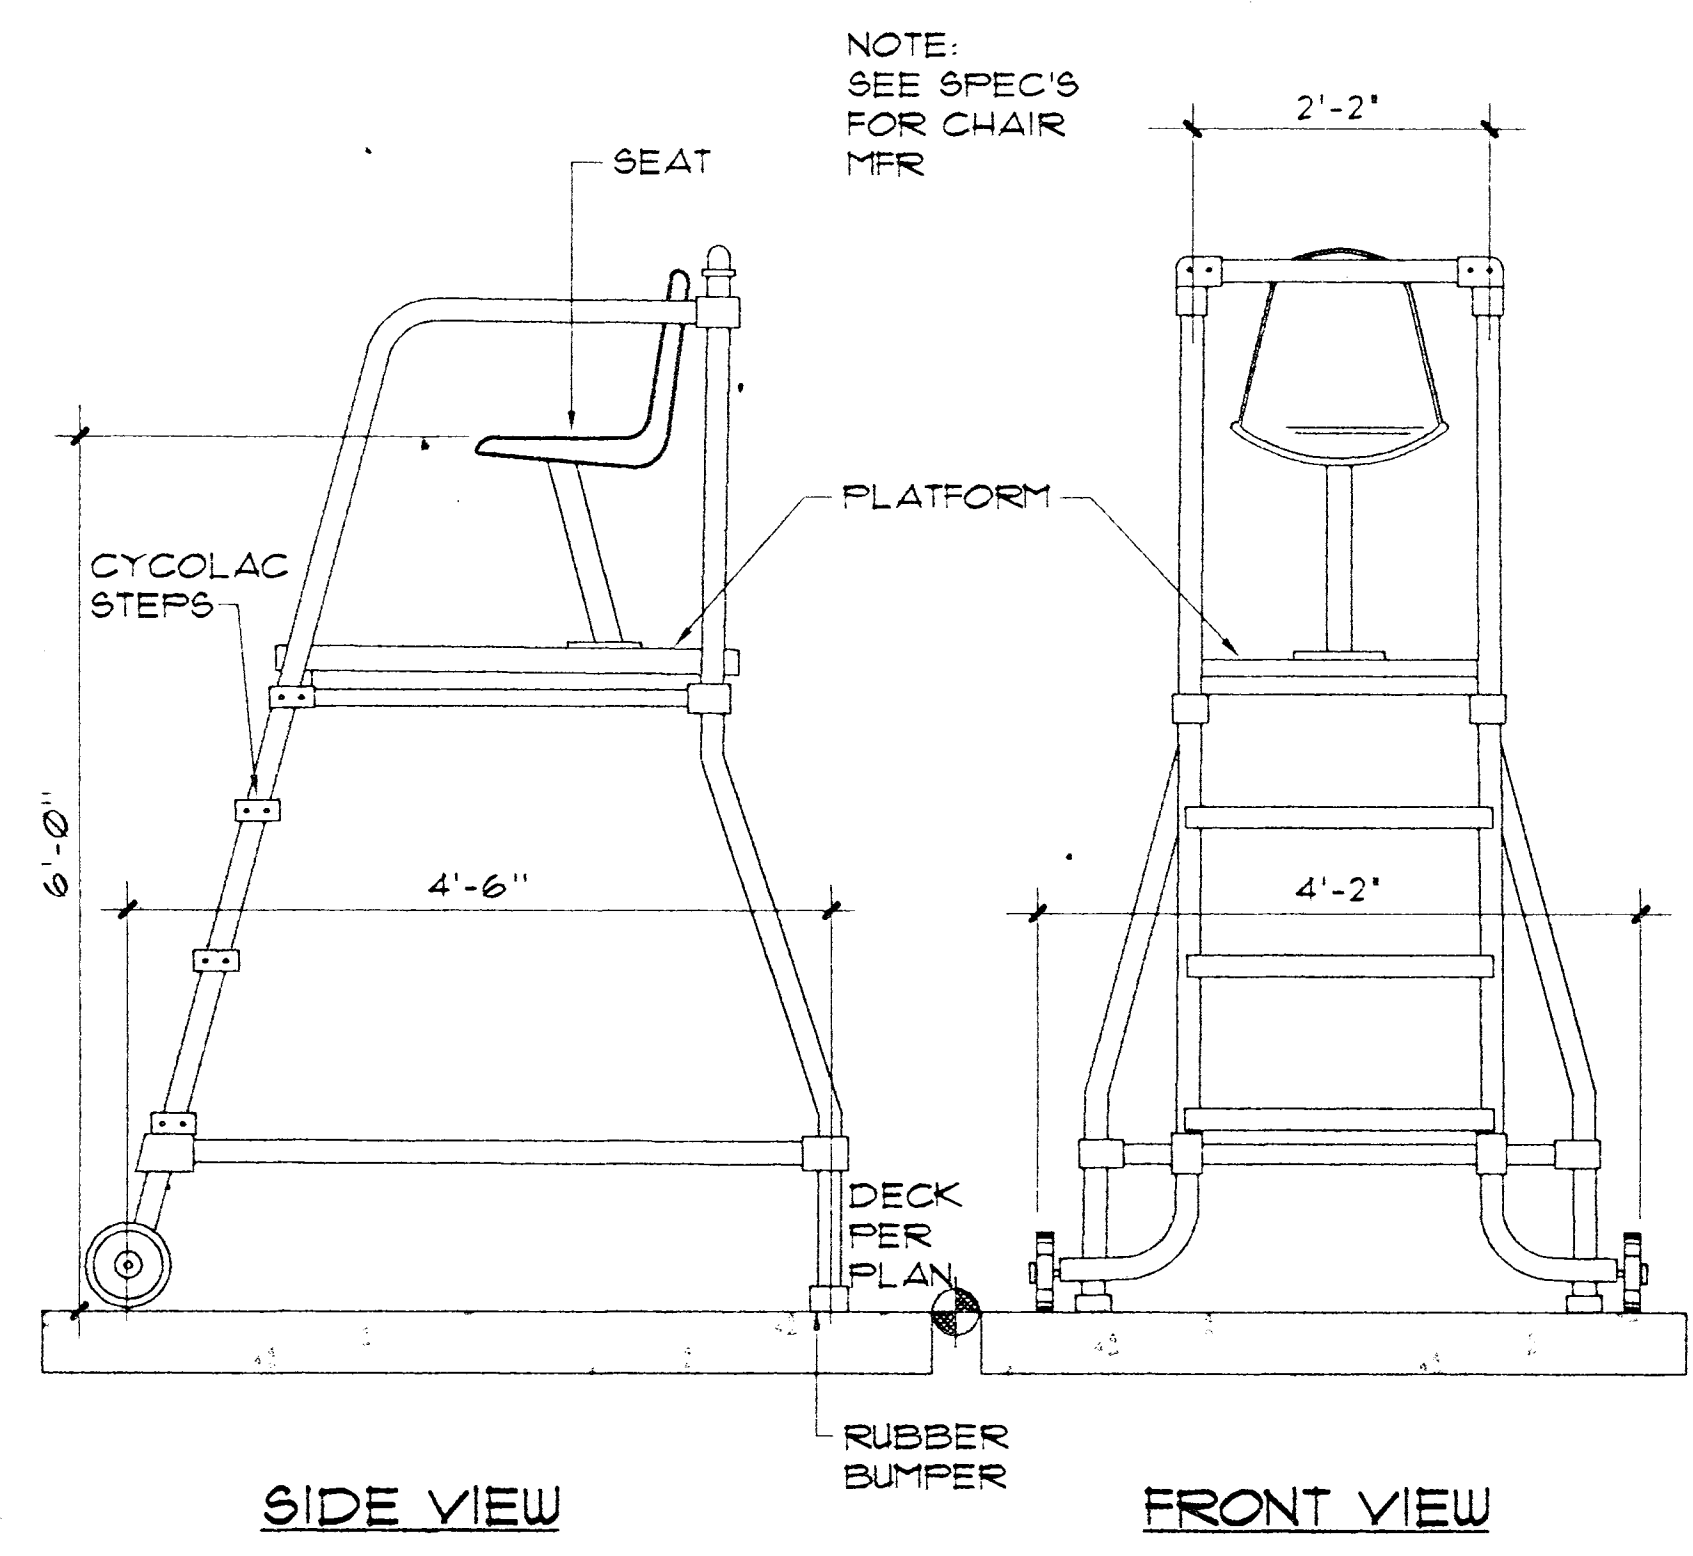

MOVEABLE LIFEGUARD CHAIR

3/4" = 1'-0"

PLANS APPROVED
 PLUMBING/MECHANICAL
 AUG 01 2000
 AUG 01 2000
 AUG 01 2000

Revisions: 4/03/00 HD, CORR

Date: OCTOBER 22, 1999

Project No. 302035-00

Scale: AS NOTED

Drawn By: N/C