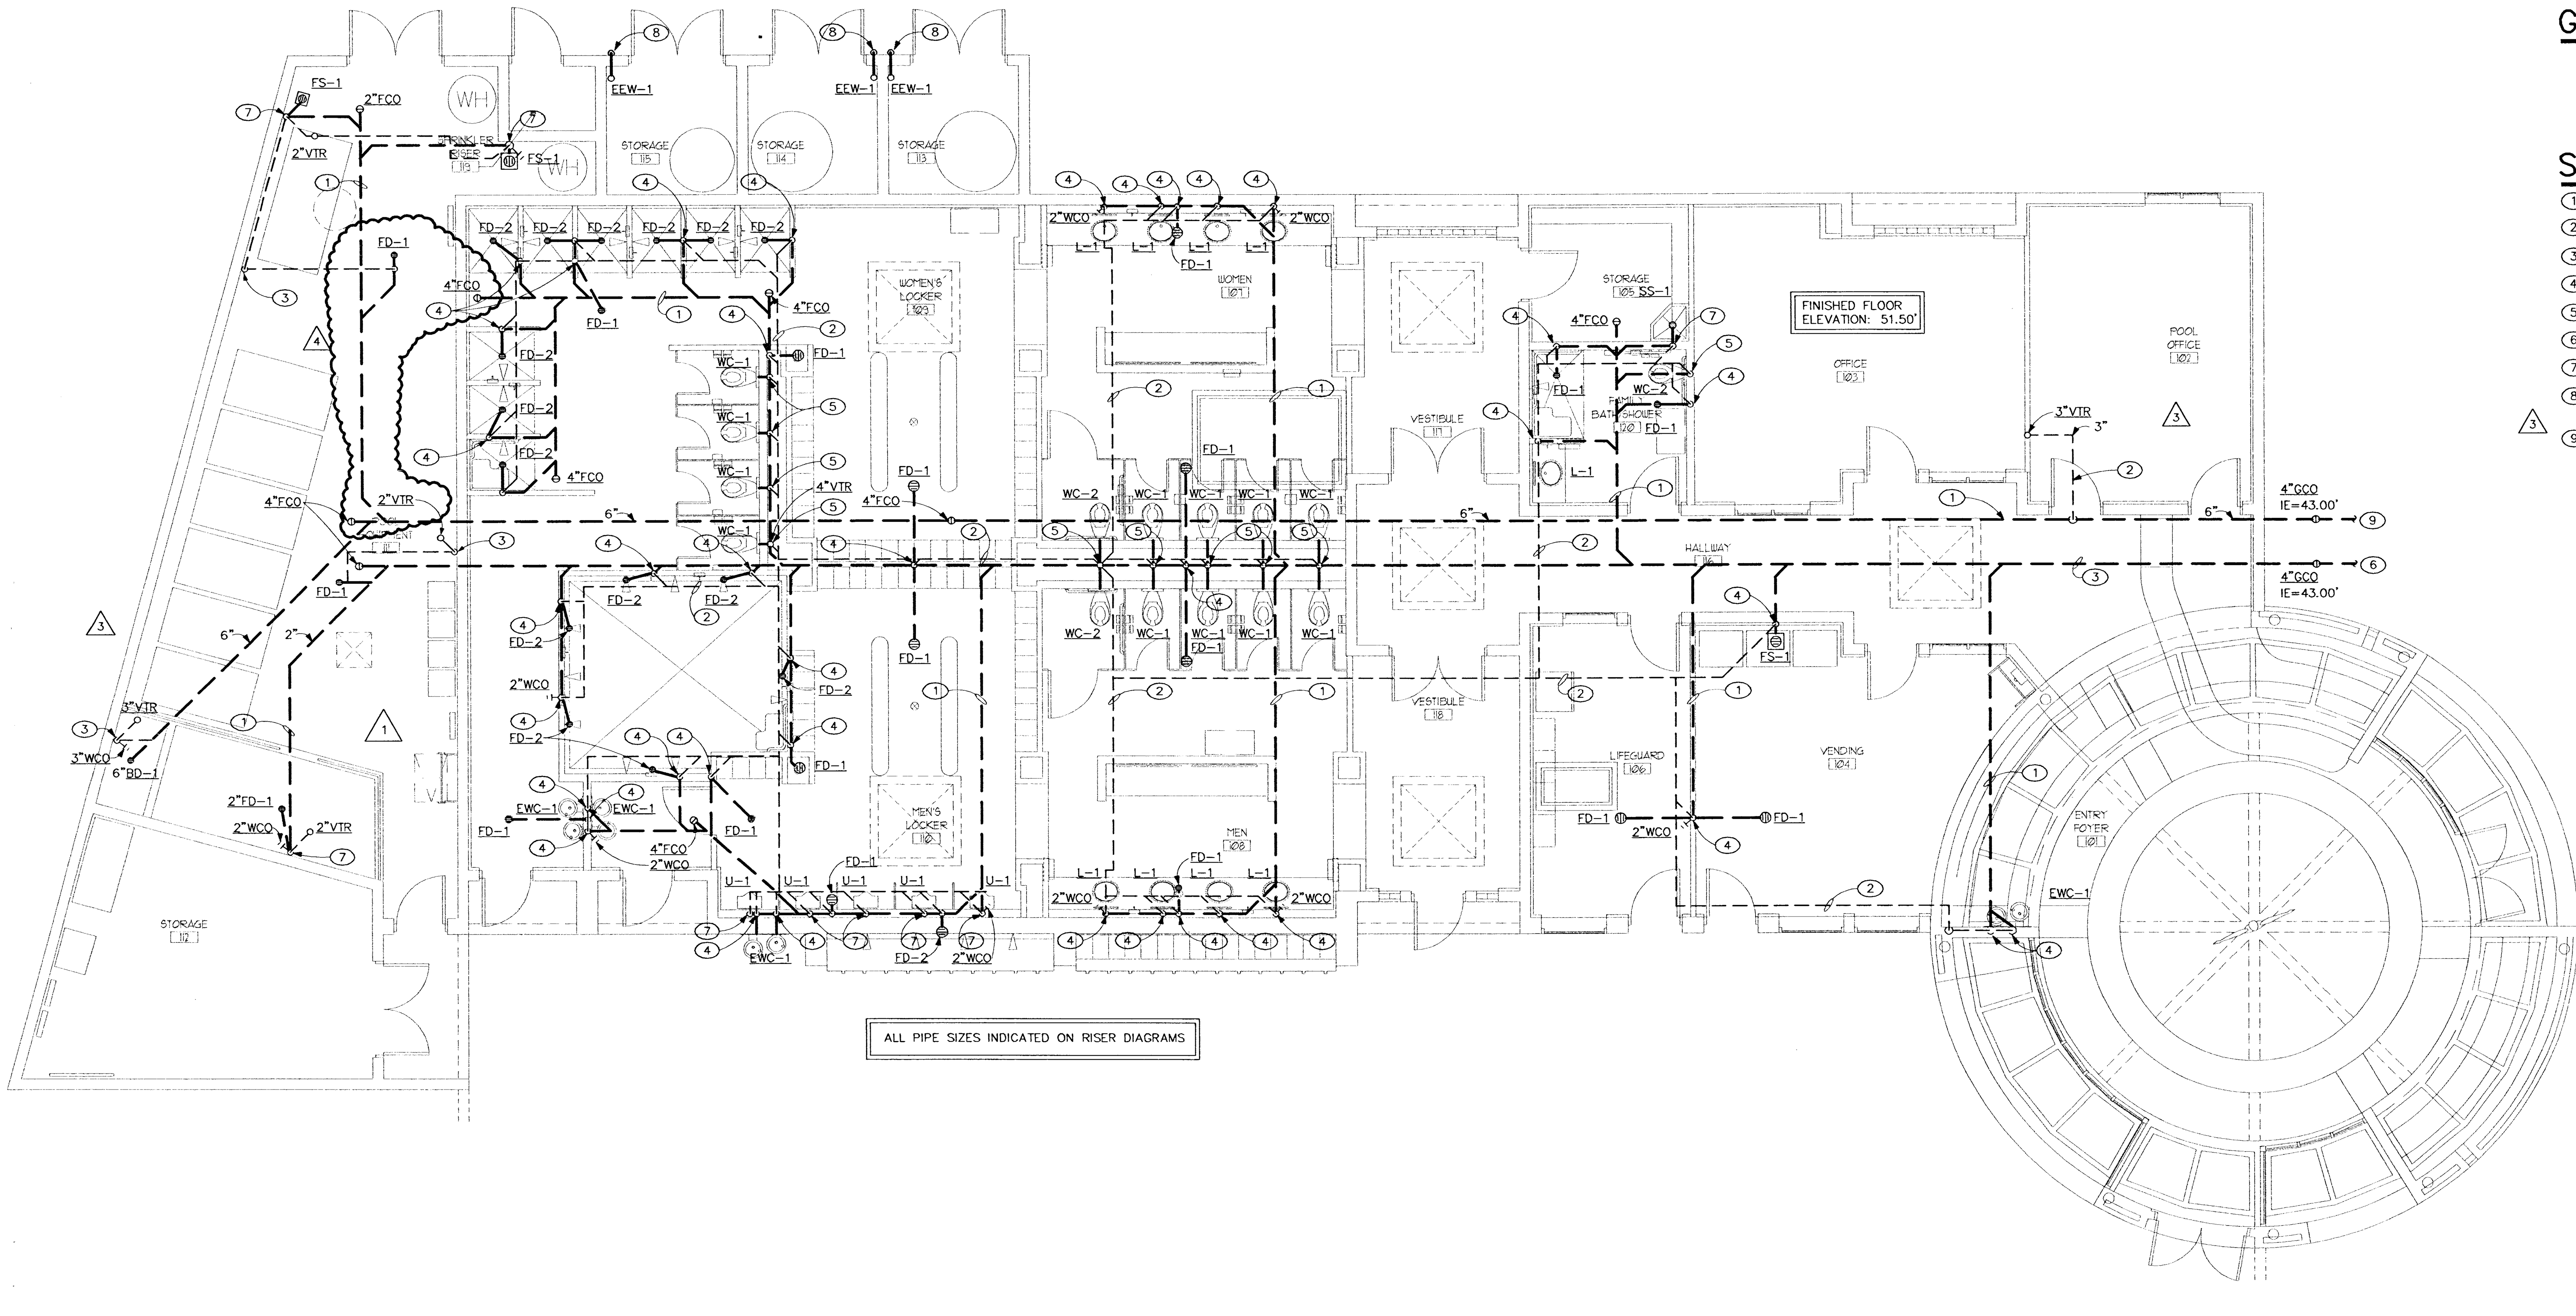

WASTE AND VENT PIPING PLAN

SCALE: 3/16" = 1' – 0"

GENERAL NOTES

1. ALL DRAINAGE PIPING 4" AND SMALLER SHALL BE SLOPED AT 1/4" PER FOOT.
2. ALL DRAINAGE PIPING LARGER THAN 4" SHALL BE SLOPED AT 1/8" PER FOOT.
3. PLUMBING VENTING SHOWN IS A MINIMUM. ADD VENTS AND/OR INCREASE PIPE SIZES AS REQUIRED.

SHEET NOTES

(1) ROUTE WASTE PIPE BELOW FLOOR.
(2) ROUTE VENT PIPE ABOVE CEILING.
(3) ROUTE VENT PIPE BELOW FLOOR AND UP ALONG WALL.
(4) 2" WASTE DOWN, 1-1/2" VENT UP.
(5) 4" WASTE DOWN, 2" VENT UP.
(6) 4" SANITARY SEWER PIPE BELOW GRADE. REFER TO CIVIL DRAWINGS FOR CONTINUATION.
(7) 2" WASTE DOWN, 2" VENT UP.
(8) ROUTE 1-1/2" WASTE PIPE FROM EMERGENCY EYEWASH THRU EXTERIOR WALL APPROXIMATELY 6" ABOVE GRADE. SEAL PENETRATION WEATHER TIGHT.
(9) 6" SANITARY SEWER PIPE BELOW GRADE. REFER TO CIVIL DRAWINGS FOR CONTINUATION.

CLU

C-18-98

APPROVAL IS FOR CLOUDED AREAS [redacted]
ONLY. SEE ORIGINALS
FOR OTHER REQUIREMENTS

PLANS APPROVED
PLUMBING/MECHANICAL
Building & Safety Dept.
City of Las Vegas, Nevada
BY JUN 0 7 2002

RECEIVED
JUN 0 5 2002
CITY OF LAS VEGAS PERMITS
509268

THESE PLANS WERE CHECKED UNDER THE 1997 UBC, UPC AND UMC, AND THE 1999 NEC

LUCCHESI • GALATI •

HARRIS CONSULTING ENGINEERS
PROJECT NO. 98240.00
DESIGNED BY: L. ANCHETA
CHECKED BY: R. HARRIS
DRAWN BY: T. ROMERO

WASTE AND VENT PIPING PLAN

SUMMERLIN ARBORS PARK
POOL AND POOL BUILDING

Revisions:
1 7/7/00 PLAN CHECK COMMENTS
3 5/31/02 FIELD CHANGE

Date: 10-22-99
Project No. 98039.00
Scale: 3/16"=1'-0"
Drawn By: KKK

Sheet Number: P2.01