HCEPG FRI JUL 07 09:23:02 2000 p501.dwg Xerox 8830 (HP-GL/2) - Version 1.5

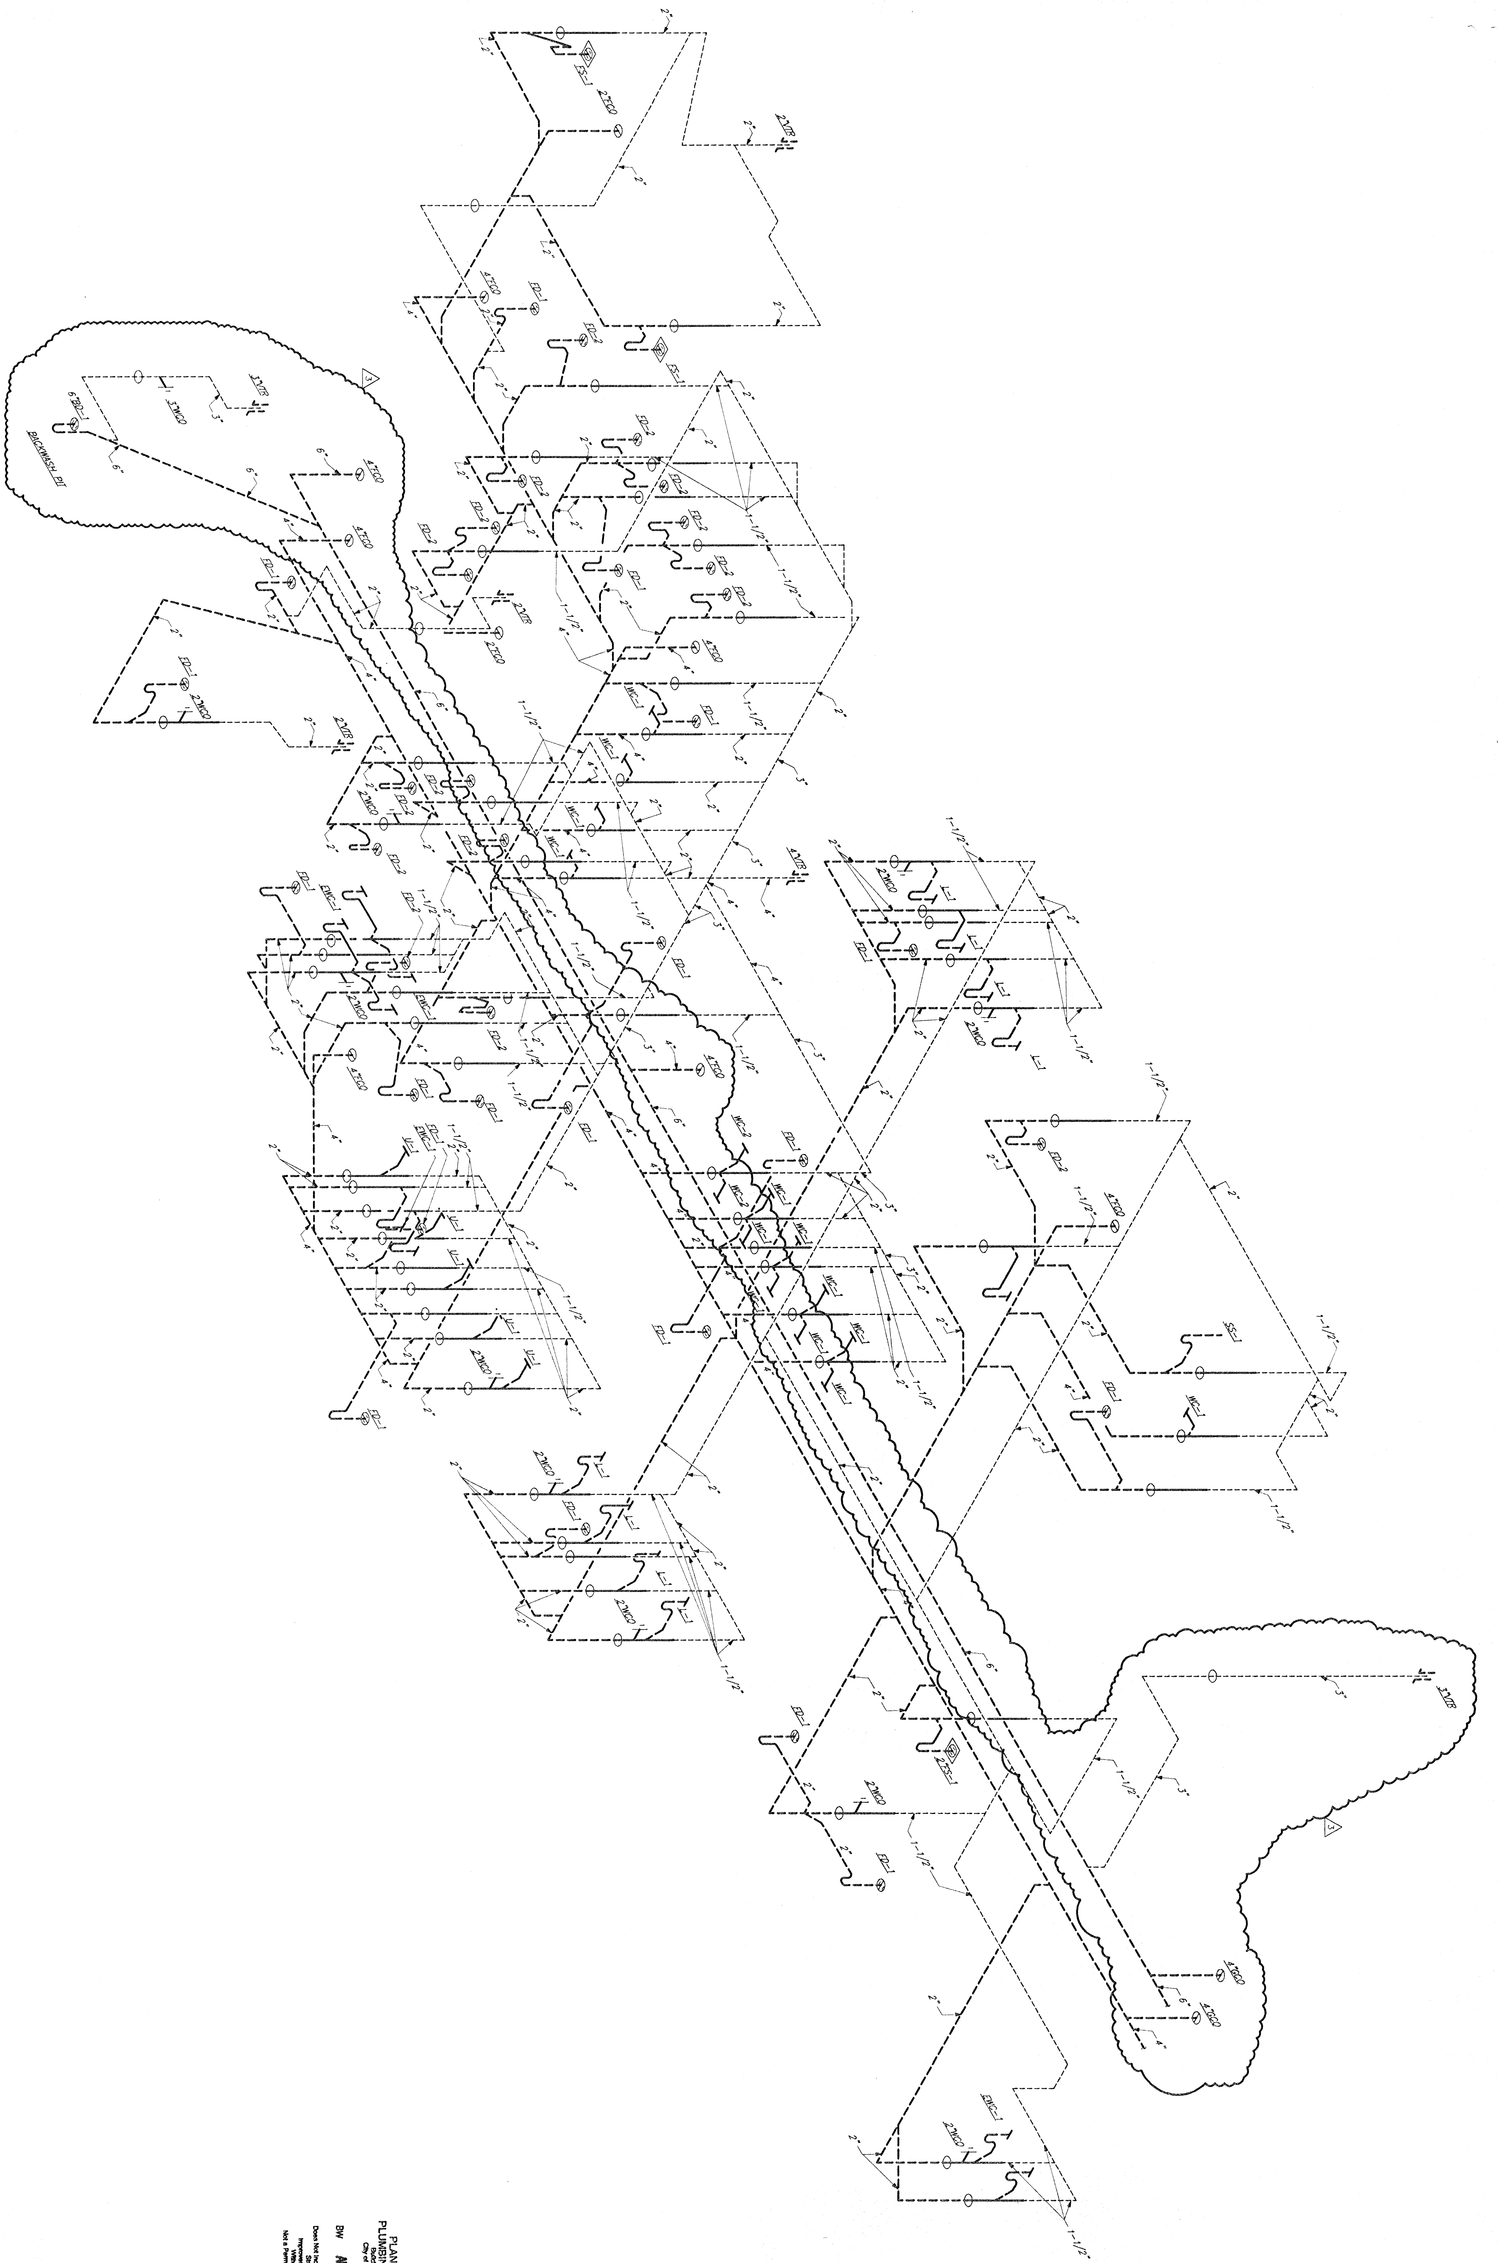

WASTE AND VENT RISER DIAGRAM

NO SCALE

P5.01

Sheet Number: P5.01

Date: 10-22-99

Project No. 98035.00

Scale: NO SCALE

Drawn By: KKK

Revisions:
1 7/11/00 PLAN CHECK COMMENTS

All Drawings, Specifications and Studies (hereinafter Contained by Lucchesi Galati Architects, Ltd. (hereinafter "LGA") are for use on the Project and are not to be used on any other Project with the exception of one particular set for each party to the Building Contract for the Project, or pursuant to the express permission for this Project or required by the laws of the State. Any use or reproduction of the Drawings in whole or in part by any means whatsoever is strictly prohibited except with the express written consent of LGA. Copyright 1999, Lucchesi Galati Architects, Ltd. Copyright 1999, Lucchesi, Galati Architects, Inc. Submission or distribution to meet official regulatory requirements or other authorized purposes is not to be construed as publication in derogation of the Architects' common law copyright or other reserved rights.

PLANS CHECKED
PLUMBING/MECHANICAL
Building & Safety Dept.
City of Las Vegas, Nevada
BY AUG 01 2000
Does Not Include Architectural, Structural
Impact Fees Not Included
Not a Permit

RECEIVED
JUL 26 2000
CITY OF LAS VEGAS
BUILDING & SAFETY

PLUMBING RISER DIAGRAMS

SUMMERLIN ARBORS PARK
POOL AND POOL BUILDING

CONSULTING ENGINEERS
HARRIS, INC.
170 Agi Road, Suite L Las Vegas, Nevada 89119
Tel 702/269-1515 Fax 702/269-1519

PROJECT NO: 98240.30
DESIGNED BY: L. ANCHETA
CHECKED BY: R. HARRIS
DRAWN BY: T. ROMERO

RANDALL S. HARRIS
JUL 07 2000
MECHANICAL
NO. 9062

LUCCHESI •GALATI•

500 PILOT ROAD • SUITE A • LAS VEGAS, NEVADA 89119 • PHONE (702) 263-7111 FAX • (702) 263-8111