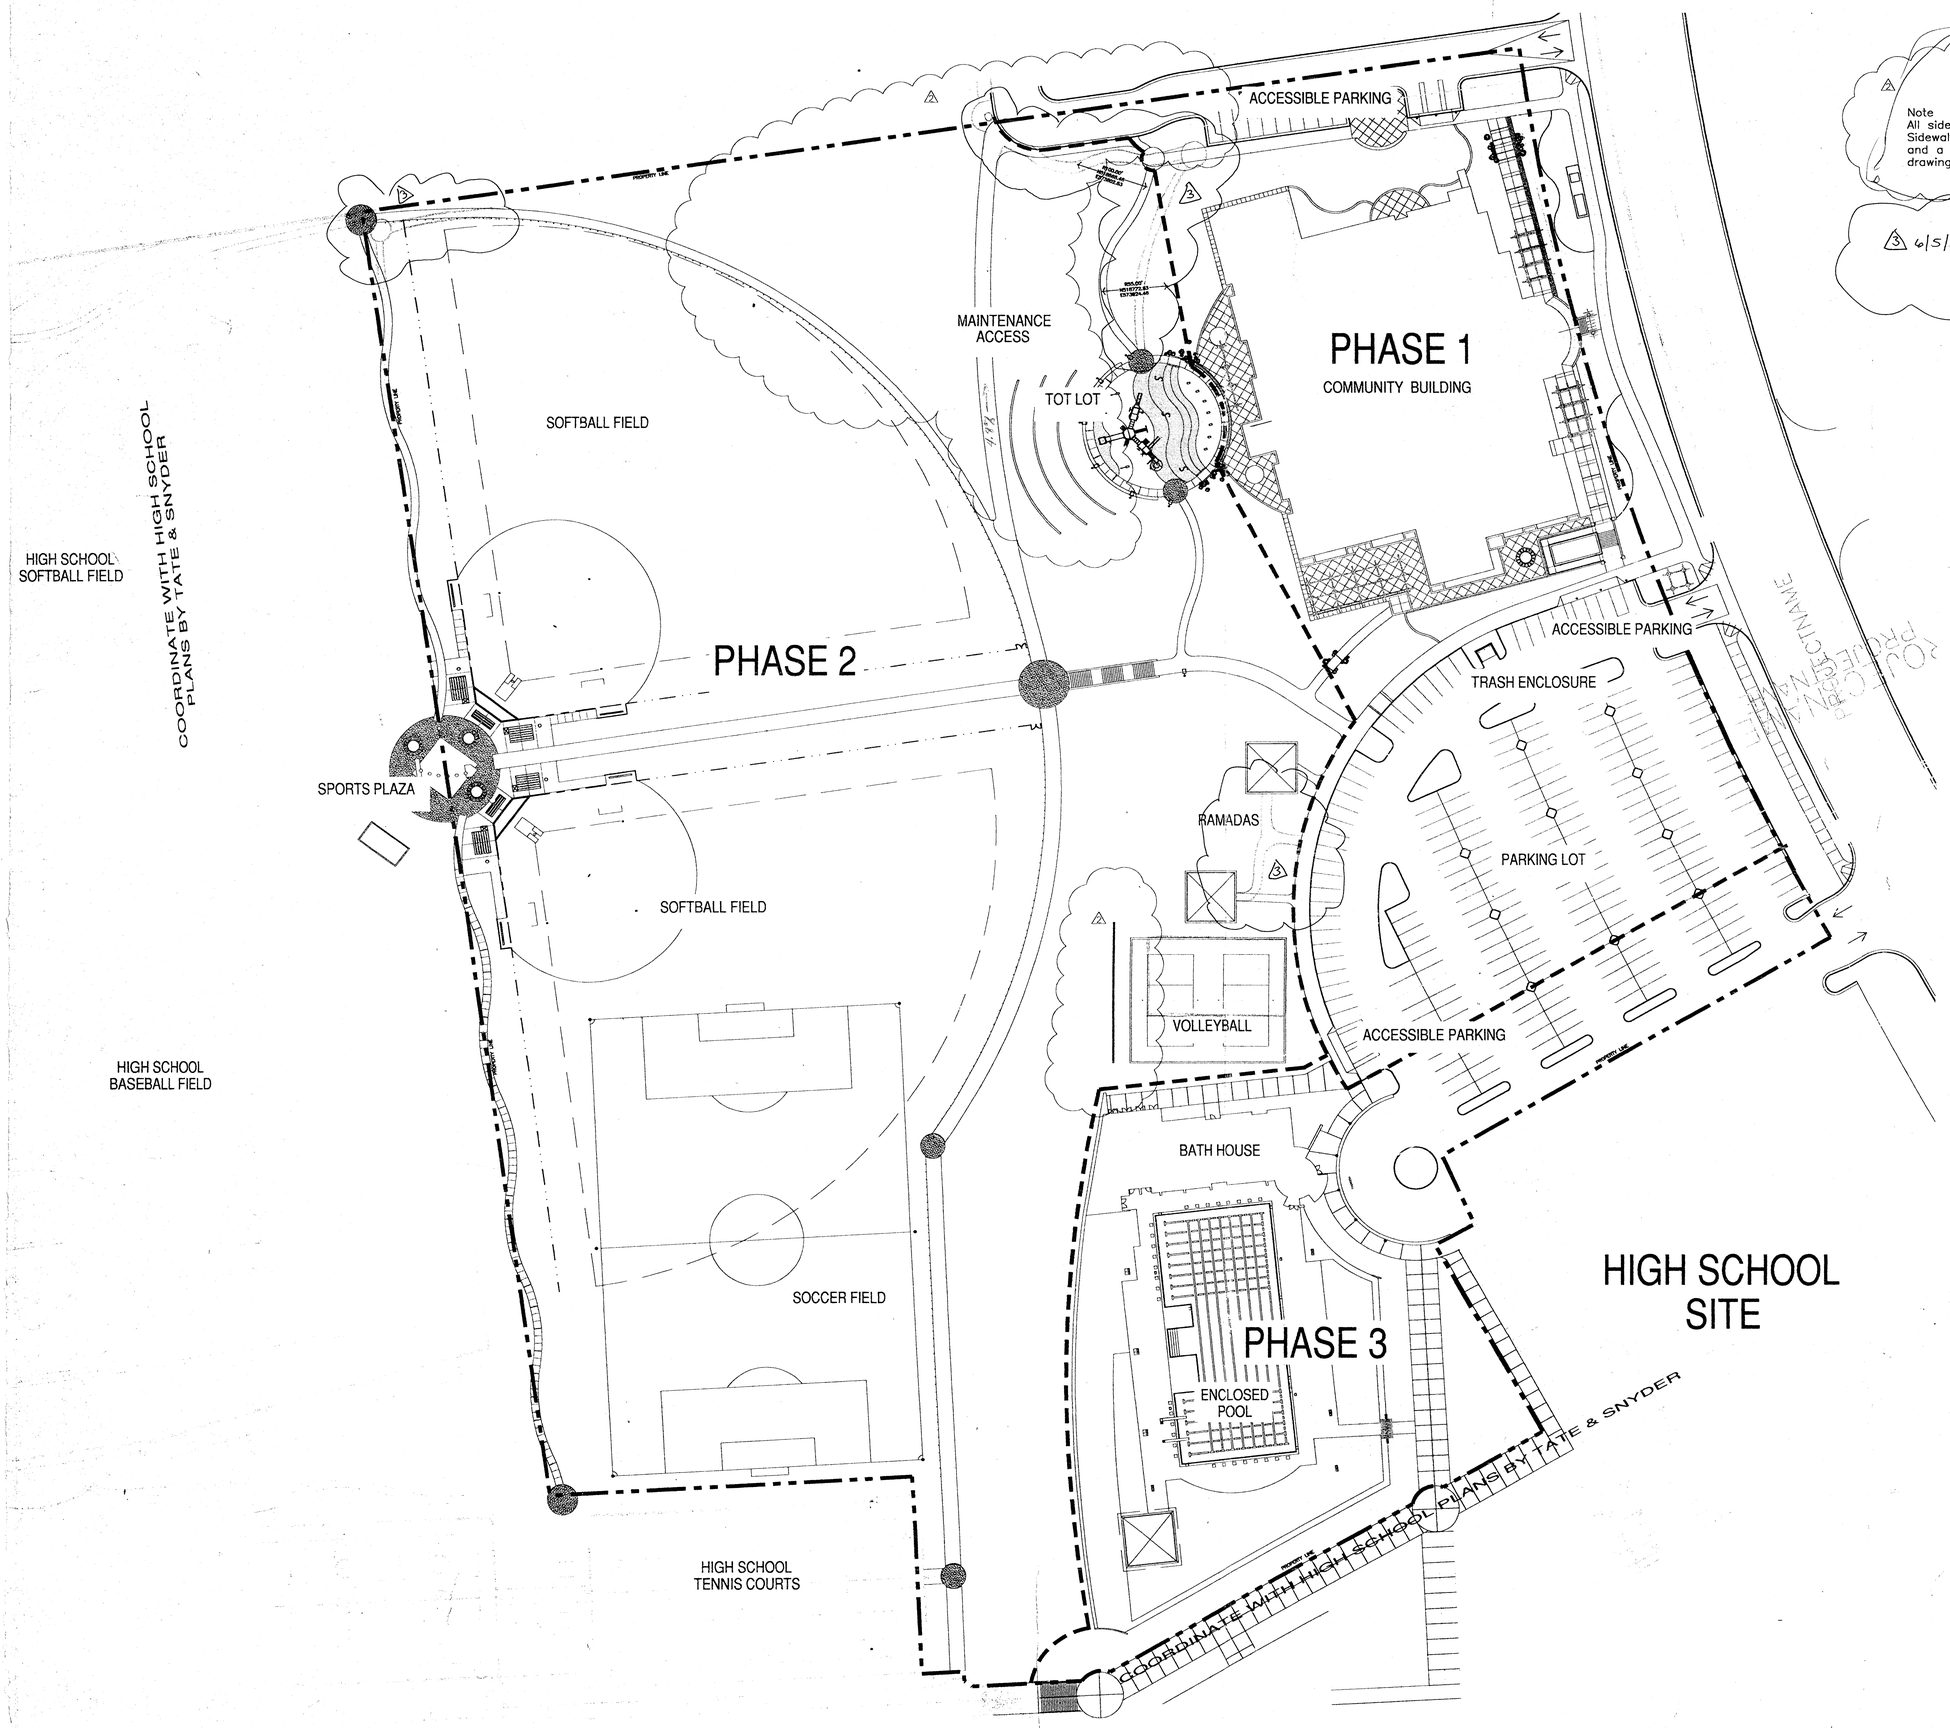

Note
All sidewalks on site are to to be accessible. Sidewalks are to have a maximum of 4.5% slope and a 1.5% cross slope. Refer to G.C. Wallace drawings for all grading conditions.

△3 6/5/00 Changed Sidewalk Locations

APPROVAL IS FOR CLOUDED AREAS OF LATEST REVISIONS ONLY AND NOT FOR OTHER REQUIREMENTS.

PLANS APPROVED
CONSTRUCTION
Building & Safety Dept
City of Las Vegas, Nevada
EGR JUN 05 2000

RECEIVED
JUN 5 2000

C-18-98 CU
Rev. 379076

Planning
Landscape Architecture
Urban Design

BRANT & GREEY
1110 East Missouri Suite 550
Phoenix, Arizona 85014
Phone 602.222.8848 Fax 602.222.8580

REGISTERED LANDSCAPE ARCHITECT DAVID D. BRANT 444 STATE OF NEVADA 4-7-99

SUMMERLIN
VILLAGE 11/12 SPORTS PARK
PHASE ONE: PARKING AND SPORTS FIELDS

DATE:		DRAWN BY: TBS
△4	5.18.98	City Comments
△5	9-9-99	Grading Changes
△6		
△7		
△8		

GENERAL NOTES

SHEET
LN02
OF 15