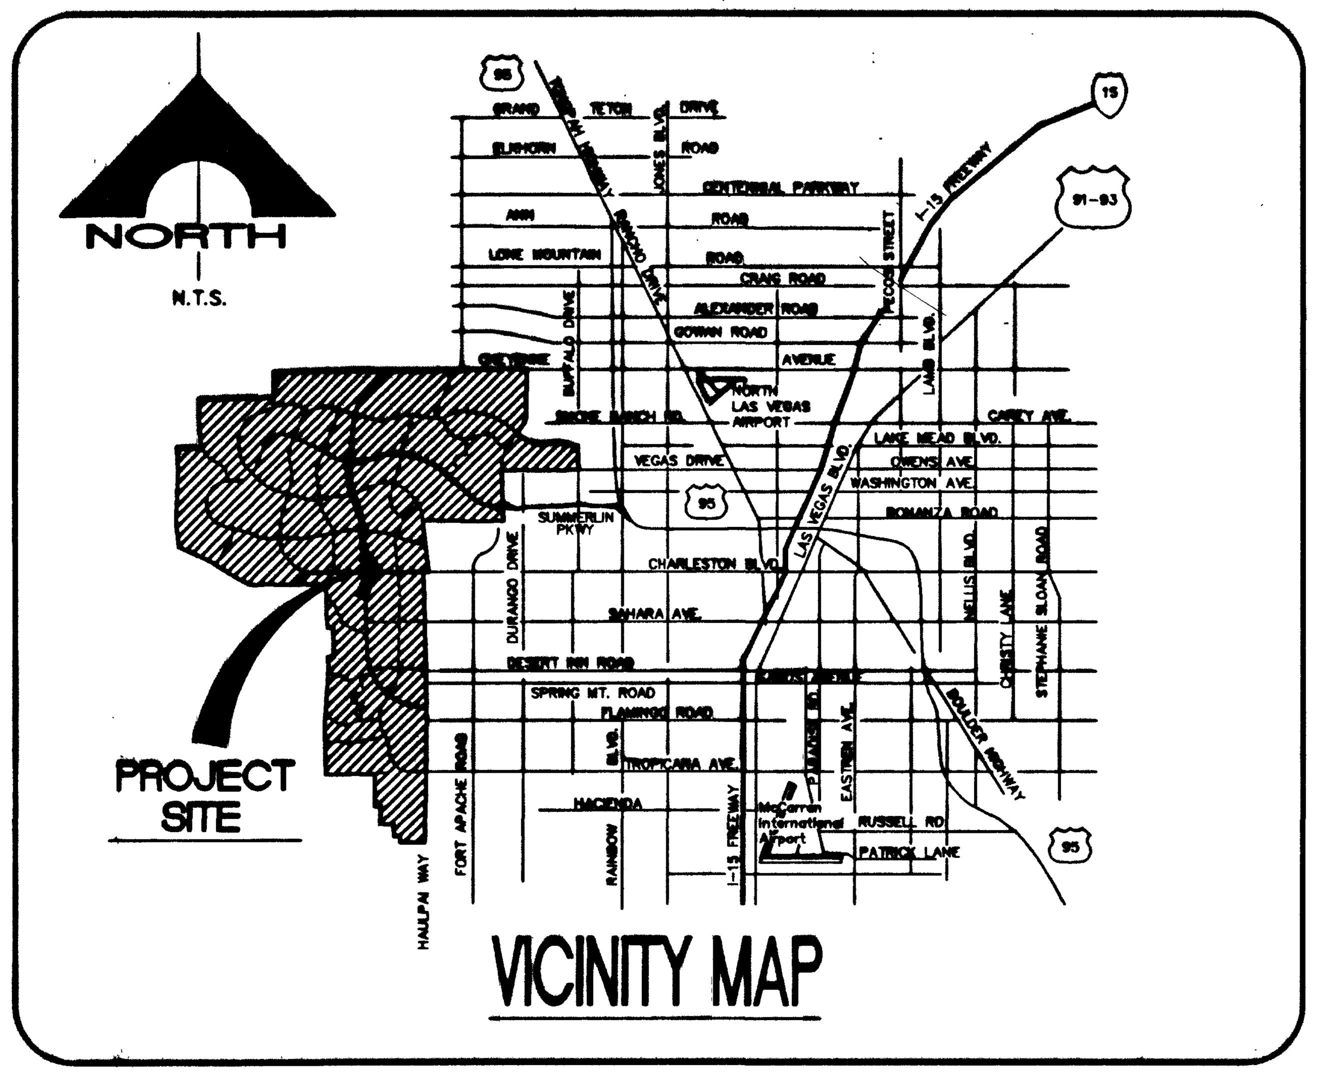

SUMMERLIN VILLAGE 20
SEWER INTERCONNECT

A PORTION OF
A.P.N. 137-35-811-001

PREPARED FOR

THE HOWARD HUGHES CORPORATION

10,000 W. CHARLESTON BLVD., STE. #200
LAS VEGAS, NV 89135
(702) 791-4440

G.C. WALLACE, INC.
Engineers/Planners/Surveyors
1555 SOUTH RAINBOW BLVD. / LAS VEGAS, NEVADA 89146
(702) 804-2000

SEWER AS-BUILTS
TAB CONTRACTORS

APPROVALS
CITY OF LAS VEGAS

11-6-2000
CHARLES KAJKOWSKI, JR., P.E. #4784 — DATE
CITY ENGINEER
CITY OF LAS VEGAS, NEVADA

APPROVAL OF THESE PLANS IS LIMITED TO THOSE IMPROVEMENTS CONSTRUCTED IN THE DEDICATED RIGHT-OF-WAY AND/OR DEDICATED EASEMENTS. THIS APPROVAL DOES NOT AUTHORIZE THE CONSTRUCTION OF ANY IMPROVEMENTS THAT DEVIATE FROM ADOPTED STANDARDS AND/OR SPECIFICATIONS, EXCEPT THOSE SPACIFICALLY LISTED UNDER DEVIATIONS FROM STANDARD. THE ENGINEER SHALL RESOLVE ANY DEVIATION OTHER THAN THOSE LISTED IN DEVIATIONS FROM STANDARDS IN FAVOR OF THE UNIFORM STANDARD DRAWINGS AND SPECIFICATIONS CLARK COUNTY AREA NEVADA.

10-18-00
JEFFREY D. RHOADS, AIA — DATE
CHAIRMAN SUMMERLIN COMMERCIAL/
DESIGN REVIEW COMMITTEE

Agency	Reviewed by	Date
L.V. VALLEY WATER DISTRICT (SHEET 1, 2 & 5)	N/A	
C.L.V. FIRE DEPARTMENT	N/A	
NEVADA POWER CO.	N/A	
SPRINT TELEPHONE CO.	N/A	
SOUTHWEST GAS CORP.	N/A	

INDEX OF DRAWINGS

NO.	TITLE and DESCRIPTION
C-1	COVER SHEET
C-2	GENERAL NOTES AND DETAILS
C-3	SEWER - PLAN AND PROFILE I
C-4	SEWER - PLAN AND PROFILE II
C-5	SEWER - PLAN AND PROFILE III

LOCATION MAP

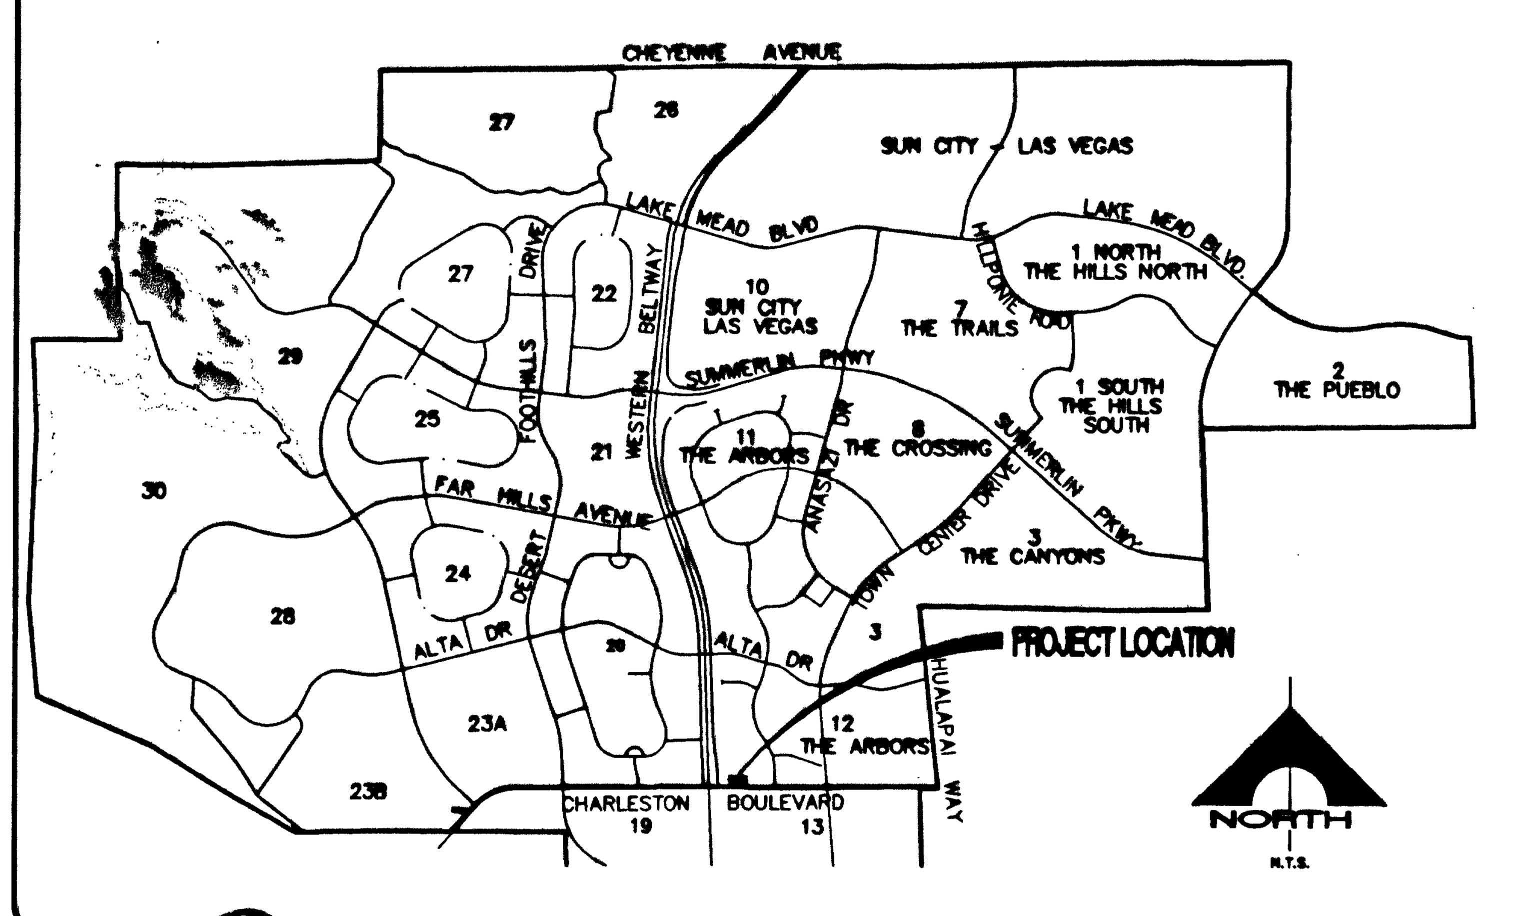

BASIS OF BEARINGS

SOUTH 06°05'51" EAST, BEING THE BEARING OF THE EAST LINE OF SECTION 36, TOWNSHIP 20 SOUTH, RANGE 59 EAST, M.D.M., AS SHOWN BY MAP THEREOF ON FILE IN BOOK 74, PAGE 71 OF PLATS, OFFICIAL RECORDS OF CLARK COUNTY, NEVADA.

BENCHMARK

CITY OF LAS VEGAS BENCHMARK OLV09 36SSW6
SUMMERLIN DATUM ELEVATION = 3014.06 FT.
NAVD 88 ELEVATION = 919.3496 METERS, 3016.23 FT.
USING NAVD 88 DATUM.

Call before you Dig.
1-800-227-2600

CALL BEFORE YOU DO OVERHEAD
1-702-593-6111

G.C. WALLACE, INC.
Engineers/Planners/Surveyors
1555 SOUTH RAINBOW BLVD./LAS VEGAS, NEVADA 89146
TELEPHONE: (702) 804-2000 • FAX: (702) 804-2299
F:\620-1792\dwg\improv\CPSEWER\CSWRc001.dwg

DESIGN:
DRAWN:
CHECK:
ISSUE DATE:
ISSUE EDITOR:
PLOT DATE: 10-11-00
PLOT TIME: 08:55:52

ISSUE DATES — X COMPLETE

SUMMERLIN
VILLAGE 20 SEWER INTERCONNECT
COVER SHEET

SHEET C-1
1 OF 5 SHTS

27633 (S) 57858