


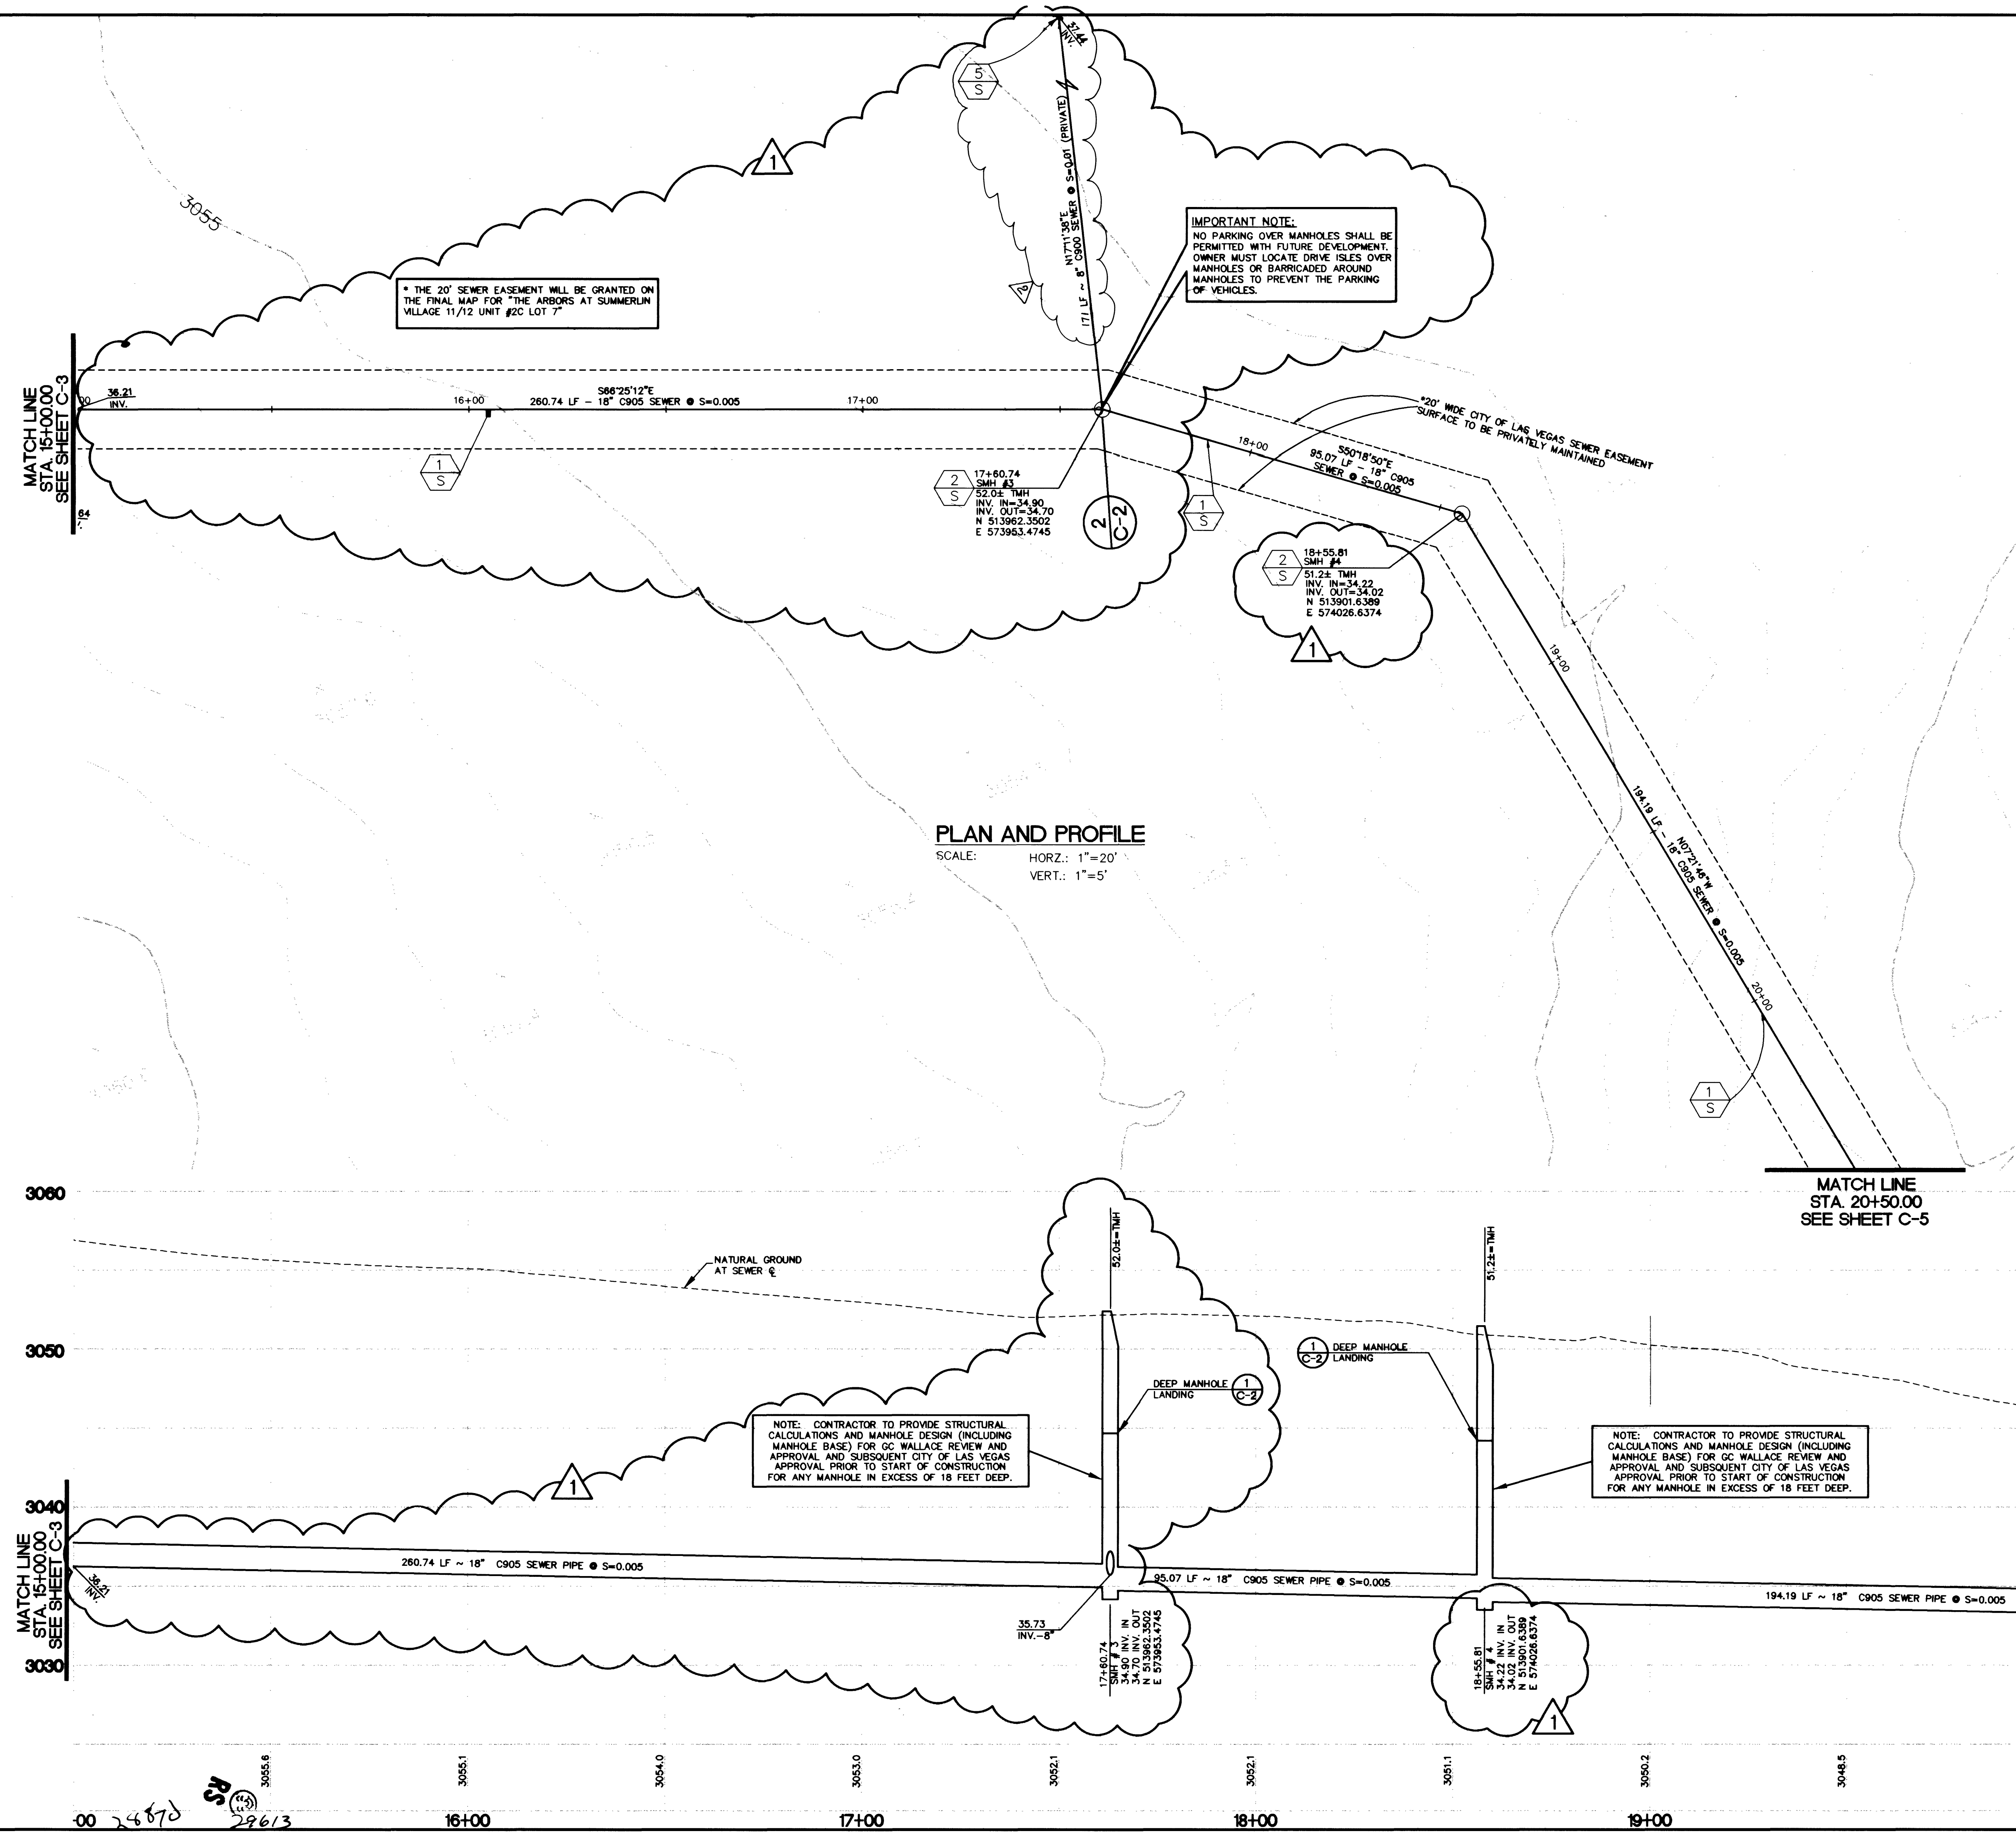

REV # 1
DATE 12/07/2000
BY GREGORY J. WALLACE
CHECKED BY GREGORY J. WALLACE
DESIGNED BY GREGORY J. WALLACE
DRAWN BY GREGORY J. WALLACE
ISSUE DATE 12-07-00
PLOT DATE 11-13-04
PLOT TIME 11:34:44
F:\620-1792\dwg\improva\CPSEWER\CSMR004.dwg

CONSTRUCTION NOTES

1. INSTALL 18" C905 SEWER PIPE.
2. INSTALL DEEP SEWER MANHOLE C-2.
3. EXISTING SEWER LATERAL TO BE REMOVED.
4. CONTRACTOR TO VERIFY EXISTING INVERTS AND LOCATION PRIOR TO CONSTRUCTION. ANY WORK DONE PRIOR TO THIS VERIFICATION SHALL BE THE CONTRACTOR'S RESPONSIBILITY AND COST.
5. INSTALL 8" SEWER PLUG.
6. SEWER PLUG PER SANITATION DISTRICT STANDARDS.
7. CONNECT PROPOSED SEWER LINE TO EXISTING SEWER MANHOLE.

BASIS OF BEARINGS

SOUTH 06°05'51" EAST, BEING THE BEARING OF THE EAST LINE OF SECTION 36, TOWNSHIP 20 SOUTH, RANGE 59 EAST, M.D.M., AS SHOWN BY MAP THEREOF ON FILE IN BOOK 74, PAGE 71 OF PLATS, OFFICIAL RECORDS OF CLARK COUNTY, NEVADA.

BENCHMARK

CITY OF LAS VEGAS BENCHMARK 0LV09 36SSW6
SUMMERLIN DATUM ELEVATION = 3014.06 FT.
NAVD 88 ELEVATION = 919.3496 METERS, 3016.23 FT.

KEY MAP

N.T.S.

REVISIONS

REV #	DATE	BY	DESCRIPTION
1	12/07/2000	GREGORY J. WALLACE	ISSUE DATE 12-07-00

PROJECT INFORMATION

SHEET C-4
4 OF 5 SHTS

307-V800