

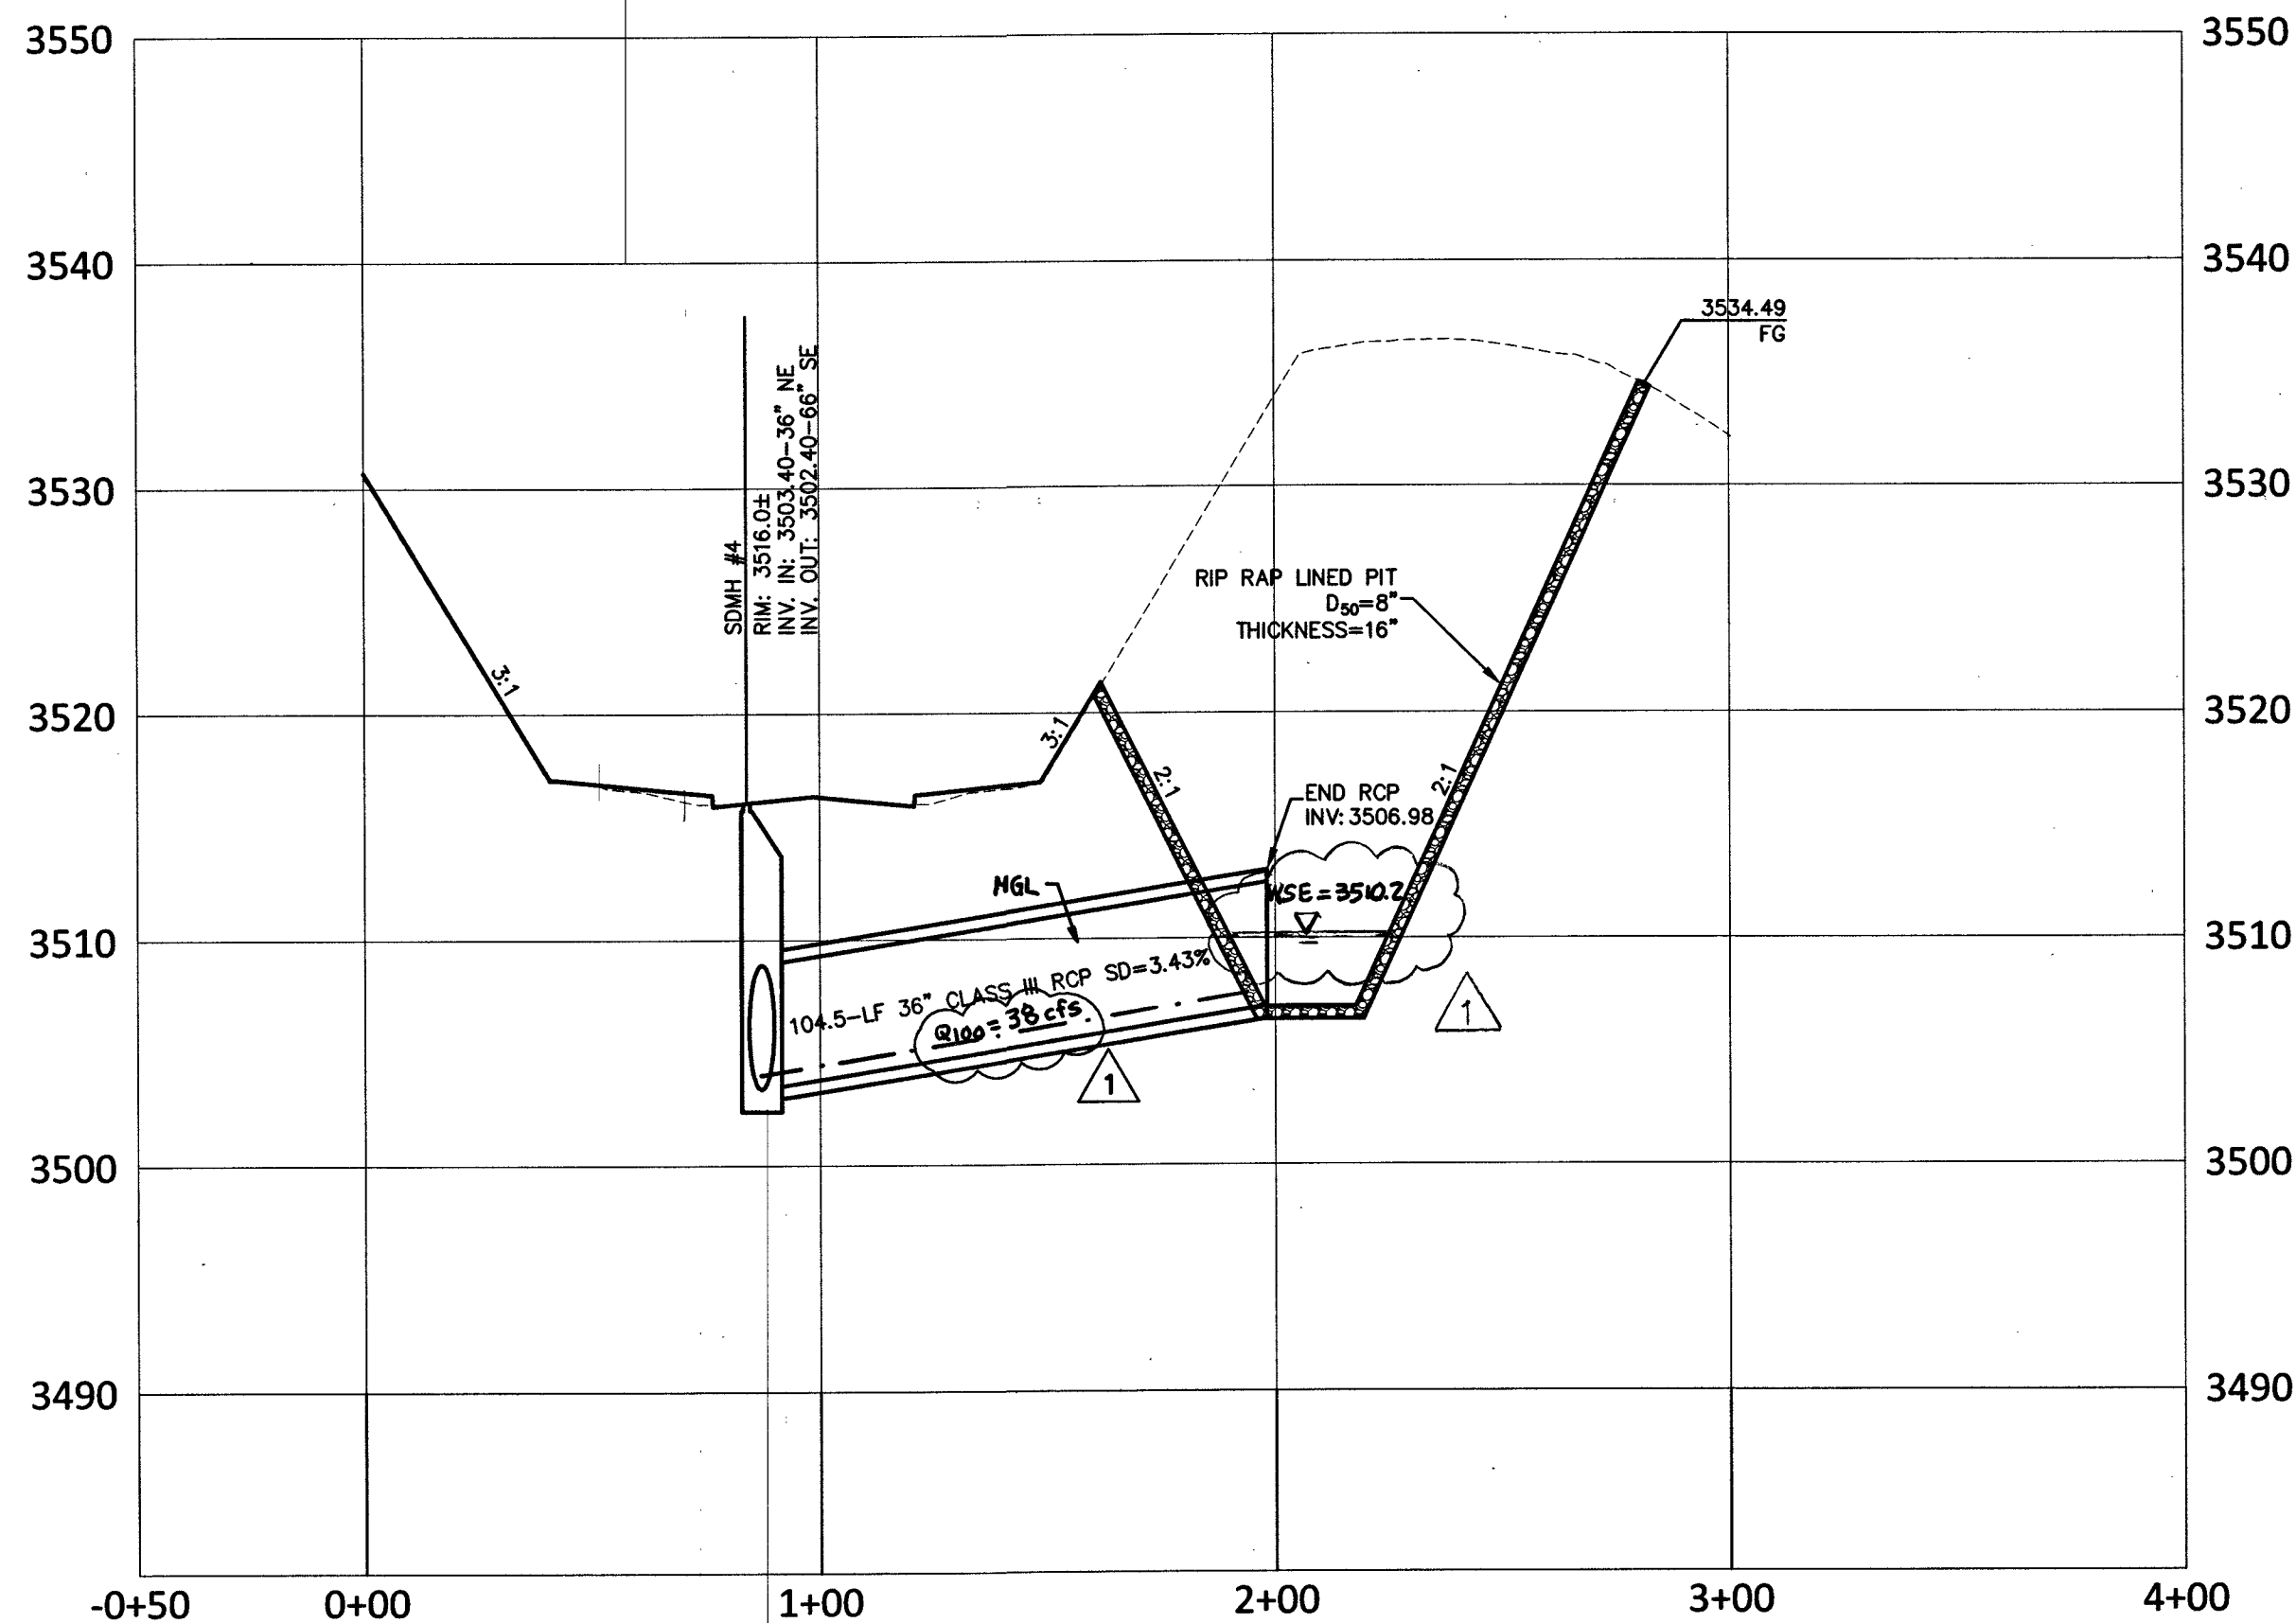


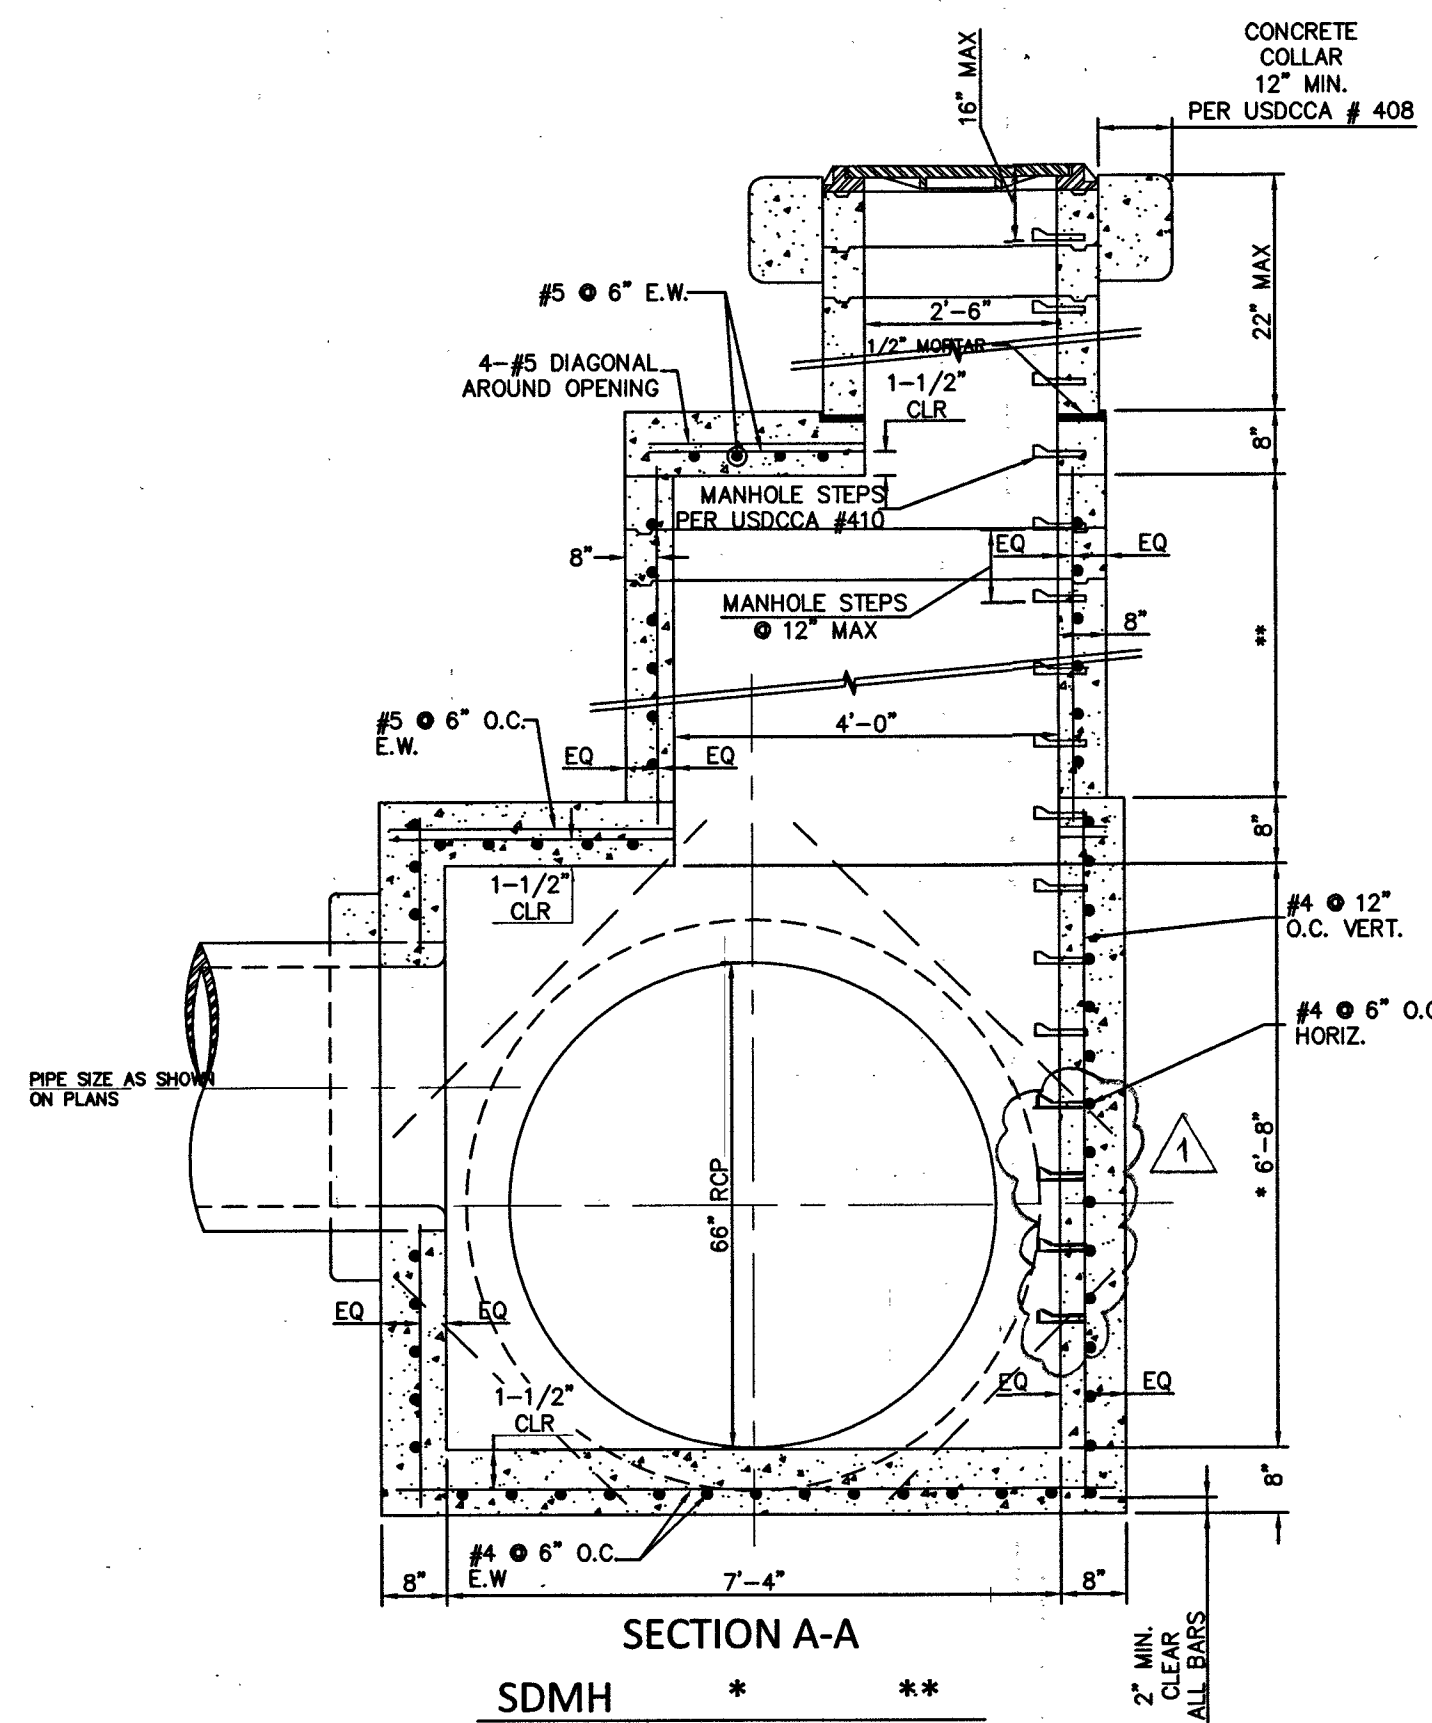


6
C8.02
36" STORM DRAIN LINE
● STA: 20+67.73 H: 1"=20' V: 1"=5'

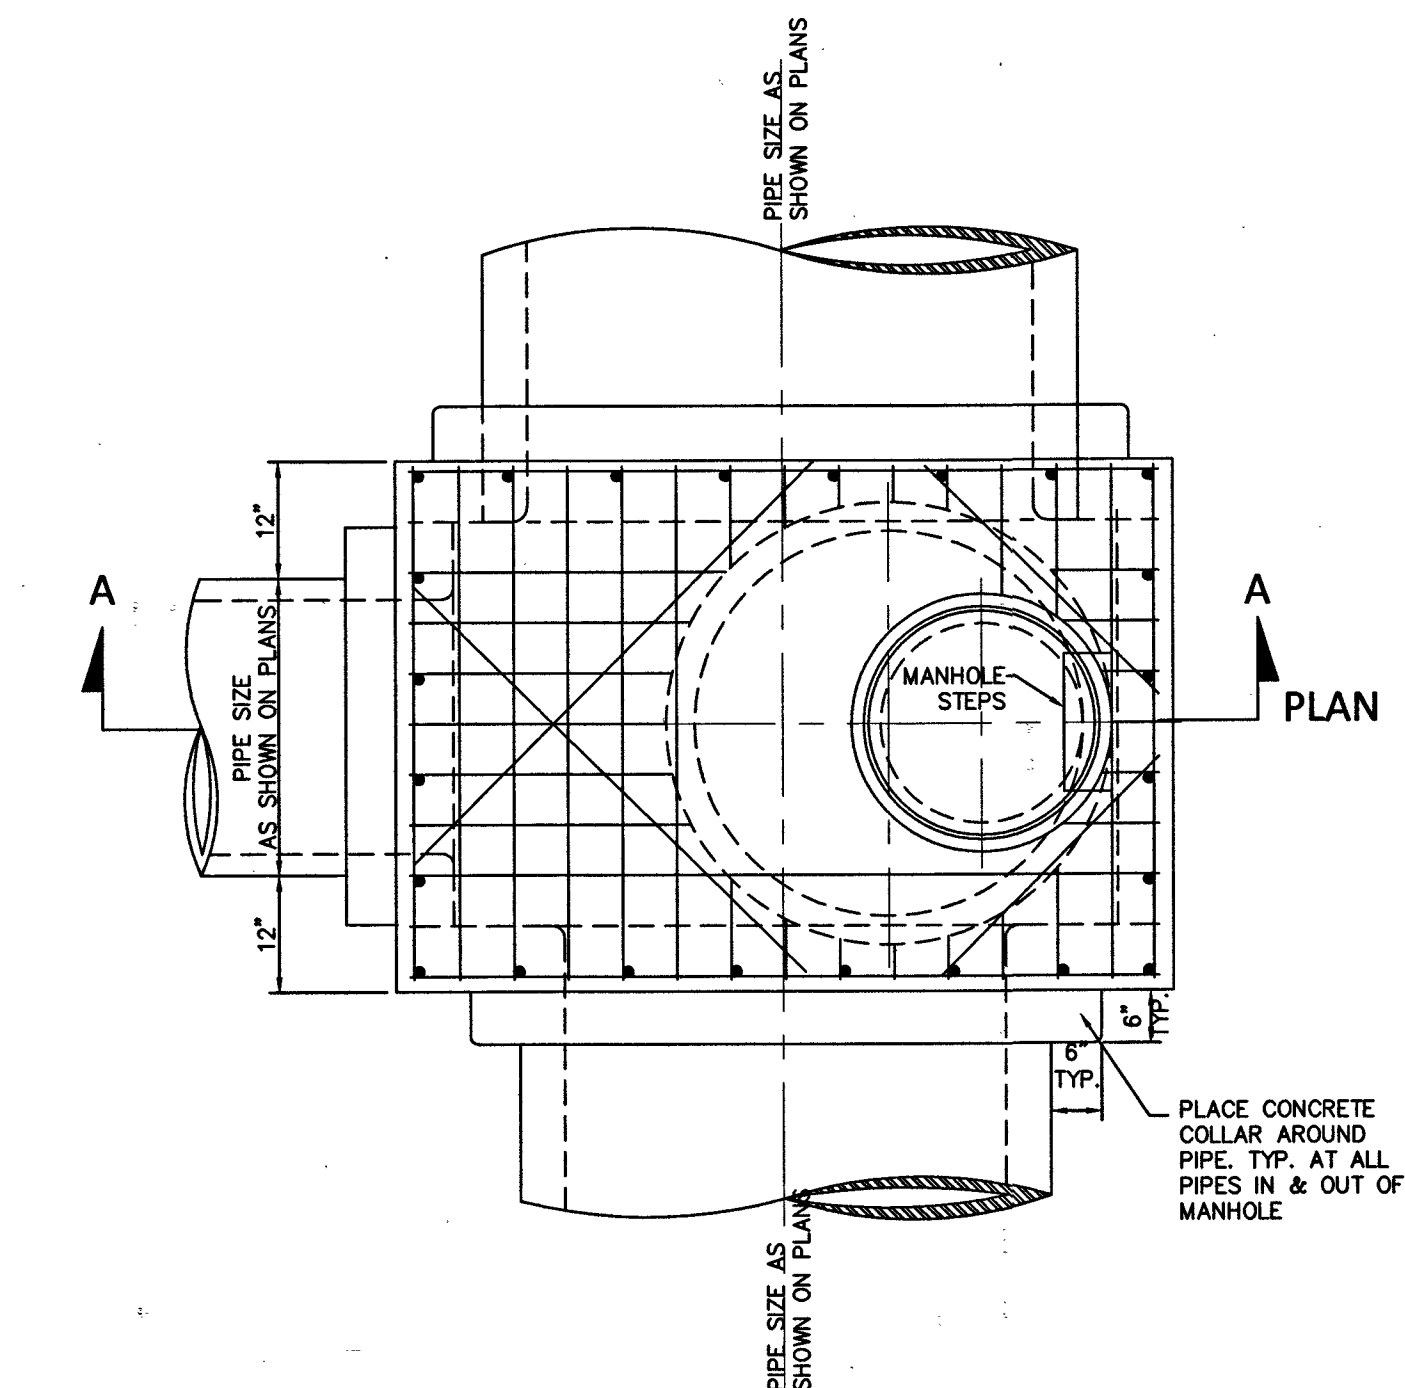


SECTION A-A

SDMH	*	**
1	6'-8"	4'-0"
2	6'-8"	3'-0"
3	6'-8"	4'-0"
4	6'-8"	4'-0"
5	10'-0"	1'-0"
6	6'-8"	4'-0"
7	6'-8"	4'-0"
8	6'-8"	5'-0"

7
C8.02
MANHOLE DETAIL
NTS

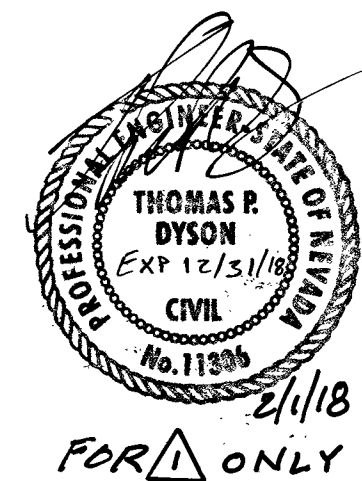

COLLINS ENGINEERS
3130 S. DURANGO DR., SUITE 404
LAS VEGAS, NV 89117
PHONE: (702) 248-8000
FAX: (702) 248-8070
WWW.COLLINSENGR.COM

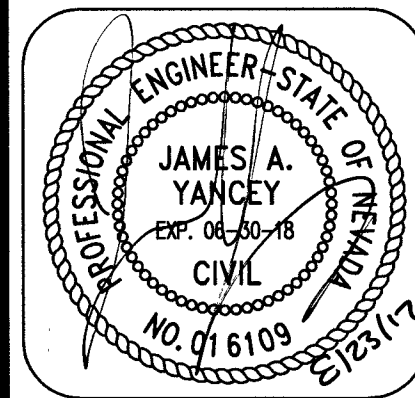

IMPROVEMENT PLANS FOR
THE HOWARD HUGHES COMPANY, LLC
APN: 137-33-601-001
DETAILS SHEET 2
SUMMERLIN VILLAGE 24 - CROSSBRIDGE DRIVE UNIT 3
CITY OF LAS VEGAS

NO.	DATE	DESCRIPTION
1	12/27/17	DESIGN BY: J. SALDIVAR
2		DRAWN BY: J. SALDIVAR
3		CHECKED BY: K. YAMADA
4		DATE: 04/20/17
5		SCALE:
6		SHEET NUMBER
7		C8.02
8		SHEET 24 OF 26

107V7063