



NOTES:



- 1 TYPE I OR SCARIFY NATIVE 6" AND RECOMPACT TO 95%
- 2 LANDSCAPE AREA: EXCAVATE AND RECOMPACT TO 85% RIP ENTIRE AREA TO DEPTH INDICATED.
- 3 ROUGH GRADE (R.G.) TO BE 6" BELOW FINISHED GRADE (F.G.) FOR FUTURE LANDSCAPE PURPOSES.
- 4 6" MIN TYPE II AGGREGATE BASE UNDER CURB AND GUTTER, TYPICAL.

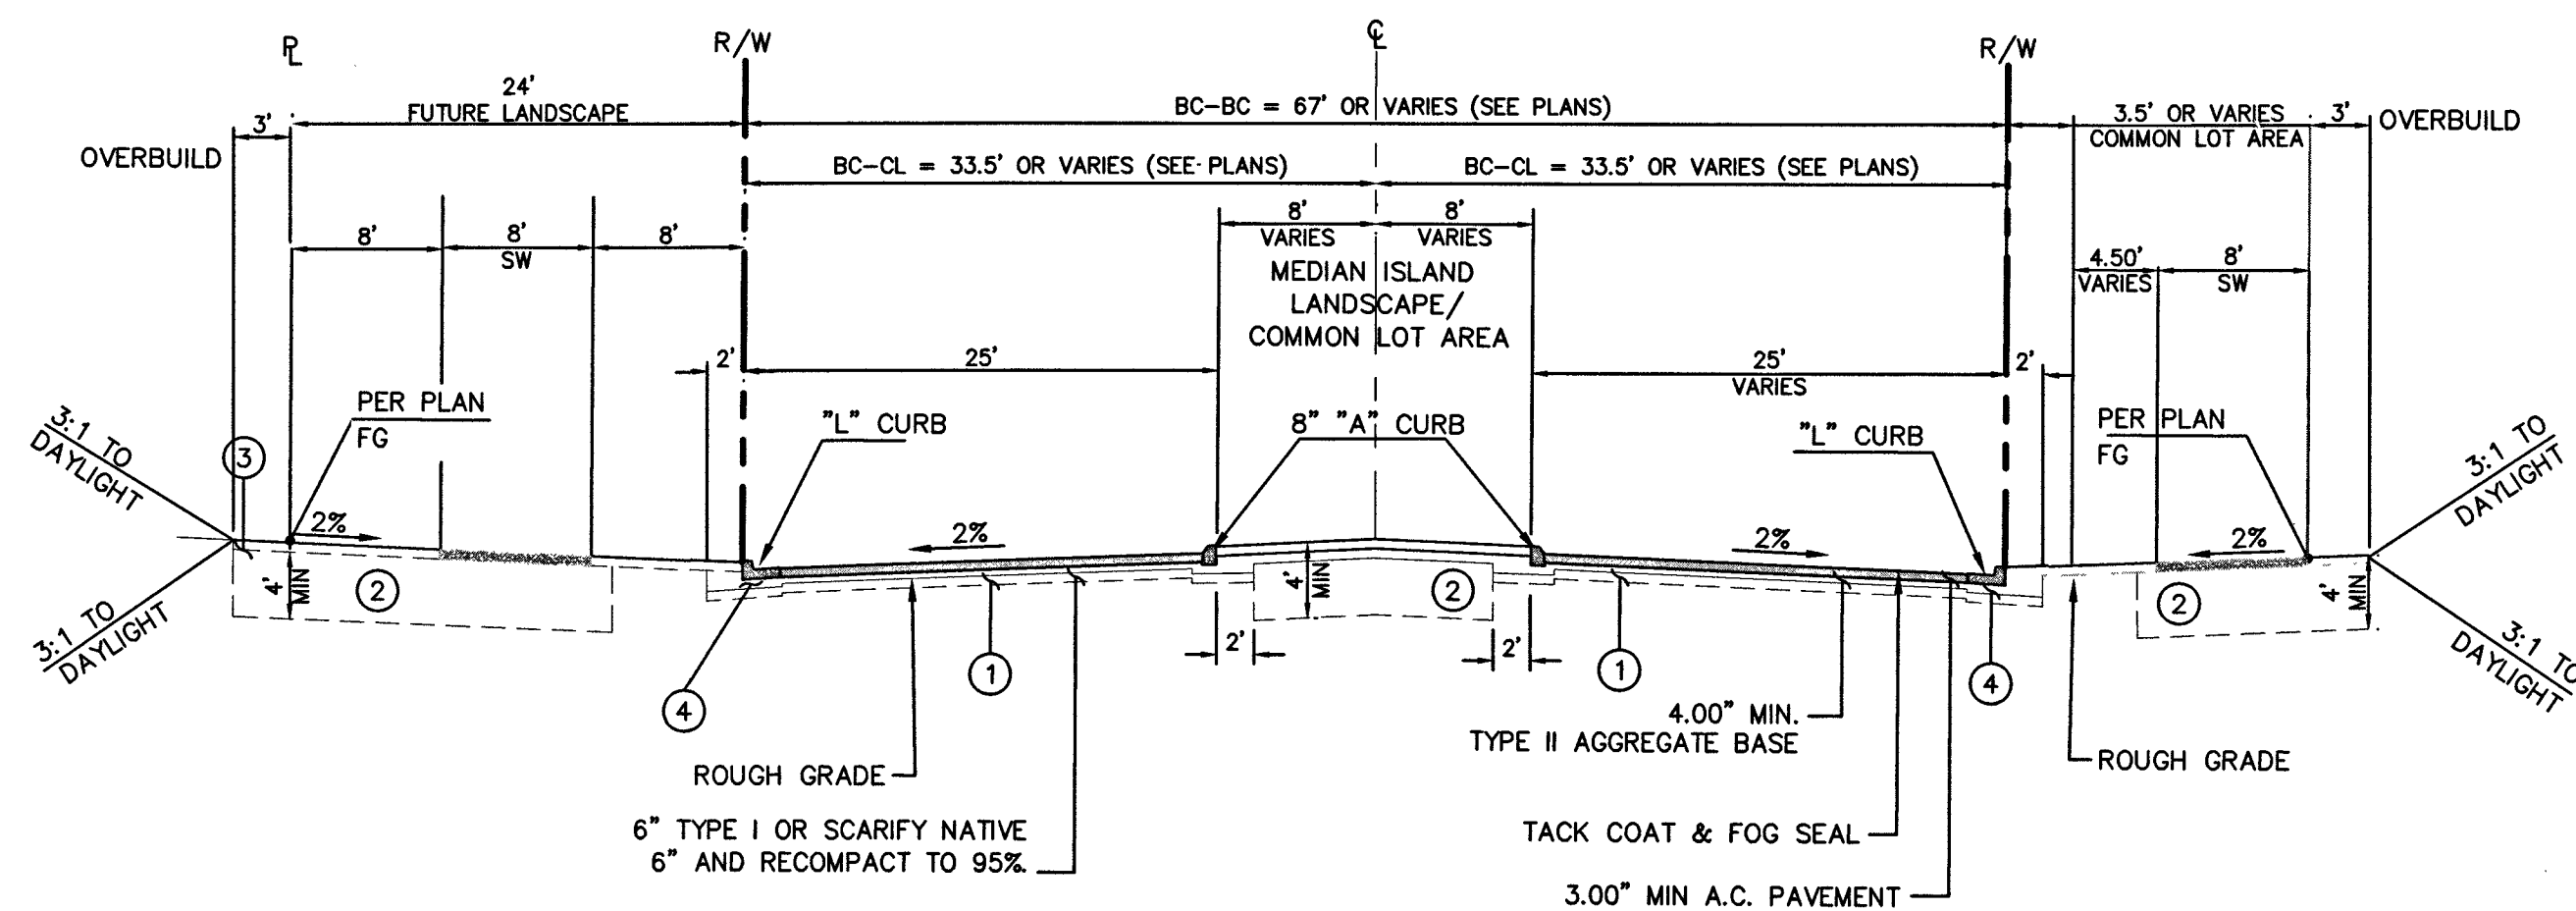


1 CROSSBRIDGE DRIVE
C8.01 STA 6+25.51 THRU STA 12+24.51 NTS

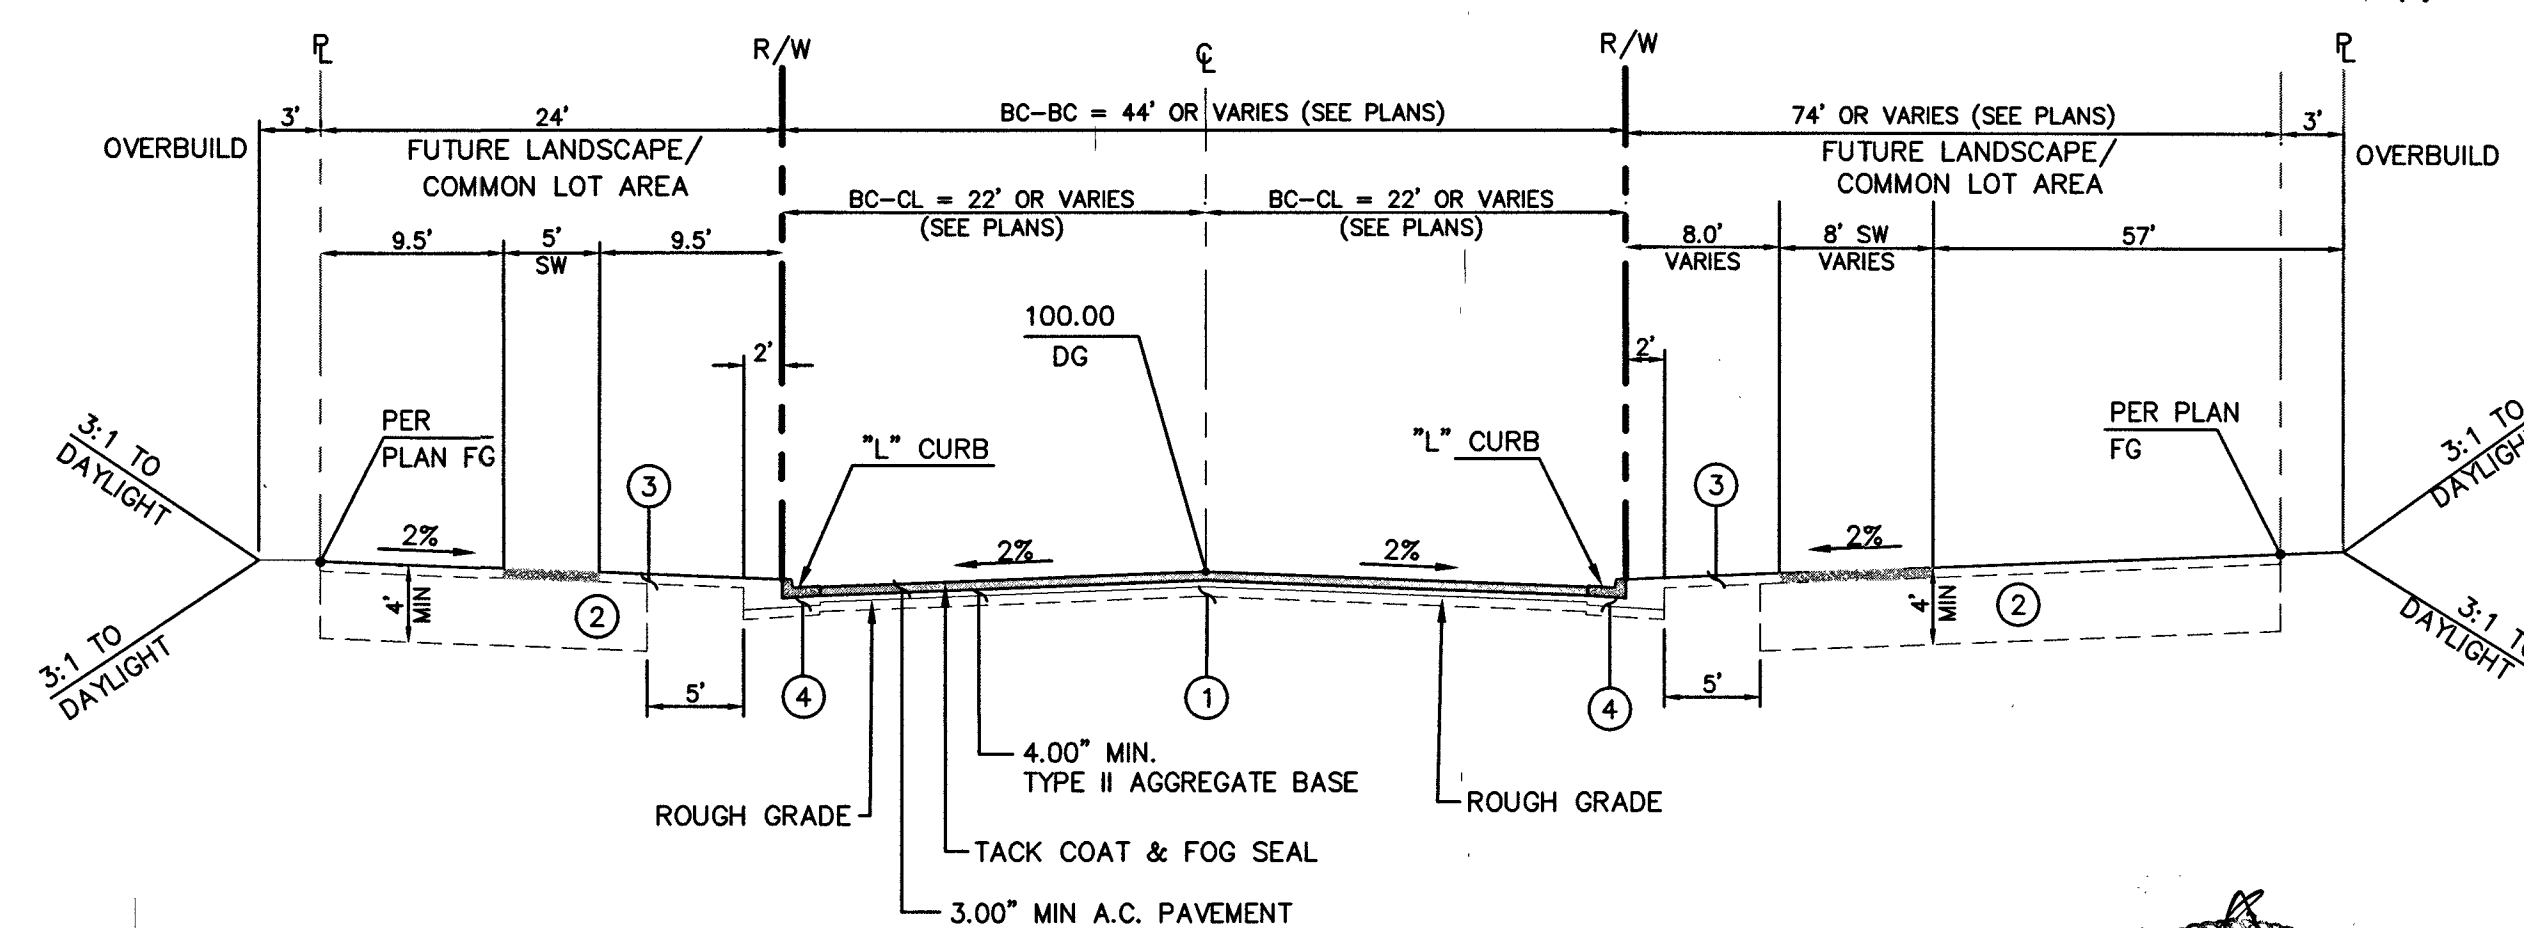


2 CROSSBRIDGE DRIVE
C8.01 STA 13+79.24 THRU STA 30+60.00 NTS

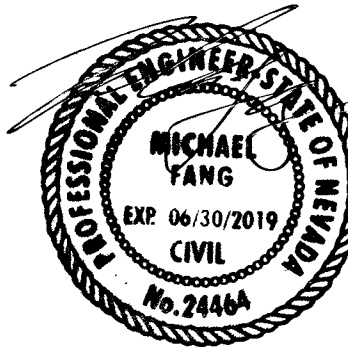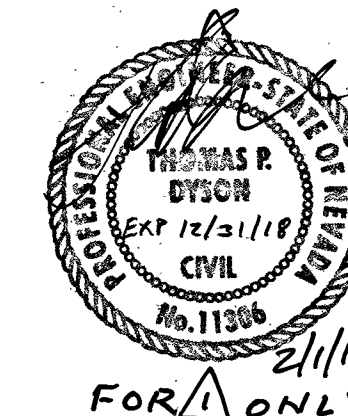

3 FOR REV 3 ONLY

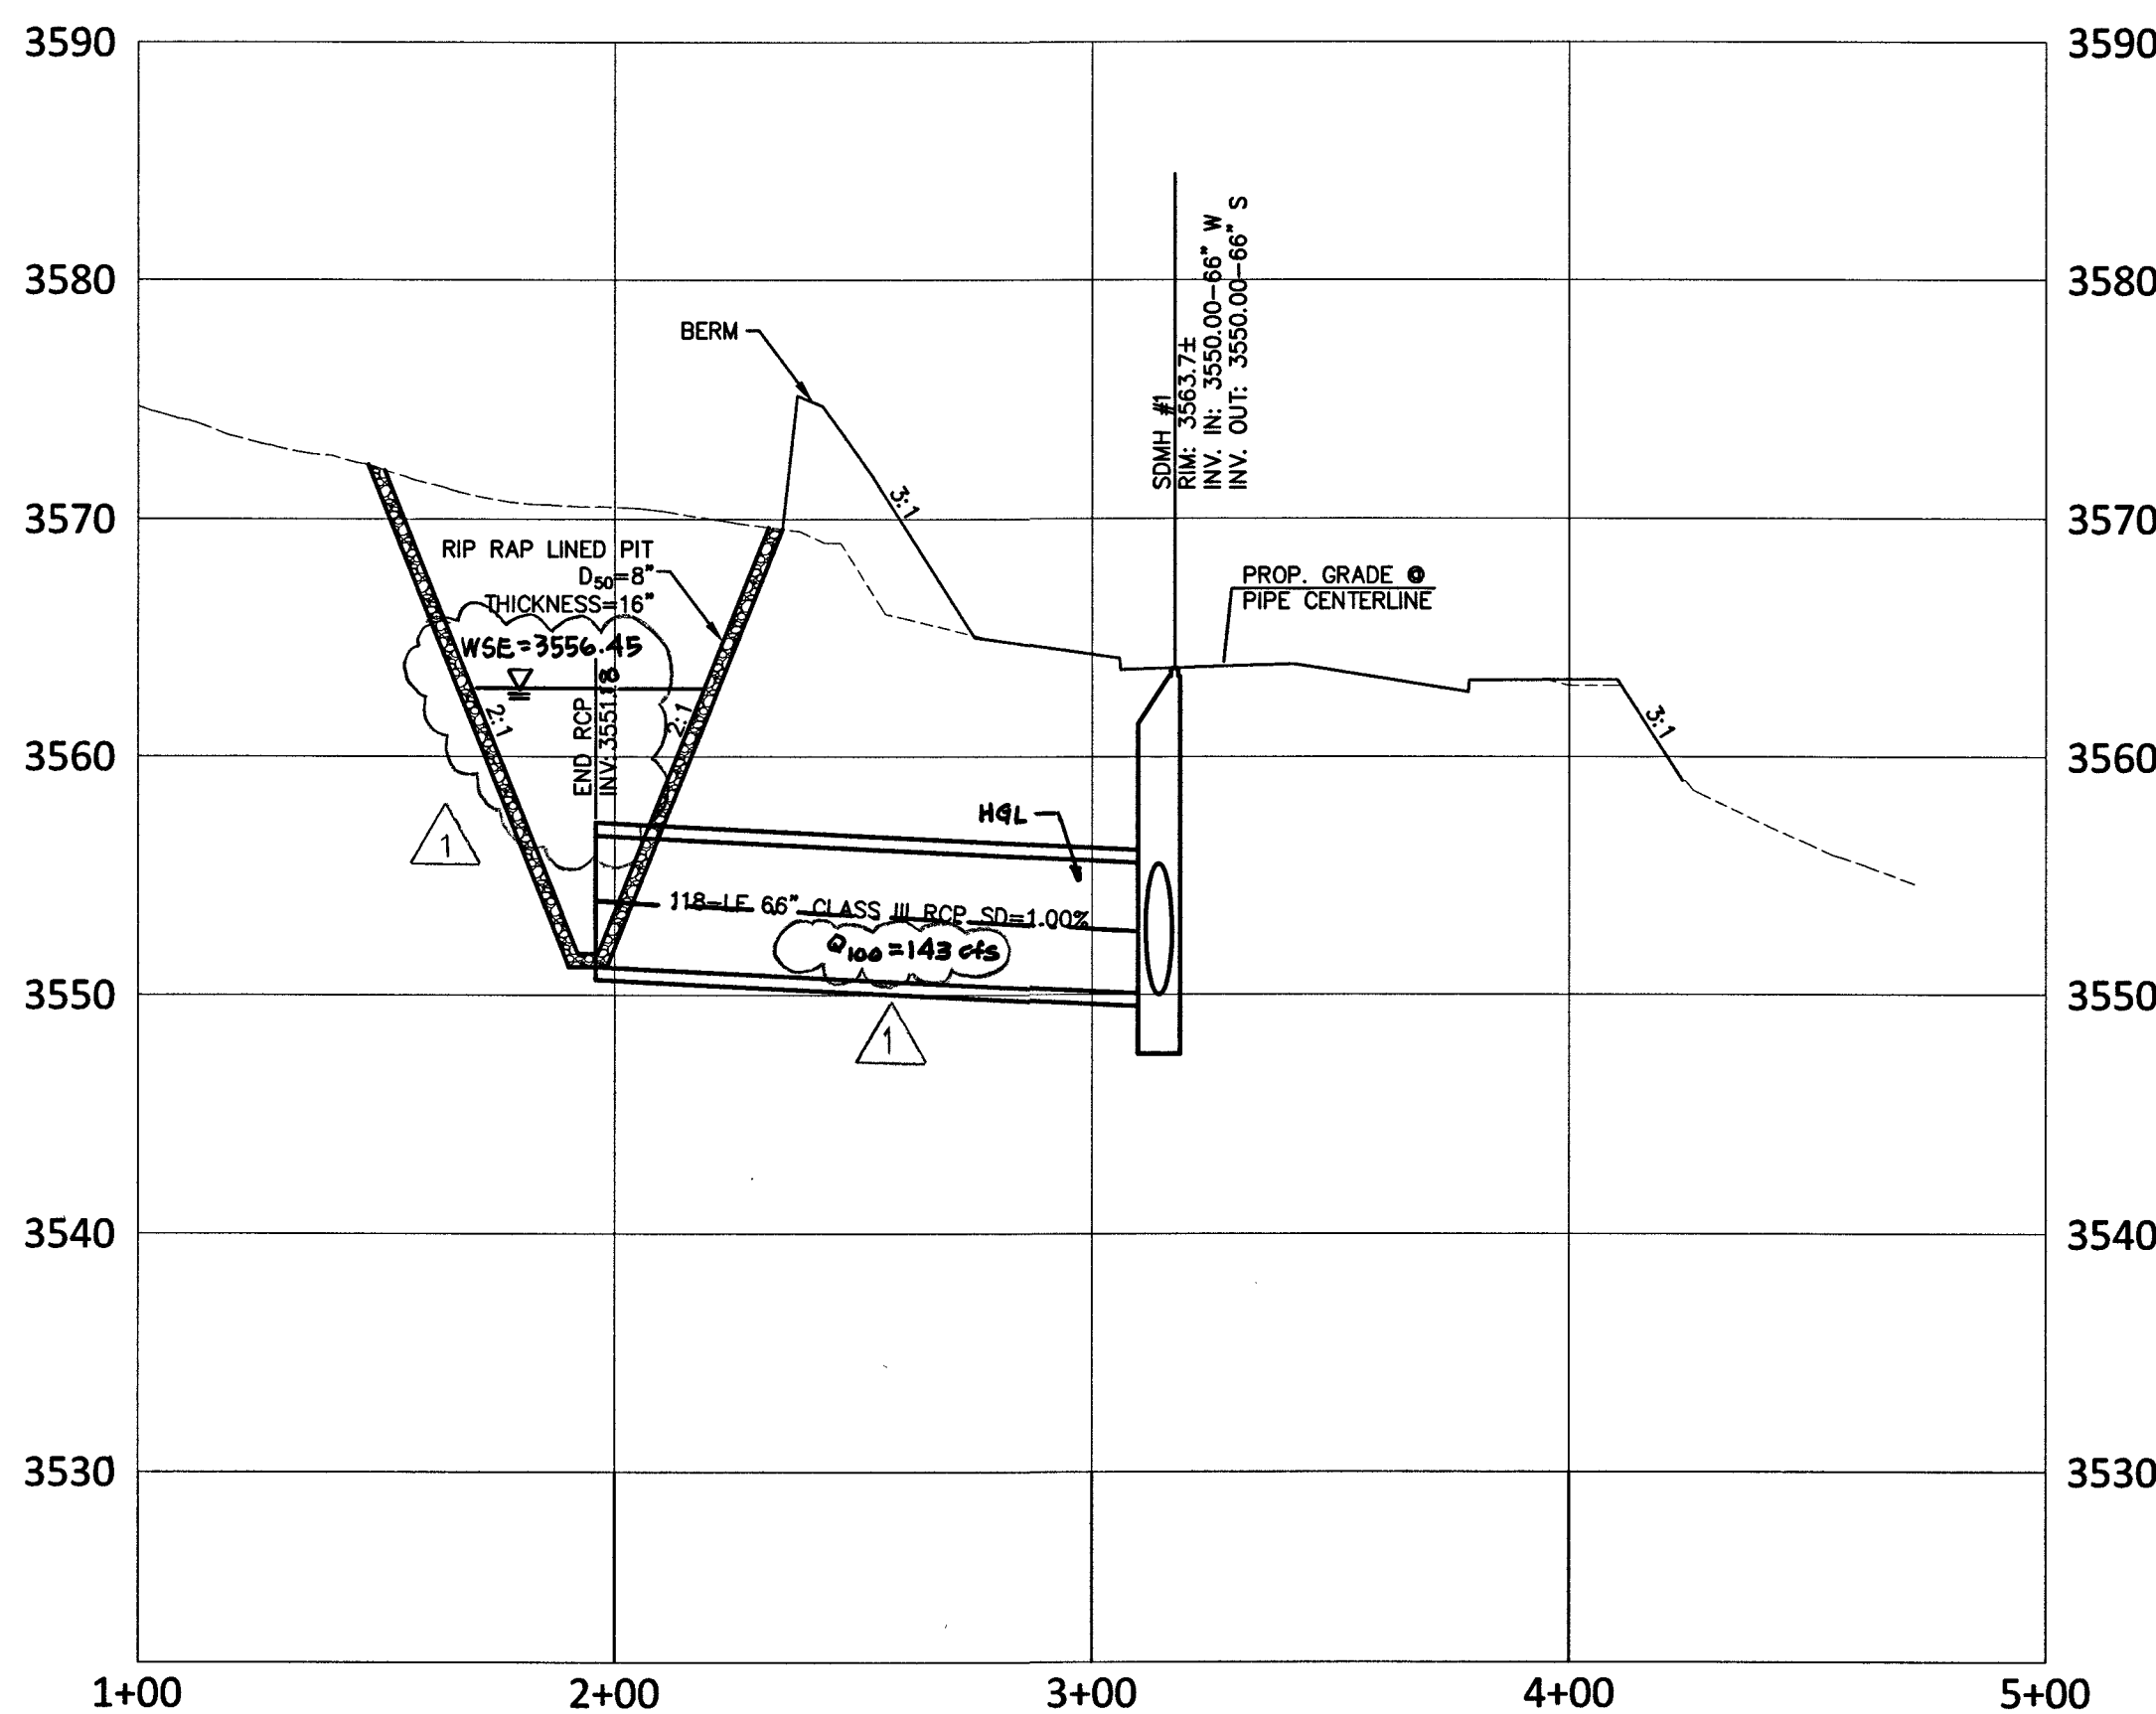

3 66" STORM DRAIN LINE
C8.01 @ STA: 13+01.69 H: 1"=20' V: 1"=5'

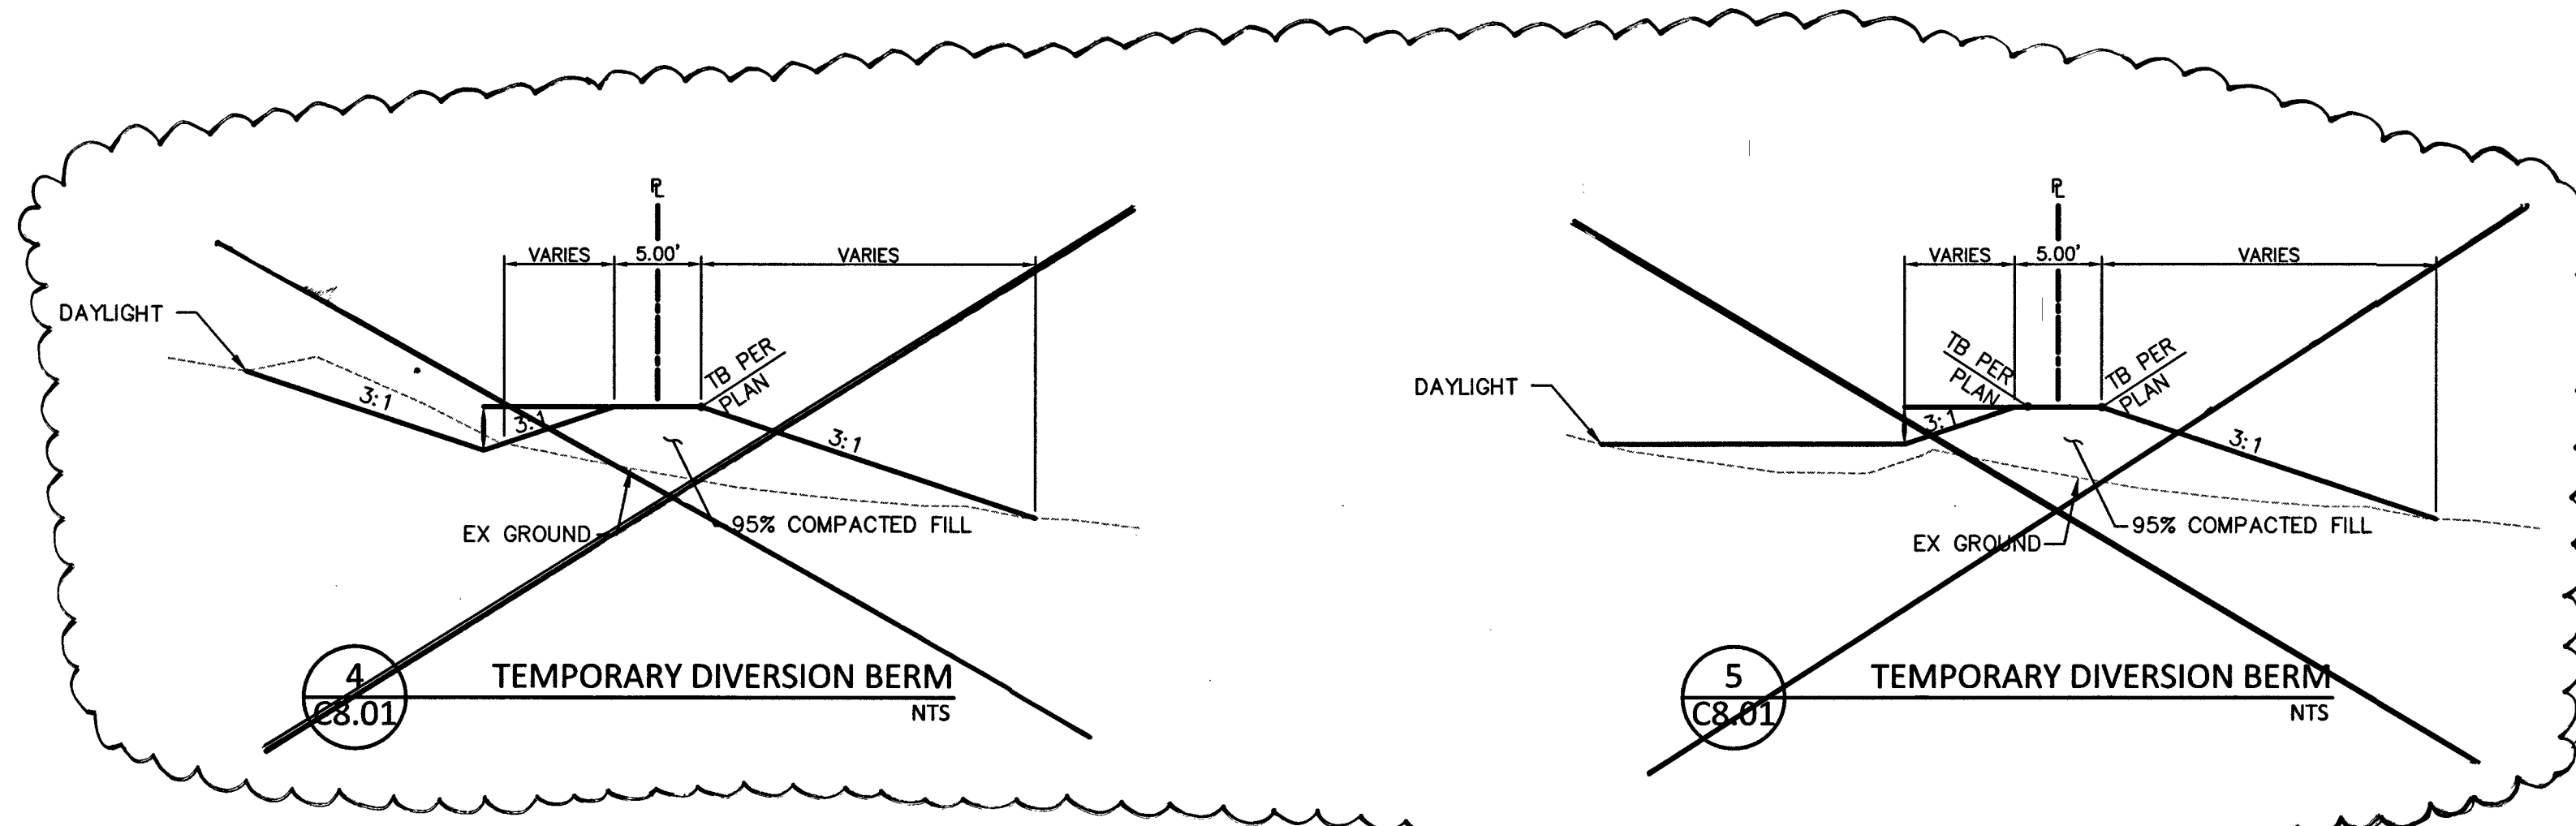


4 TEMPORARY DIVERSION BERM
C8.01 NTS

5 TEMPORARY DIVERSION BERM
C8.01 NTS

APPROVED FOR CONSTRUCTION
LAS VEGAS VALLEY-WATER DISTRICT ENGINEERING SERVICES MANAGER
PROJECT NO: 124806 DATE: 8/31/17

107V7063

COLLINS ENGINEERS
3130 S. DURANGO DR., SUITE 404
LAS VEGAS, NV 89117
PHONE: (702) 248-8000
FAX: (702) 248-8070
WWW.COLLINSENGINEERS.COM

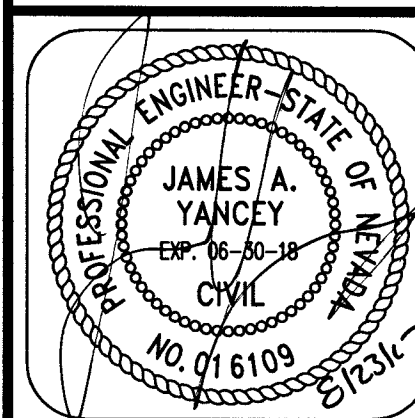

IMPROVEMENT PLANS FOR THE HOWARD HUGHES COMPANY, LLC
APN: 137-33-601-001
DETAILS SHEET 1
SUMMERLIN VILLAGE 24 - CROSSBRIDGE DRIVE UNIT 3
CITY OF LAS VEGAS

NO.	DATE	DESIGN BY	DESCRIPTION
1	12/27/17	APD BY J.M.	2/27/18
2	05/08/18	APD BY J.M.	REMOVE BERM.
3			

CEI PROJECT: 9106
DESIGN BY: J. SALDIVAR
DRAWN BY: J. SALDIVAR
CHECKED BY: K. YAMADA

DATE: 04/2017
SCALE:

SHEET NUMBER
C8.01
SHEET 23 OF 26

Hue5276