
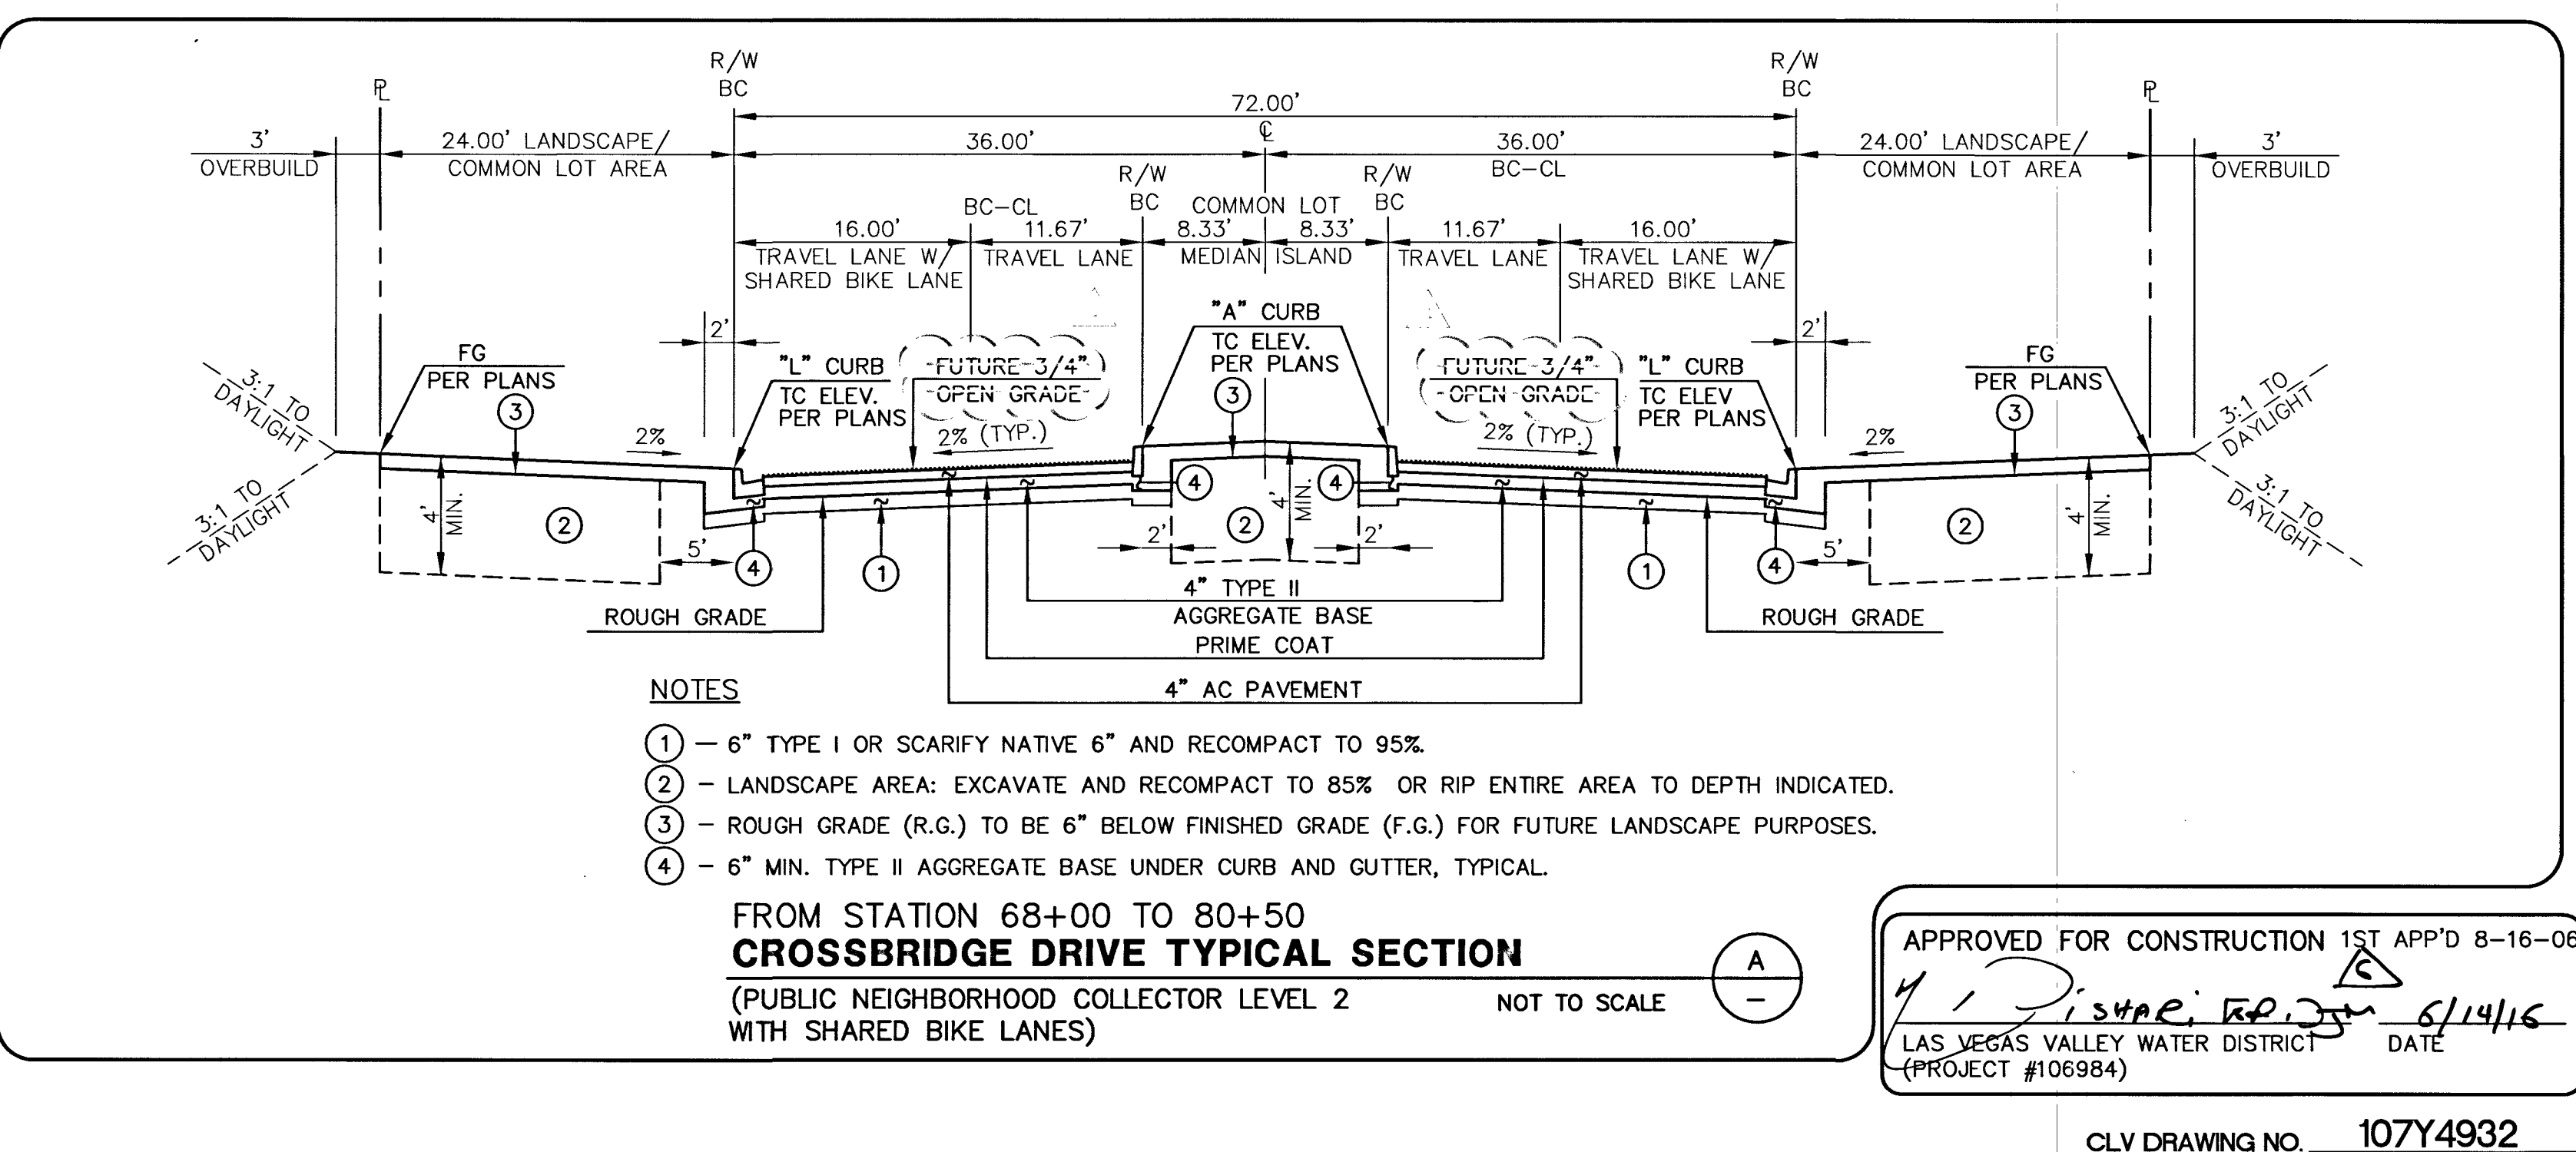
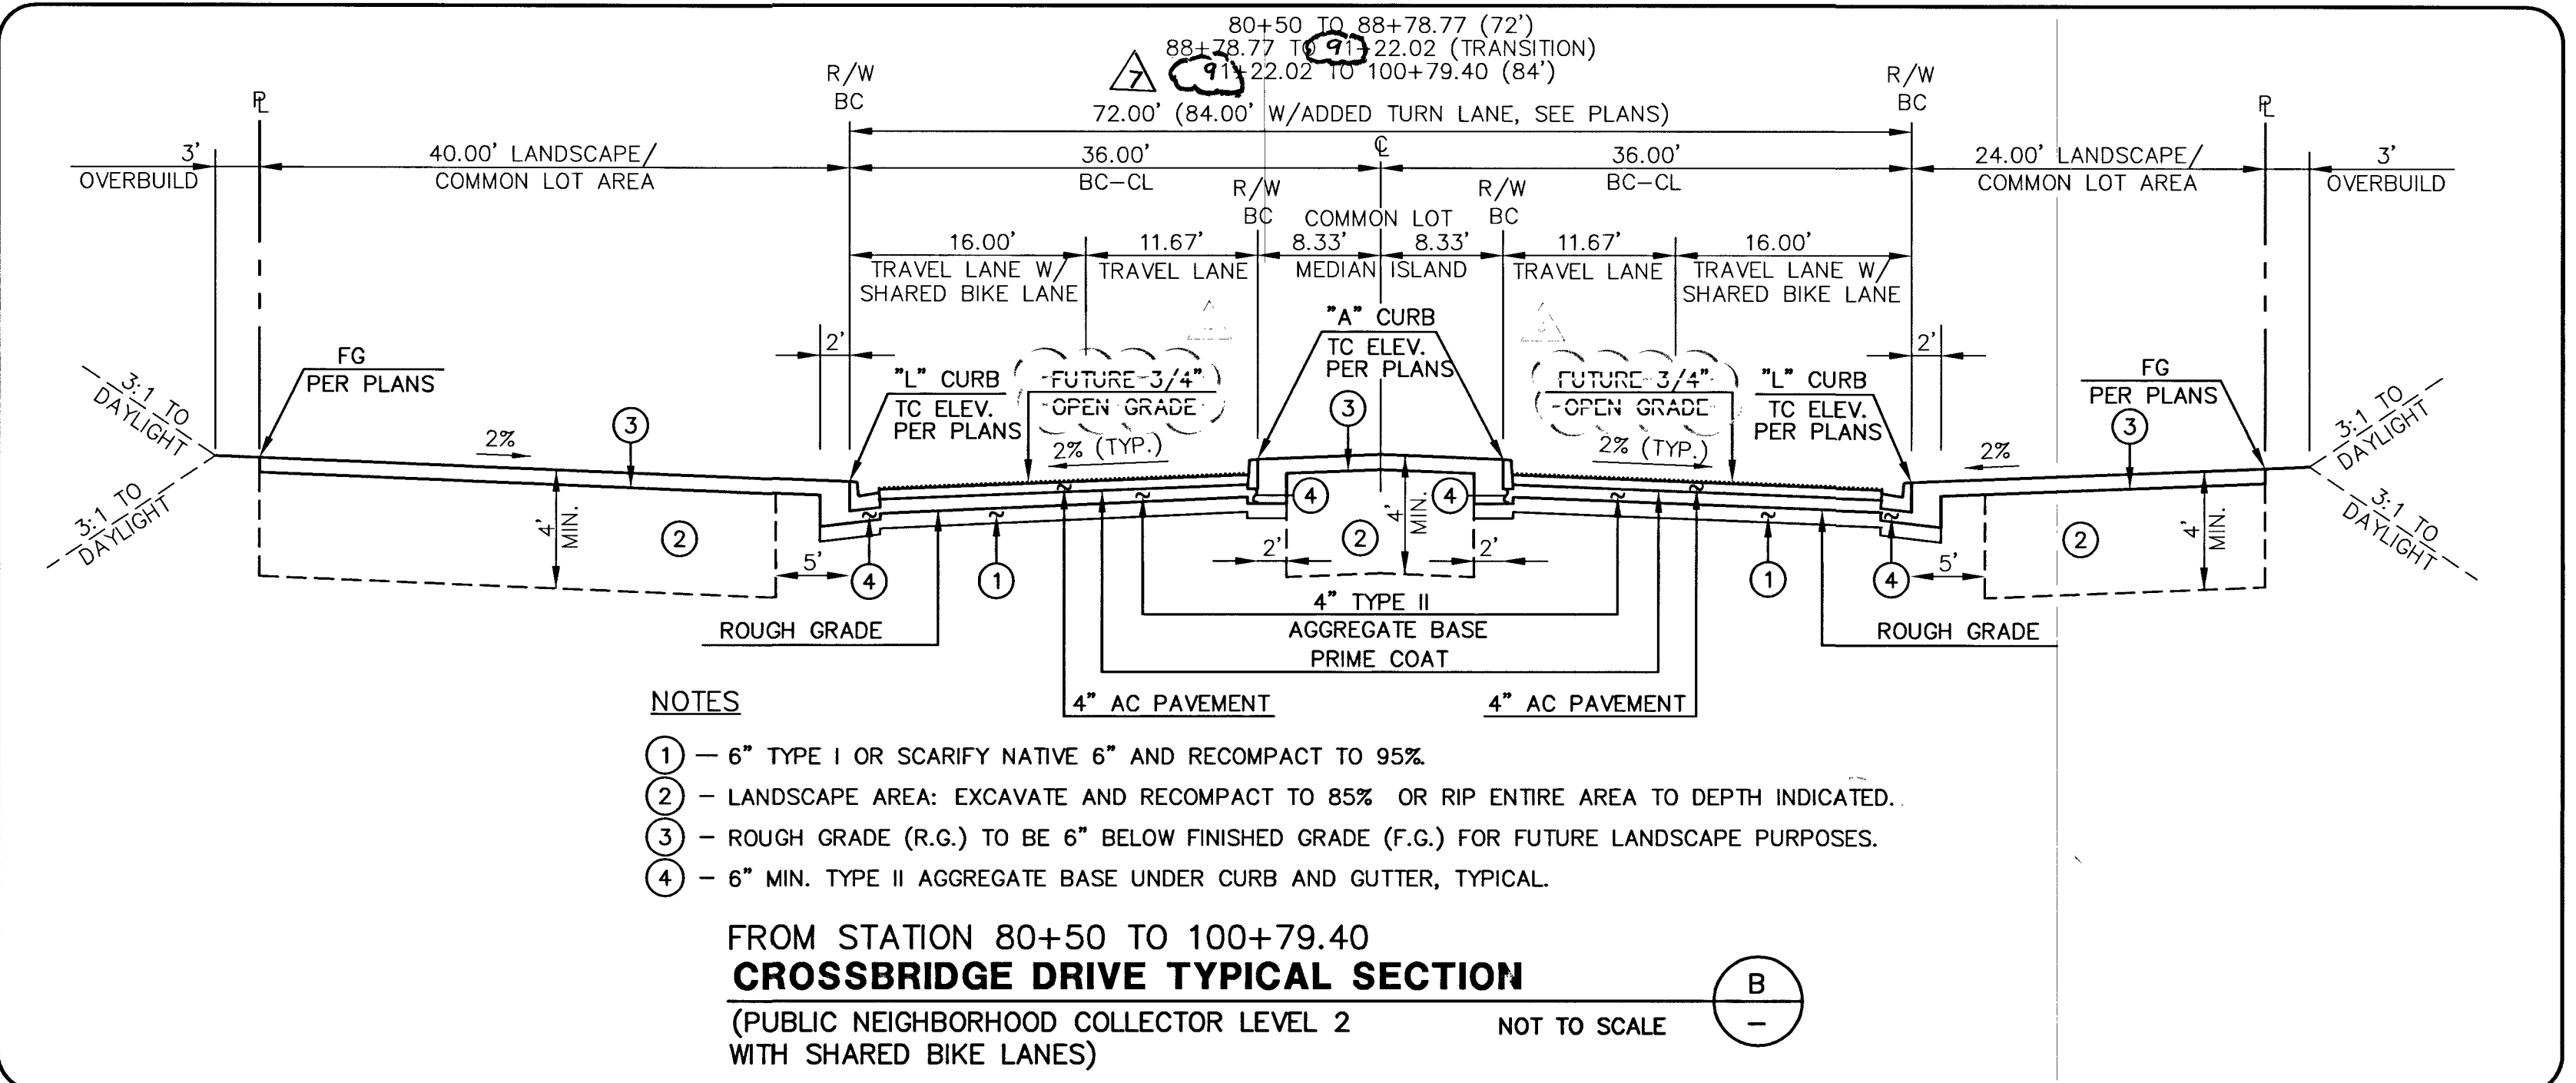
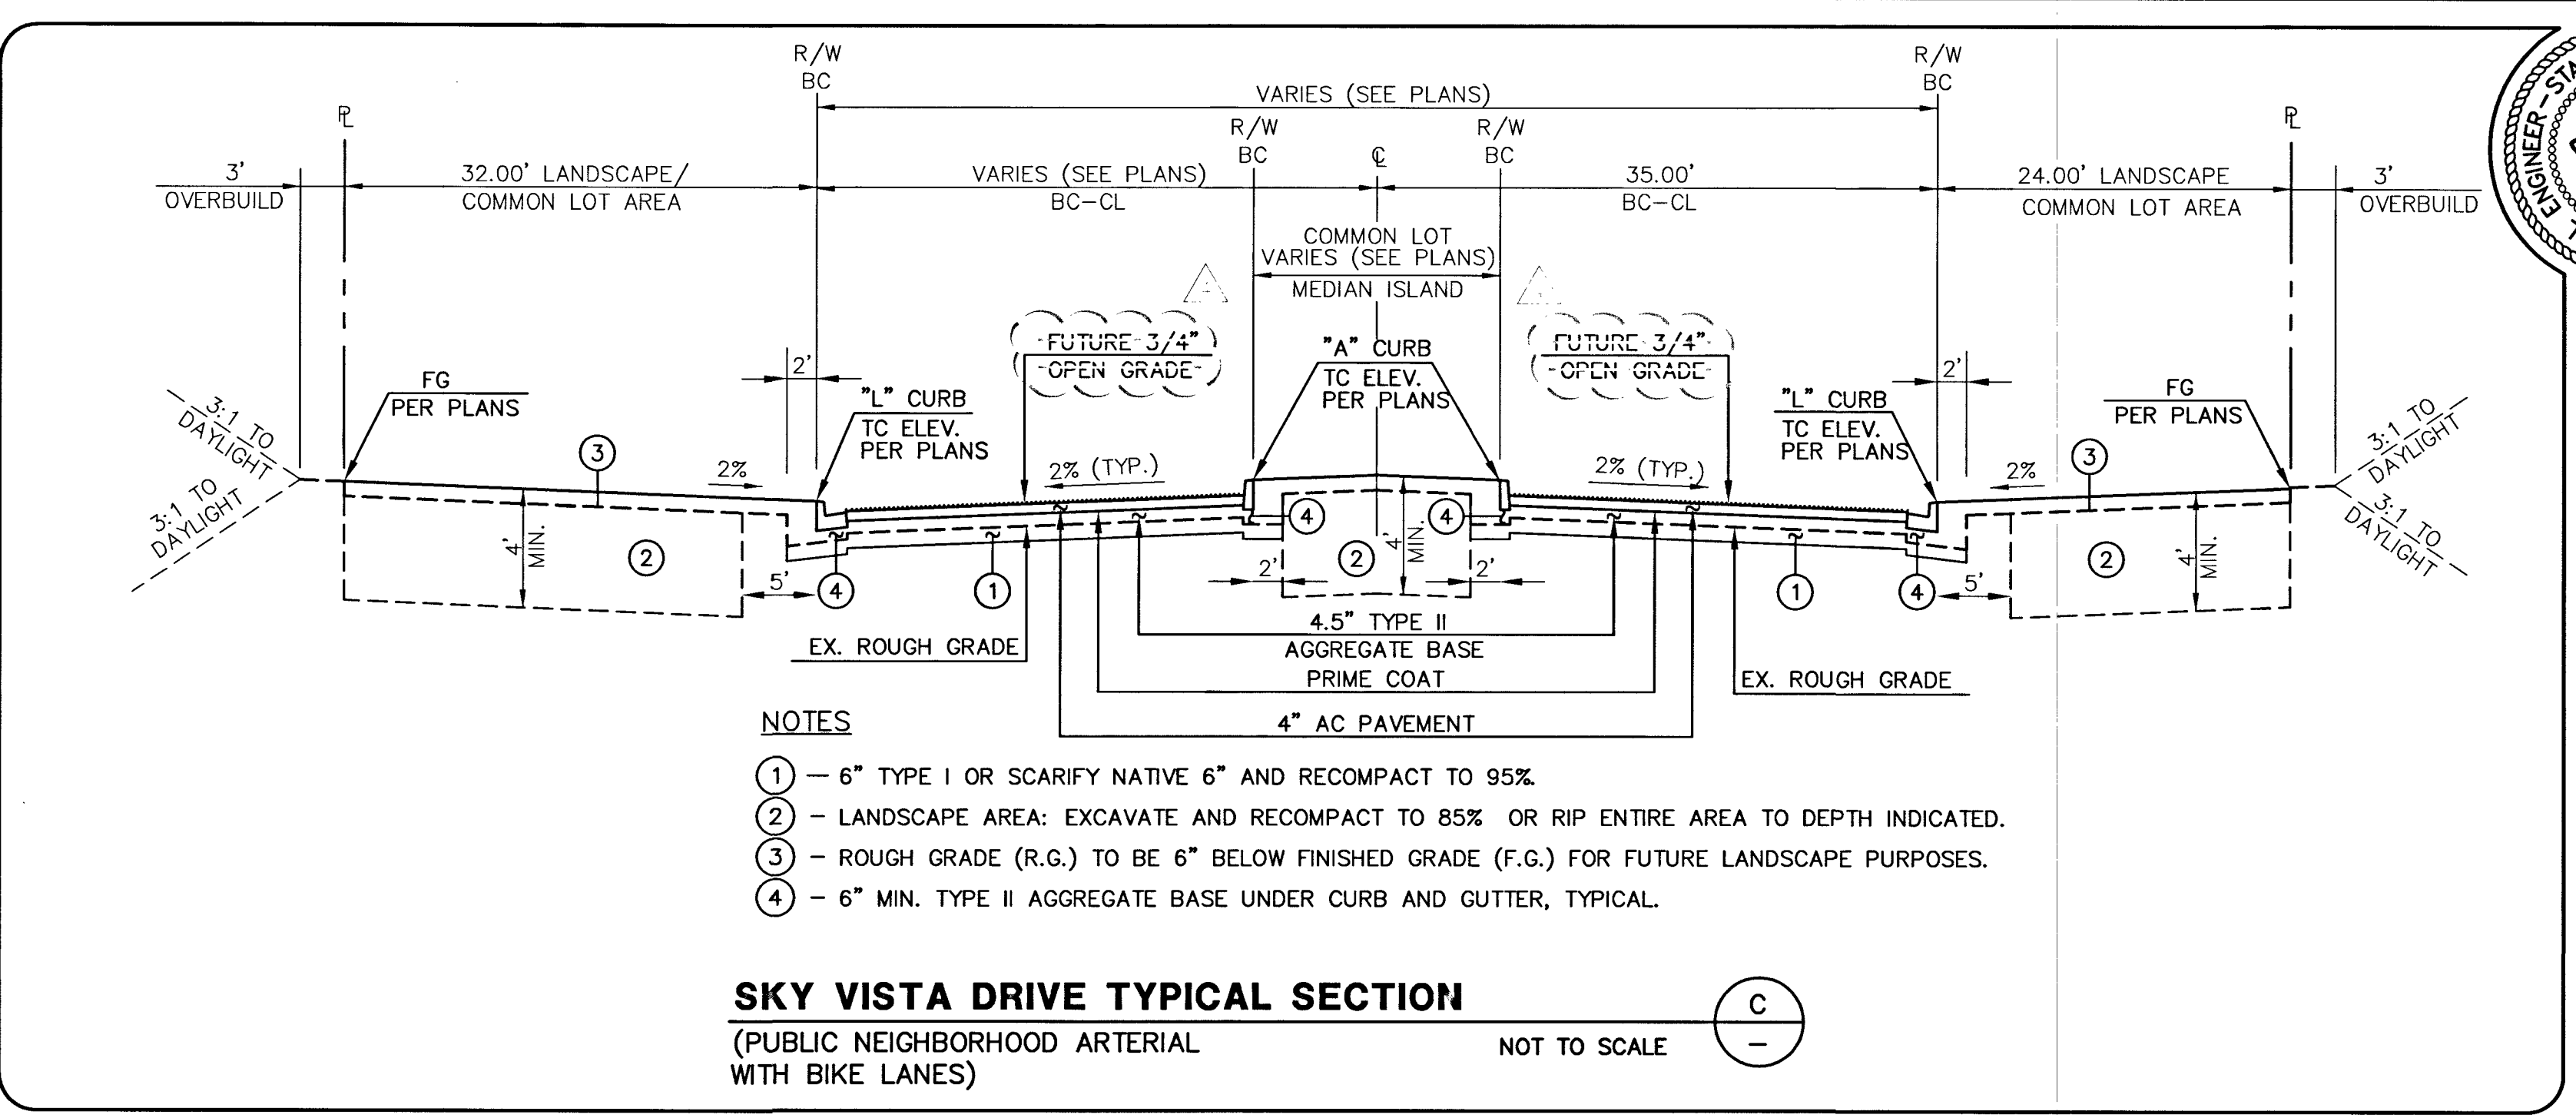
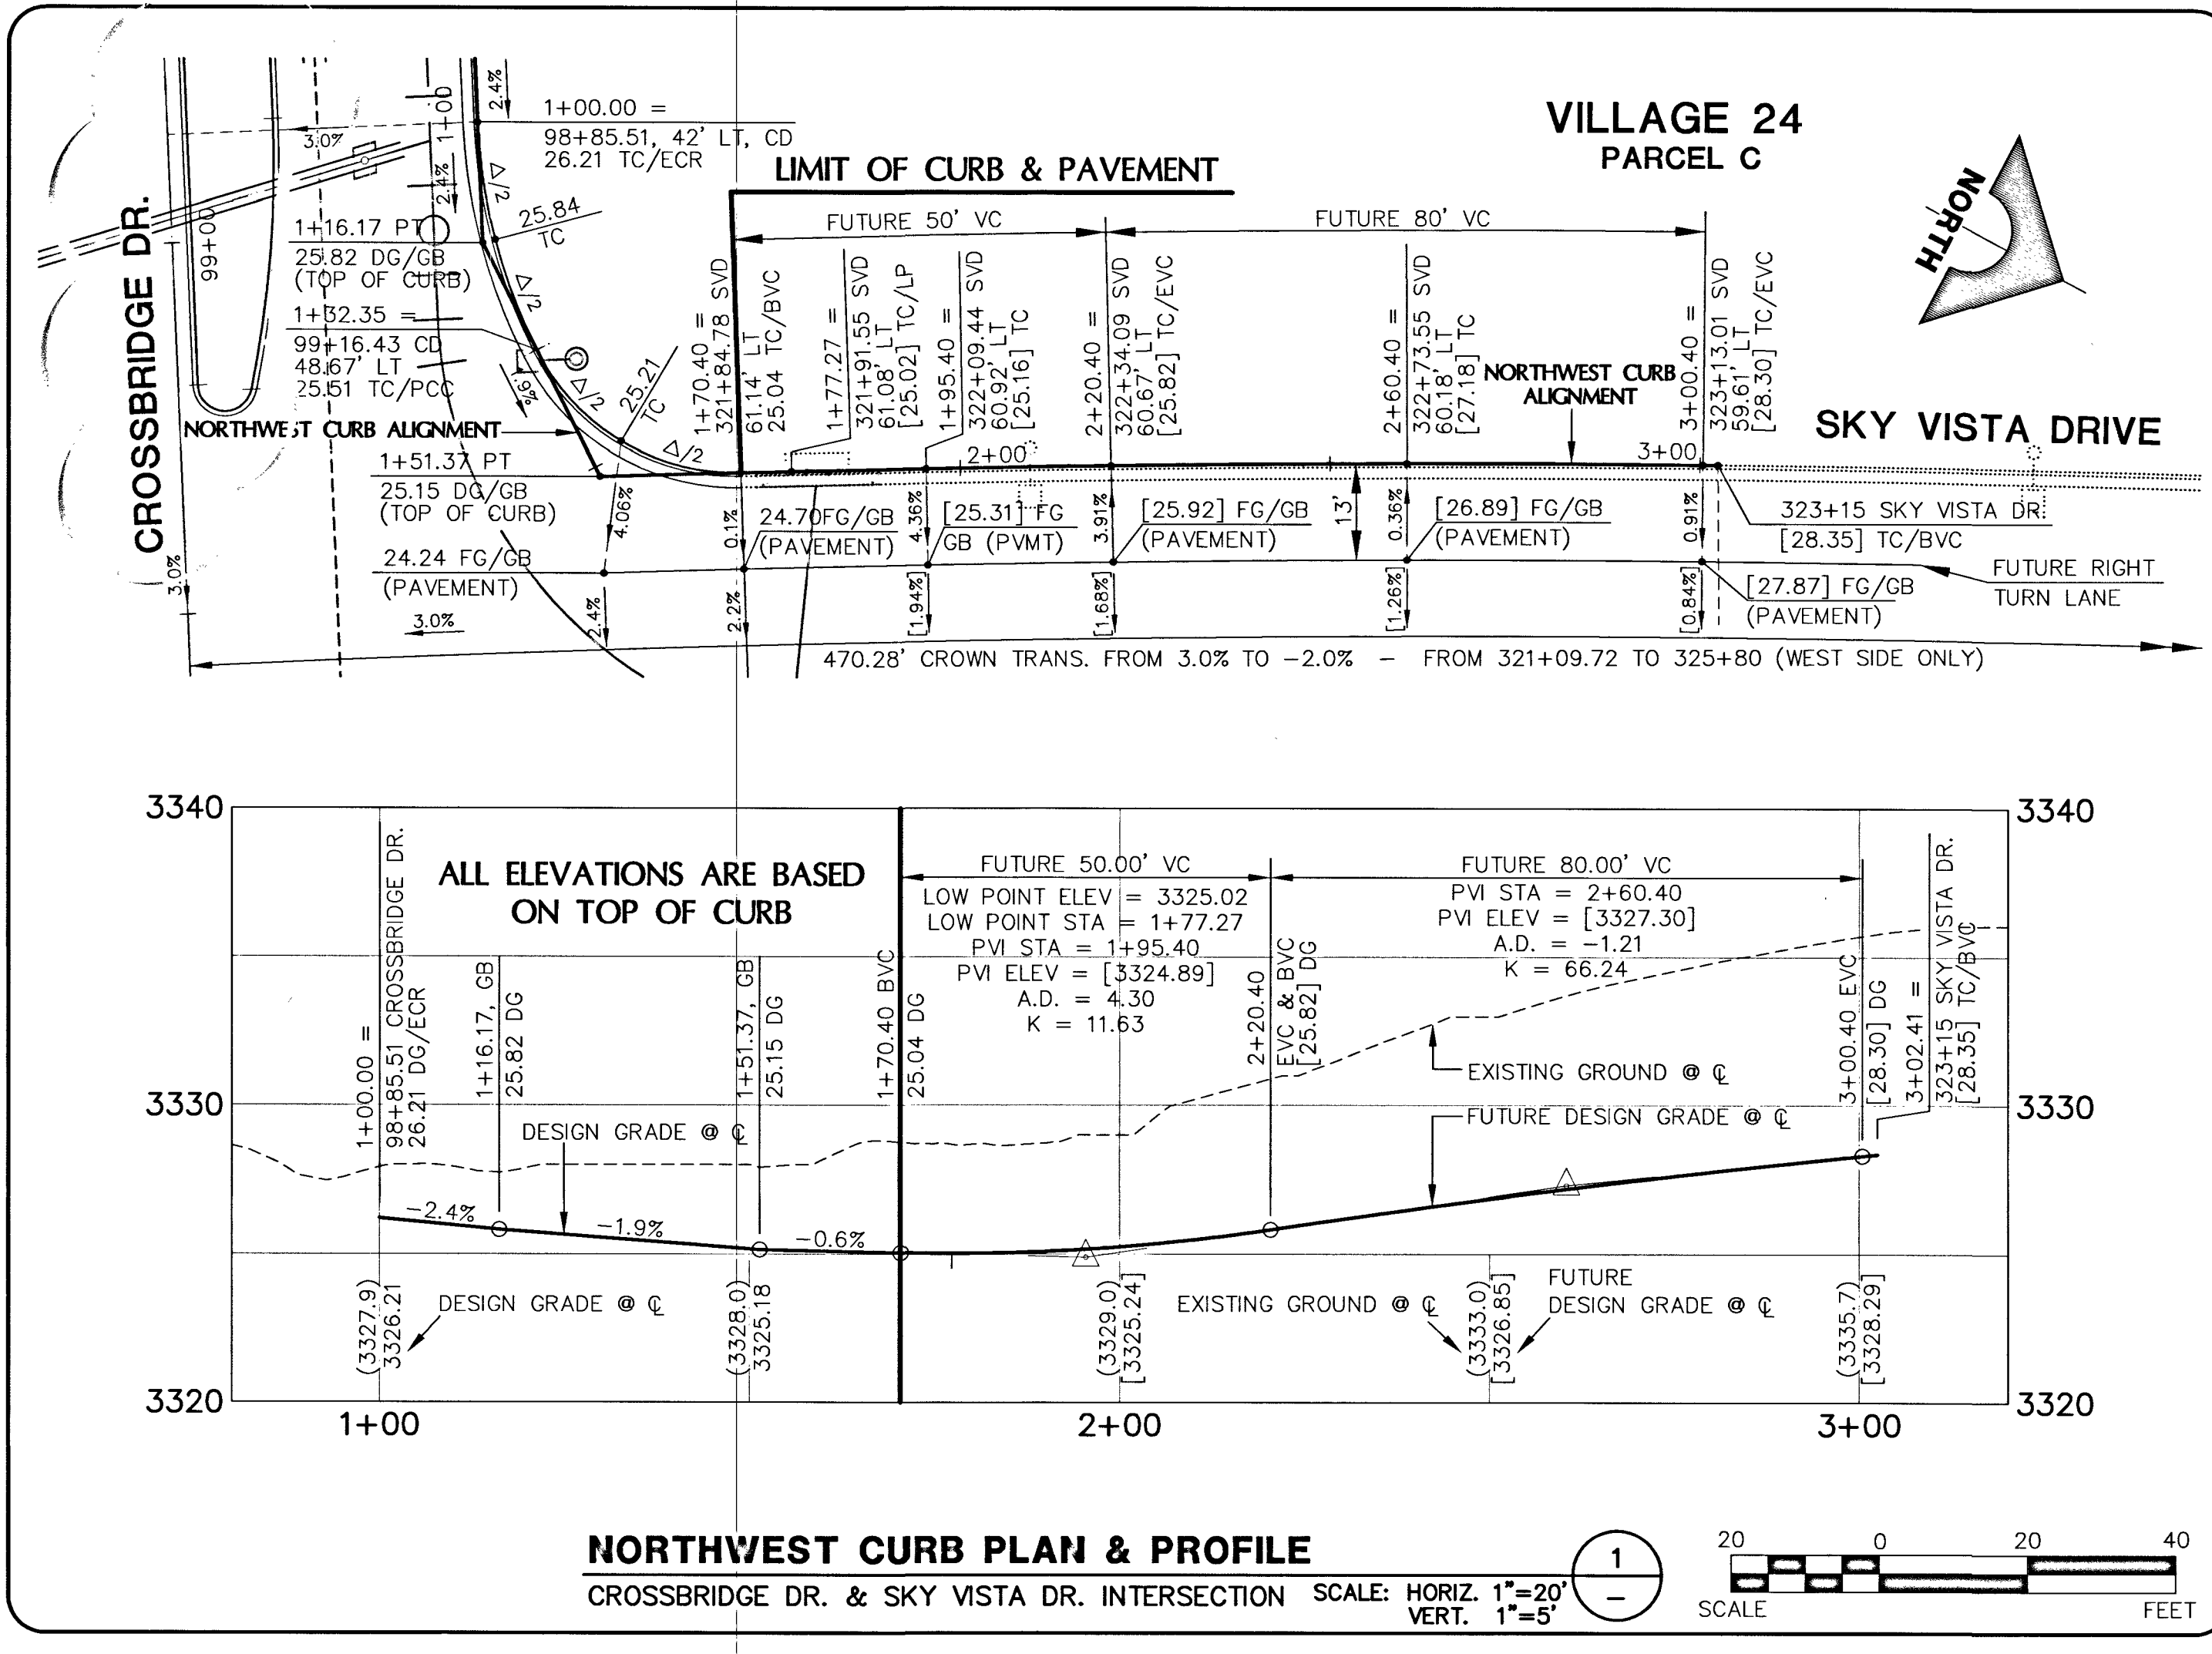


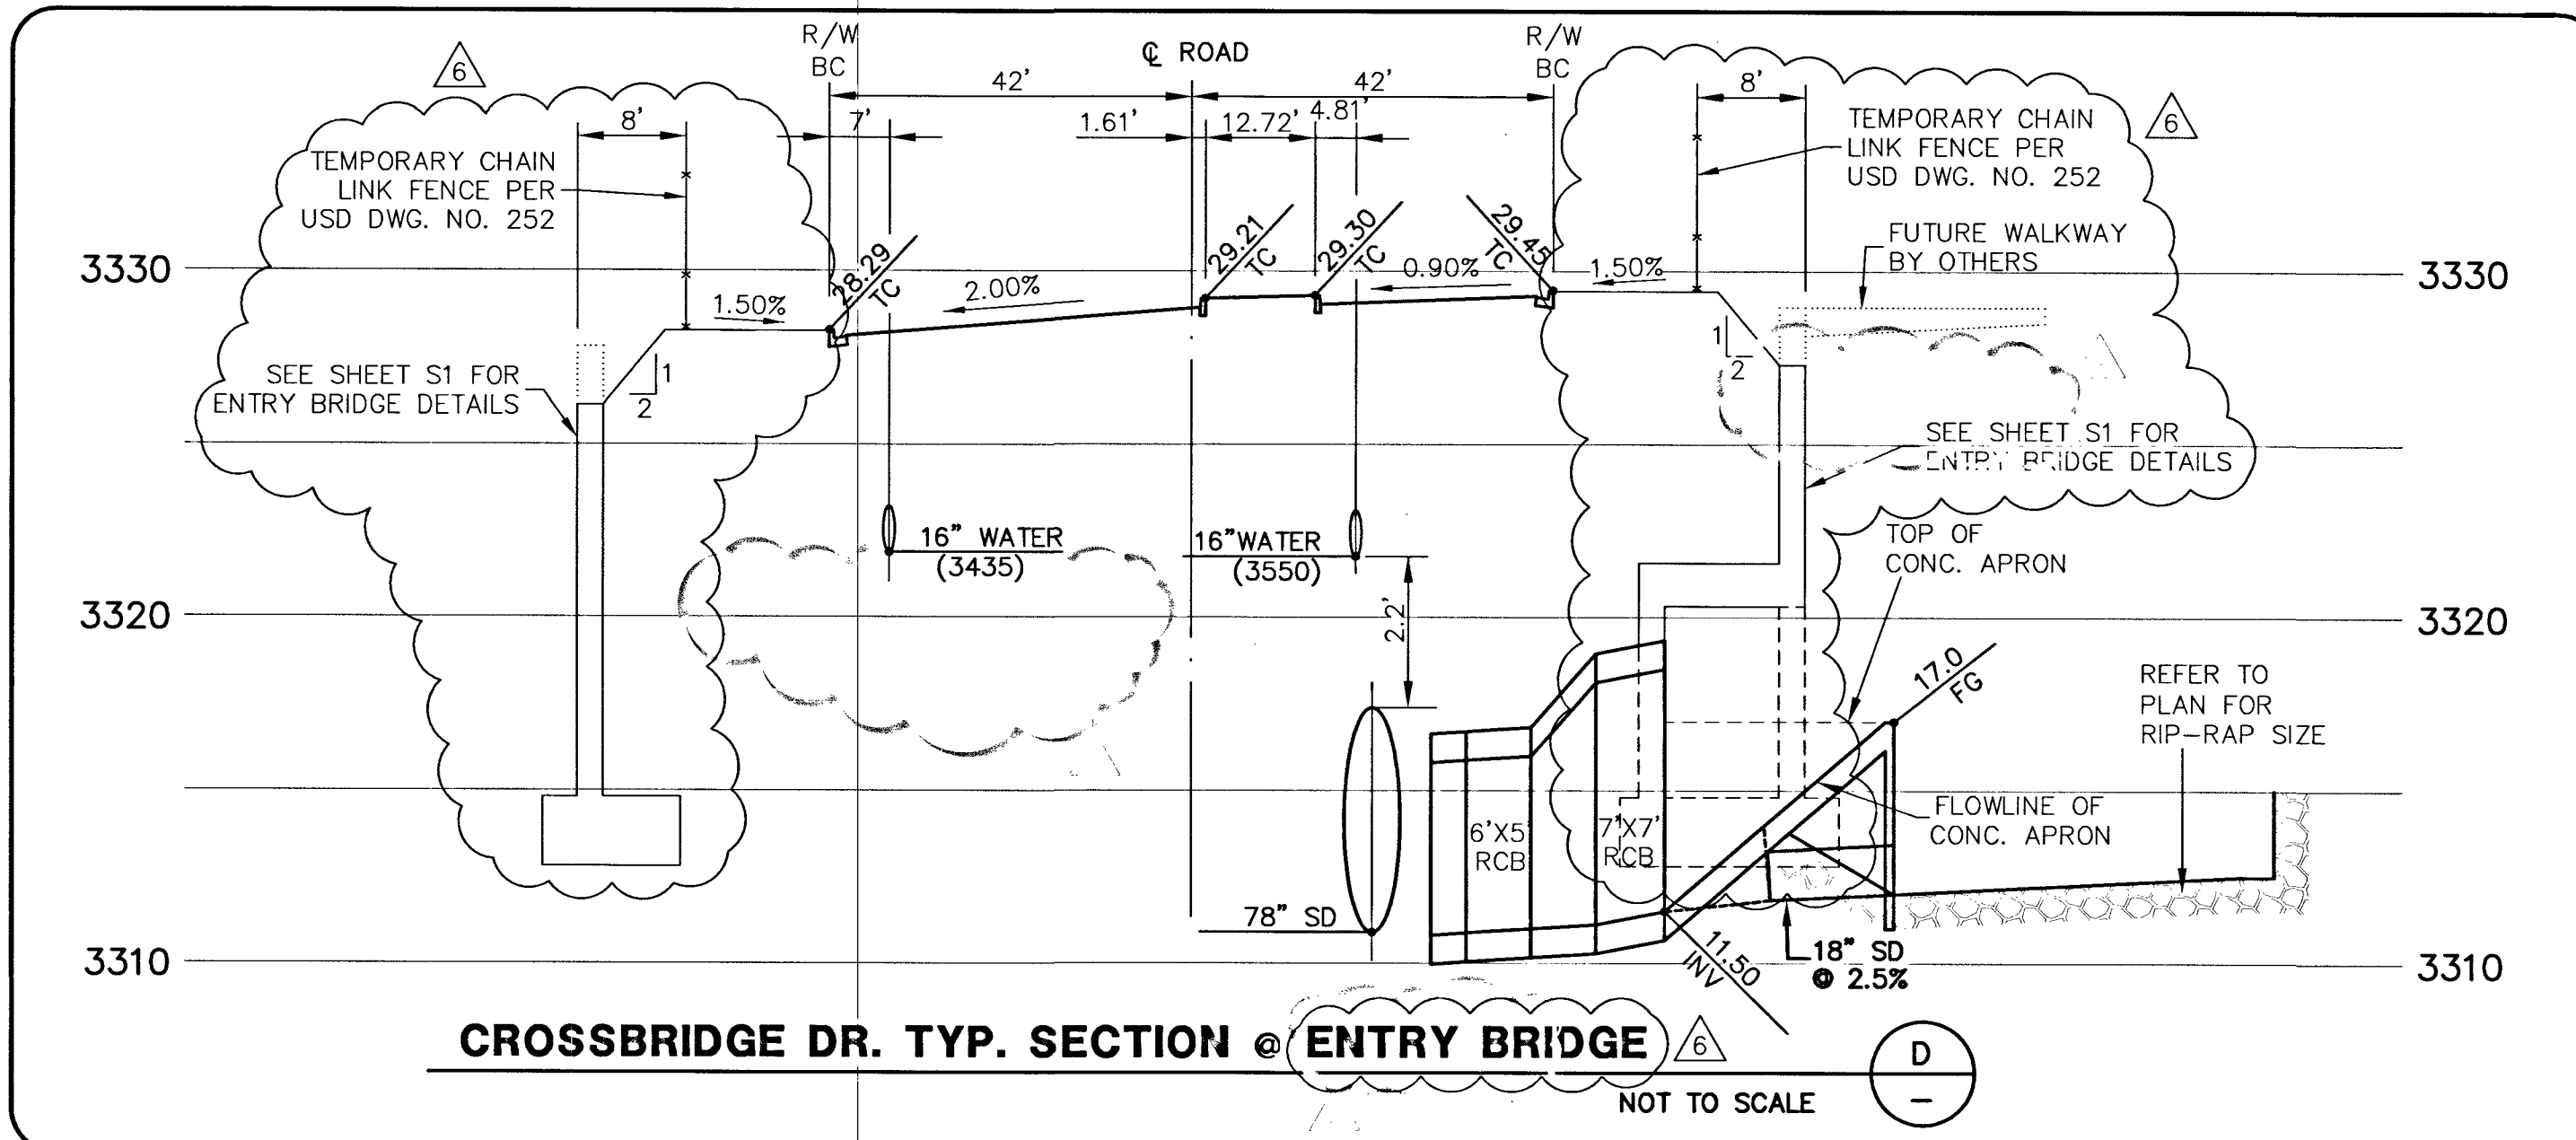

DESIGN: 06/20/16, REVISED MEDIAN, STRIPING, & STREETLIGHTS
 CHECK: 07/17/16, ADDED WATER METER & IRRIGATION SLEEVES
 07/17/16, ADDED SHT 258, BEAVED FUTURE SEWER TO PROPOSED, REMOVED OPEN GRADE

DATE: 06/08/2016

PROJECT: 62A.24.21
 PROJECT NO. 62A.24.21
 PROJECT NO. 62A.24.21

G.C. WALLACE, INC.
 Engineers/Planners/Surveyors
 1555 SOUTH RAINBOW BLVD., LAS VEGAS, NEVADA 89146
 TELEPHONE: (702) 804-2000 • FAX: (702) 804-2299
 E-MAIL: GOWALL@GOWALL.COM

SUMMERLIN
 VILLAGE 24 UNIT 1 IMPROVEMENTS
 TYPICAL SECTIONS AND MISCELLANEOUS DETAILS

APPROVED FOR CONSTRUCTION 1ST APP'D 8-16-06
 DATE: 6/14/16
 (PROJECT #106984)

CLV DRAWING NO. 107Y4932

SHEET 20
 20 OF 47 SHTS