


DATE: 01/13/2015

REV.	DATE	DESCRIPTION
1	07/20/15	REVISED PLAN, RE-GRADED CROSSBRIDGE DRIVE SW/14 TO 97.25
2	07/20/15	REVISED PLAN, RE-GRADED CROSSBRIDGE DRIVE SW/14 TO 97.25
DESIGN: BE
 DRAWN: BB
 CHECK: STS/BAH
 ISSUE DATE:
 ISSUE EDITOR:
 PLOT DATE: 07-17-15
 PLOT TIME: 08:26:47

G. C. WALLACE, INC.
 Engineers/Planners/Surveyors
 1000 S. RAYMOND BLVD. SUITE 100
 LAS VEGAS, NV 89105
 TELEPHONE: (702) 804-2000 • FAX: (702) 804-2299
 F:\Projects\6000\2202\DWG\Production\DWPL_140331\DWPL6037.dwg

SUMMERLIN
 VILLAGE 24 UNIT 1 IMPROVEMENTS
 BORROW SITE II
 SHEET
37A
 144
 37 OF 47 SHTS
 JOB NO. 62A.24.21

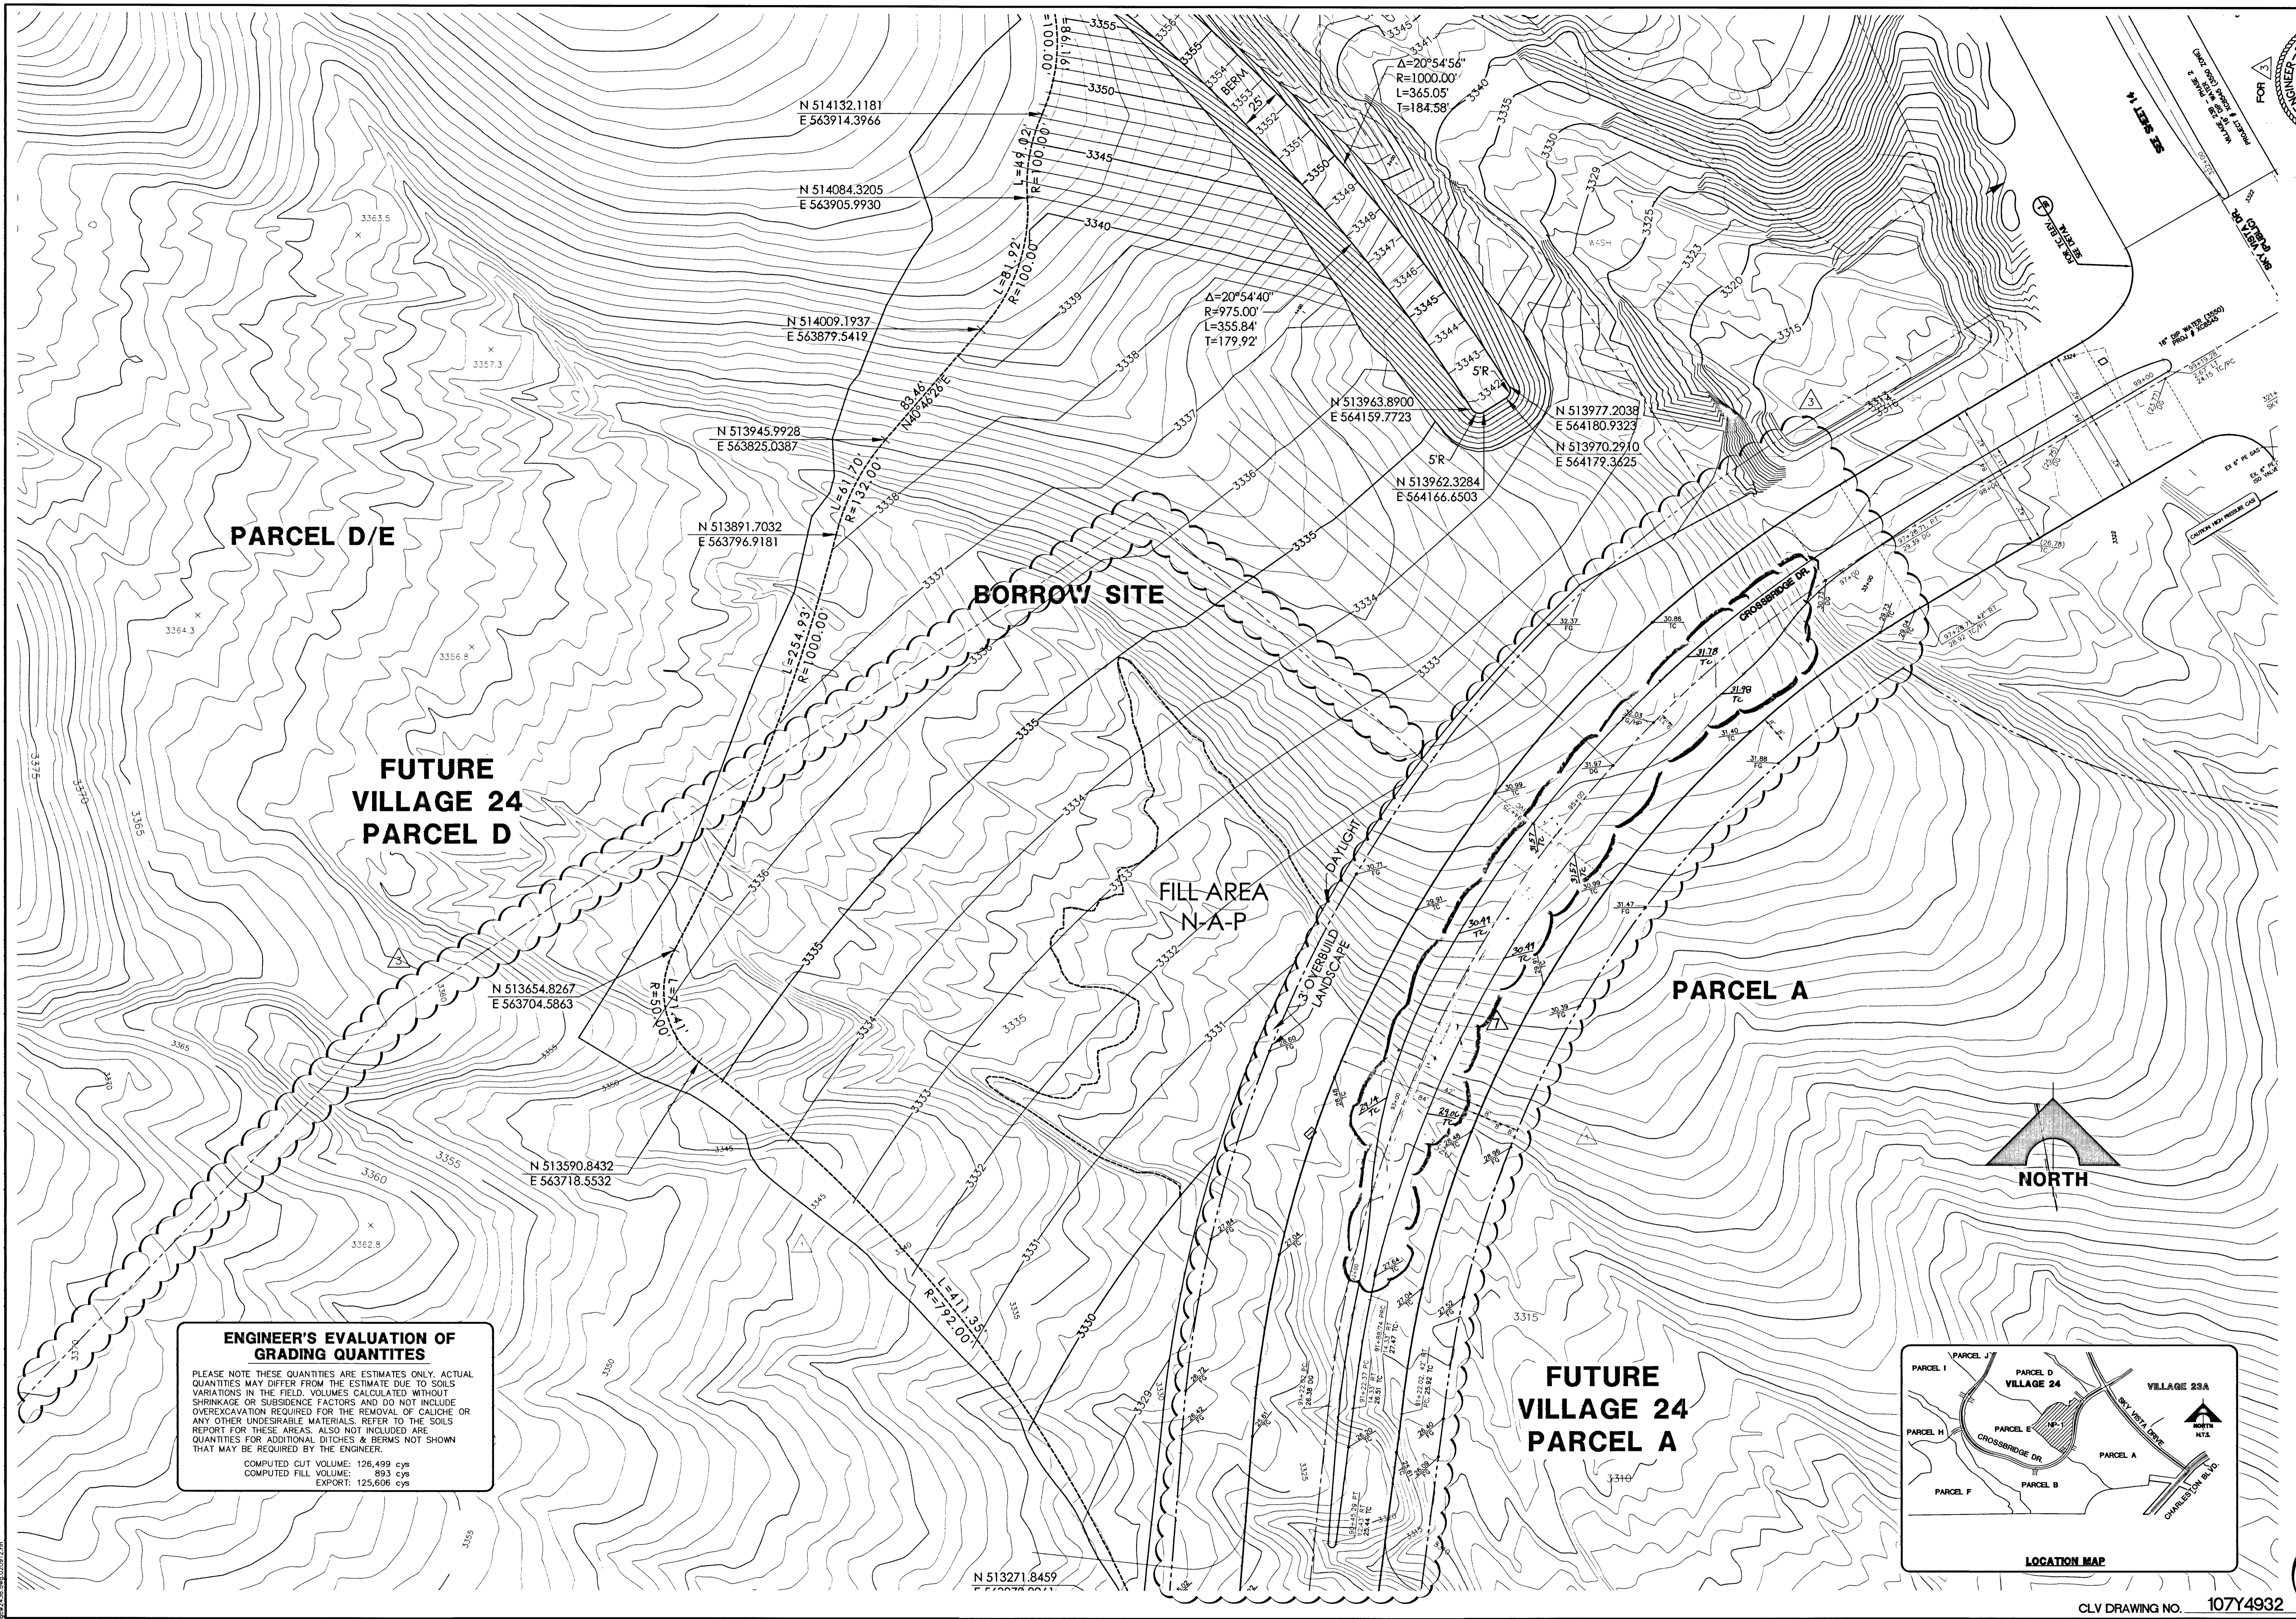

PARCEL D/E


FUTURE VILLAGE 24 PARCEL D

BORROW SITE

FILL AREA N-A-P

PARCEL A

FUTURE VILLAGE 24 PARCEL A

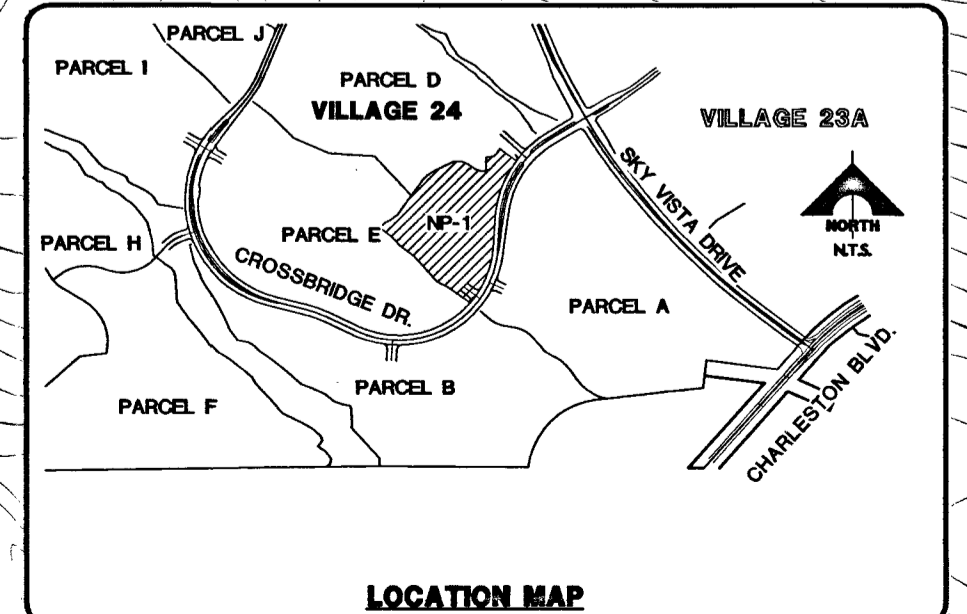

ENGINEER'S EVALUATION OF GRADING QUANTITIES

PLEASE NOTE THESE QUANTITIES ARE ESTIMATES ONLY. ACTUAL QUANTITIES MAY DIFFER FROM THE ESTIMATE DUE TO SOILS VARIATIONS IN THE FIELD. VOLUMES CALCULATED WITHOUT SHRINKAGE OR SUBSIDENCE FACTORS AND DO NOT INCLUDE OVEREXCAVATION REQUIRED FOR THE REMOVAL OF CALICHE OR ANY OTHER UNDESIRABLE MATERIALS. REFER TO THE SOILS REPORT FOR THESE AREAS. ALSO NOT INCLUDED ARE QUANTITIES FOR ADDITIONAL DITCHES & BERMS NOT SHOWN THAT MAY BE REQUIRED BY THE ENGINEER.

COMPUTED CUT VOLUME: 126,499 cys
 COMPUTED FILL VOLUME: 893 cys
 COMPUTED EXPORT: 125,606 cys

CLV DRAWING NO. 107Y4932