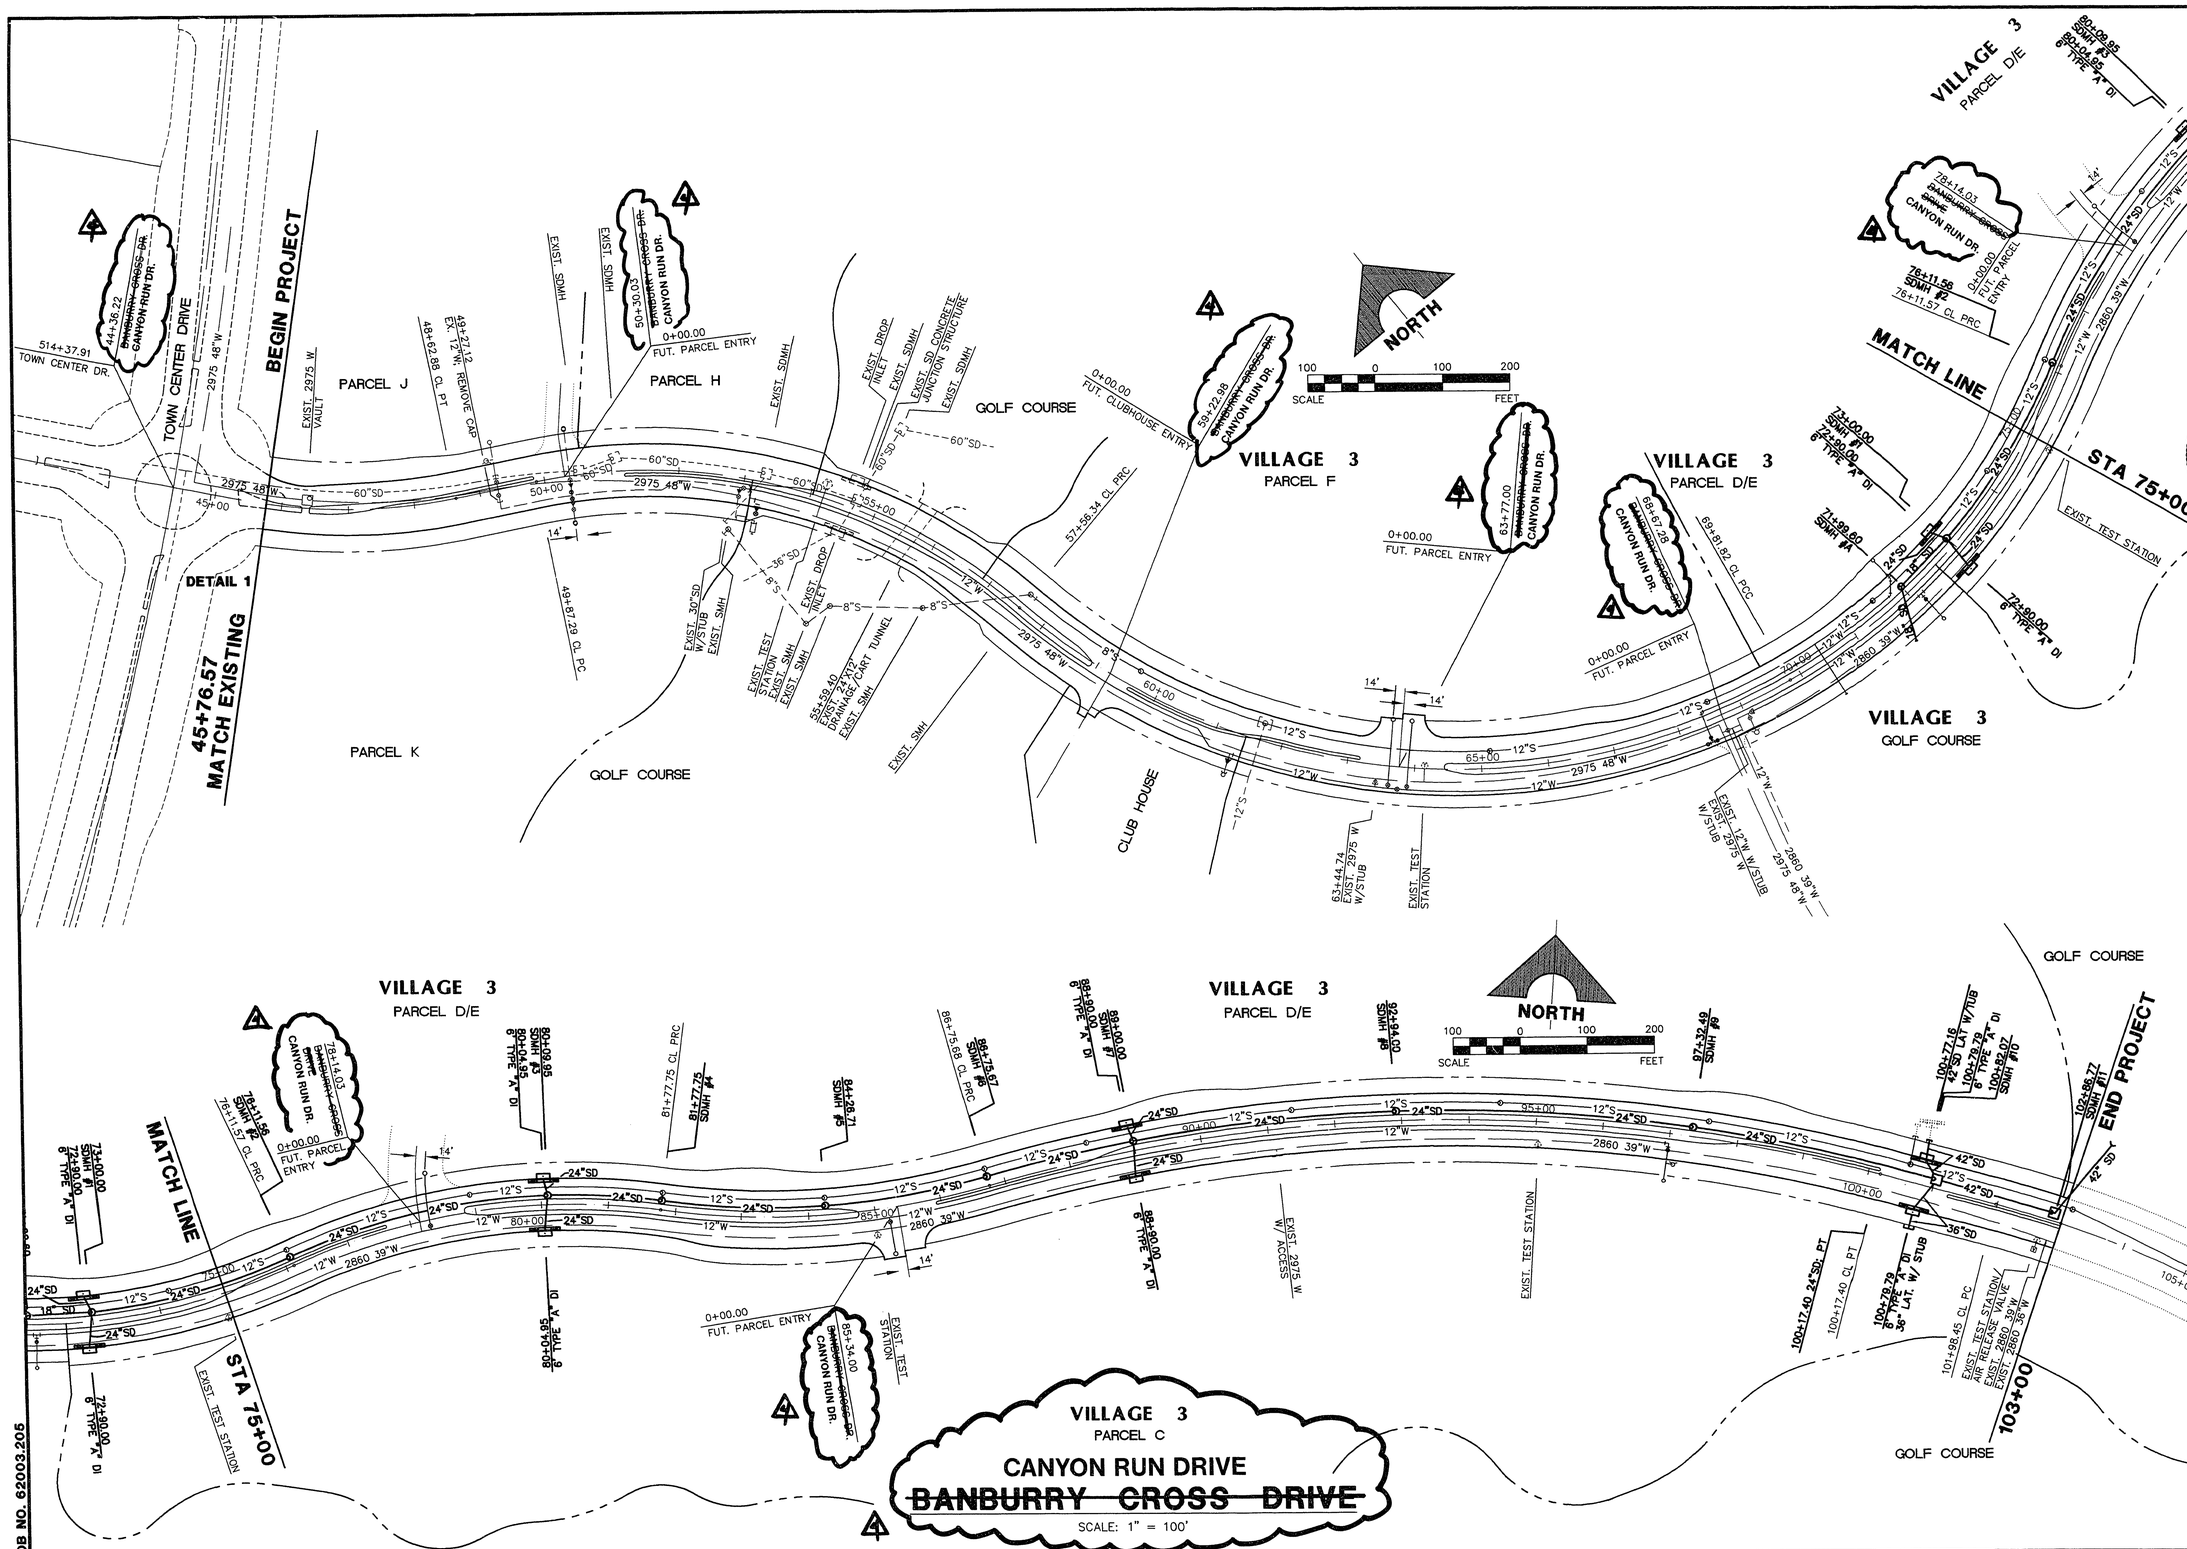

JOB NO. 62003.205

S.T.S., BCD-SD.DWG, 10/02/95

REV.	DATE	DESCRIPTION	DATE	APPROVAL
1	9/19/95	STREET NAME CHANGE	8/22/96	KB

RECOMMENDED: BERT A. HUGHES, P.E. — DATE

ENGINEER-STATE OF NEVADA — BERT A. HUGHES, P.E. — DATE

G.C. WALLACE, INC.
Engineering/Architecture 1555 SOUTH RAINBOW BLVD./LAS VEGAS, NEVADA 89102

SUMMERLIN
VILLAGE 3
~~BANBURRY CROSS DRIVE~~ — WEST
CANYON RUN DRIVE - WEST
STORM DRAIN MASTER PLAN

SHEET 6
SHT 6 OF 26

96-2-47 107-V2426