

CURVE DATA (1 INDICATES CURVE NUMBER)

CURVE	DELTA	RADIUS	LENGTH	TANGENT
1	141.06°	958.33'	237.28'	119.24'
2	24.07°	911.00'	383.55'	194.66'
3	24.07°	941.67'	398.45'	201.21'
4	24.07°	989.00'	416.39'	211.33'
5	24.07°	950.00'	399.97'	202.99'
6	18.74°	300.00'	84.15'	42.36'
7	08.24°	300.00'	44.04'	22.06'
8	02.16°	946.00'	37.59'	18.80'

NOTE: CURVE DATA REPRESENTS PARTIAL CURVE, THIS SHEET ONLY.

- CONSTRUCTION NOTES**
- IMPROVEMENTS**
- INSTALL A.C. PAVEMENT PER STREET SECTIONS, SHEET NO. 25
 - INSTALL "L" TYPE CURB AND GUTTER (S-47)
 - INSTALL "A" TYPE ISLAND CURB (S-50)
 - INSTALL CONCRETE ENCASUREMENT (C-24)

- SEWER**
- INSTALL 12" SEWER PIPE (U-20)
 - INSTALL SEWER MANHOLE (S-01)
 - INSTALL 8" SEWER PIPE (U-20)



- WATER**
- INSTALL 12" WATER PIPE (U-20)
 - INSTALL 6" WATER PIPE (U-20)
 - INSTALL 6" GATE VALVE (U-34)
 - INSTALL 12" X 12" X 6" TEE (U-32)
 - INSTALL TEMPORARY 2" BLOW-OFF VALVE (U-32)
 - INSTALL 8" WATER PIPE (U-20)

- STORM DRAIN**
- INSTALL 24" STORM DRAIN PIPE (1350-D) (U-20)
 - INSTALL TYPE II STORM DRAIN MANHOLE (D1-2)
 - INSTALL TYPE "A" DROP INLET (U-12)
 - INSTALL 18" STORM DRAIN PIPE (1350-D) (U-20)

- STREET LIGHTING**
- STREET LIGHT OR COMMON TRENCH, SEE ELECTRICAL PLANS
 - STREET LIGHT, SEE ELECTRICAL PLANS (E-2)

- IRRIGATION**
- BANK "A", 1-6" & 2-4" SDR35 PVC
 - BANK "B", 2-4" SDR35 PVC

RANBURRY CROSS DRIVE
CANYON RUN DRIVE
 SCALE: HORIZ. 1" = 20'
 VERT. 1" = 5'

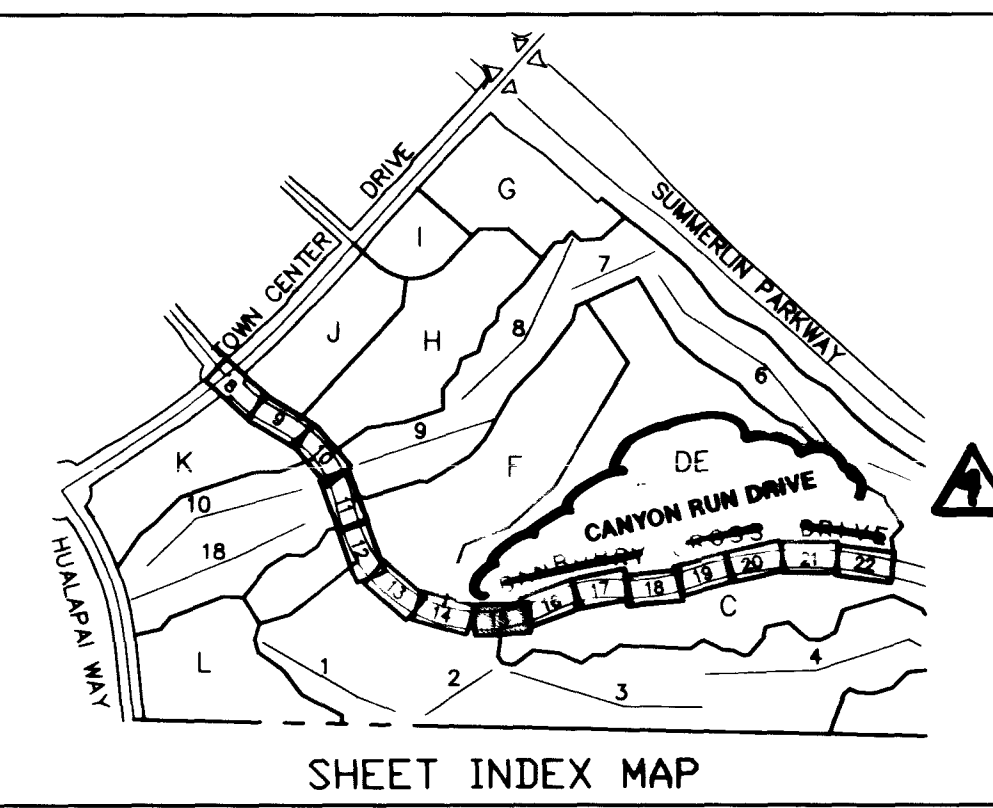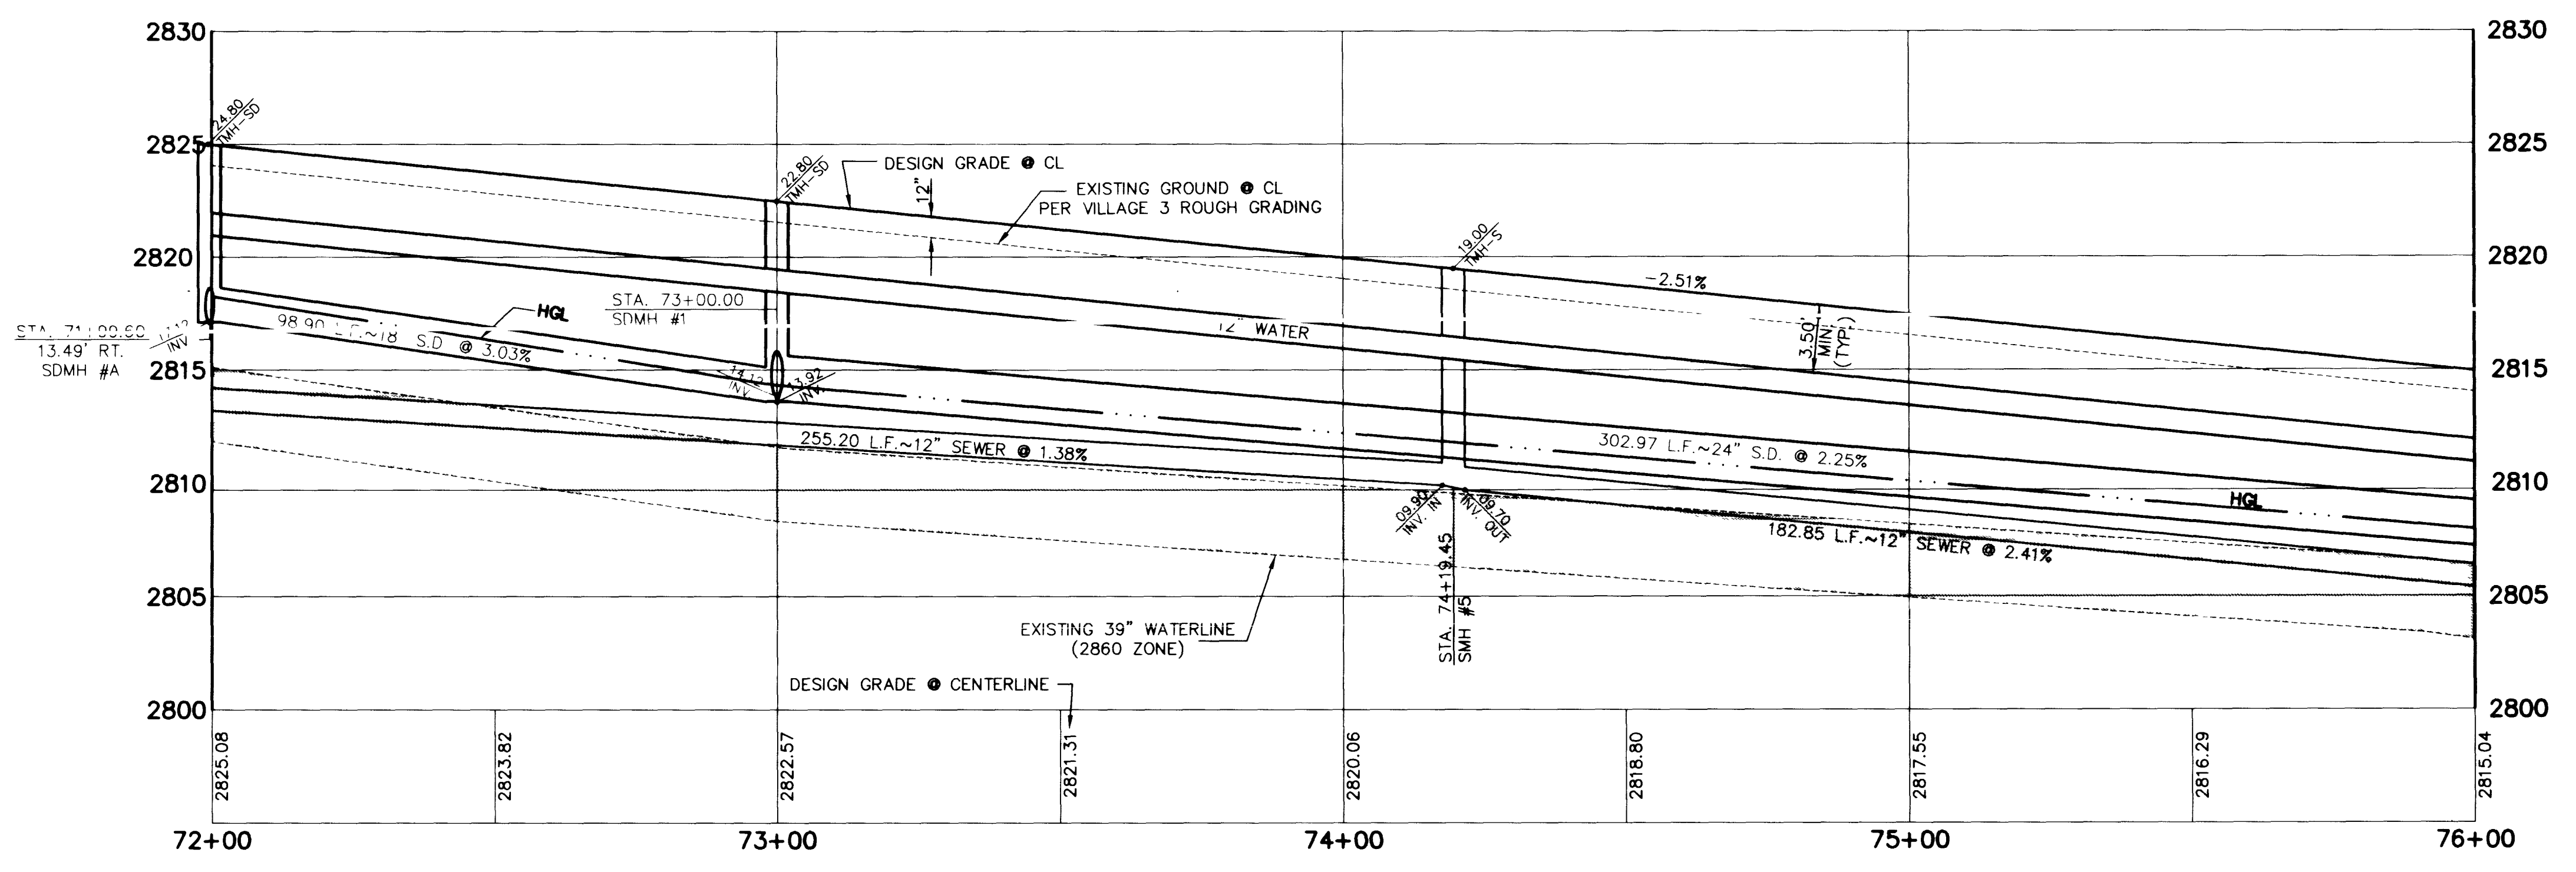

APPROVAL:
 15T M 10-30-95
 LAS VEGAS VALLEY WATER DISTRICT

REVISIONS

NO.	DATE	DESCRIPTION
1	12/21/95	REVISED WATER STUB LOCATION
2	12/21/95	REVISED WATER STUB LOCATION

RECEIVED: 12/21/95

DESIGNED BY: [Signature]

CHECKED BY: [Signature]

DATE: 12/21/95

PROJECT: 107-V2426

SHEET 15 OF 26

JOB NO. 62003.205

12/21/95

107-V2426

