NORTH

1" = 20'

SCALE: 20 0 20 40 FEET

RAMPART BLVD.

ANGEL PARK

EXISTING RAMPART BLVD. ISLANDS PER CLV DWG. NO. 107-V2088A

EXISTING RAMPART BLVD. PER CLV DWG. NO. 107-V2088

EXISTING RAMPART BLVD. ISLANDS PER CLV DWG. NO. 107-V2088A

24"SD

18"SD

EXIST. STREET LIGHT CONDUIT

EXIST. TRAFFIC INTERCONNECT CONDUIT

90+00

89+00

88+00

87+00

86+00

85+00

36"W (2860 ZONE)

STA. 89+00.00 BCR REMOVE CURB AND GUTTER REMOVAL BEGIN SAWCUT

STA. 88+59.76 53.00' LT., PRC

STA. 88+19.52 38.50' LT., PT

STA. 89+08.02 42.81' LT. REPLACE EXIST. STORM DRAIN

REMOVE AND REPLACE EXISTING DROP INLET IN KIND

SAWCUT EXIST. PAVEMENT

2.00%

47.51'

STA. 86+72.43 38.50' LT., BCR

STA. 135+51.39 & 4.33' LT. PCC

STA. 85+35.55 BCR END CURB AND GUTTER REMOVAL END SAWCUT

4" GAS

EXIST. TELEPHONE CONDUIT

RELOCATE EXIST. BOXES TO BC

1.04%

EXIST. POWER CONDUIT

COMMON LOT

STA. 86+68.43 62.81' LT.

STA. 135+44.76 BCR

STA. 135+48.99 BCR

268'D

EXIST. CENTEL MANHOLE TO BE RELOCATED TO STA 85+10.00

COMMON LOT

STA. 135+48.76 43.31' RT.

SEE SHEET 11

MATCH LINE

RELOCATE TEST STA. STA. 135+39 @ BACK-OF-CURB

STA. 135+30.0 IRRIGATION SLEEVE

BANDURRY GROSS DRIVE

CANYON RUN DRIVE

EXISTING 8"XS' RCP

EXIST. 66" SD PER CLV DWG. NO. 107-V2464

EXIST. 8"S PER CLV DWG. NO. 107-V2464

PARCEL A

RAMPART BLVD.

SCALE: HORIZ. 1" = 20'
VERT. 1" = 5'

CURVE DATA

(1) INDICATES CURVE NUMBER

CURVE	DELTA	RADIUS	LENGTH	TANGENT
1	15°33'49"	150.00'	40.75'	20.50'
2	83°00'00"	30.00'	43.46'	26.54'
3	95°50'31"	30.00'	50.18'	33.23'
4	180°00'00"	2.00'	6.28'	------

NOTE: CURVE DATA REPRESENTS PARTIAL CURVE, THIS SHEET ONLY.

CONSTRUCTION NOTES

IMPROVEMENTS

1. INSTALL A.C. PAVEMENT PER STREET SECTIONS, SHEET NO. 14
2. INSTALL "L" TYPE CURB AND GUTTER (S-47/S)
3. INSTALL "A" TYPE ISLAND CURB (S-50/S)
4. INSTALL HANDICAP RAMP CURB DEPRESSION (S-77/S)
5. INSTALL A.C. PAVEMENT PER (B/14) (RAMPART BLVD.)

STORM DRAIN

1 SD. INSTALL 18" RCP STORM DRAIN (U-20/S)
2 SD. INSTALL TYPE "A" DROP INLET (D-12/S)

LEGEND

RAMPART BLVD. PAVEMENT SECTION

~~BANDURRY GROSS DR.~~ PAVEMENT SECTION
CANYON RUN DRIVE

NOTE: ALL COMMON LOTS AS SHOWN HEREIN TO BE PRIVATELY MAINTAINED BY THE H.O.A.

NOTE TO CONTRACTOR

TOPOGRAPHY SHOWN HEREIN REFLECTS ORIGINAL EXISTING TOPOGRAPHY. ACTUAL FIELD CONDITIONS INCLUDE SITE ROUGH GRADING.

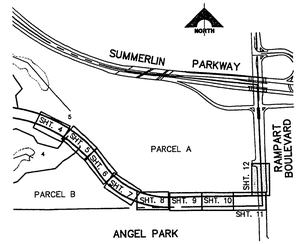

SHEET INDEX MAP

APPROVAL:

LAS VEGAS VALLEY WATER DISTRICT 5/1/96

NO.	DESCRIPTION	DATE
2	~~BANDURRY GROSS DRIVE~~ CANYON RUN DRIVE	8/23/96
1	STREET NAME CHANGE	08/15/96

RECOMMENDED FOR APPROVAL BY CLARK COUNTY PUBLIC WORKS DEPARTMENT

8/23/96 DATE

BERT A. THOMPSON, P.E. NO. 9899 DATE

PROFESSIONAL ENGINEER OF NEVADA

CIVIL

G.C. WALLACE, INC.
Engineering/Architecture
1555 SOUTH RAINBOW BLVD./LAS VEGAS, NEVADA 89102

SUMMERLIN
VILLAGE 3
~~BANDURRY GROSS DRIVE~~ CANYON RUN DRIVE - EAST
RAMPART BLVD. PLAN
STA. 85+35.55 TO 89+00.00

SHEET 12
SHT 12 OF 15

JOB NO. 62003.204

S.T.S. BCDE-12.DWG, 03/29/96

36-2-70

107-V2464-2