


THESE PLANS SHOW RECORD INFORMATION RECEIVED FROM:

DATE: **OCTOBER 15, 1996**


THIS DATA MAY OR MAY NOT REFLECT THE ACTUAL
FIELD LOCATIONS. ALL DATA SHOULD BE CONFIRMED
PRIOR TO USE ON DEVELOPMENT OR ENGINEERING
PLANS.

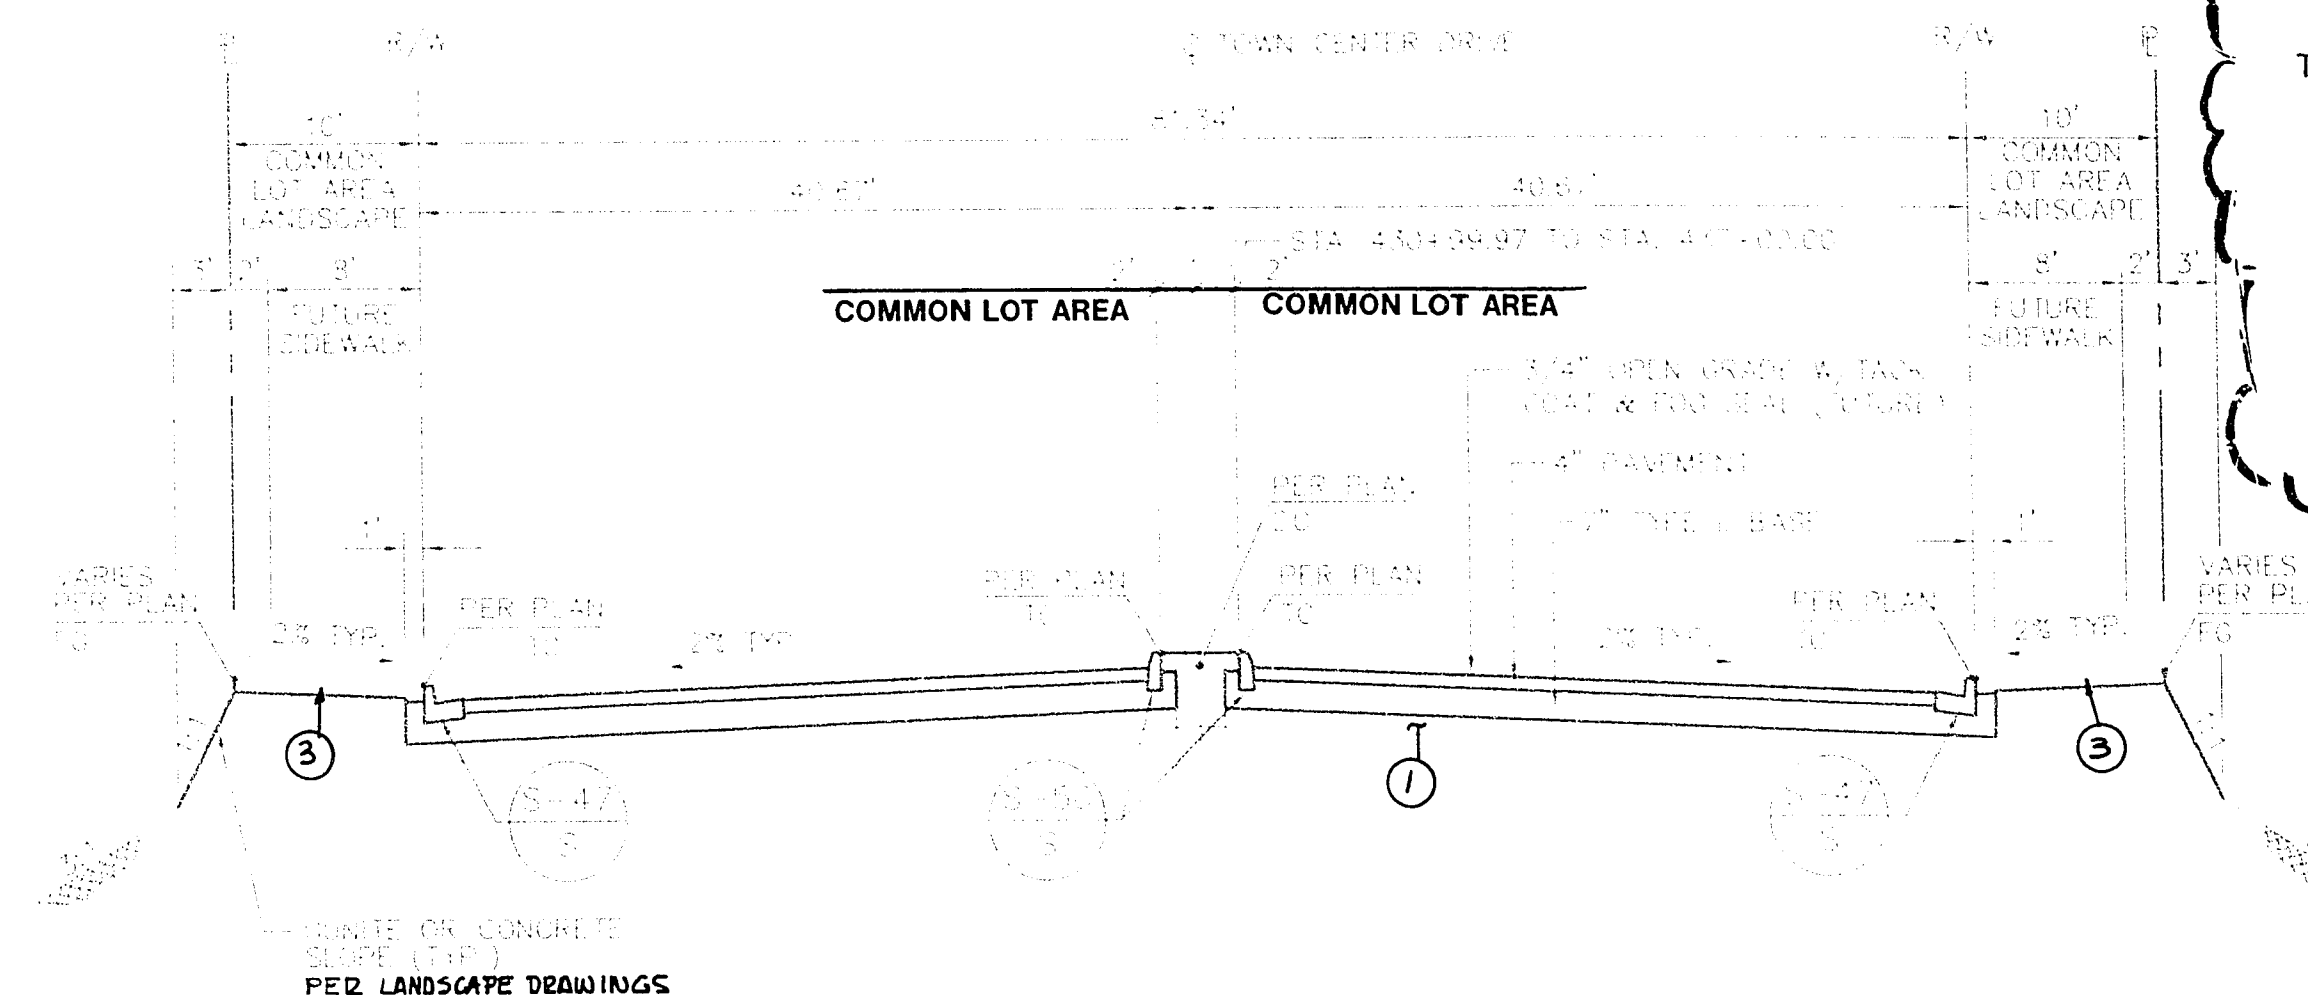

STA. 431+00.29 TO 437+00.00
TOWN CENTER DRIVE - SECTION
SCALE: HORIZ. 1"=10'
VERT. 1"=5'

c
in


- NOTES:
- ① — SCARIFY NATIVE 6" AND RECOMPACT TO 95%.
 - ② — LANDSCAPE AREA: EXCAVATED AND RECOMPACT TO 85% OR RIP ENTIRE AREA TO DEPTH INDICATED.
 - ③ — ROUGH GRADE (R.G.) TO BE 4" BELOW FINISH GRADE (F.G.) FOR FUTURE LANDSCAPE PURPOSES.

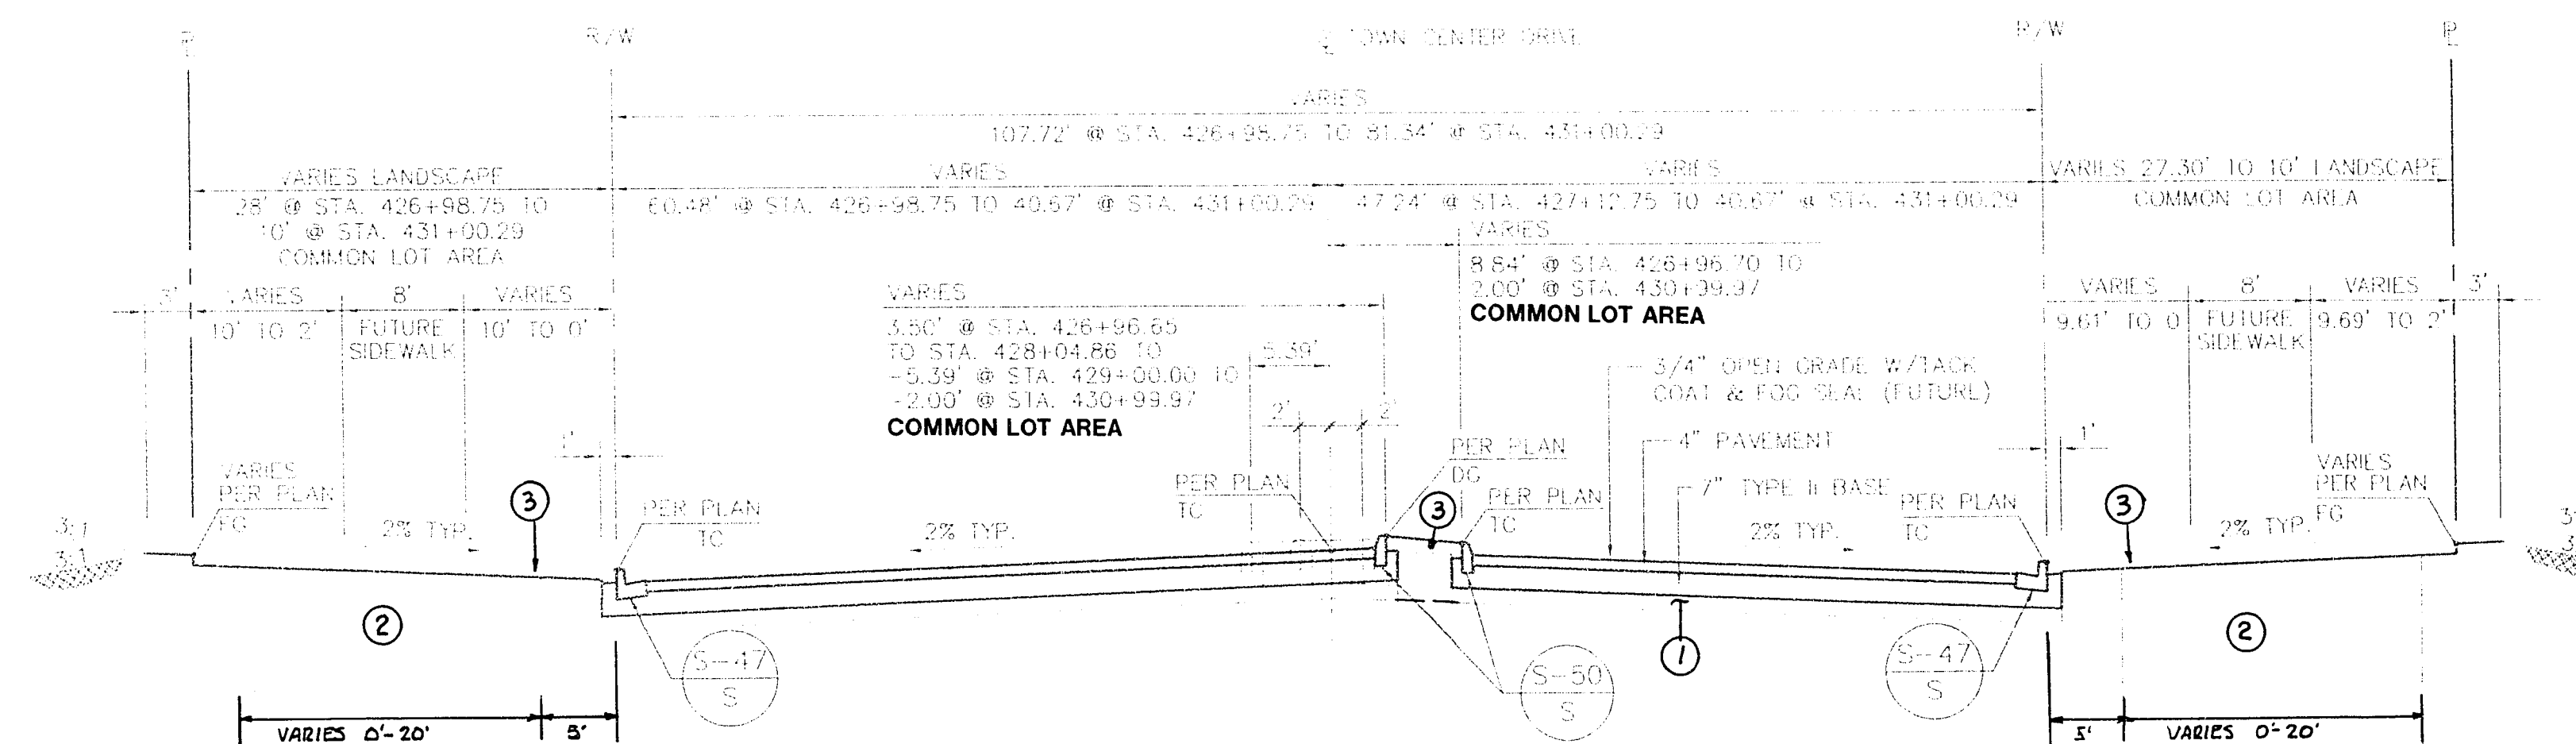

STA. 426+98.75 TO 431+00.29
TOWN CENTER DRIVE - SECTION
SCALE: HORIZ. 1"=10'
VERT. 1"=5'

11

- NOTES:
- ① — SCARIFY NATIVE 6" AND RECOMPACT TO 95%
 - ② — LANDSCAPE AREA: EXCAVATED AND RECOMPACT TO 85%, OR RIP ENTIRE AREA TO DEPTH INDICATED.
 - ③ — ROUGH GRADE (R.G.) TO BE 4" BELOW FINISH GRADE (F.G.) FOR FUTURE LANDSCAPE PURPOSES.

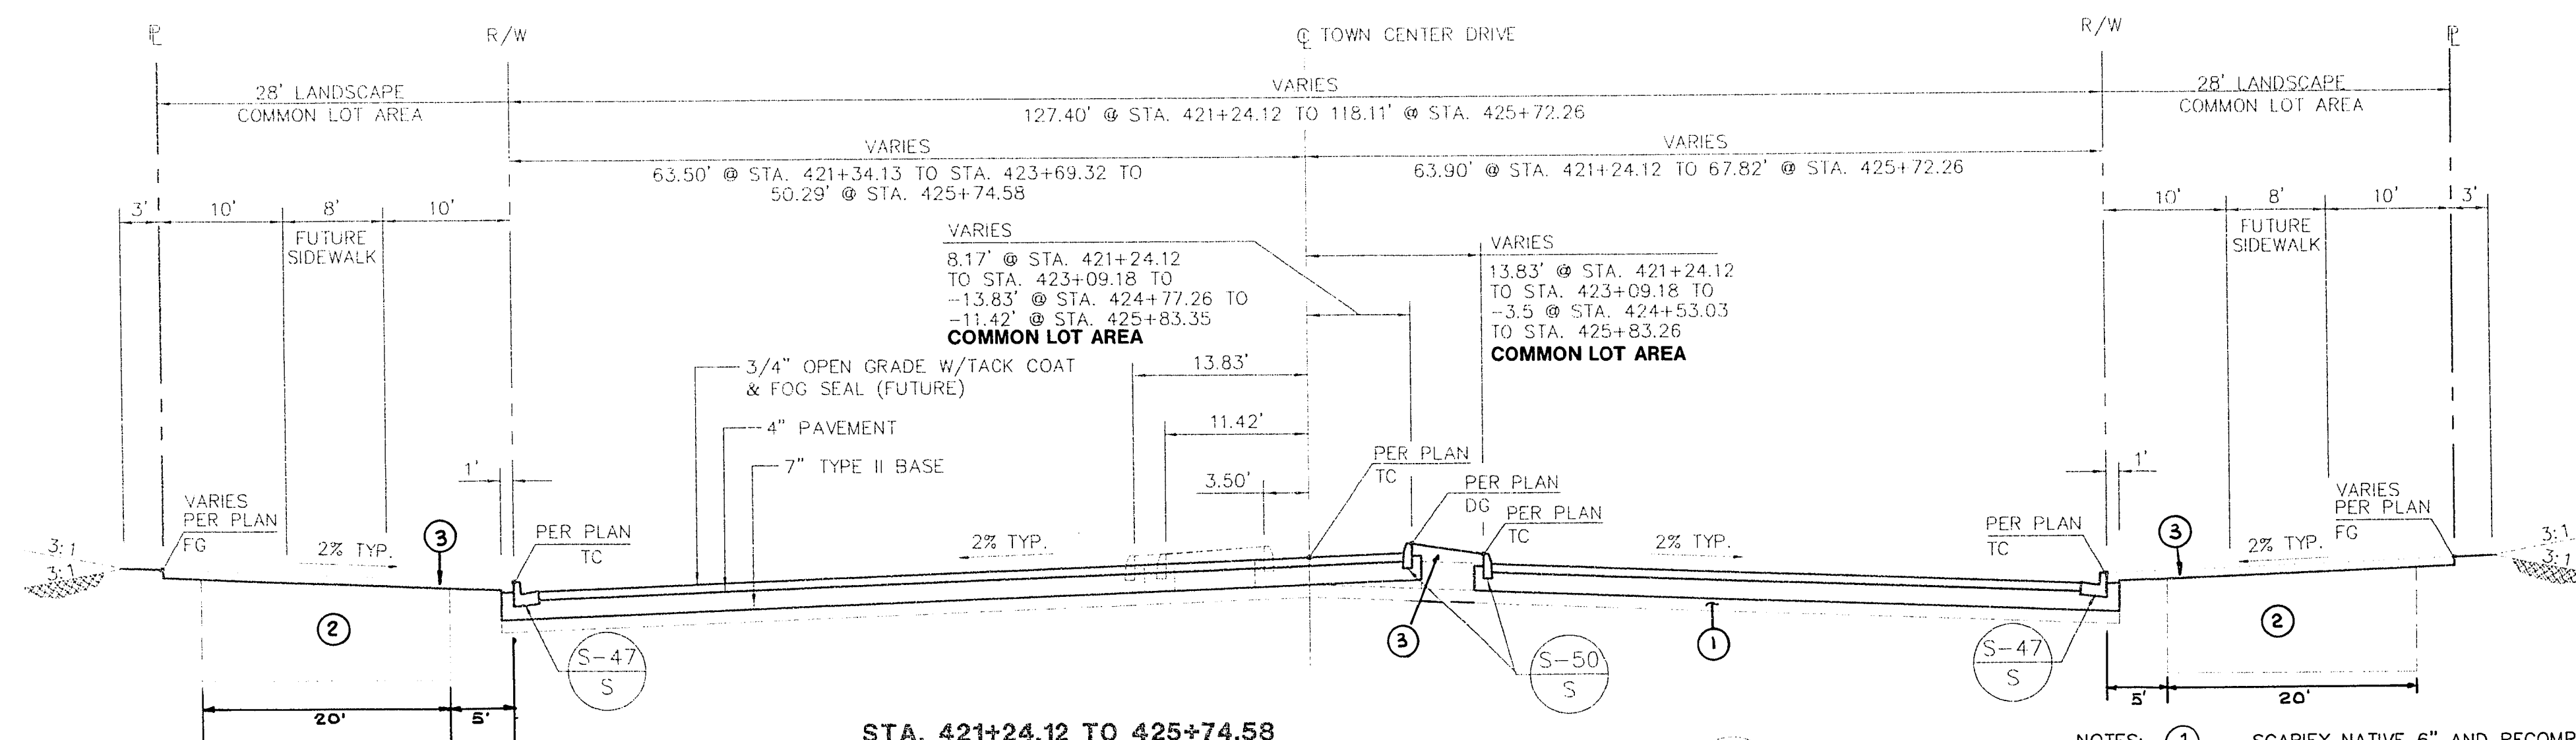

STA. 421+24.12 TO 425+74.58
TOWN CENTER DRIVE - SECTION
SCALE: HORIZ. 1"=10'
VERT. 1"=5'

- NOTES:
- ① — SCARIFY NATIVE 6" AND RECOMPACT TO 95%.
 - ② — LANDSCAPE AREA: EXCAVATED AND RECOMPACT TO 85%, OR RIP ENTIRE AREA TO DEPTH INDICATED.
 - ③ — ROUGH GRADE (R.G.) TO BE 4" BELOW FINISH GRADE (F.G.) FOR FUTURE LANDSCAPE PURPOSES.