


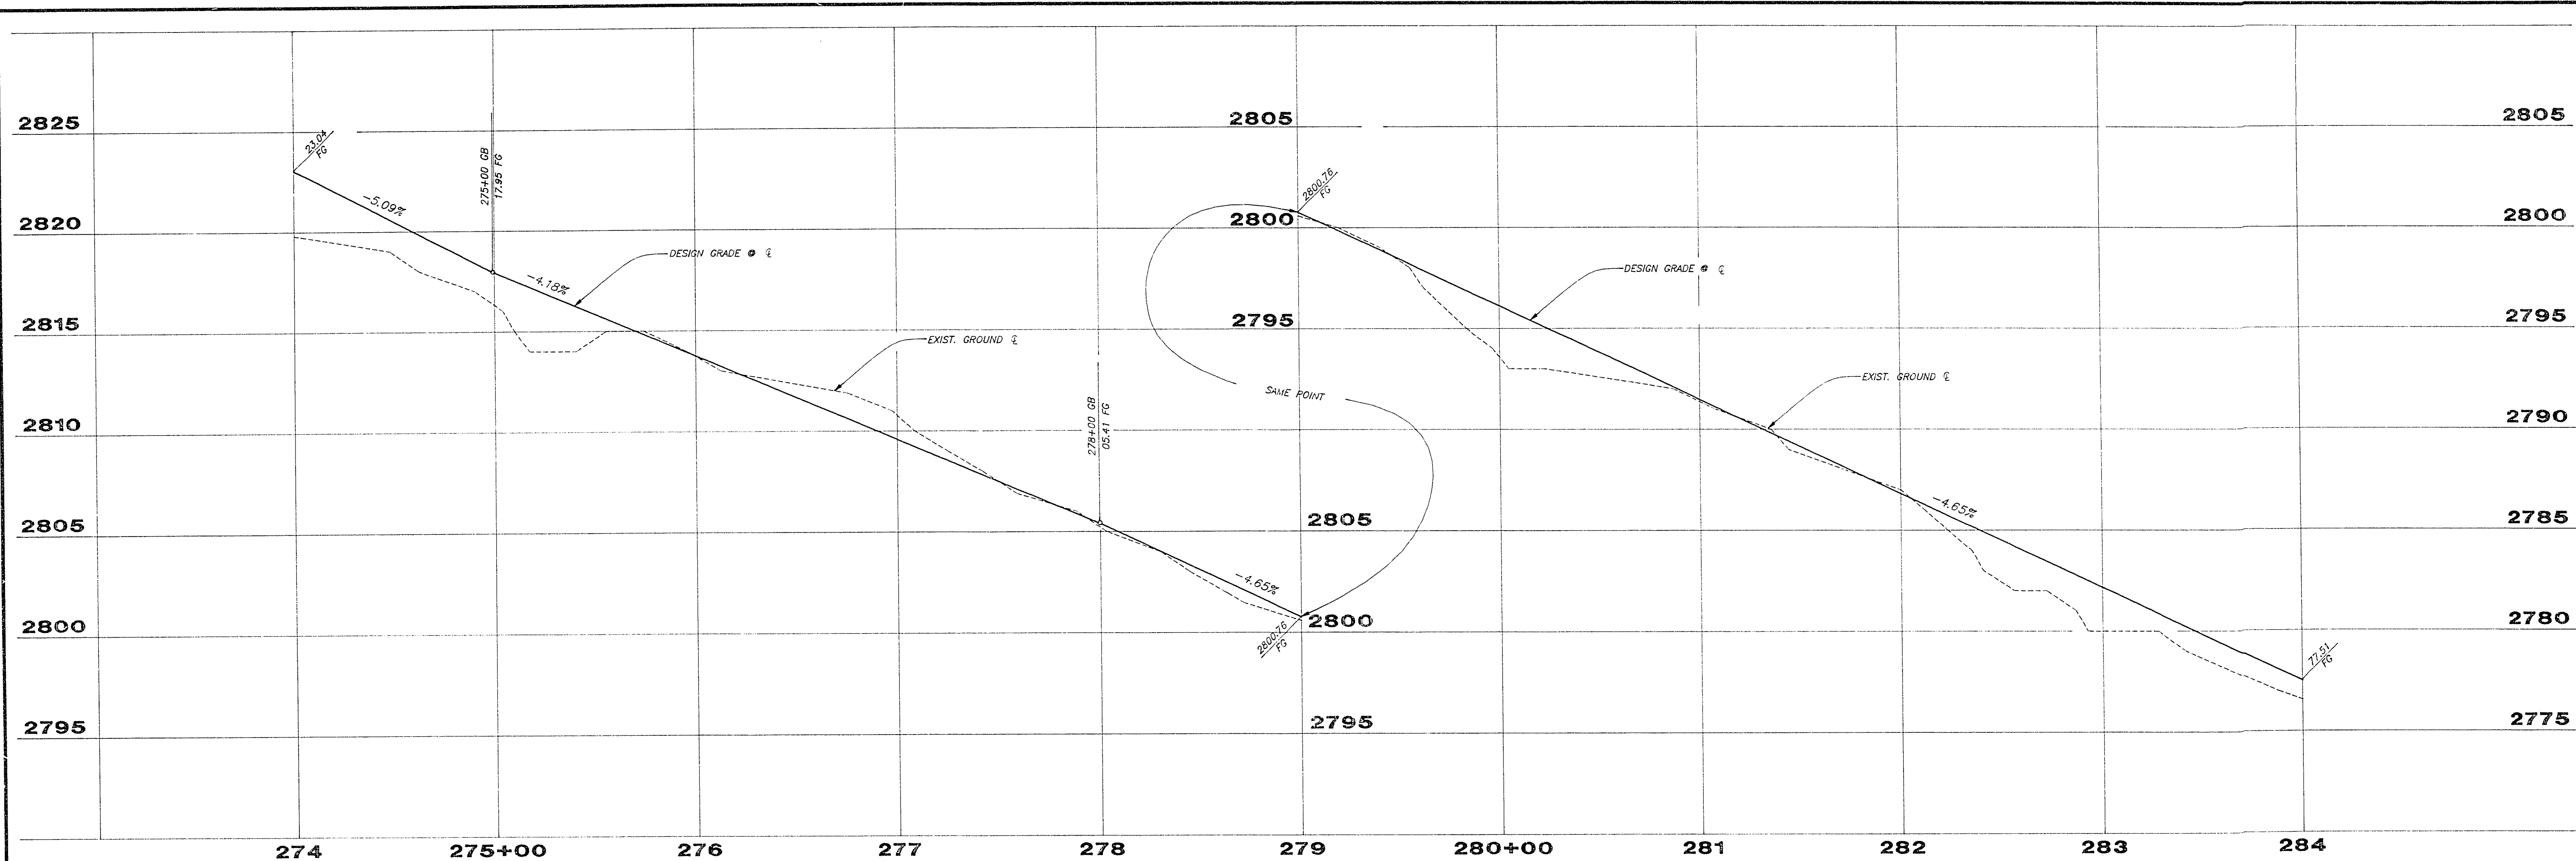


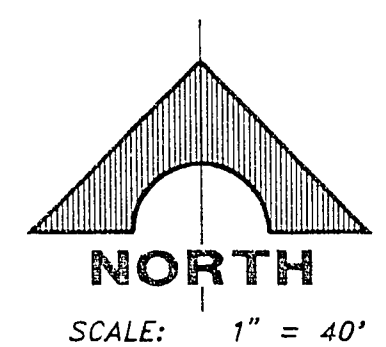

PROFILE
SCALE: HORIZ. 1" = 40'
VERT. 1" = 4'

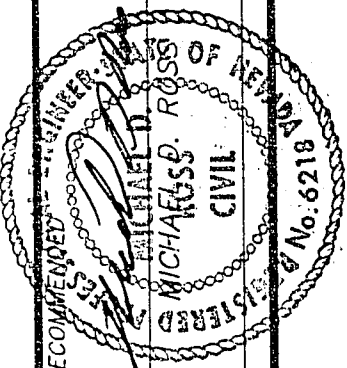

CURVE	DELTA	RADIUS	LENGTH	TANGENT
1	10'59"17"	300.00'	57.53'	28.88'
2	18'00"00"	3.33'	10.48'	---

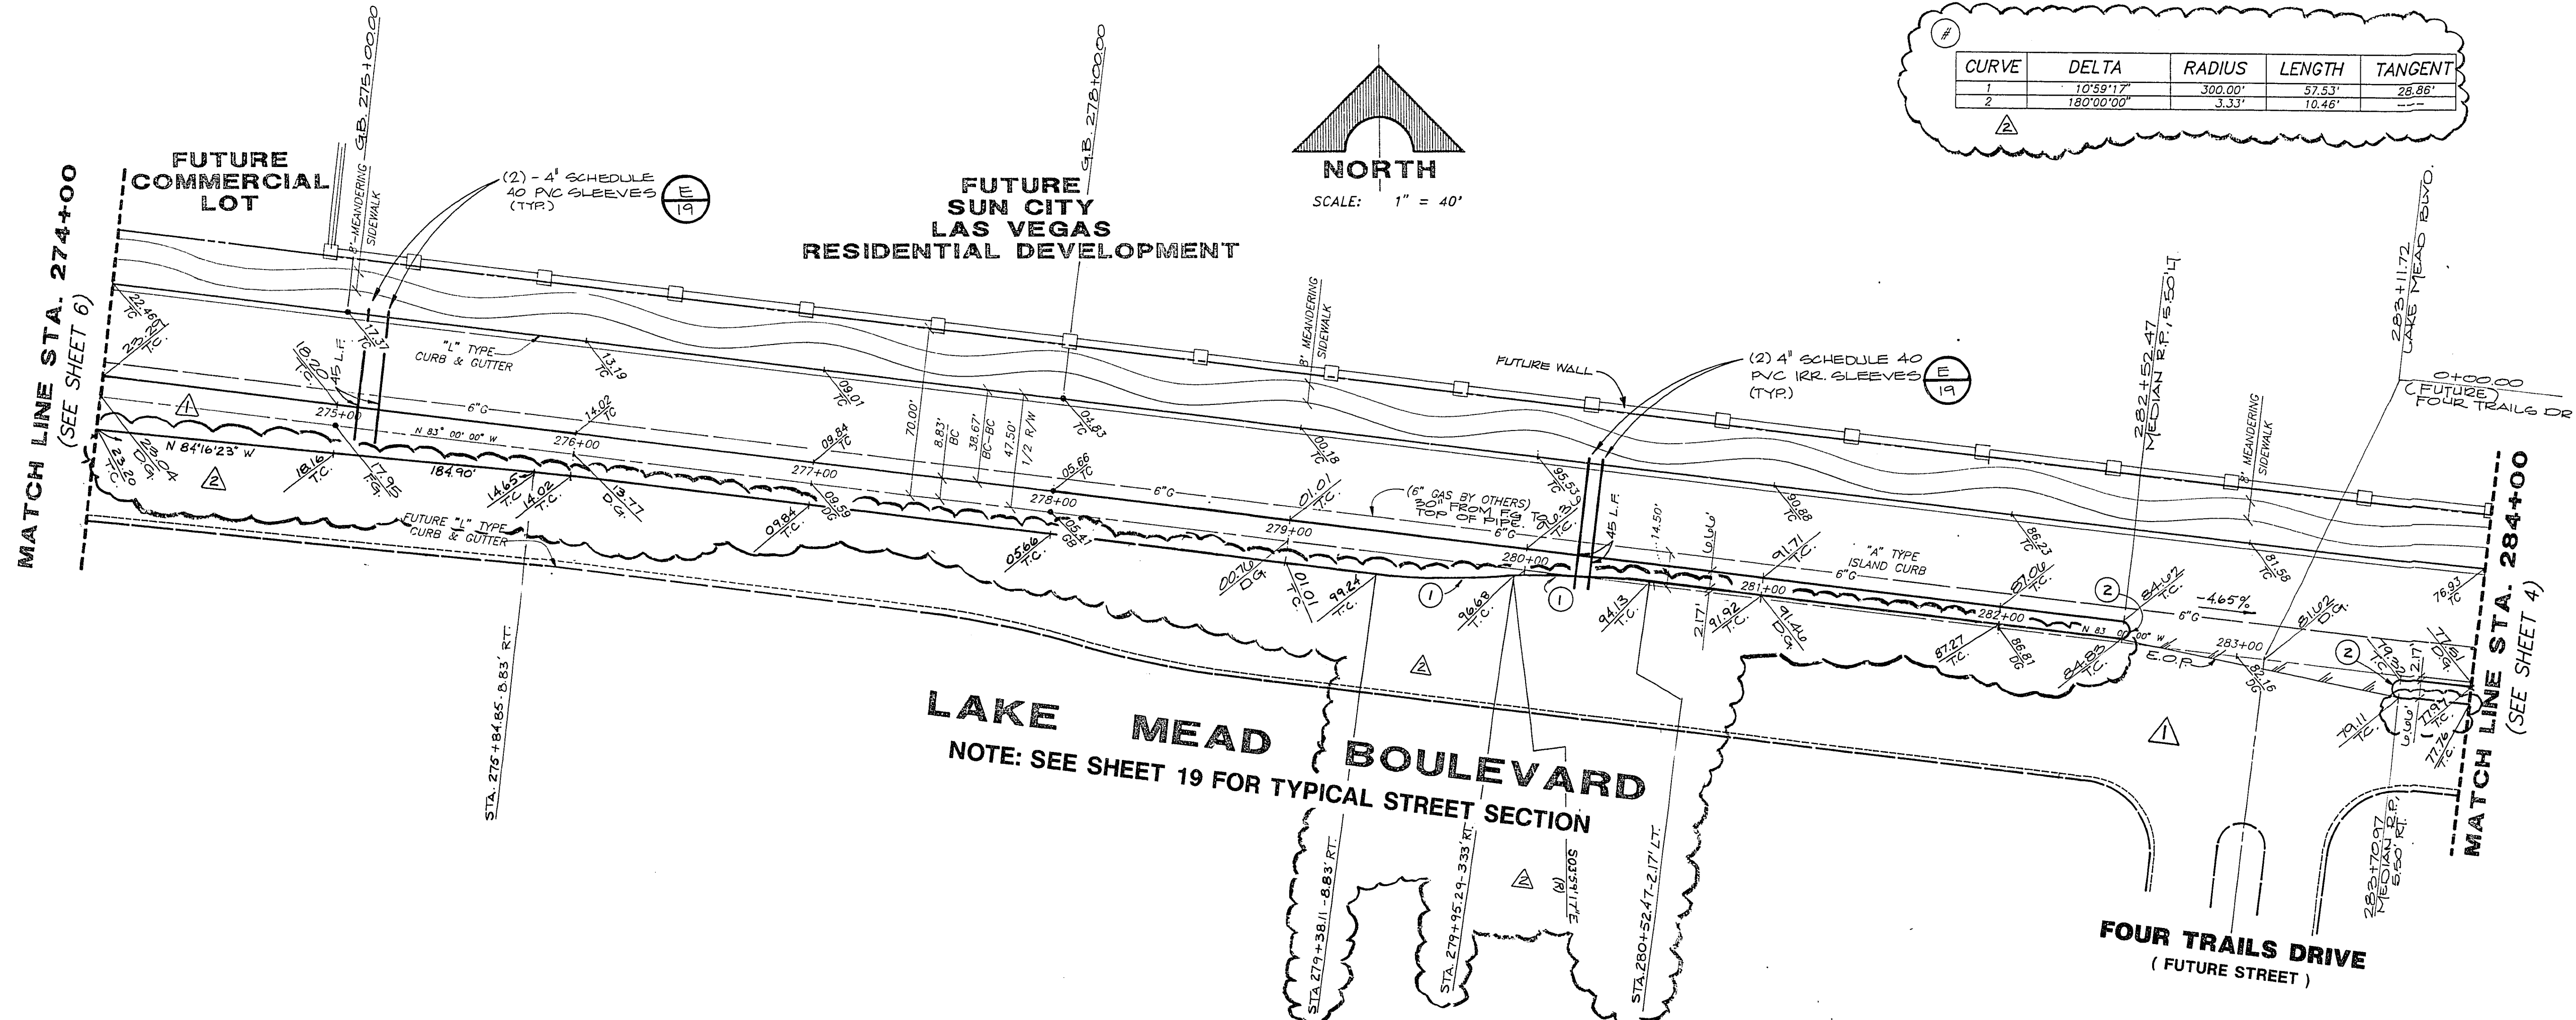

G.C. WALLACE, INC.
Engineering/Architecture
1555 SOUTH PARKWAY BLVD/LAS VEGAS, NEVADA 89102

DEL WEBB COMMUNITIES, INC.
SUN CITY LAS VEGAS
LAKE MEAD BOULEVARD
STA. 274+00 TO STA. 284+00

SHEET
5
OF 32 SHEETS