


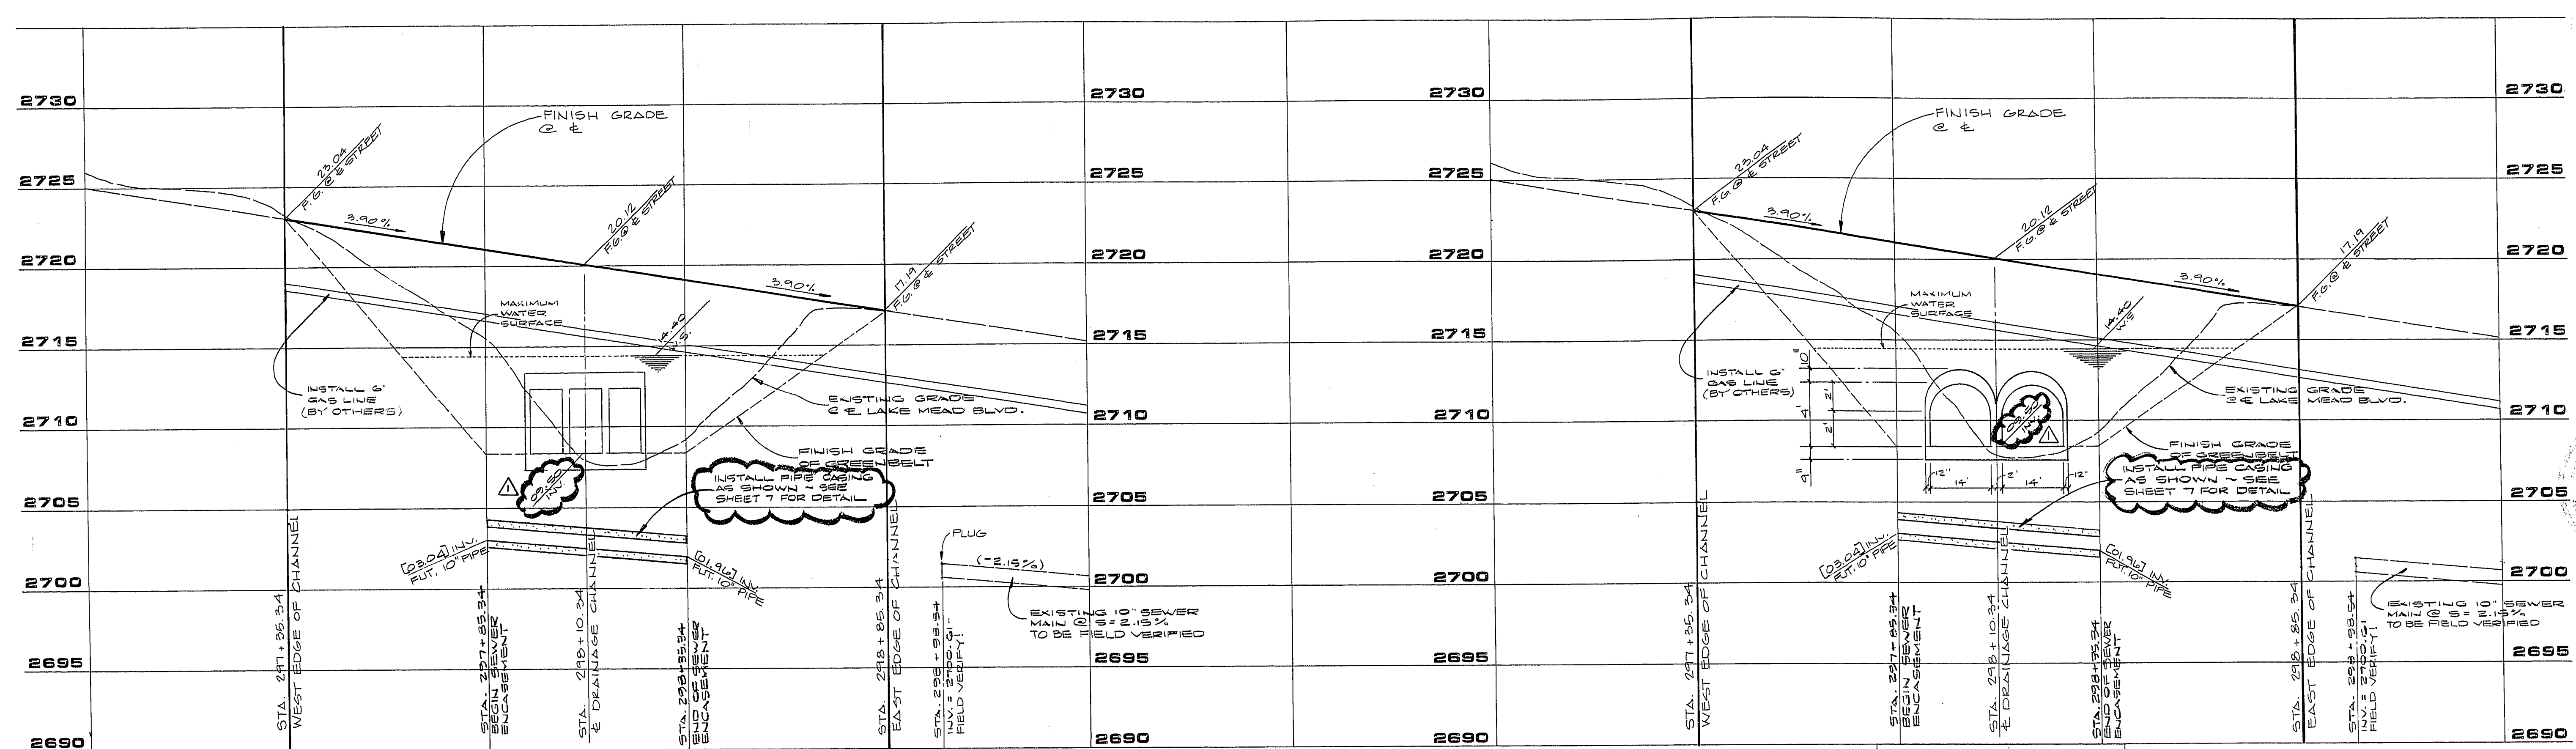

ELEVATION AT INLET
SCALE 1" = 20' HORIZ.
1" = 5' VERT.
(3) 8' x 4' R.C.B.
(880 CFS)


ELEVATION AT INLET
SCALE 1" = 20' HORIZ.
1" = 5' VERT.
(2) CONC. ARCH CULVERTS
(880 CFS)

WARP INVERT AND
SHOWN TO DIRECT
WATER TO
PROPOSED CATCH BASIN
AS SHOWN.


NOTE - REFER TO LAKE
MEAD BLVD. EXTENSION
WEST FROM STA. 290+46.72
TO STA. 312+21.33 FOR PROFILE
OF PROPOSED DROP INLET.

SEE STORM DRAIN
PROFILE THIS SHEET

NOTE:
EXISTING STORM DRAIN PIPE
TO BE FIELD VERIFIED FOR
HORIZONTAL & VERTICAL LOCATION.

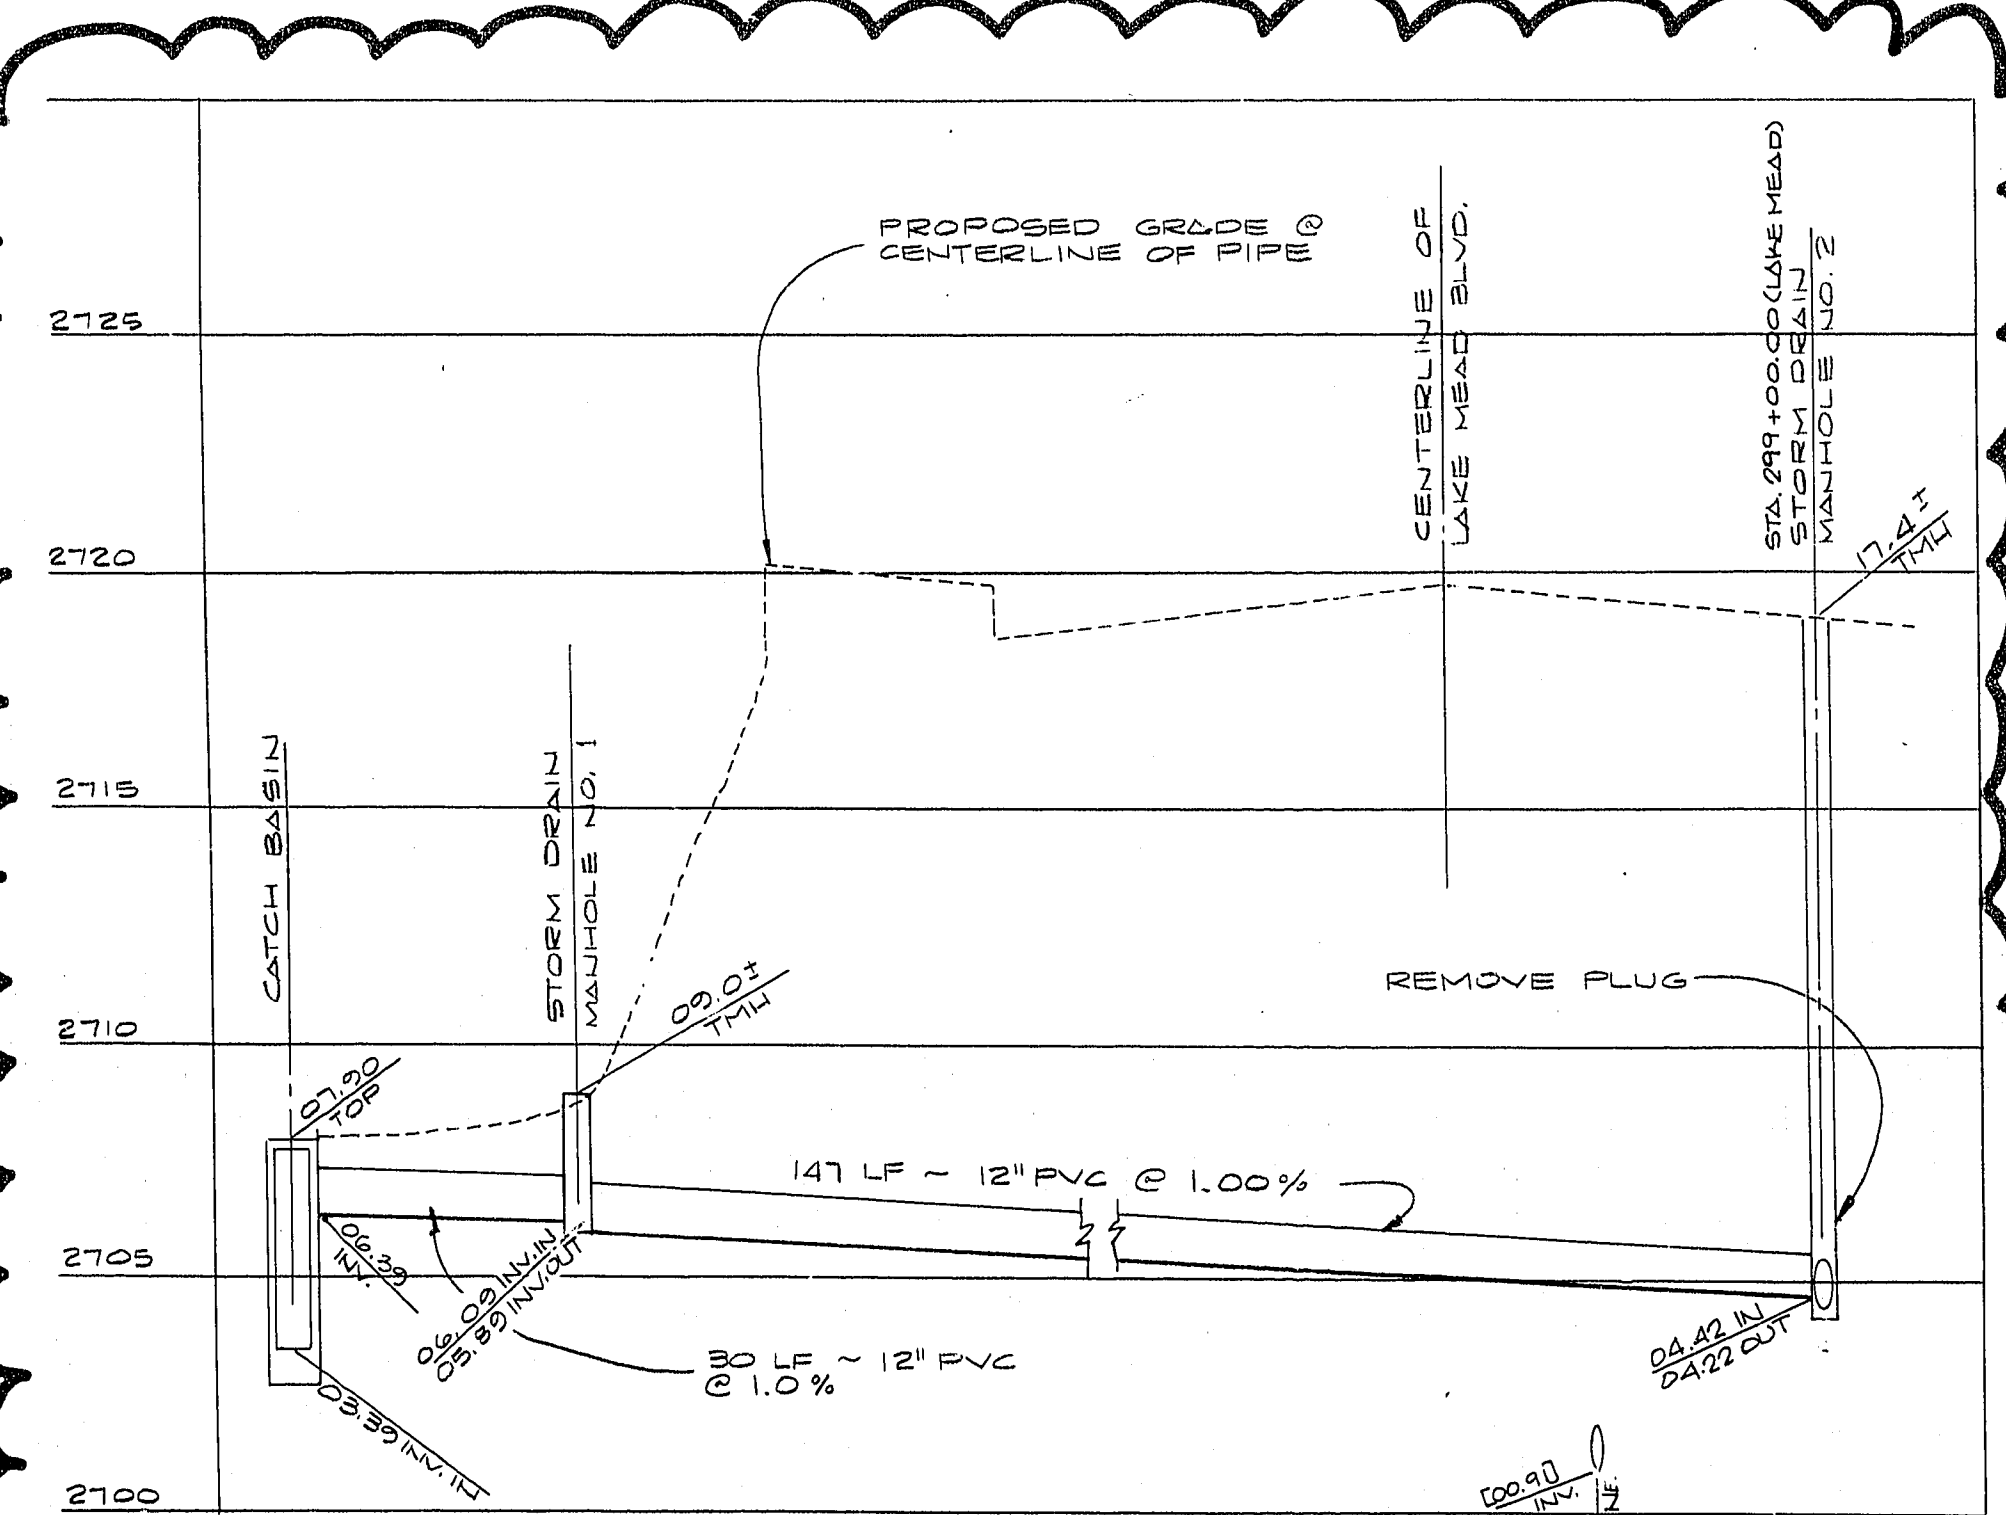

STORM DRAIN PROFILE
SCALE 1" = 20' HORIZ.
1" = 4' VERT.

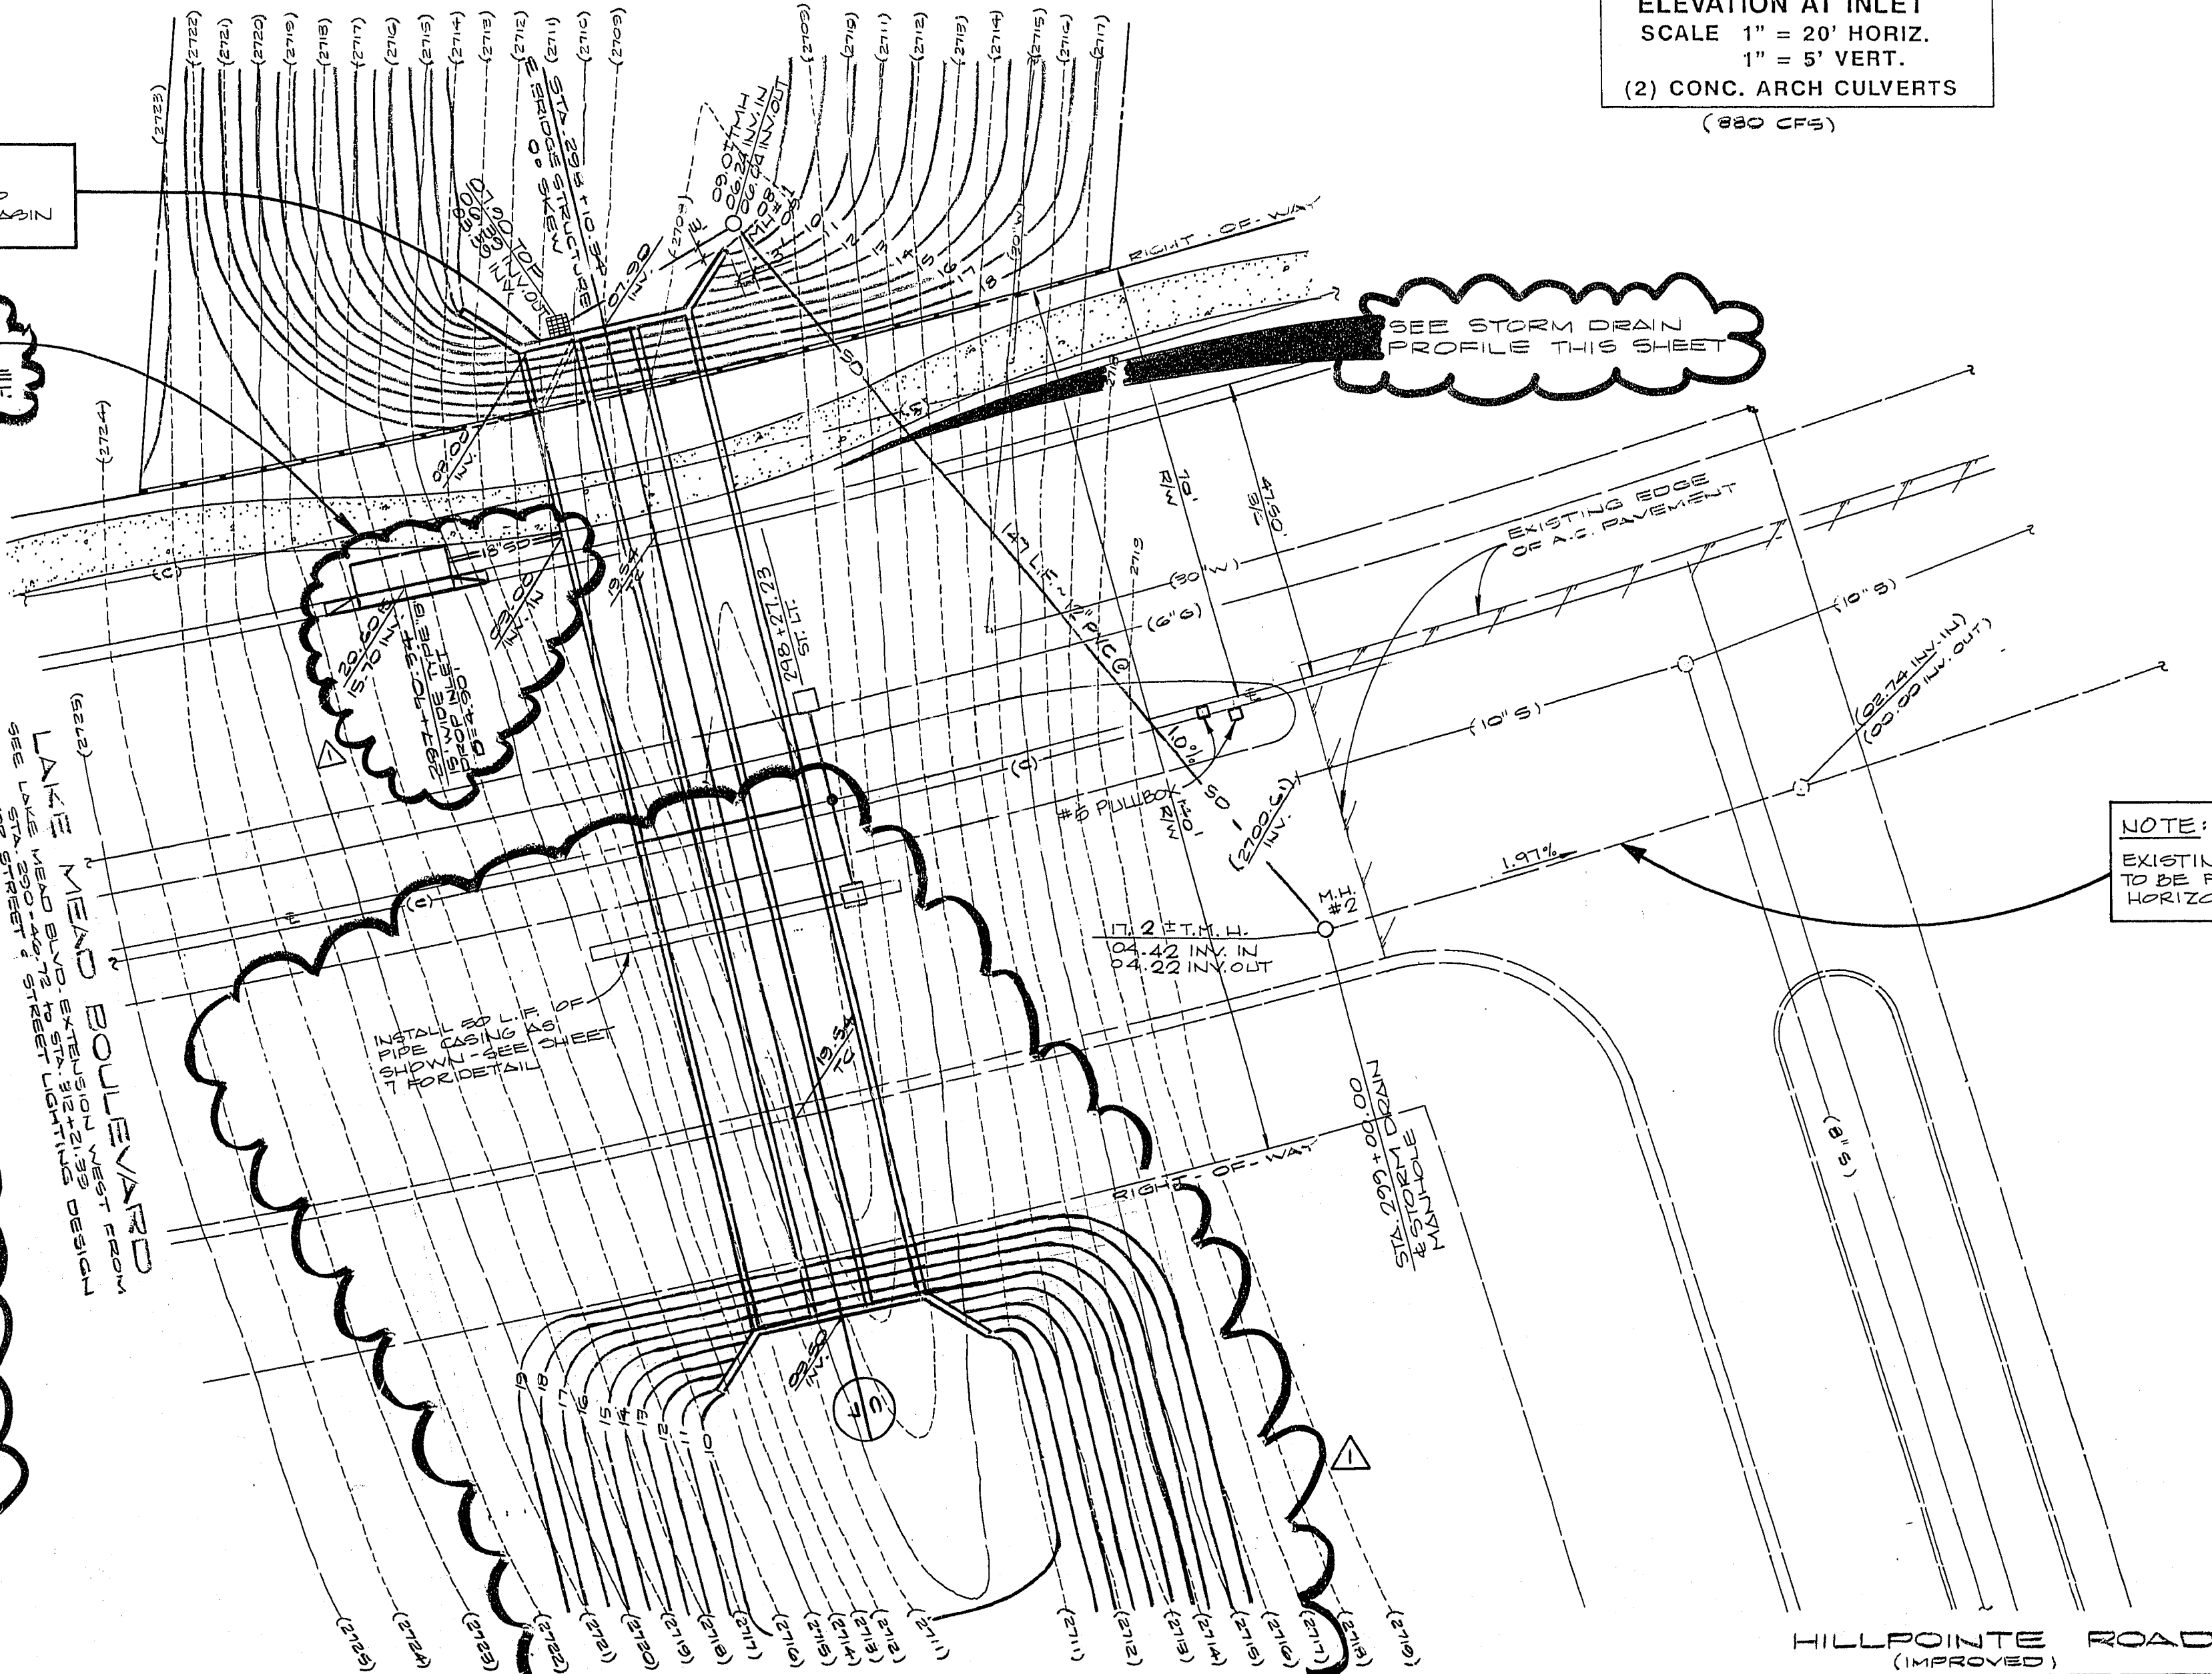

REV	DATE	DESCRIPTION
G.C. WALLACE, INC.
Engineering/Architecture

DEL WEBB COMMUNITIES, INC.
SUN CITY LAS VEGAS DRAINAGE STRUCTURES
LAKE MEAD BOULEVARD
(STORM DRAINAGE STRUCTURE NO. 1)

SHEET
3
OF 8 SHEETS

327Y-4141