


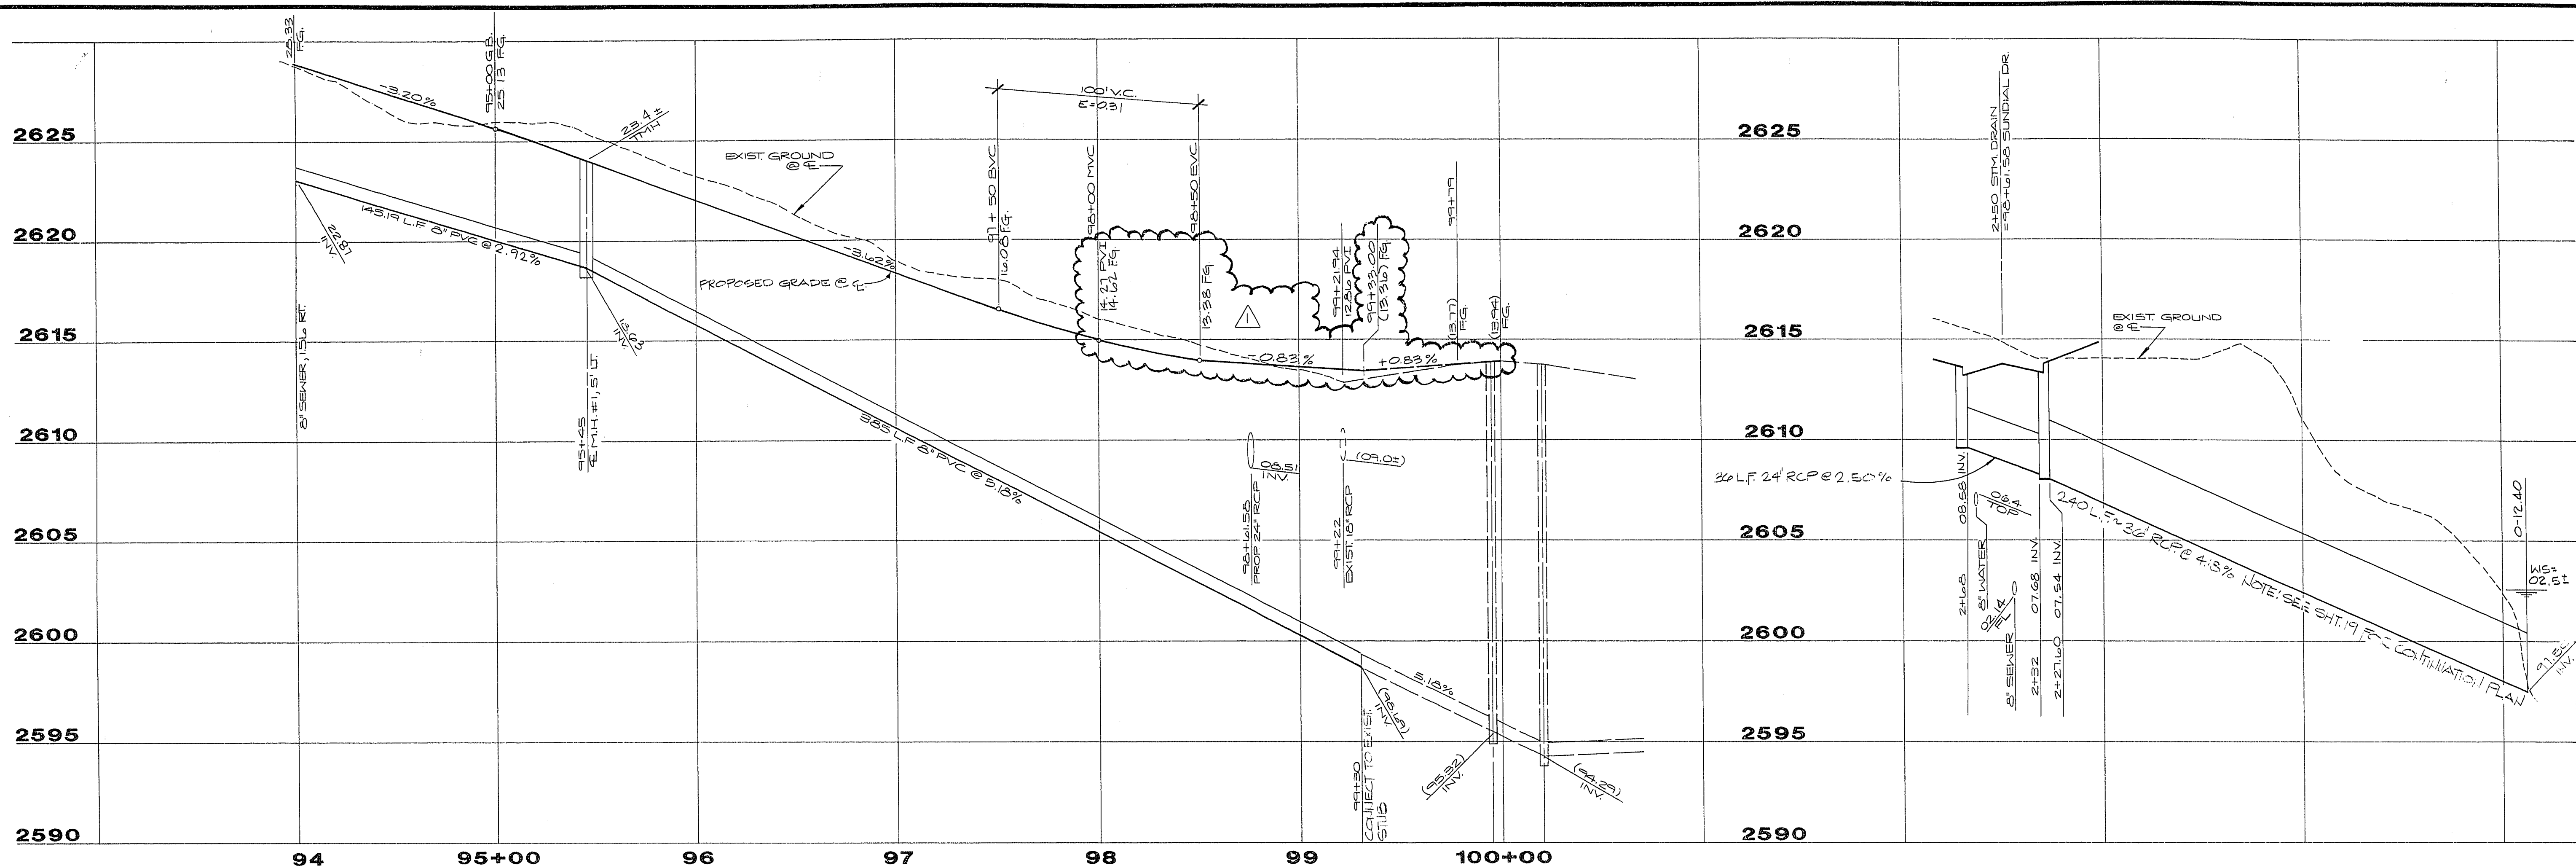

PROFILE
SCALE: HORIZ. 1" = 40'
VERT. 1" = 4'




MATCH LINE STA. 94+00
(SEE SHEET 12)

SEWER LINE TABLE

LINE	BEARING	DISTANCE
1	N 83°00'00" W	385.00'
2	N 86°50'19" W	450.00'

CURVE DATA

CURVE	DELTA	RADIUS	LENGTH	TANGENT
1	175°10'1"	2655.00'	827.16'	416.96'
2	175°10'1"	2675.00'	833.39'	420.10'
3	175°10'1"	2635.00'	820.92'	413.81'
4	01°34'56"	2635.00'	72.77'	36.39'
5	01°20'48"	2635.00'	61.93'	30.97'
6	01°41'45"	2675.00'	79.17'	39.59'
7	01°07'25"	2675.00'	52.45'	26.23'

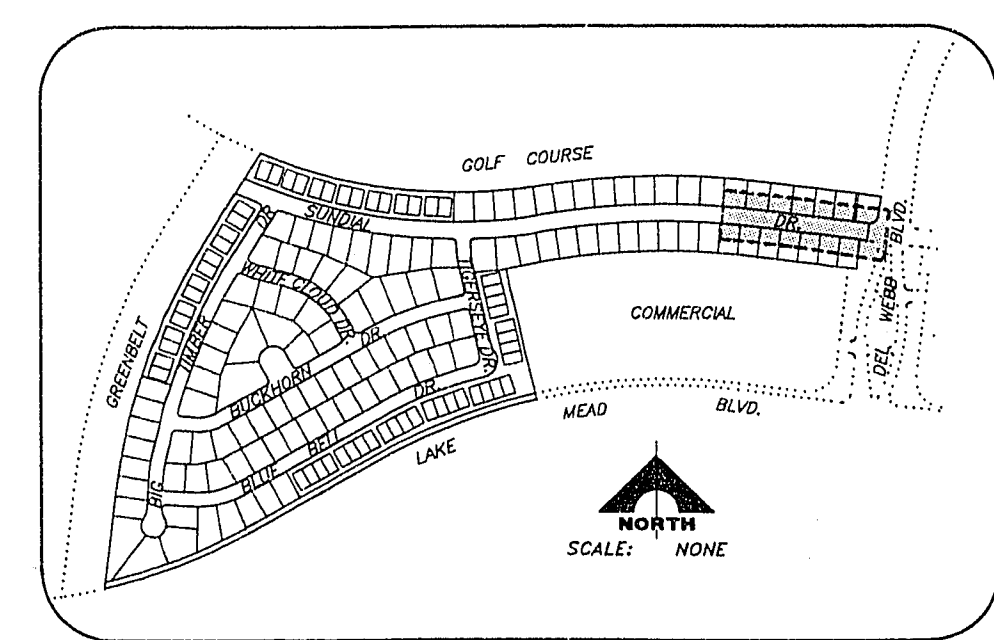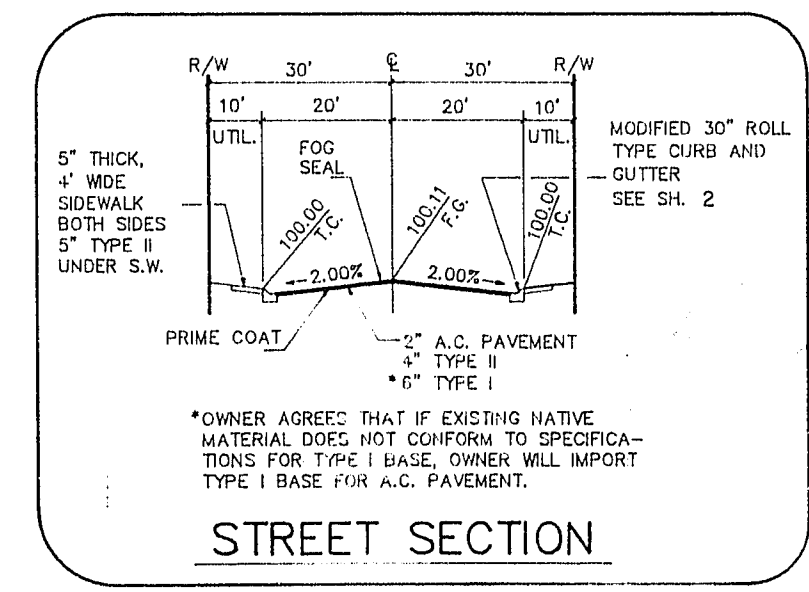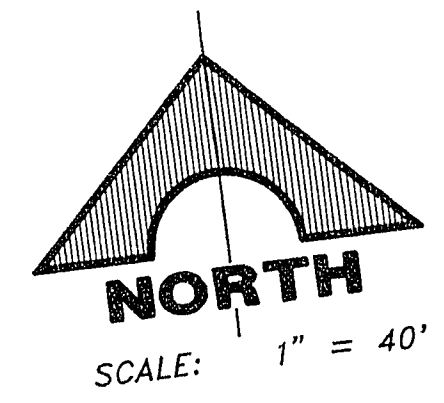

RECOMMENDED FOR CONSTRUCTION	DATE	6/18/2020
REVISIONS	DATE	
1	DATE	
2	DATE	
