
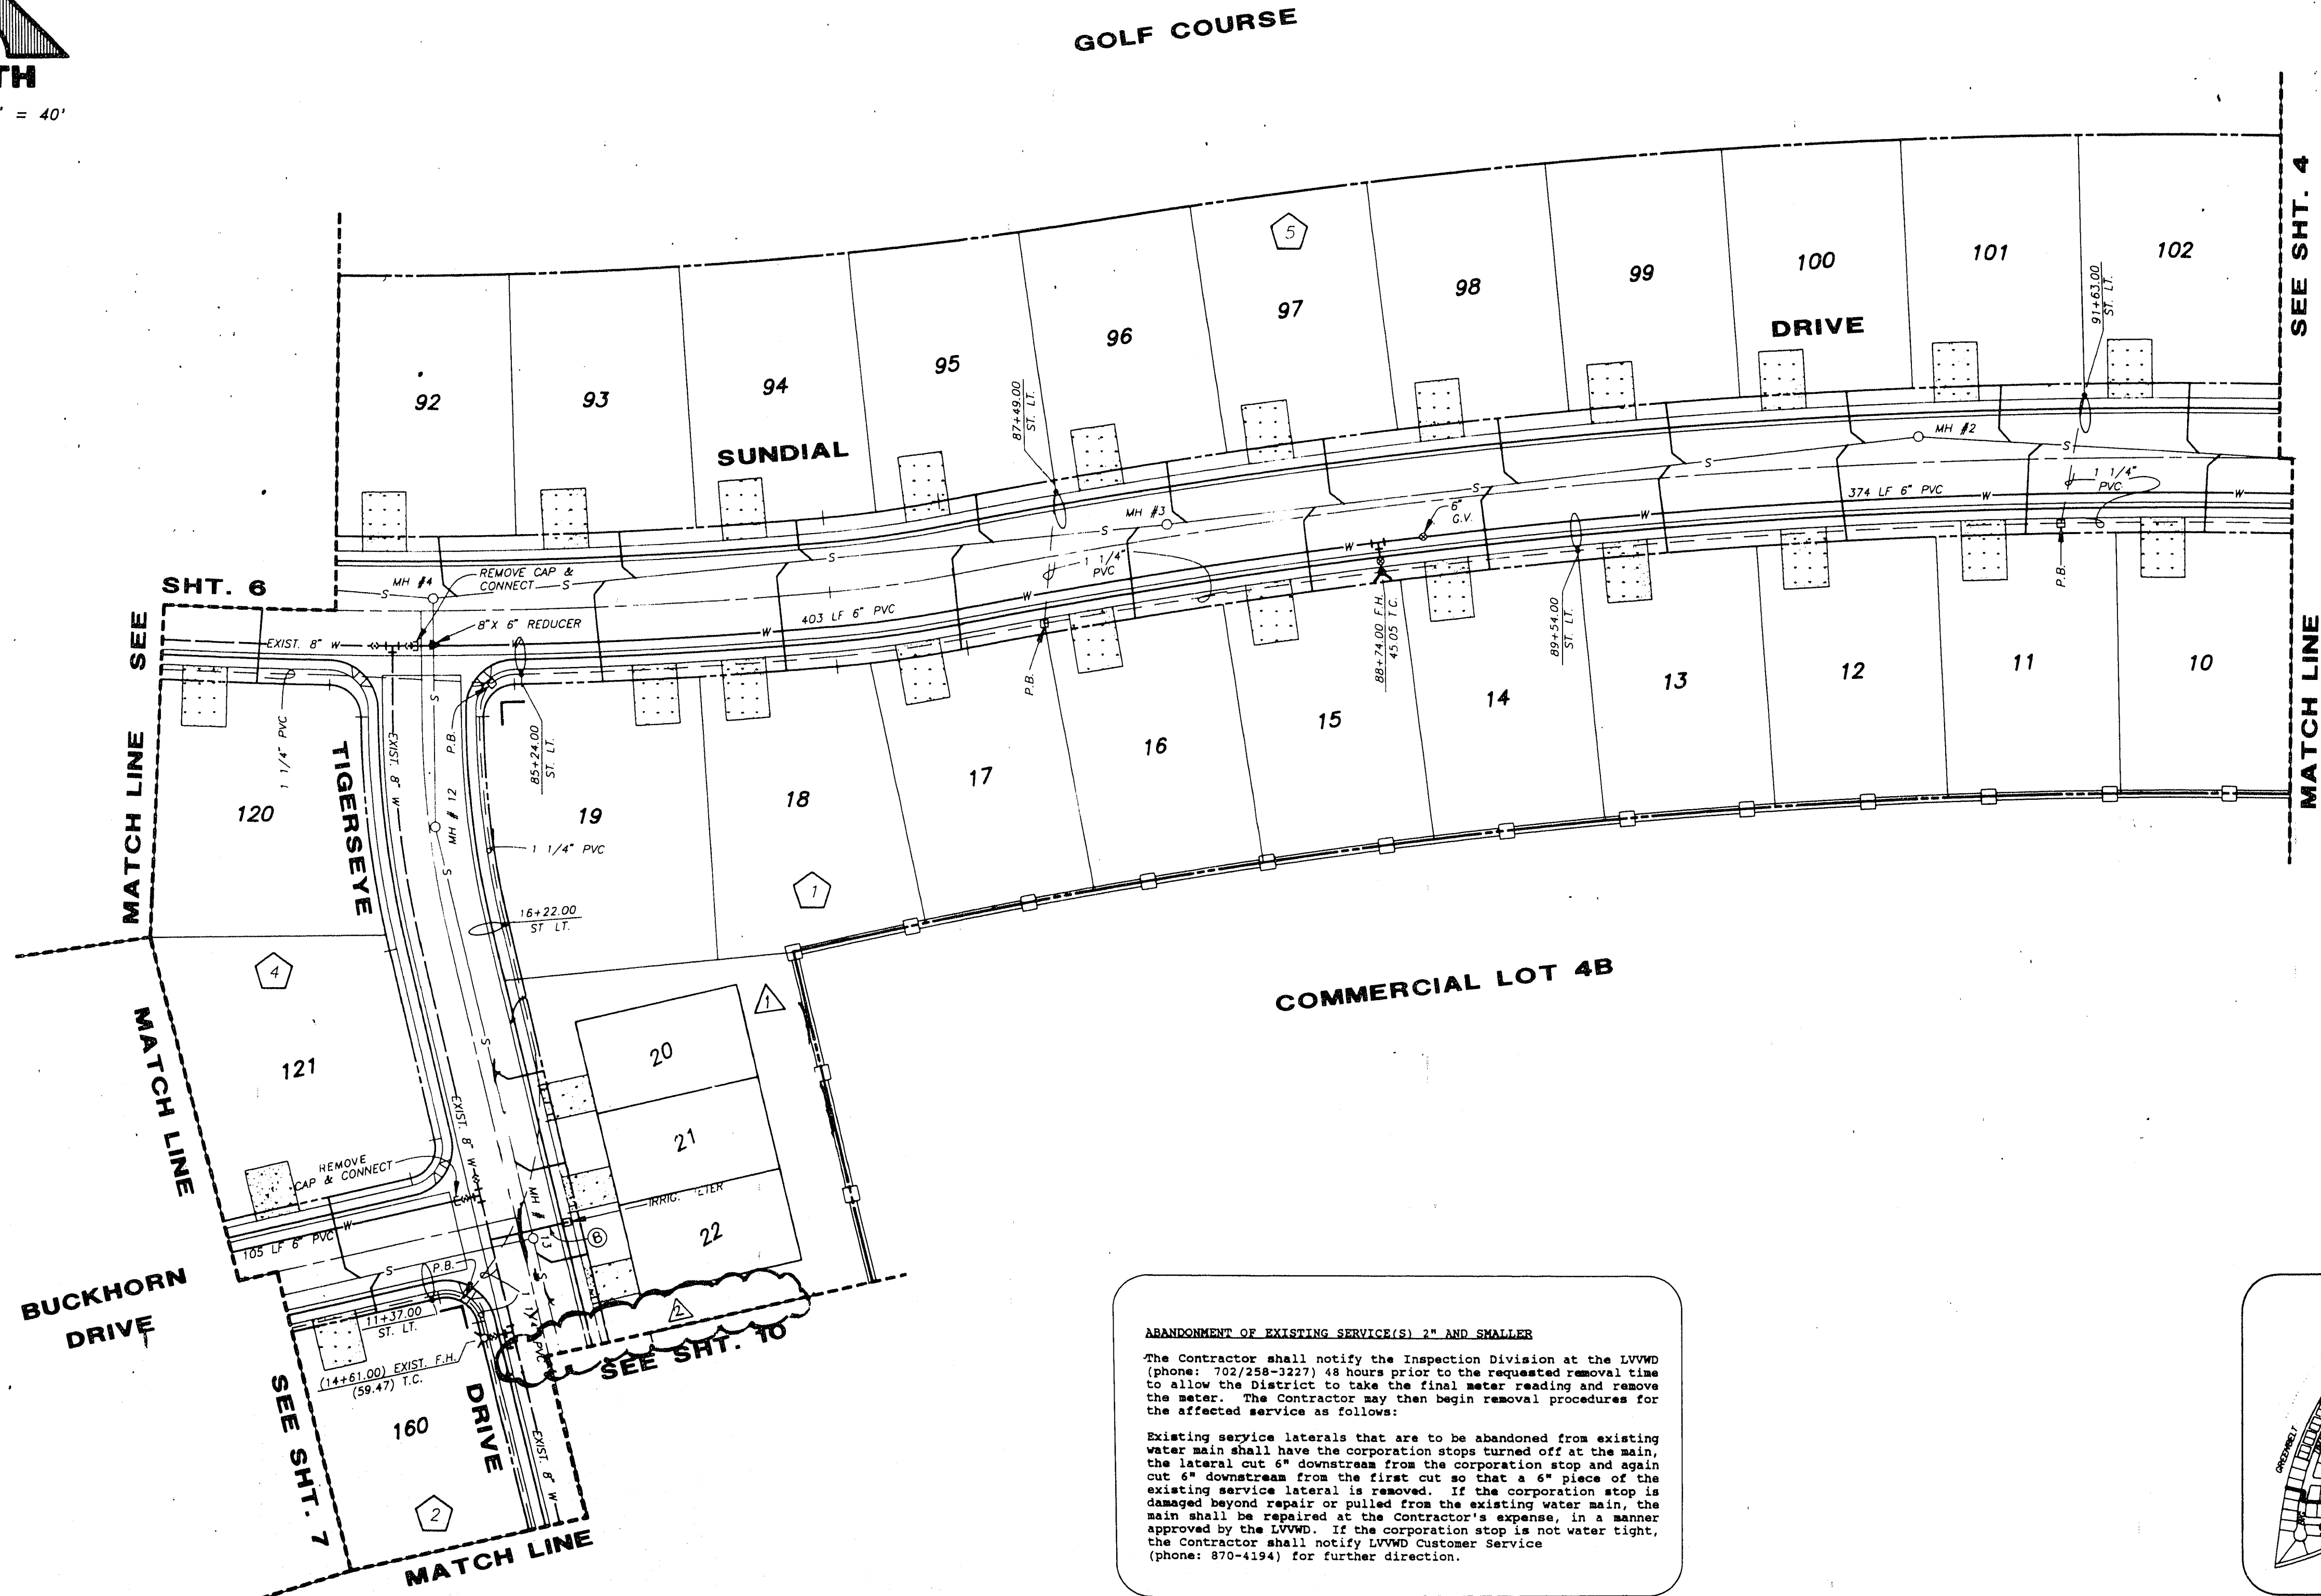


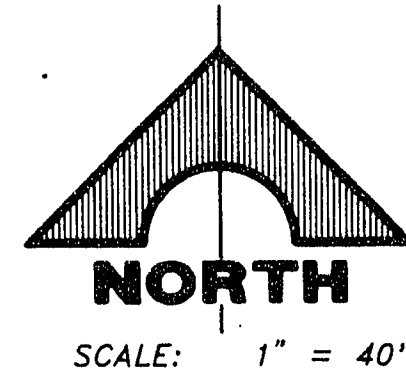


ABANDONMENT OF EXISTING SERVICE(S) 2" AND SMALLER

The Contractor shall notify the Inspection Division at the LVWD (phone: 702/258-1227) 48 hours prior to the requested removal time to allow the District to take the final meter reading and remove the meter. The Contractor may then begin removal procedures for the affected service as follows:

Existing service laterals that are to be abandoned from existing water main shall have the corporation stops turned off at the main, the lateral cut 6" downstream from the corporation stop and again cut 6" downstream from the first cut so that a 6" piece of the existing service lateral is removed. If the corporation stop is damaged beyond repair or pulled from the existing water main, the main shall be repaired at the Contractor's expense, in a manner approved by the LVWD. If the corporation stop is not water tight, the contractor shall notify LVWD Customer Service (phone: 870-4194) for further direction.

LEGEND:
⑤ ABANDON EXISTING IRRIG. METER.

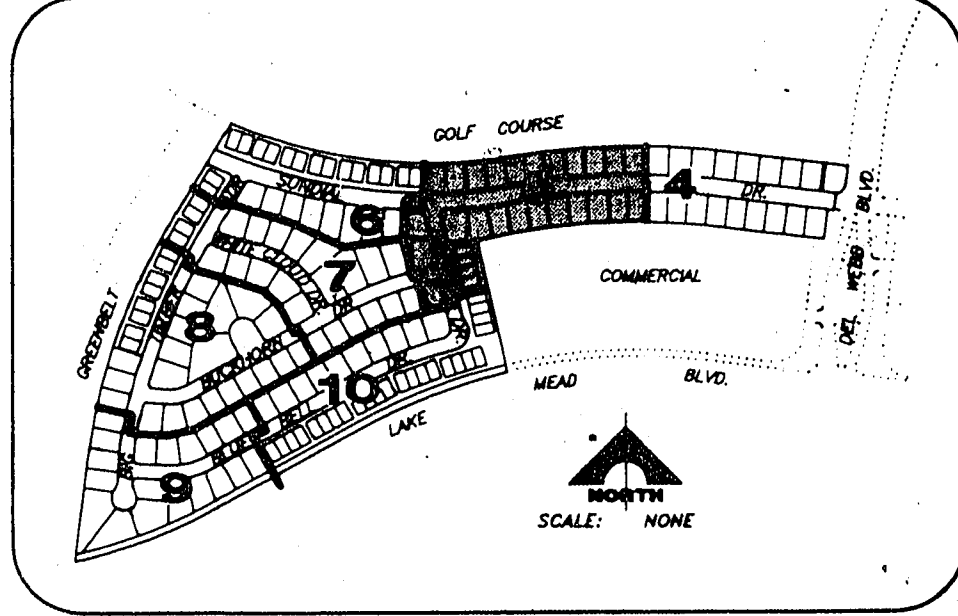

KEY MAP

APPROVED FOR CONSTRUCTION
DEL WEBB COMMUNITIES, INC. DATE

APPROVED FOR CONSTRUCTION
REVISION 5-14-97 DATE
11-15-97 DATE
LAS VEGAS WATER DISTRICT

REV	DATE	DESCRIPTION
1	2-27-97	24% CHANGE 4 PLEVES TO 3 PLEVES
2	11-15-97	11-15-97

RECOMMENDED
MICHAEL D. ROSS
MICHAEL D. ROSS
1555 SOUTH RAINBOW BLVD LAS VEGAS NEVADA 89102

DEL E. WEBB COMMUNITIES, INC.
SUN CITY LAS VEGAS UNIT NO. 23
UTILITY PLAN II

SHEET
5
OF 26 SHEETS

JOB NO. 701.093

NR 10-854 3002 2745-7 QS 359
2860-7 360
XC-3892
3074-4/11-23