

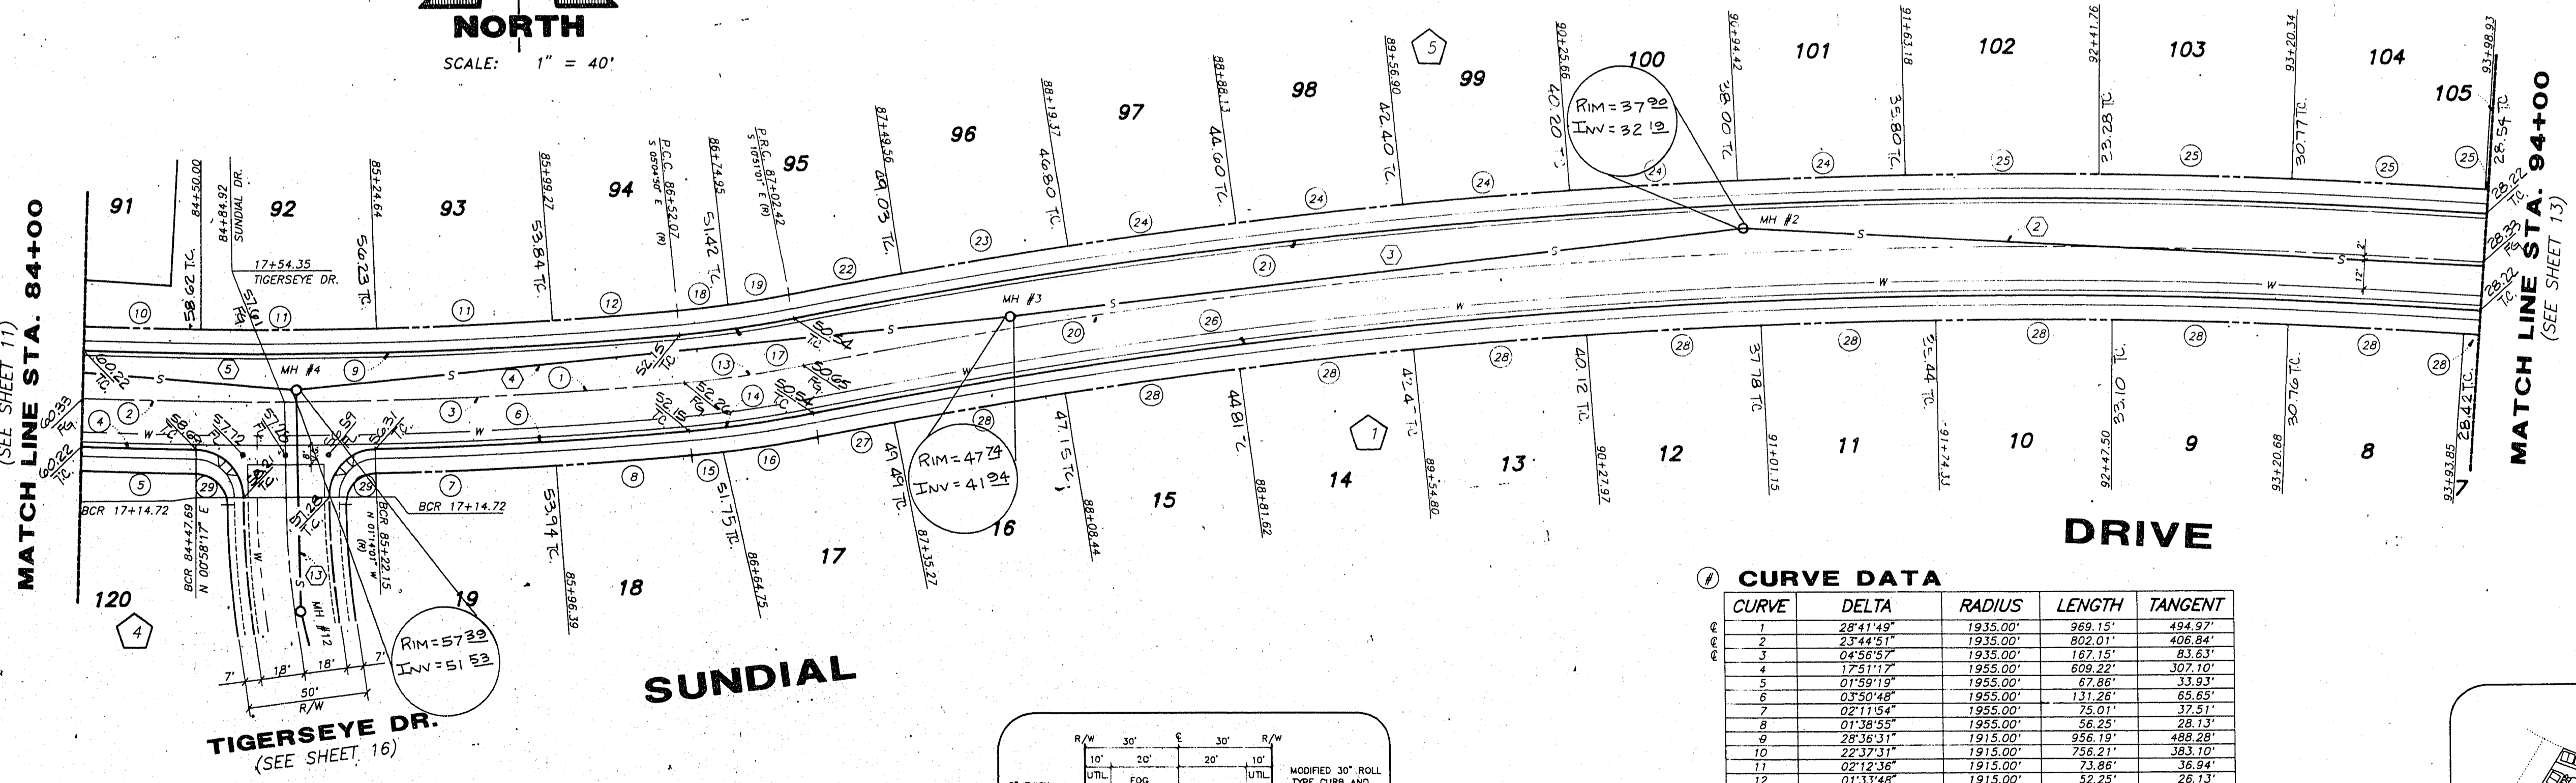


PROFILE
SCALE: HORIZ. 1" = 40'
VERT. 1" = 4'

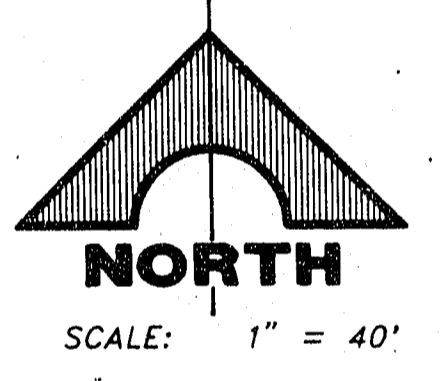

SEWER LINE TABLE


LINE	BEARING	DISTANCE
2	N 86°50'19" W	450.00'
3	S 8°20'38" W	305.50'
4	S 84°18'57" W	299.78'
5	N 85°12'22" W	341.28'
13	S 00°07'52" E	92.06'

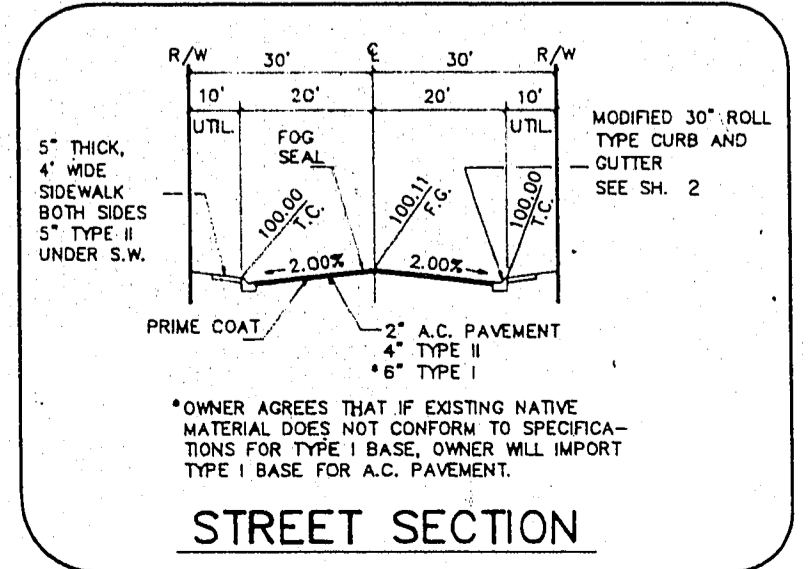

CURVE DATA

CURVE	DELTA	RADIUS	LENGTH	TANGENT
1	28°41'49"	1935.00'	969.15'	494.97'
2	23°44'51"	1935.00'	802.01'	406.84'
13	05°46'12"	500.00'	50.35'	25.20'
14	05°46'12"	520.00'	52.37'	26.21'
15	01°27'12"	520.00'	13.19'	6.59'
16	04°19'00"	520.00'	39.18'	19.60'
17	05°46'12"	480.00'	48.34'	24.19'
18	02°37'18"	480.00'	21.96'	10.98'
19	03°08'54"	480.00'	28.37'	13.19'
20	17°51'01"	2655.00'	827.16'	416.96'
21	17°51'01"	2675.00'	833.39'	420.10'
22	01°01'02"	2675.00'	47.50'	23.75'
23	01°30'24"	2675.00'	70.34'	35.17'
24	01°29'02"	2675.00'	69.28'	34.64'
25	01°41'45"	2675.00'	78.17'	39.09'
26	17°51'01"	2635.00'	820.93'	413.62'
27	00°42'32"	2635.00'	32.61'	16.30'
28	01°34'45"	2635.00'	72.62'	36.31'
29	80°00'00"	20.00'	31.42'	20.00'

APPROVED FOR CONSTRUCTION
DEL WEBB COMMUNITIES, INC. DATE

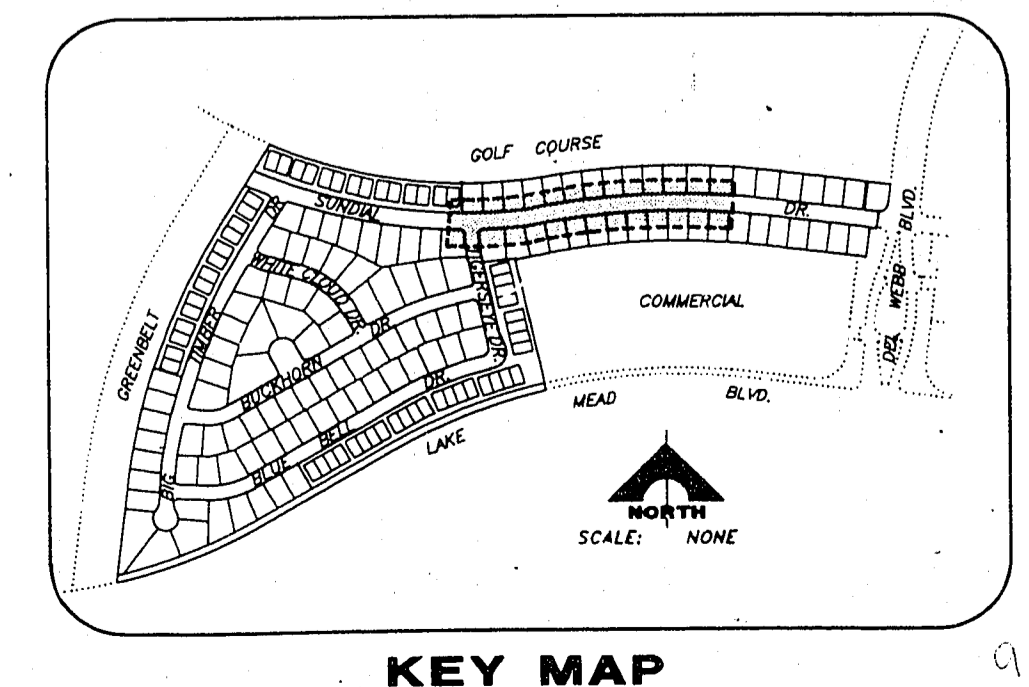

REV	DATE	DESCRIPTION

RECOMMENDED BY: STATE OF NEVADA
MICHAEL D. ROSS, CIVIL ENGINEER
1555 SOUTH RAINBOW BLVD. LAS VEGAS, NEVADA 89102

G.C. WALLACE, INC.
Engineering/Architecture

DEL WEBB COMMUNITIES, INC.
SUN CITY LAS VEGAS UNIT NO. 23
SUNDIAL DRIVE

SHEET
12
OF 26 SHEETS