
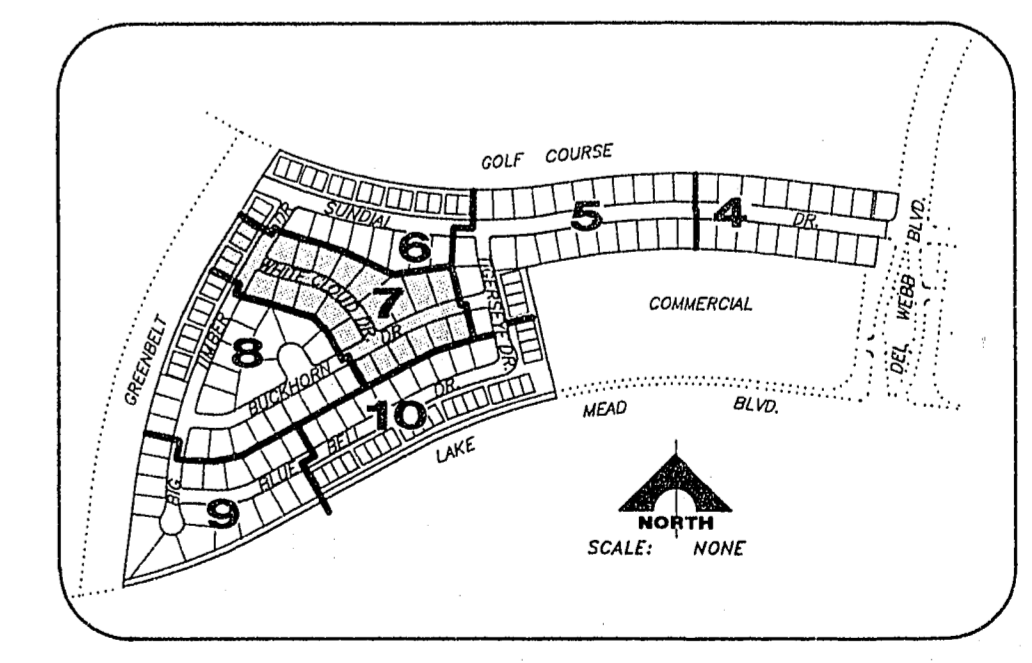
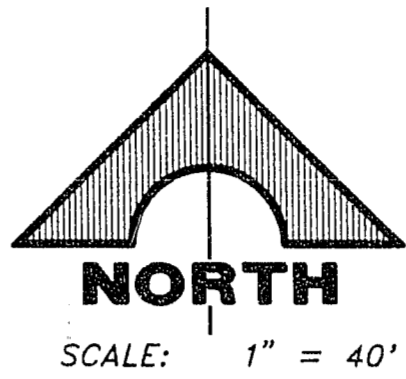


JOB NO. 701.093

684 DIETERICH-POST 65328

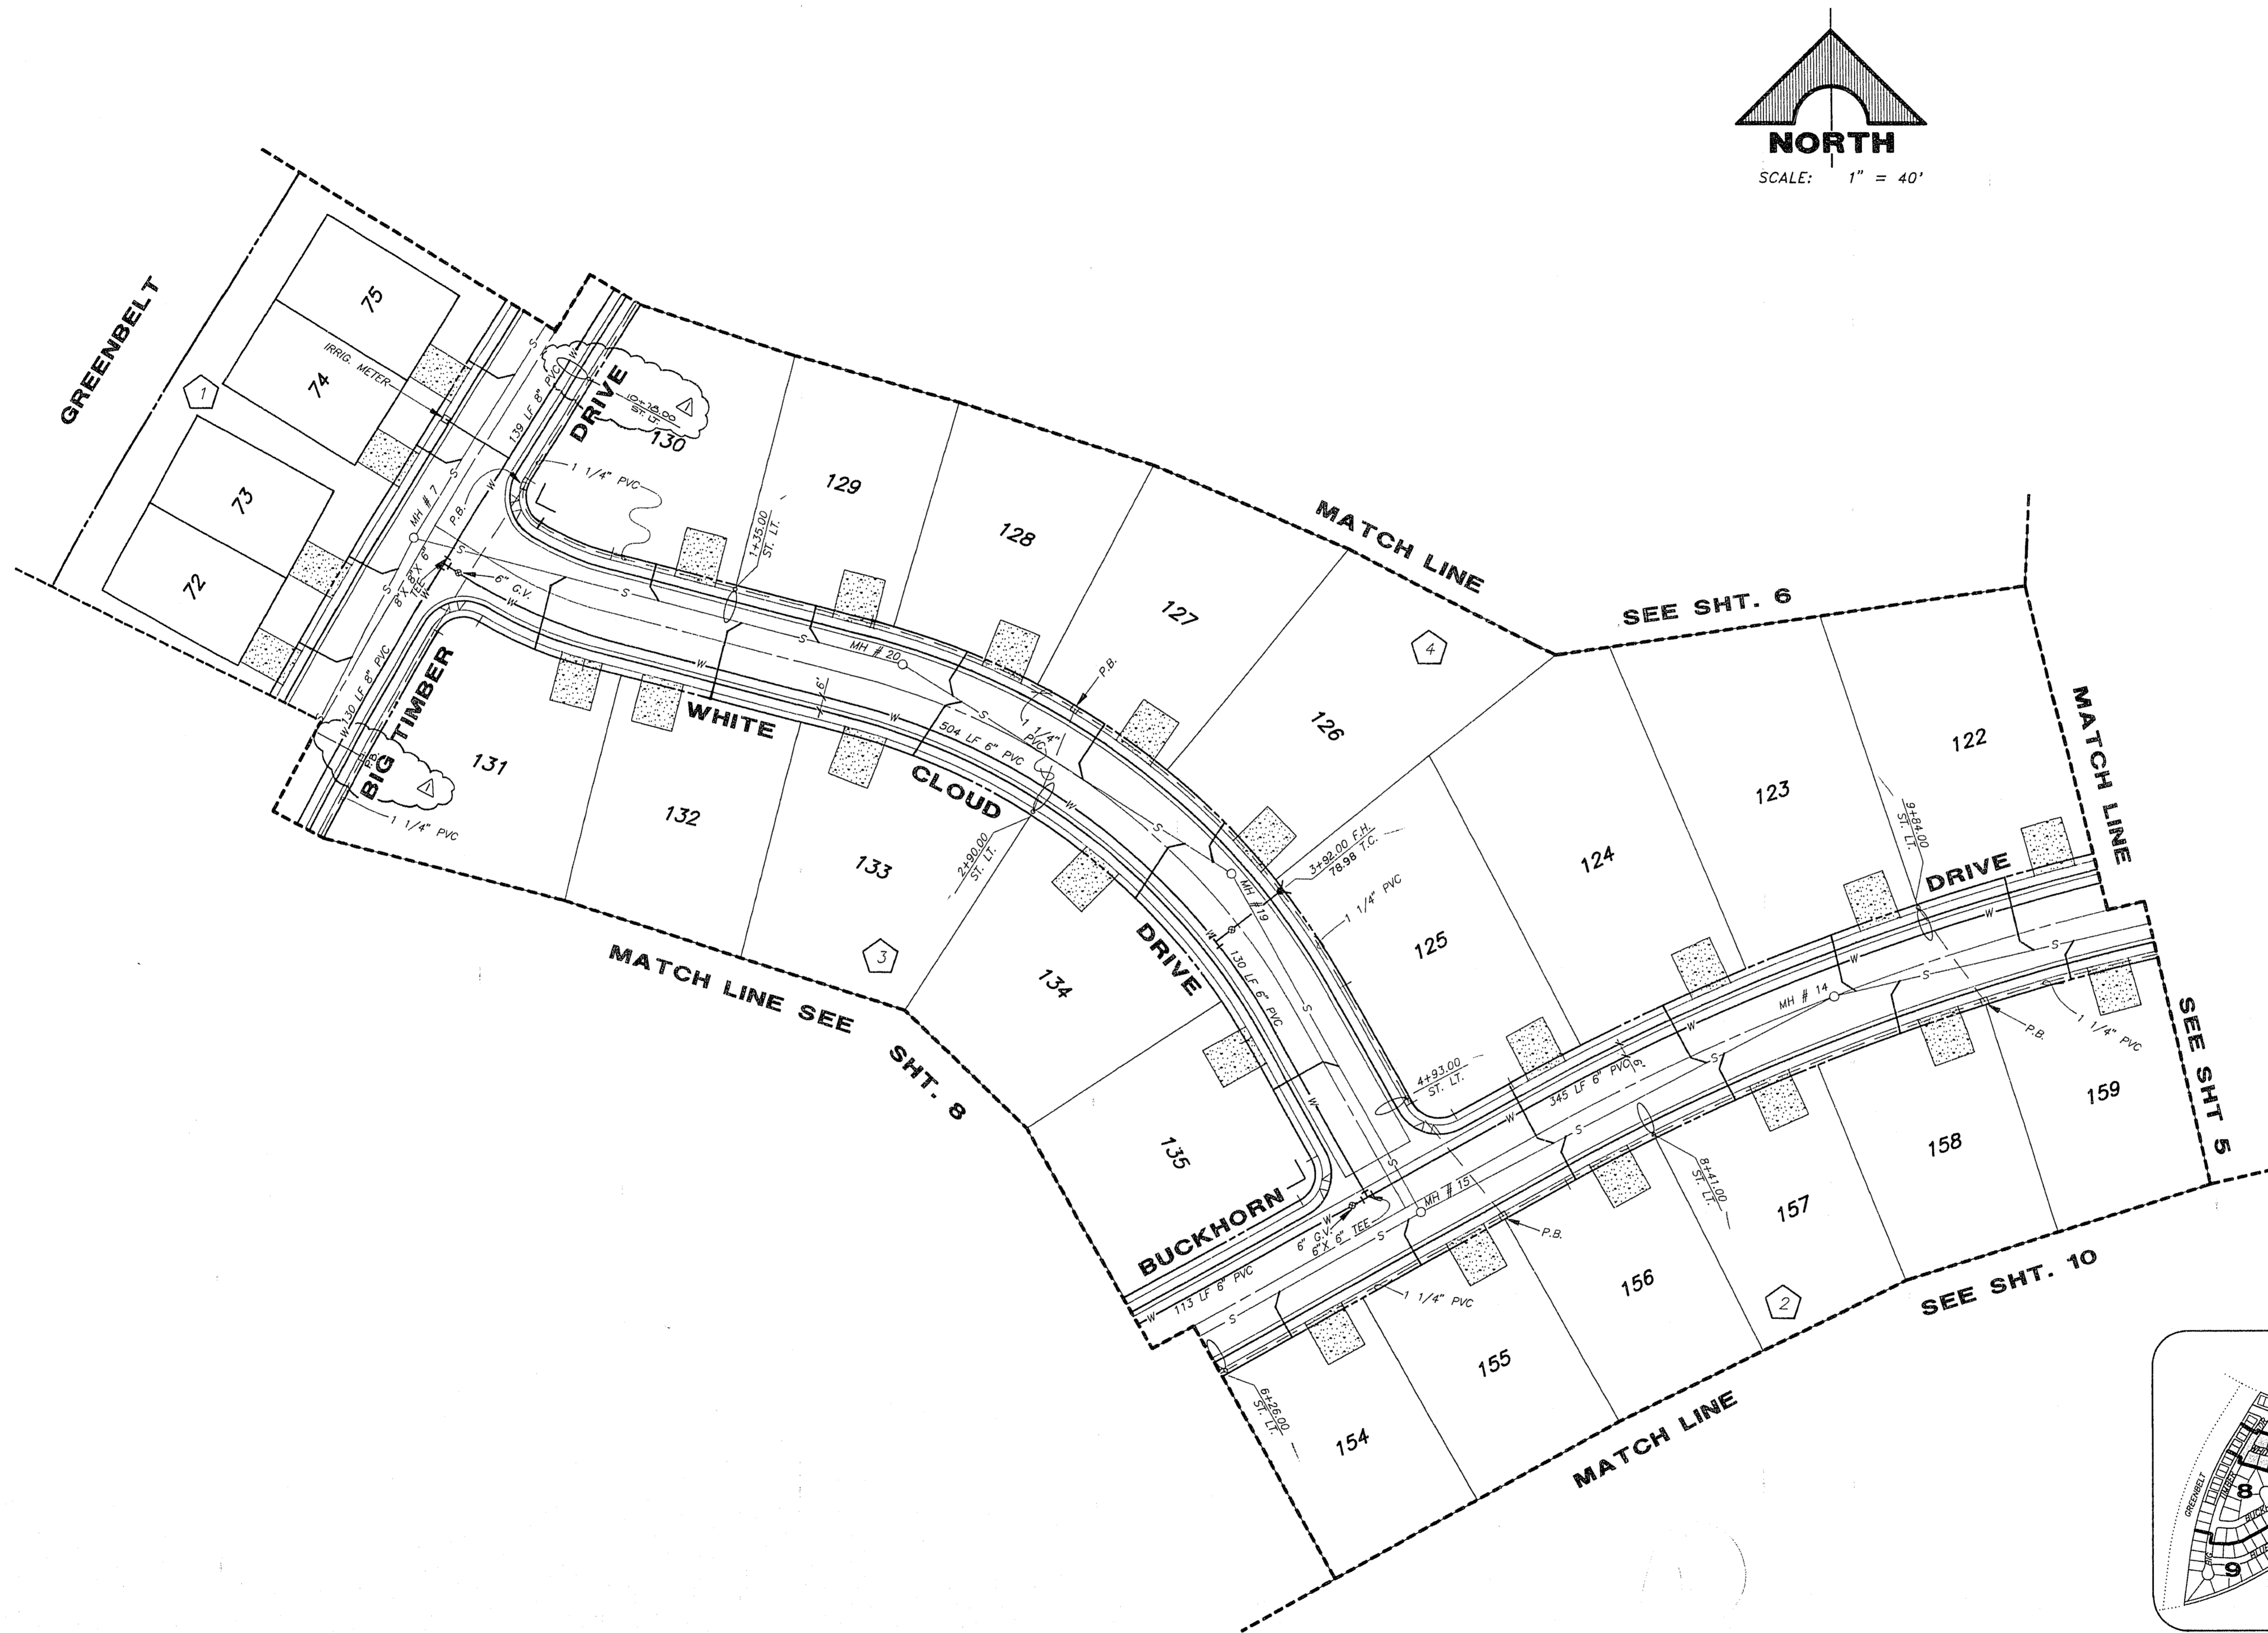

APPROVED FOR CONSTRUCTION
DEL WEBB COMMUNITIES, INC. DATE

APPROVED FOR CONSTRUCTION
[Signature] 11-05-90
LAS VEGAS WATER DISTRICT DATE

REV	DATE	DESCRIPTION
1	11-05-90	ISSUED FOR PERMIT AND FINAL G.D.C.

RECOMMENDED BY ALL ENGINEERS
MICHAEL D. ROSS, LICENSE NO. 2218
G.C. WALLACE, INC.
Engineering/Architecture
1555 SOUTH RAINBOW BLVD., LAS VEGAS, NEVADA 89102

DEL E. WEBB COMMUNITIES, INC.
SUN CITY LAS VEGAS UNIT NO. 23
UTILITY PLAN IV

SHEET
7
OF 26 SHEETS

3017-4141-23