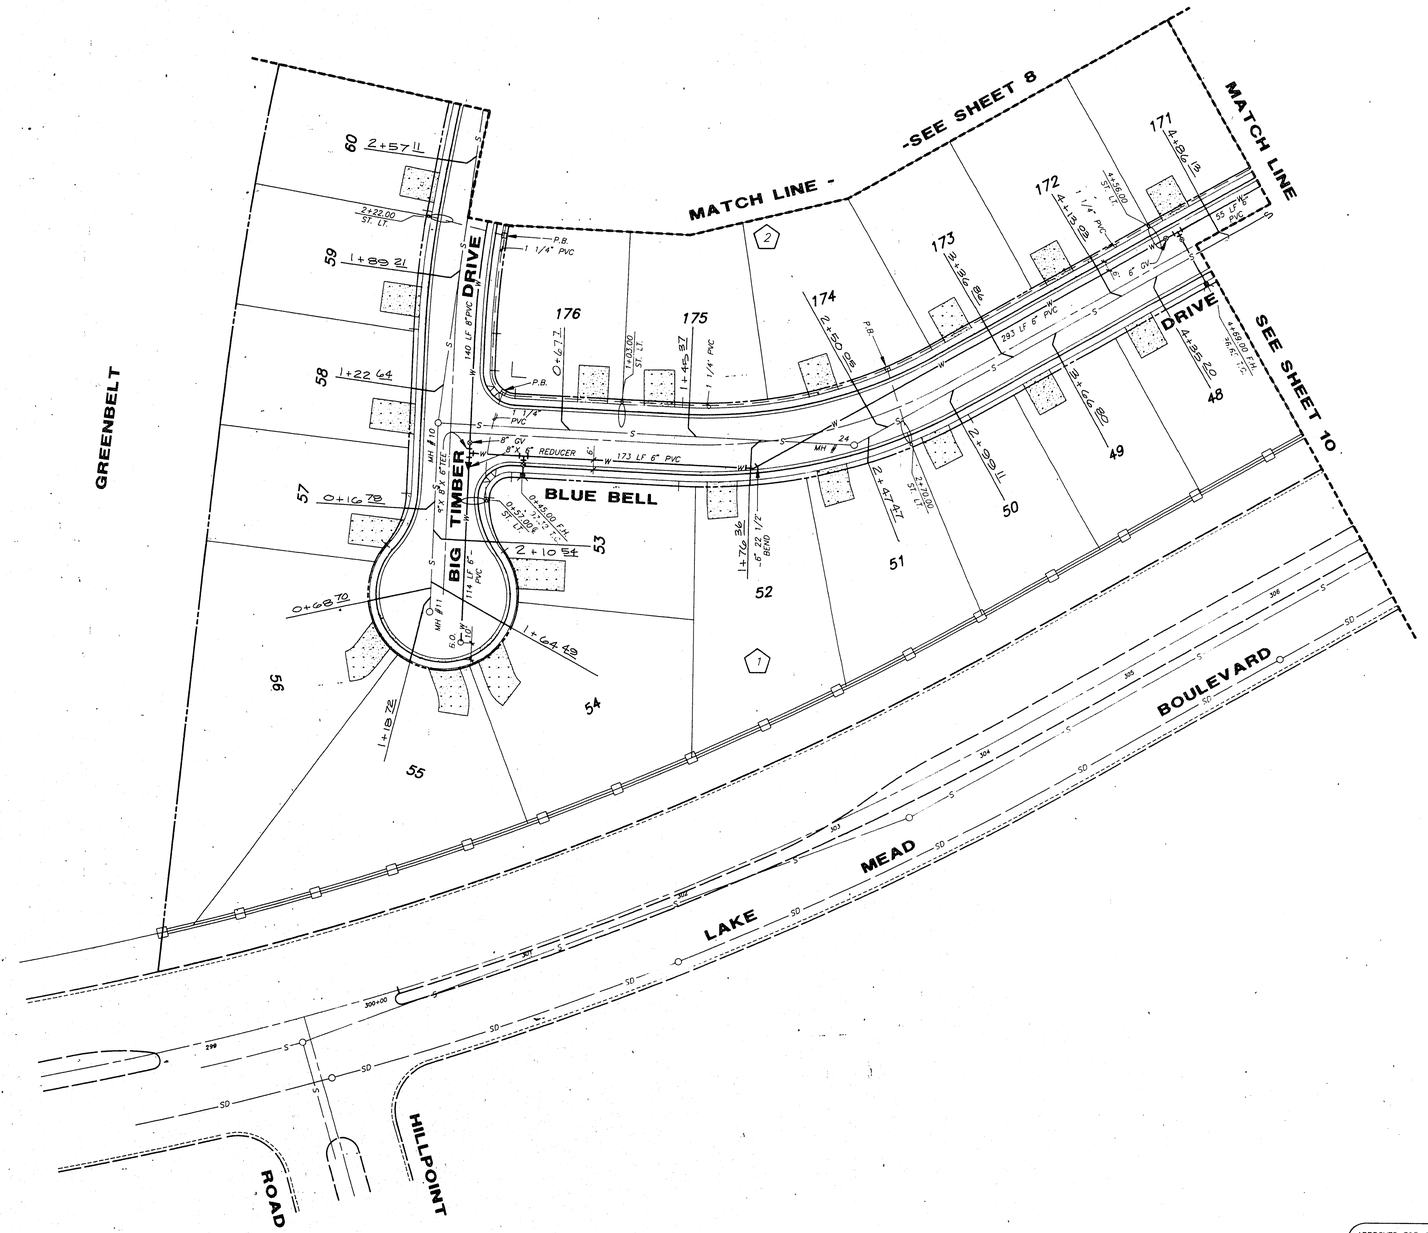

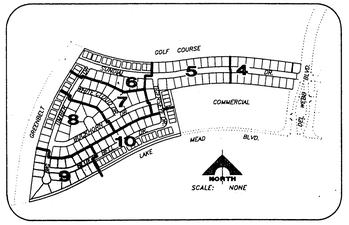

KEY MAP

APPROVED FOR CONSTRUCTION

DEL WEBB COMMUNITIES, INC. DATE

APPROVED FOR CONSTRUCTION

LAS VEGAS WATER DISTRICT 11-05-93 DATE

REV	DATE	DESCRIPTION

RECOMMENDED
MICHAEL D. ROSS
REGISTERED PROFESSIONAL ENGINEER
NO. 9218
DATE

MICHAEL D. ROSS
STATE OF NEVADA
9218
REGISTERED PROFESSIONAL ENGINEER

G.C. WALLACE, INC.
Engineering/Architecture
1555 SOUTH RAINBOW BLVD. / LAS VEGAS, NEVADA 89102

DEL E. WEBB COMMUNITIES, INC.
SUN CITY LAS VEGAS UNIT NO. 23

UTILITY PLAN VI

SHEET 9 OF 26 SHEETS

JOB NO. 701.093

8/94 DIETERICH-POST 6532B

As Built 3074- 4/41-23