


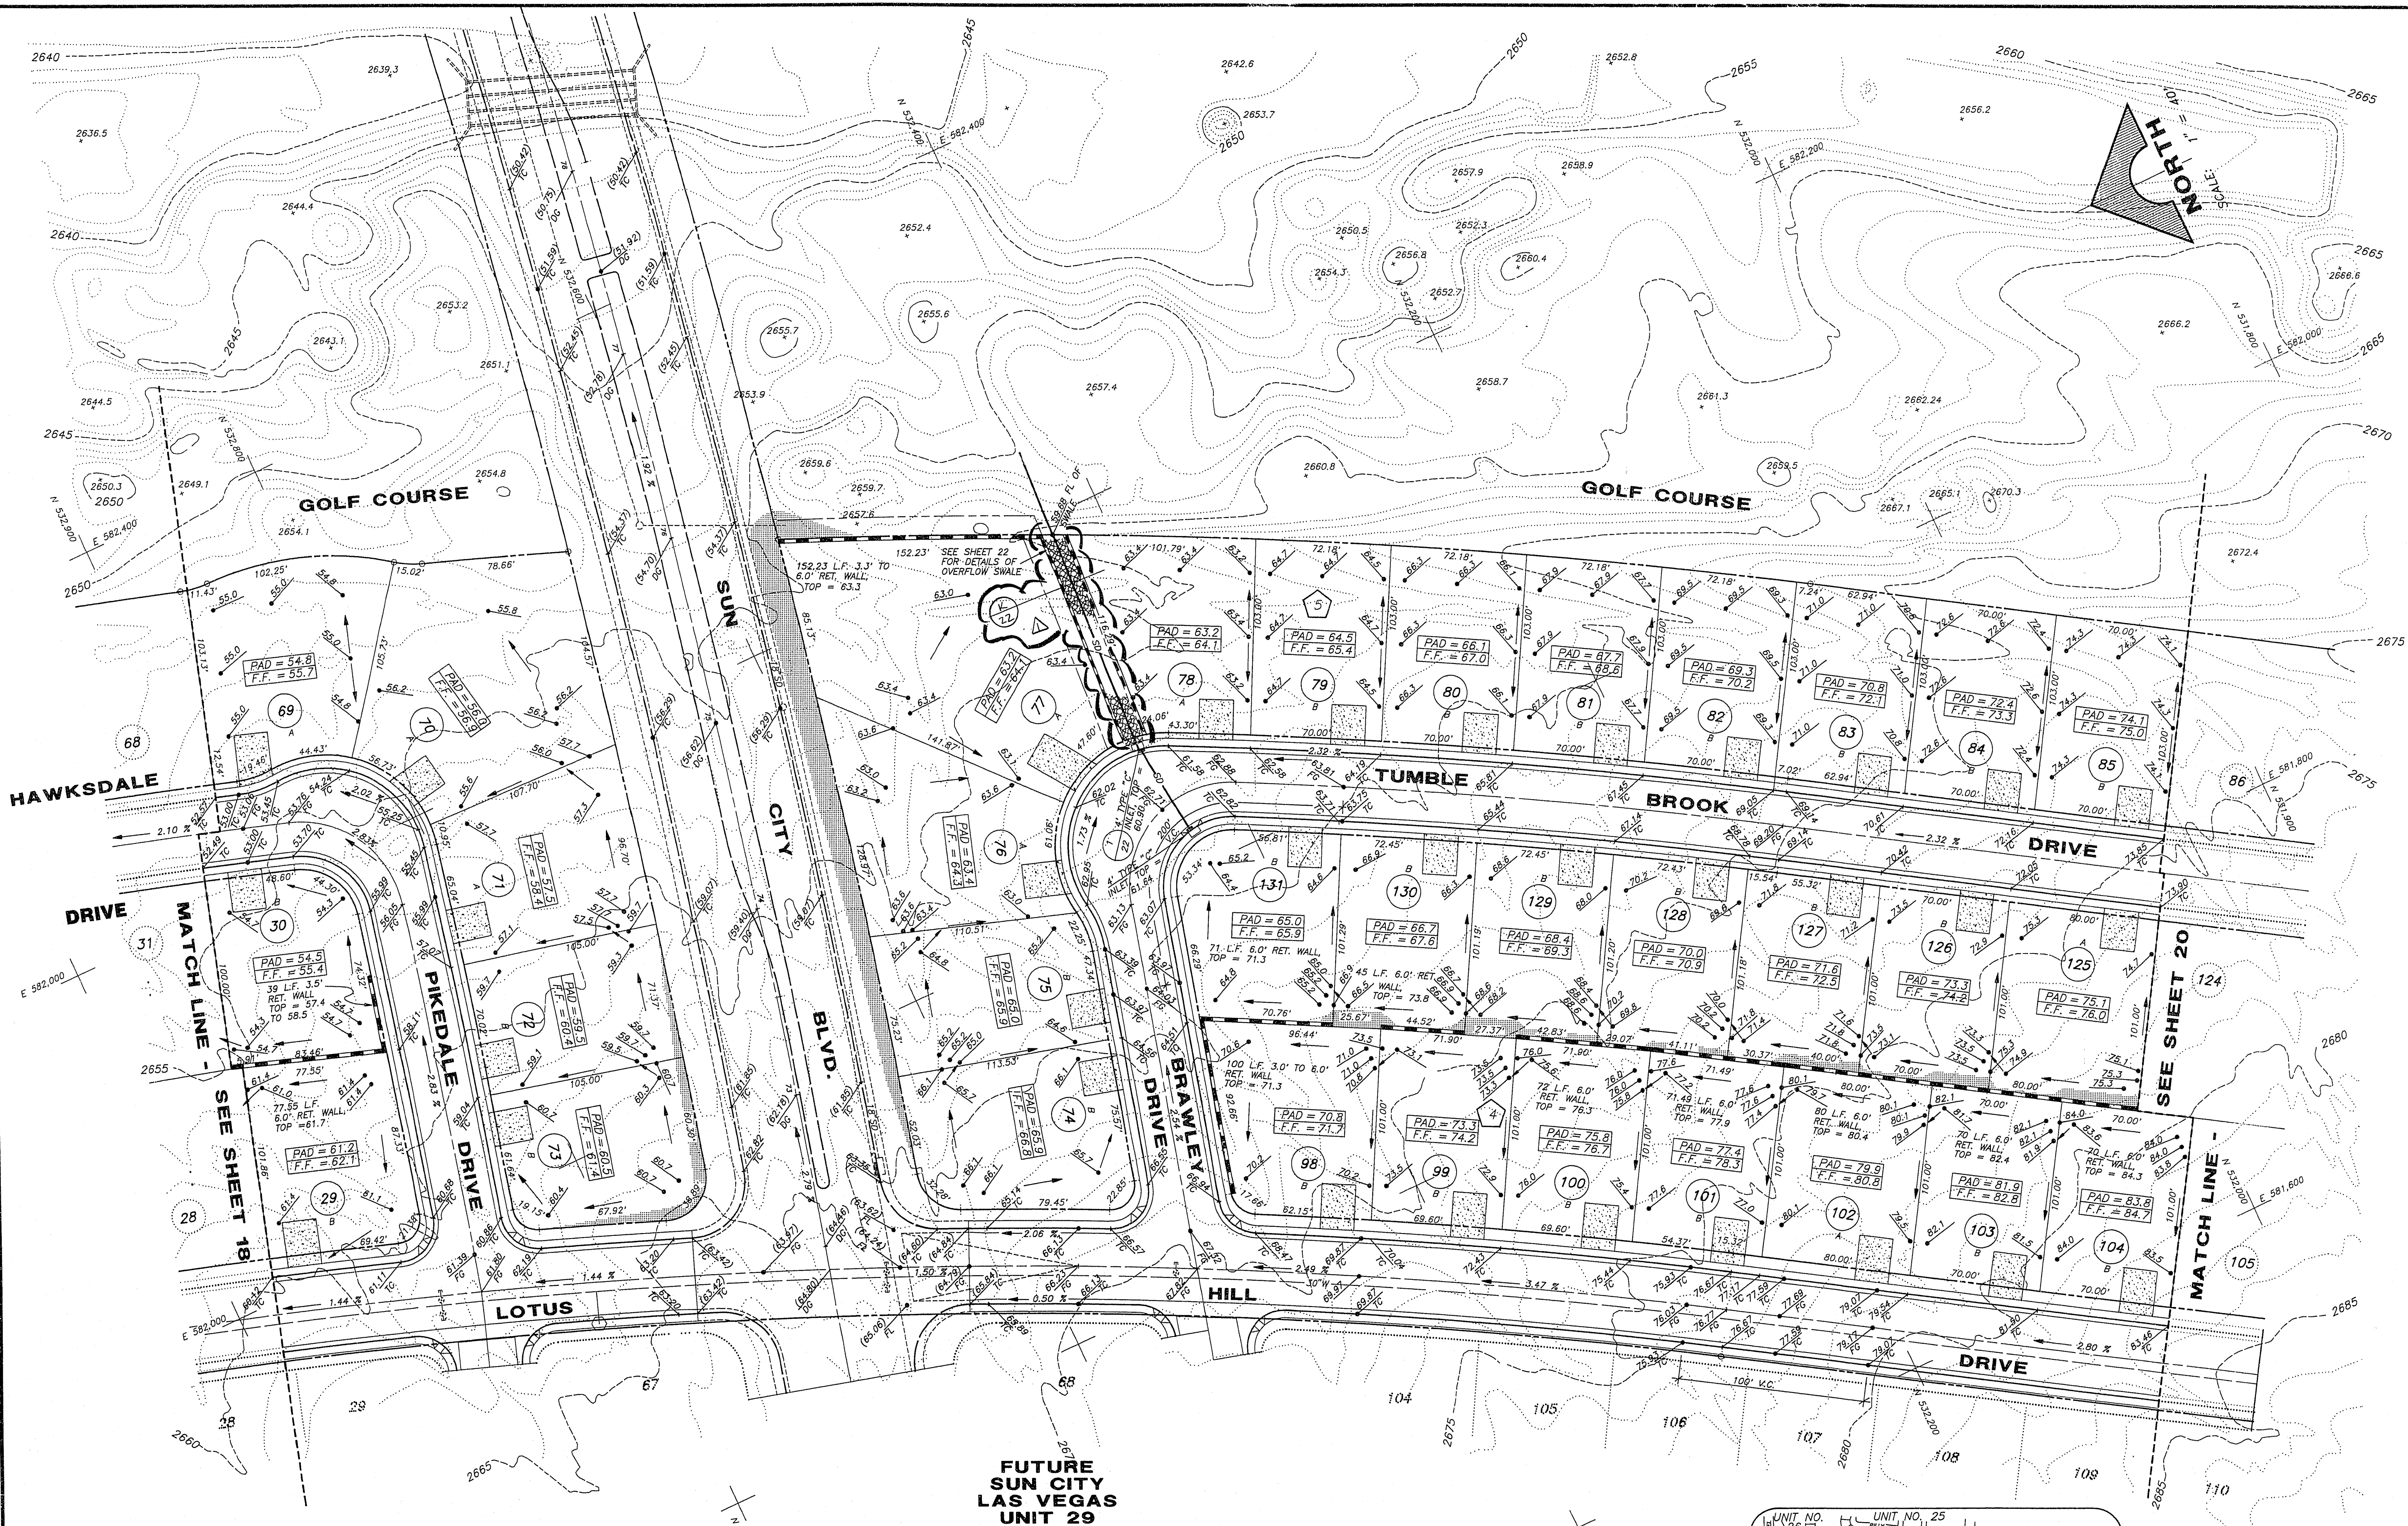


**FUTURE
SUN CITY
LAS VEGAS
UNIT 29**

NOTE:
COBBLE LINED SWALES TO BE MAINTAINED
BY THE SUN CITY HOMEOWNERS ASSOCIATION.

NOTE:
APPROVAL OF THESE GRADING PLANS DOES NOT
CONSTITUTE APPROVAL OF THE RETAINING WALLS.
ENGINEERING CALCULATIONS MUST BE FURNISHED
AND APPROVED BY THE DEPARTMENT OF
BUILDING AND SAFETY.

Call
before you
Dig.
1-800-227-2600
UNDERGROUND SERVICE (USA)

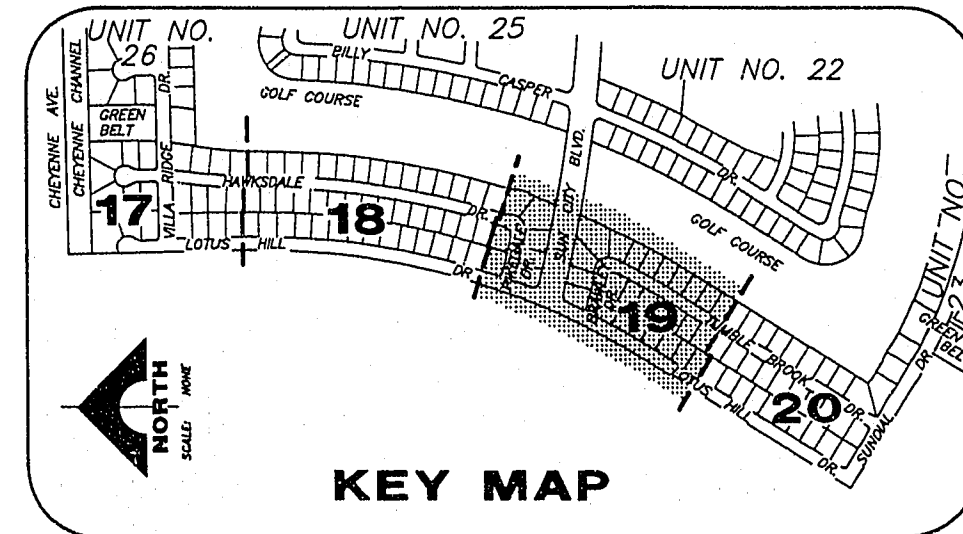

APPROVED FOR CONSTRUCTION

DEL WEBB COMMUNITIES, INC. DATE

DEL WEBB COMMUNITIES, INC.
SUN CITY LAS VEGAS UNIT NO. 29

GRADING PLAN III

SHEET
19
OF 23 SHEETS

G.C. WALLACE, INC.
Engineering/Architecture 1555 SOUTH RAINBOW BLVD., LAS VEGAS, NEVADA 89102

RECOMMENDED
DATE 9/1/91
BY 8443
DATE 8/15/91
PROJECT NO. 8443
SHEET NO. 19
SHEET TOTAL 23

DESCRIPTION
