

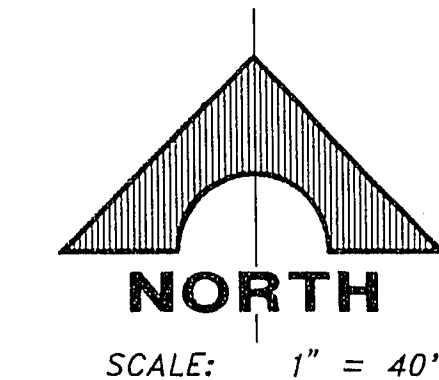


JOB NO. 701.108


PLOTTED: 07/02/91 10:30 am

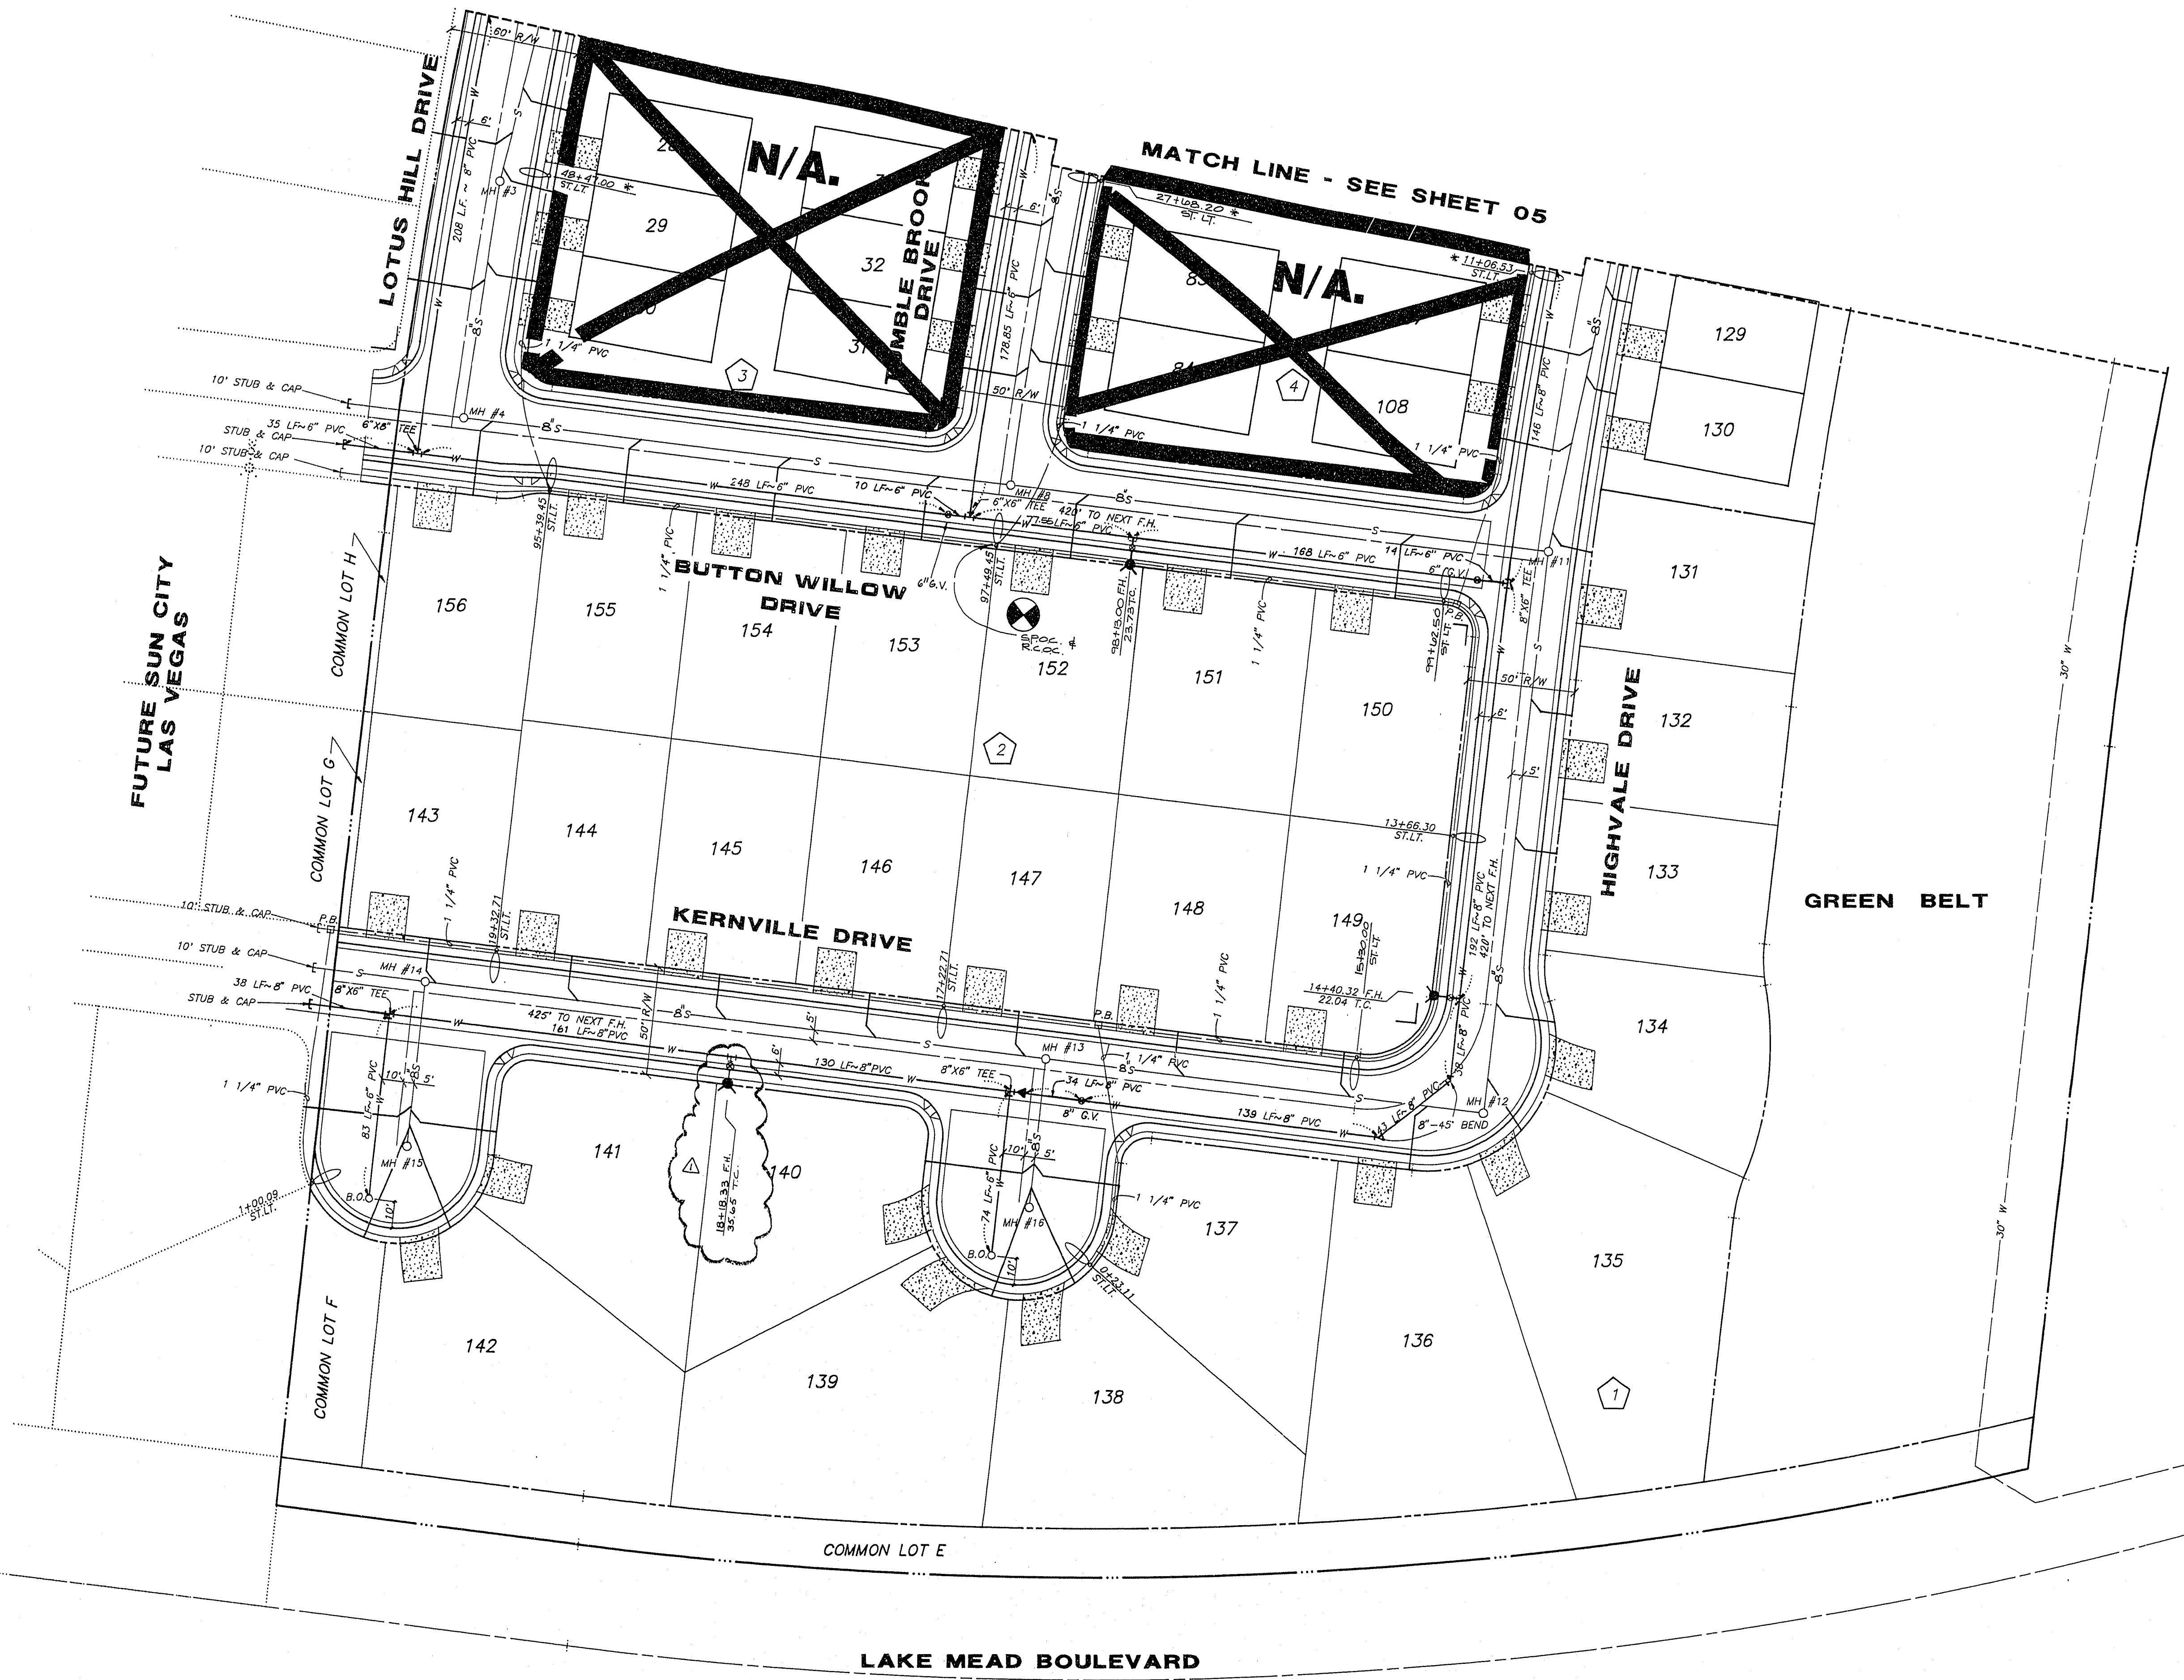

EXIST. SUN CITY LAS VEGAS UNIT NO. 23

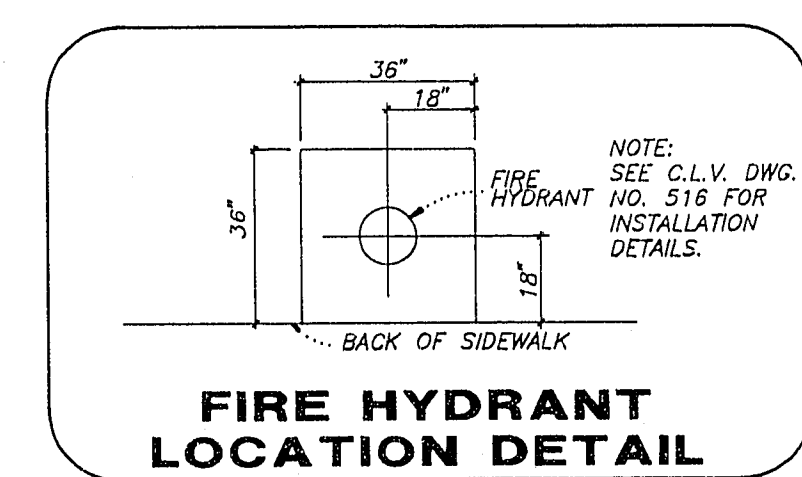

* NOTE: SEE AMENDED UNIT NO. 28 FOR CORRECT ST. LIT. & FH LOCATIONS FOR CONSTRUCTION.

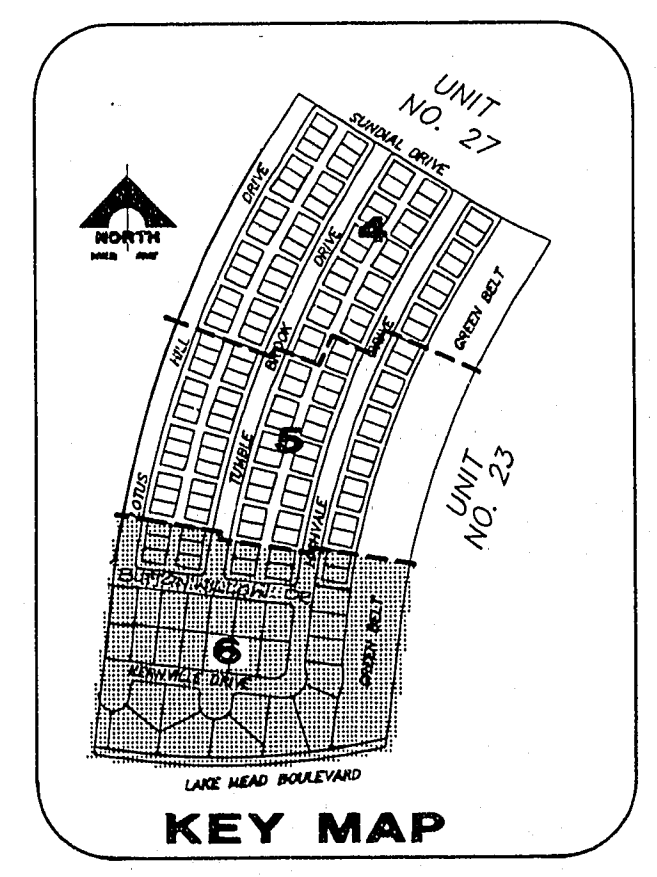

APPROVED FOR CONSTRUCTION
Louis B. [Signature] 12/4/91
 LAS VEGAS WATER DISTRICT DATE

APPROVED FOR CONSTRUCTION
 DEL WEBB COMMUNITIES, INC. DATE

REVISION	DATE	BY	DESCRIPTION
1	07/02/91	MB	RELEASED - FIELD SUBMITTAL

RECOMMENDED
 MICHAEL D. ROSS
 CIVIL ENGINEER
 STATE OF NEVADA
 LICENSE NO. 6787
 1555 SOUTH RAINBOW BLVD., LAS VEGAS, NEVADA 89102
G. C. WALLACE, INC.
 Engineering/Architecture

DEL WEBB COMMUNITIES, INC.
 SUN CITY LAS VEGAS UNIT NO. 28
UTILITY PLAN III
 SHEET
6
 OF 18 SHEETS

10-7-92 3074-441-28