







CURVE DATA

| NO. | Δ           | L       | T       |               |
|-----|-------------|---------|---------|---------------|
| 1   | 12° 48' 52" | 500.00' | 111.82' | 50.13' & RW   |
| 2   | 10° 05' 17" | 475.00' | 83.63'  | 41.92' & PVMT |

NOTES:

- STRUCTURAL SECTION OF STREET TO CONFORM TO STANDARD DRAWING NO. NA.
- OWNER AGREES THAT IF EXISTING NATIVE MATERIAL DOES NOT CONFORM TO SPECIFICATIONS FOR TYPE 1 BASE, OWNER WILL IMPORT TYPE 1 BASE FOR A.C. PAVEMENT.

STREET SECTION

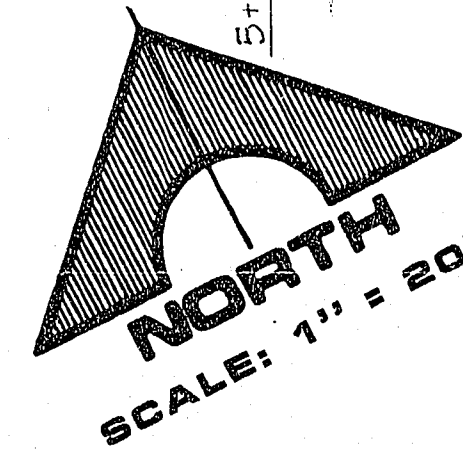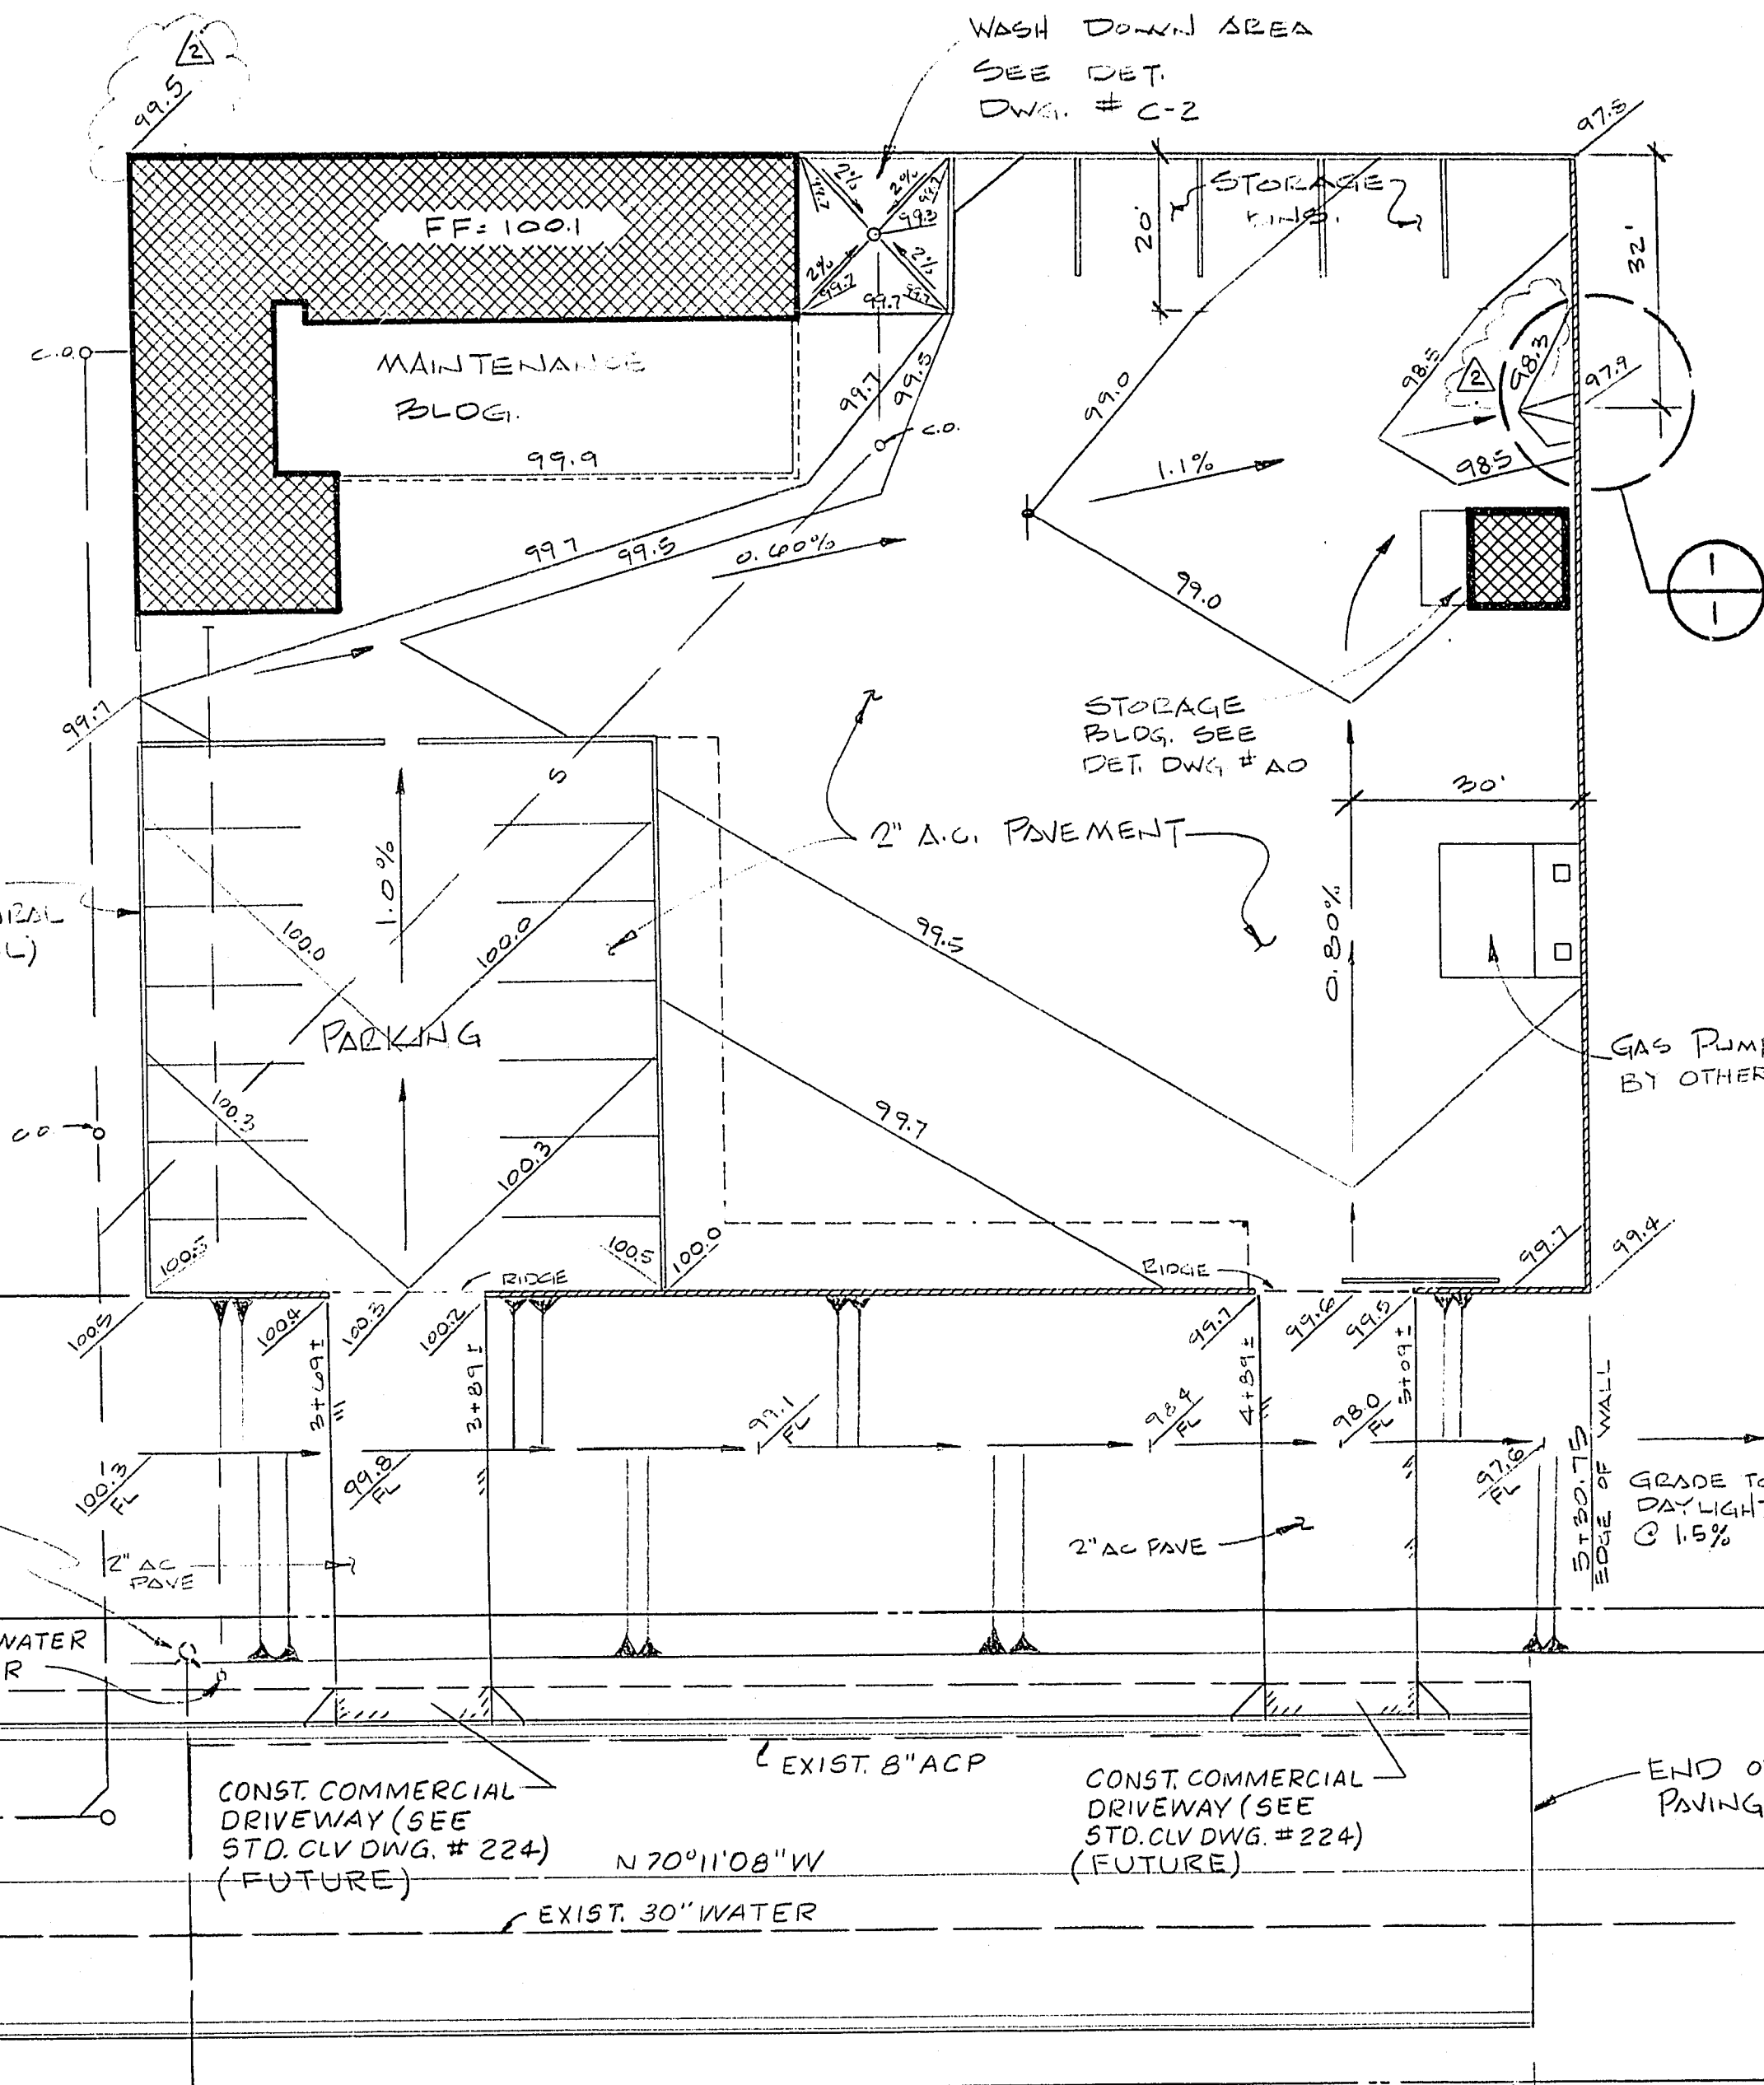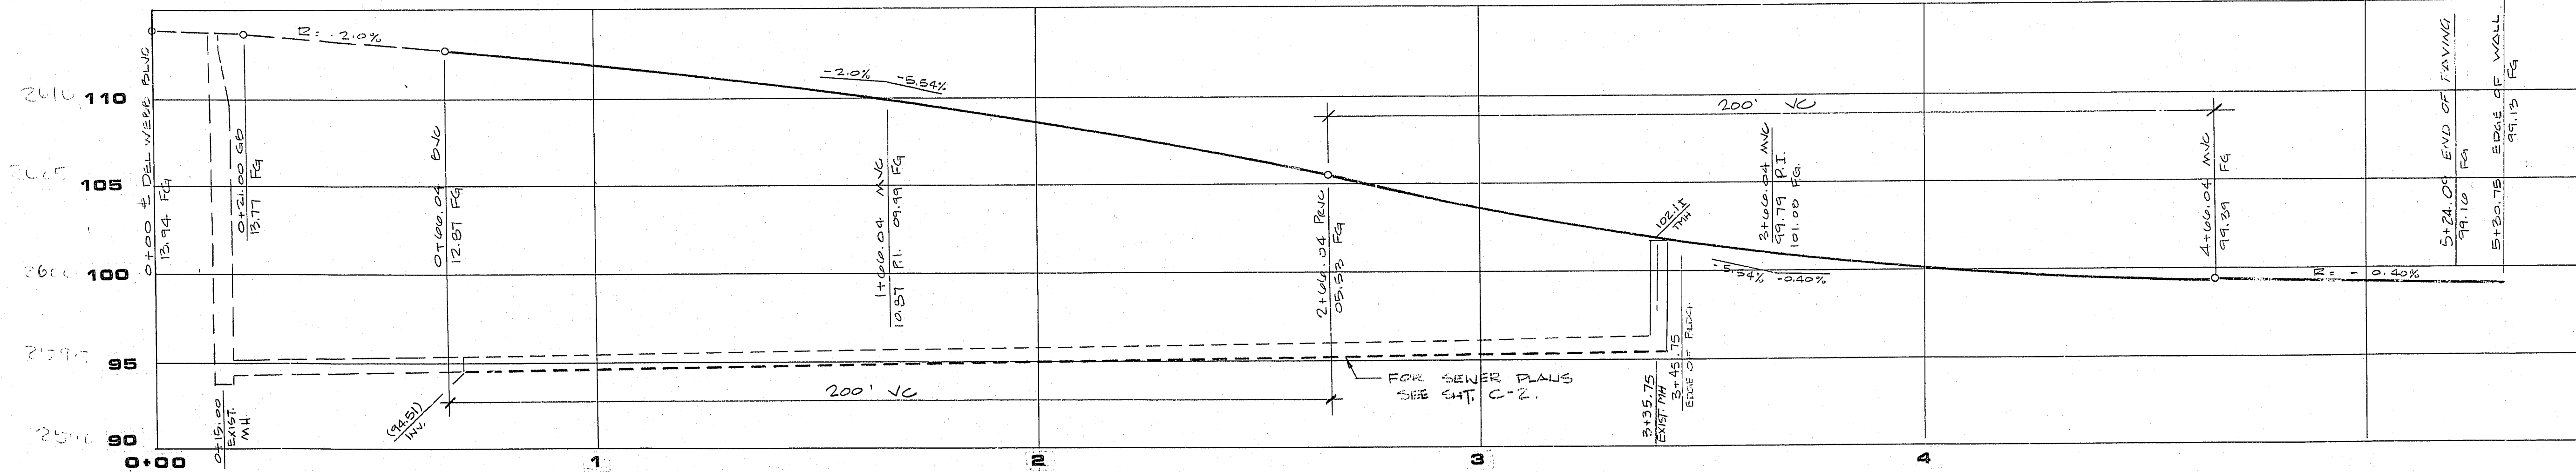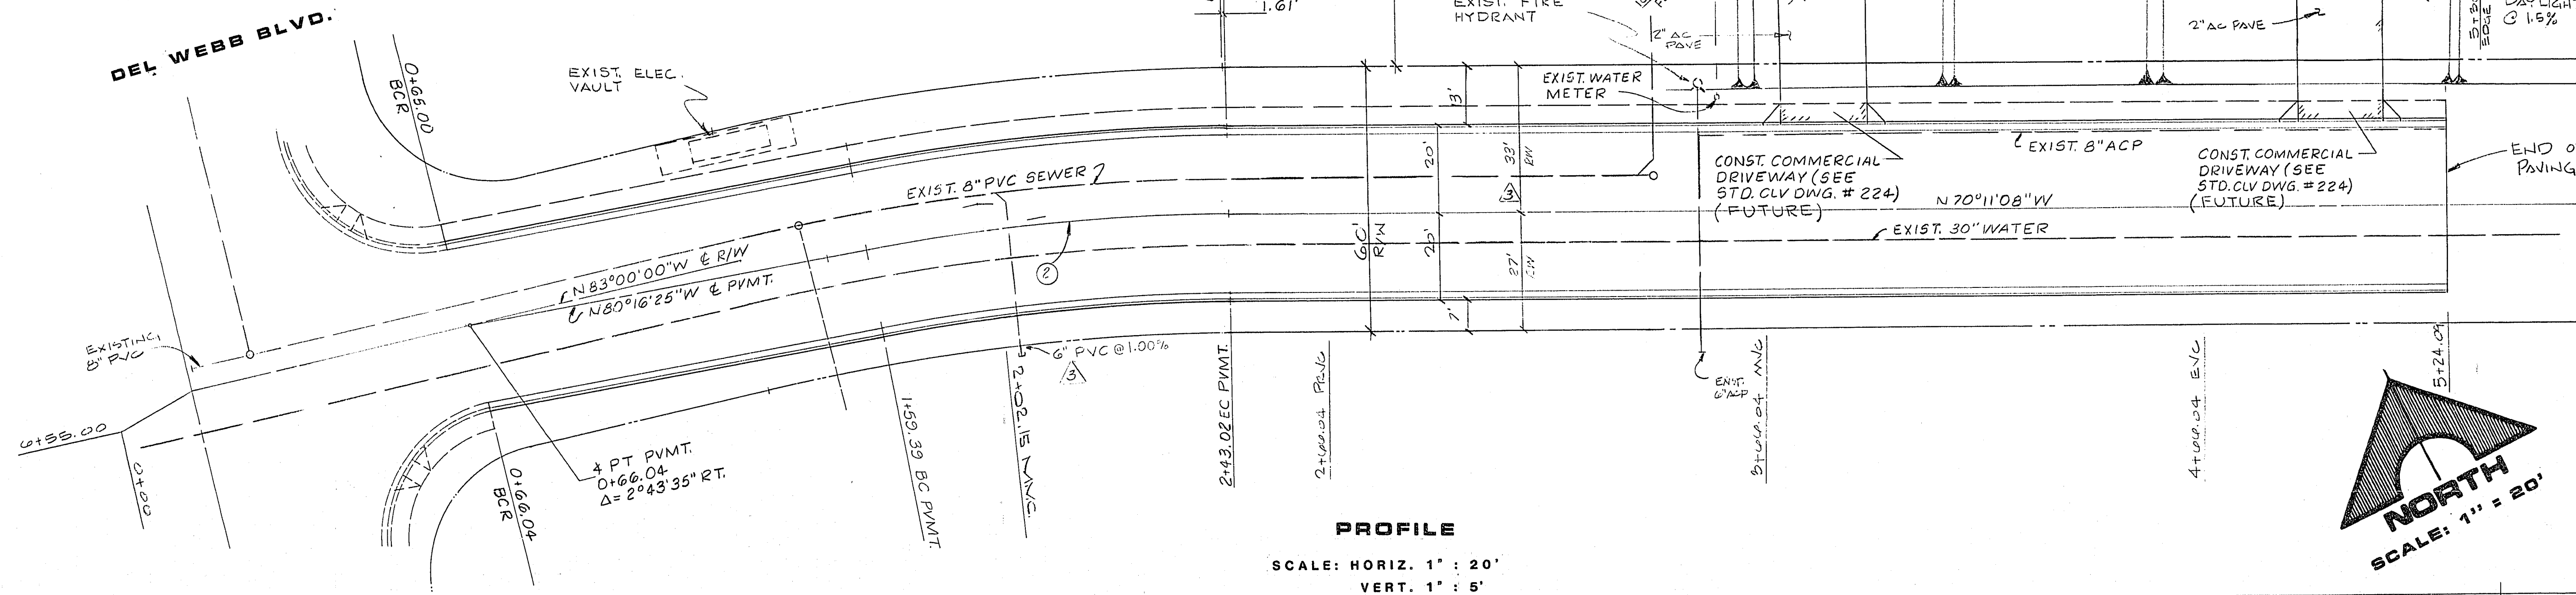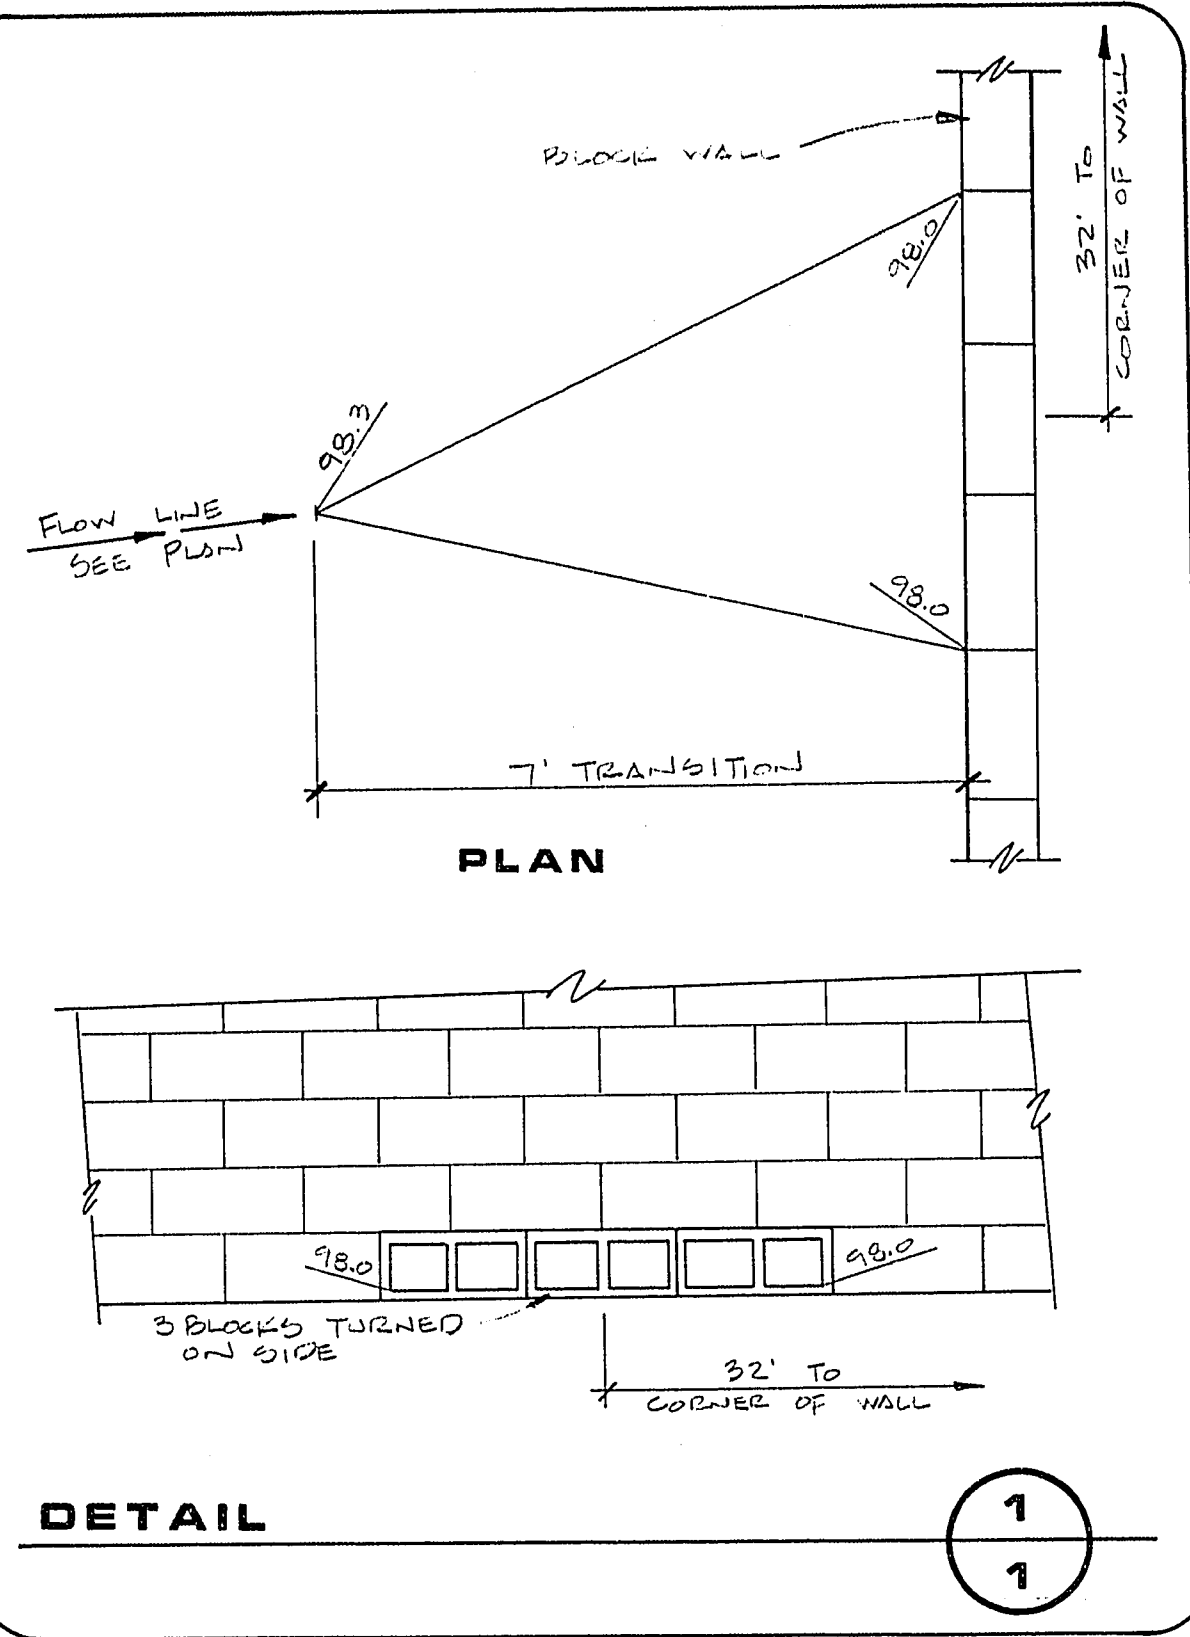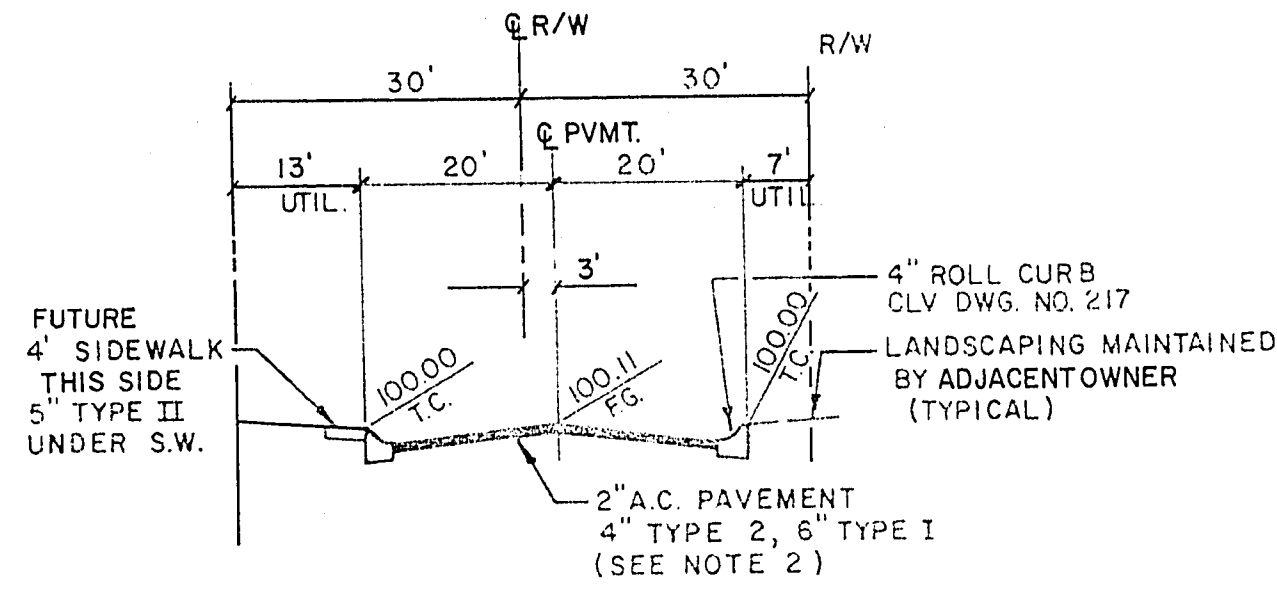

G.C. WALLACE, INC.  
Engineering/Architecture

DEL WEBB COMMUNITIES, INC.  
SUN CITY SUMMERLIN MAINTENANCE YARD  
STREET IMPROVEMENT & GRADING PLAN

SHEET

C-1

OF 17 SHEETS

| REV | DATE     | DESCRIPTION                  |
|-----|----------|------------------------------|

RECOMMENDED  
10/17/14  
R.E. NO. 10/17/14

1555 SOUTH RAINBOW BLVD. LAS VEGAS, NEVADA 89102

12-9-24

1074-4003-21