

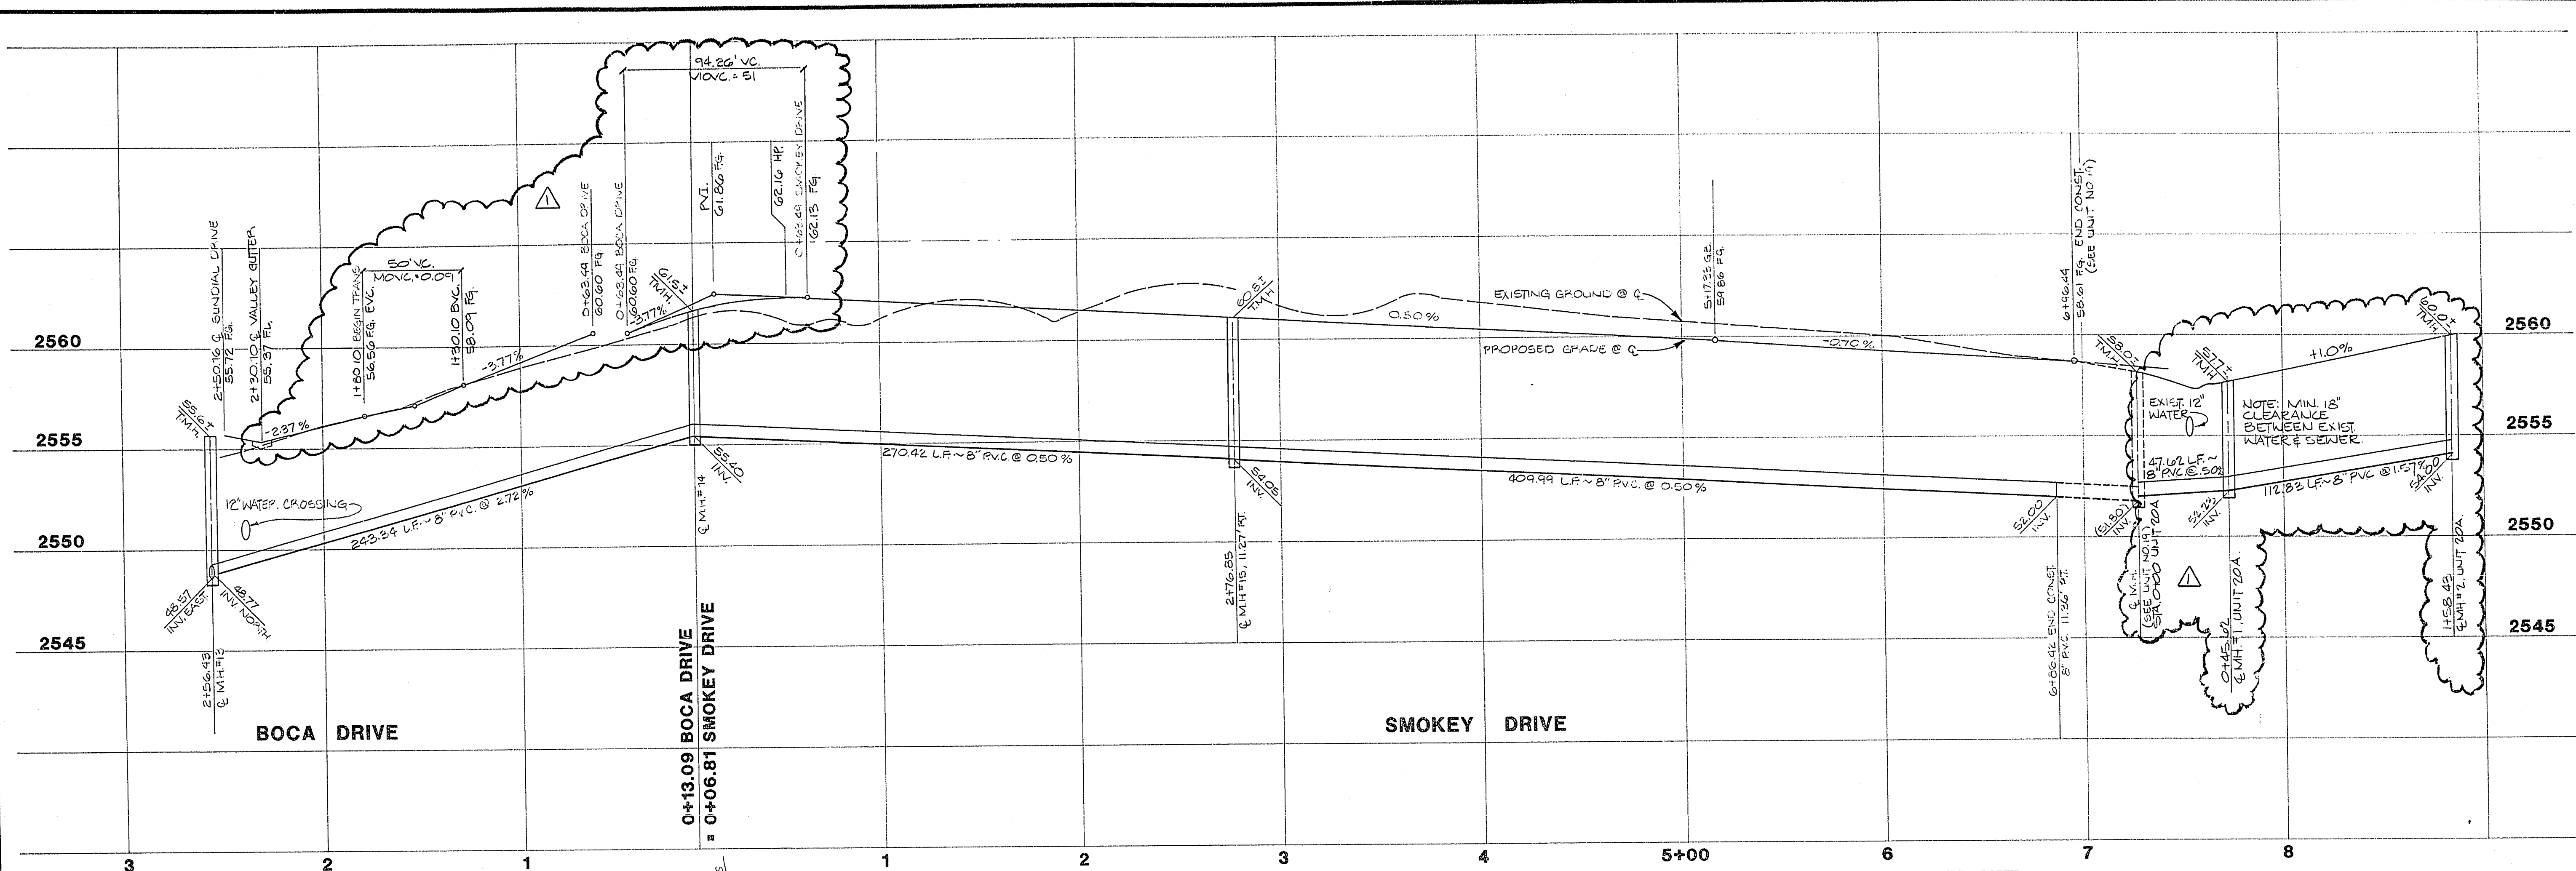
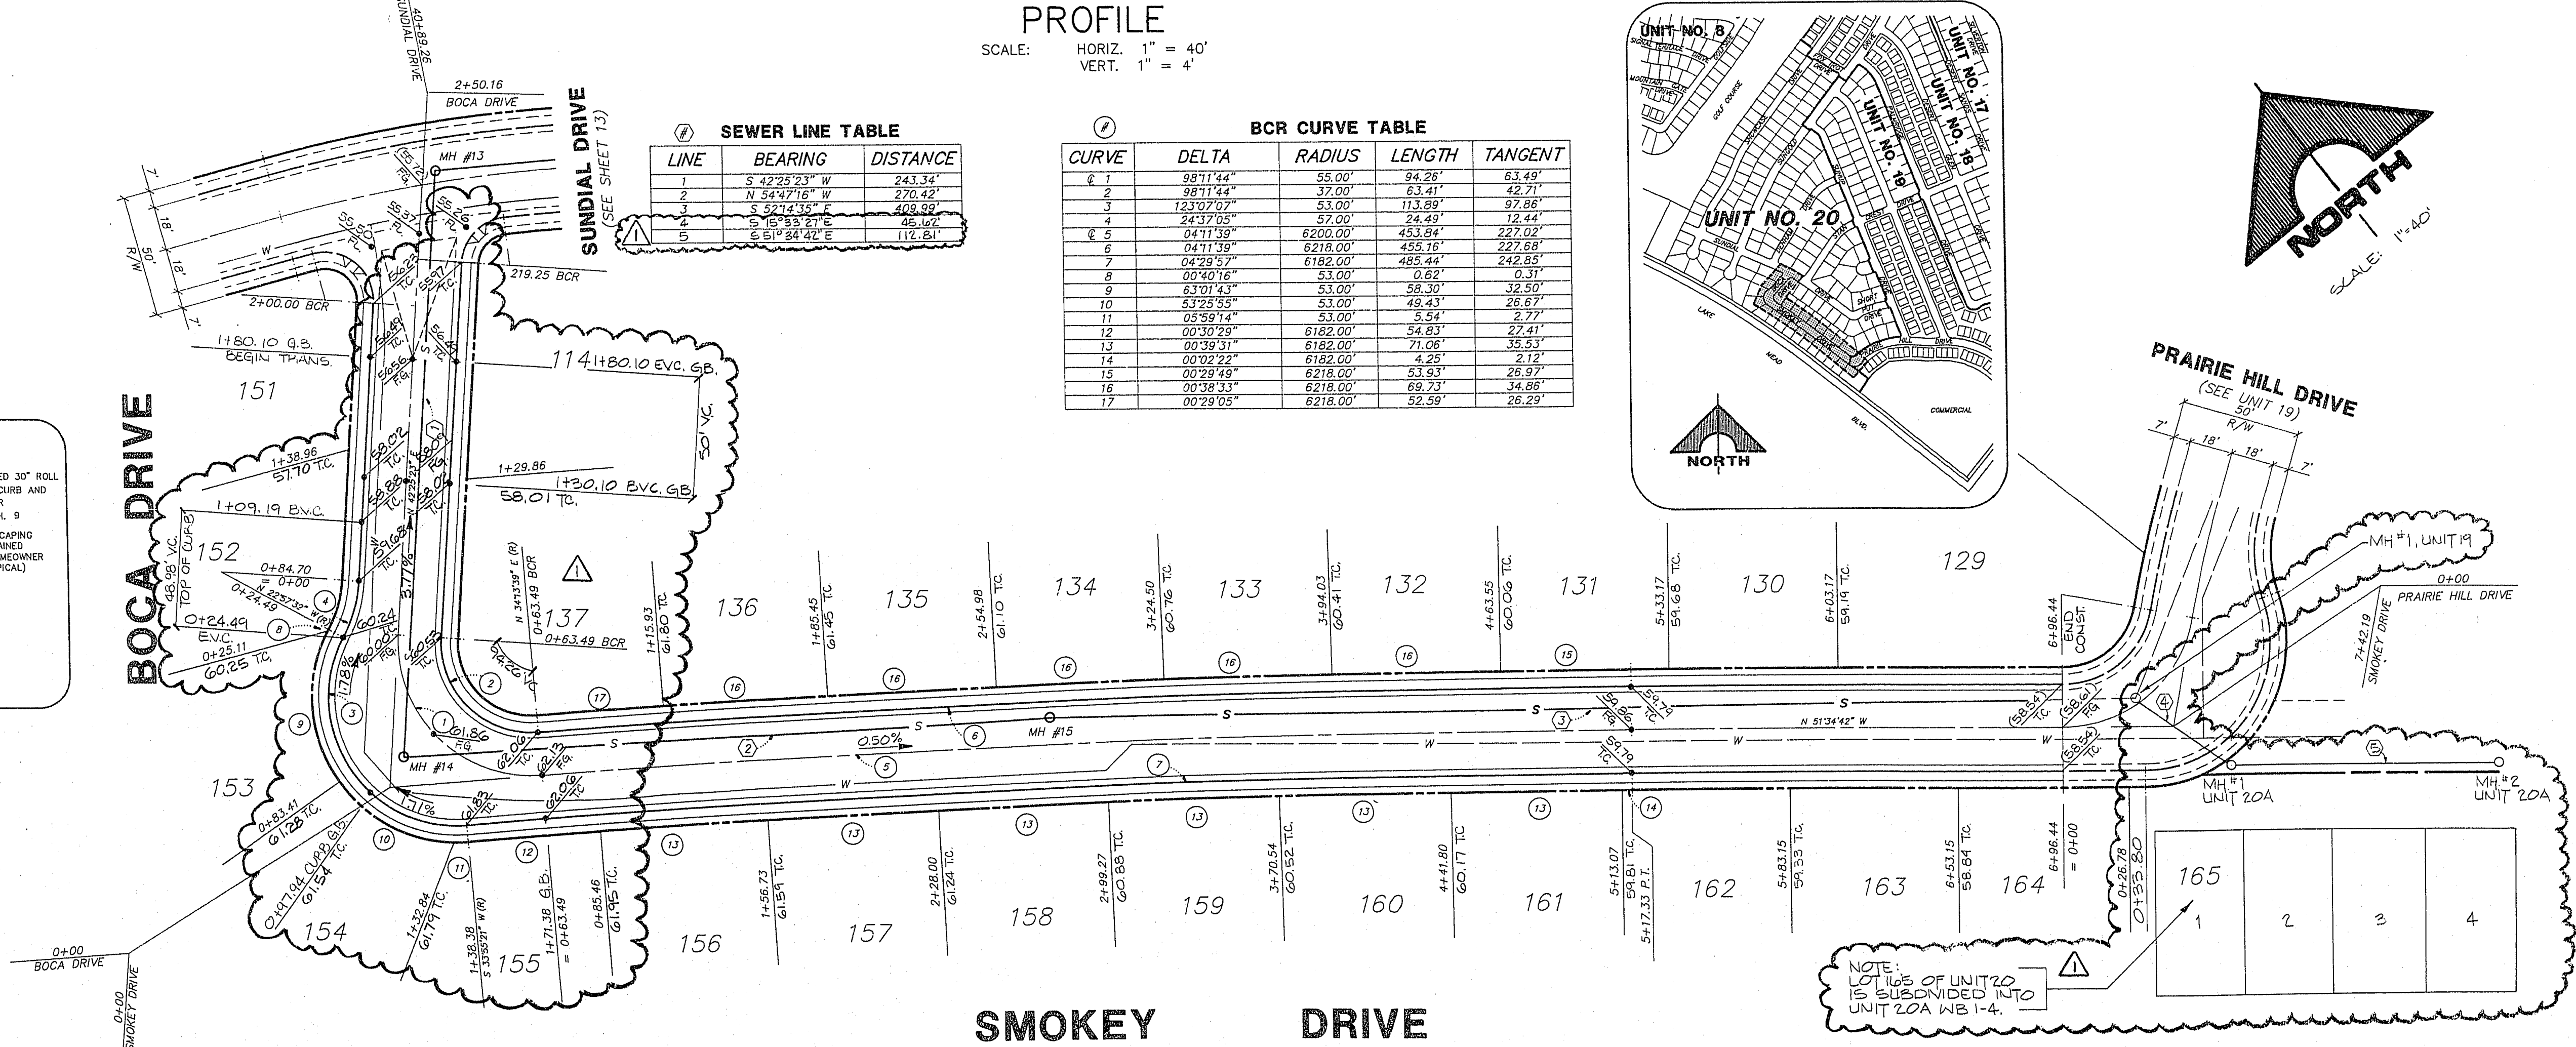
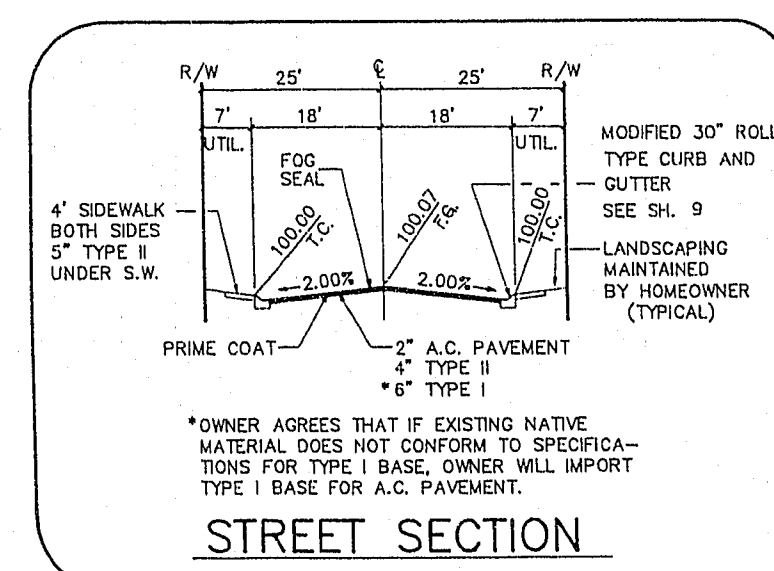


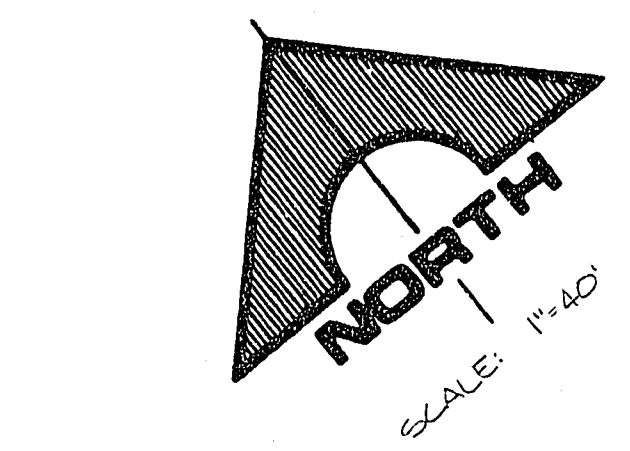

PROFILE  
SCALE: HORIZ. 1" = 40'  
VERT. 1" = 4'

| SEWER LINE TABLE |               |          |
|------------------|---------------|----------|
| LINE             | BEARING       | DISTANCE |
| 1                | S 42°25'23" W | 243.34'  |
| 2                | N 54°47'16" W | 270.42'  |

| BCR CURVE TABLE |            |          |         |         |
|-----------------|------------|----------|---------|---------|
| CURVE           | DELTA      | RADIUS   | LENGTH  | TANGENT |
| 5               | 04°11'39"  | 6200.00' | 453.94' | 227.02' |
| 6               | 04°11'39"  | 6218.00' | 455.16' | 227.68' |
| 7               | 04°29'57"  | 6182.00' | 485.44' | 242.85' |
| 8               | 00°40'16"  | 53.00'   | 0.62'   | 0.31'   |
| 9               | 63°01'43"  | 53.00'   | 56.30'  | 32.50'  |
| 10              | 53°25'55"  | 53.00'   | 49.43'  | 26.67'  |
| 11              | 05°59'14"  | 53.00'   | 5.54'   | 2.77'   |
| 12              | 00°30'29"  | 6182.00' | 54.63'  | 27.41'  |
| 13              | 00°39'31"  | 6182.00' | 71.08'  | 35.53'  |
| 14              | 00°02'22"  | 6182.00' | 4.25'   | 2.12'   |
| 15              | 00°29'49"  | 6218.00' | 53.93'  | 26.97'  |
| 16              | 00°38'33"  | 6218.00' | 69.73'  | 34.66'  |
| 17              | 00°29'05"  | 6218.00' | 52.58'  | 26.29'  |

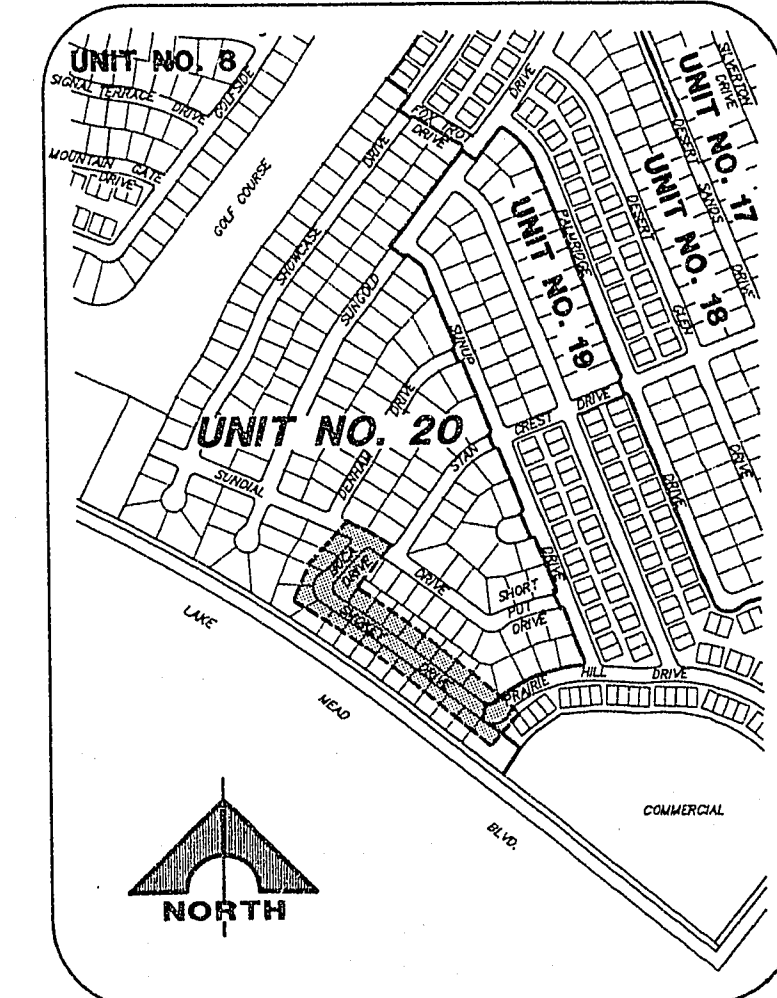

|             |          |                                                                                    |
|-------------|----------|------------------------------------------------------------------------------------|
| RECOMMENDED | DATE     | DESCRIPTION                                                                        |
| REV         | DATE     | DESCRIPTION                                                                        |

155 SOUTH RAINBOW BLVD LAS VEGAS, NEVADA 89102

G.C. WALLACE, INC.  
Engineering/Architecture

DEL E. WEBB COMMUNITIES, INC.  
SUN CITY SUMMERLIN UNIT NO. 20  
SMOKEY DRIVE &  
BOCA DRIVE

SHEET  
15  
OF 20 SHEETS

12-9-50