
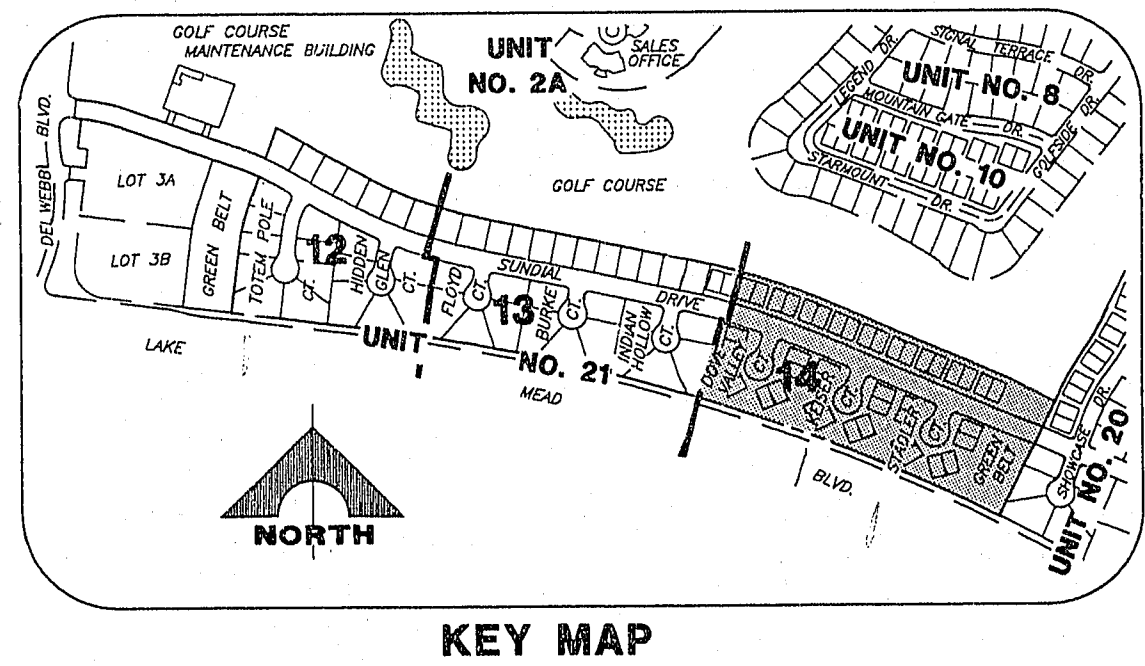
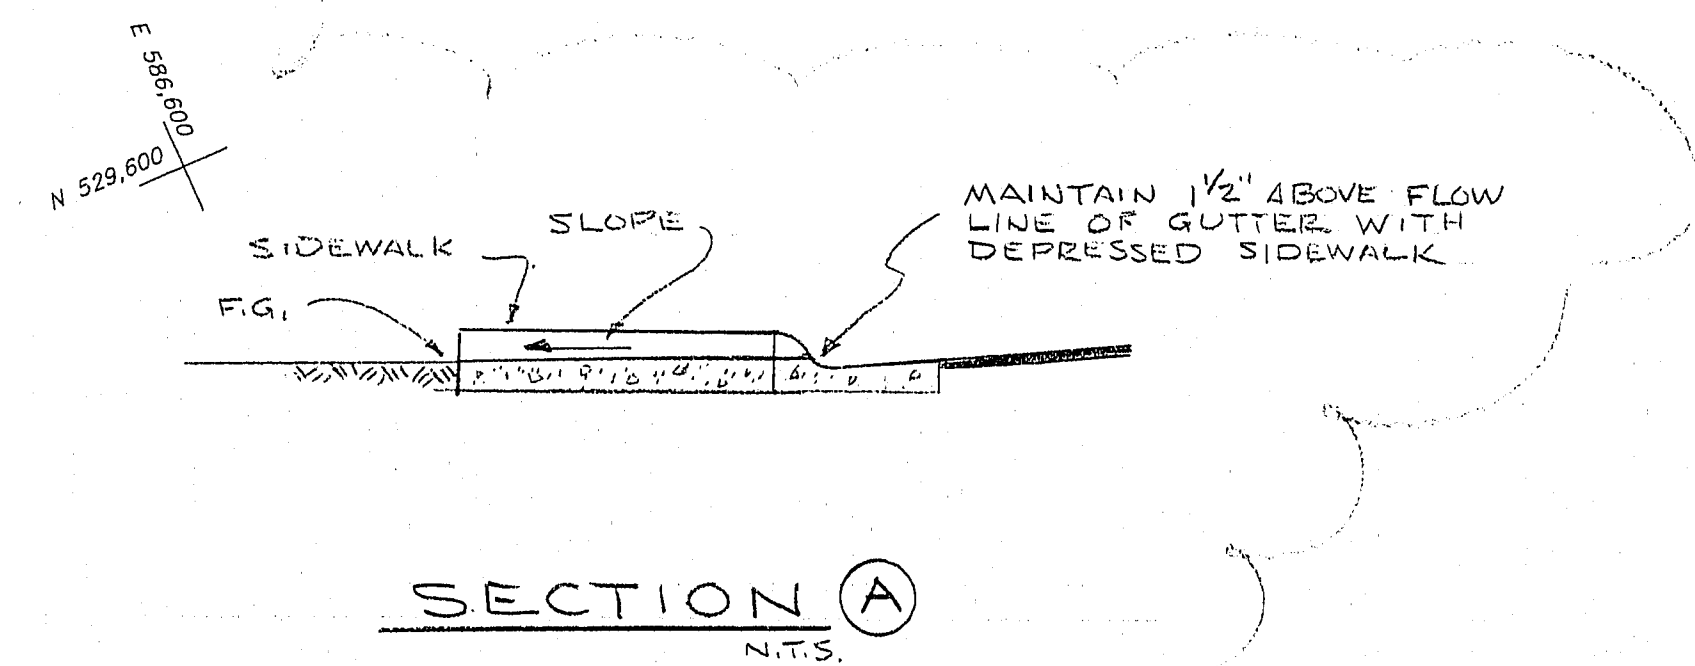
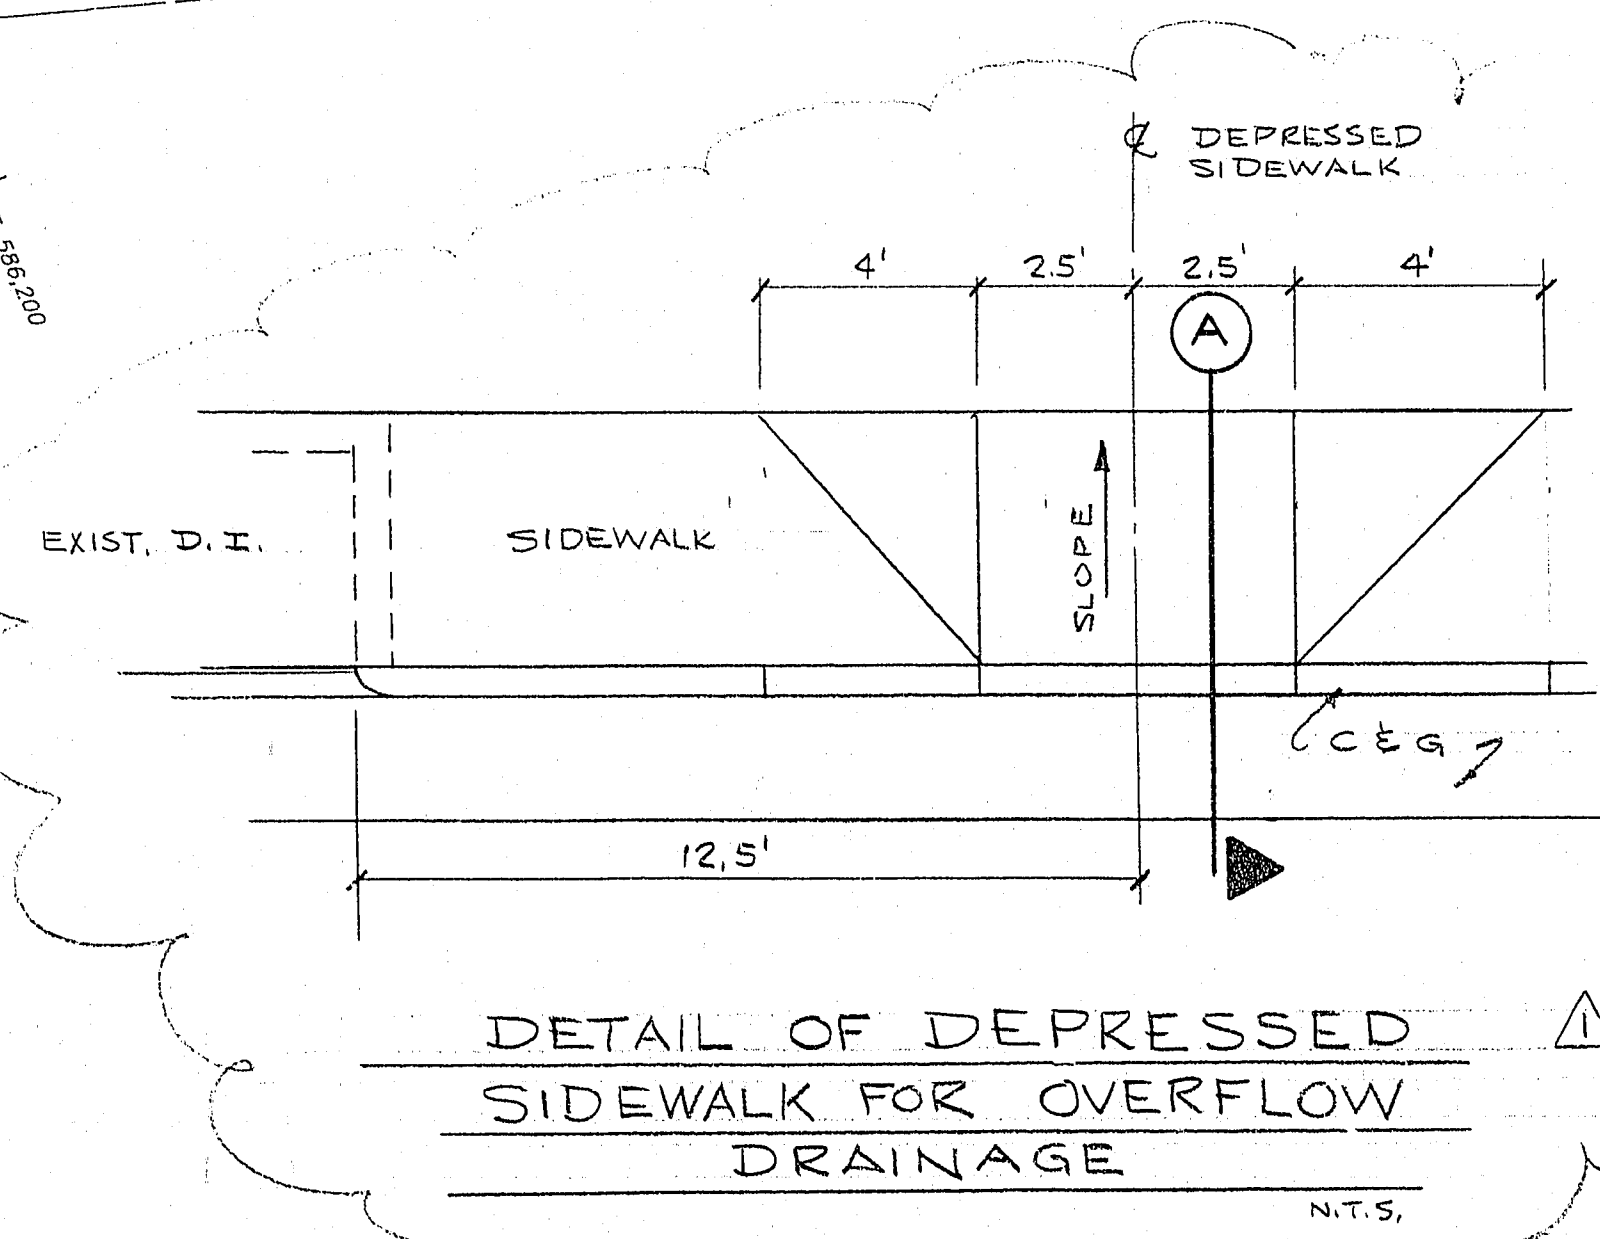


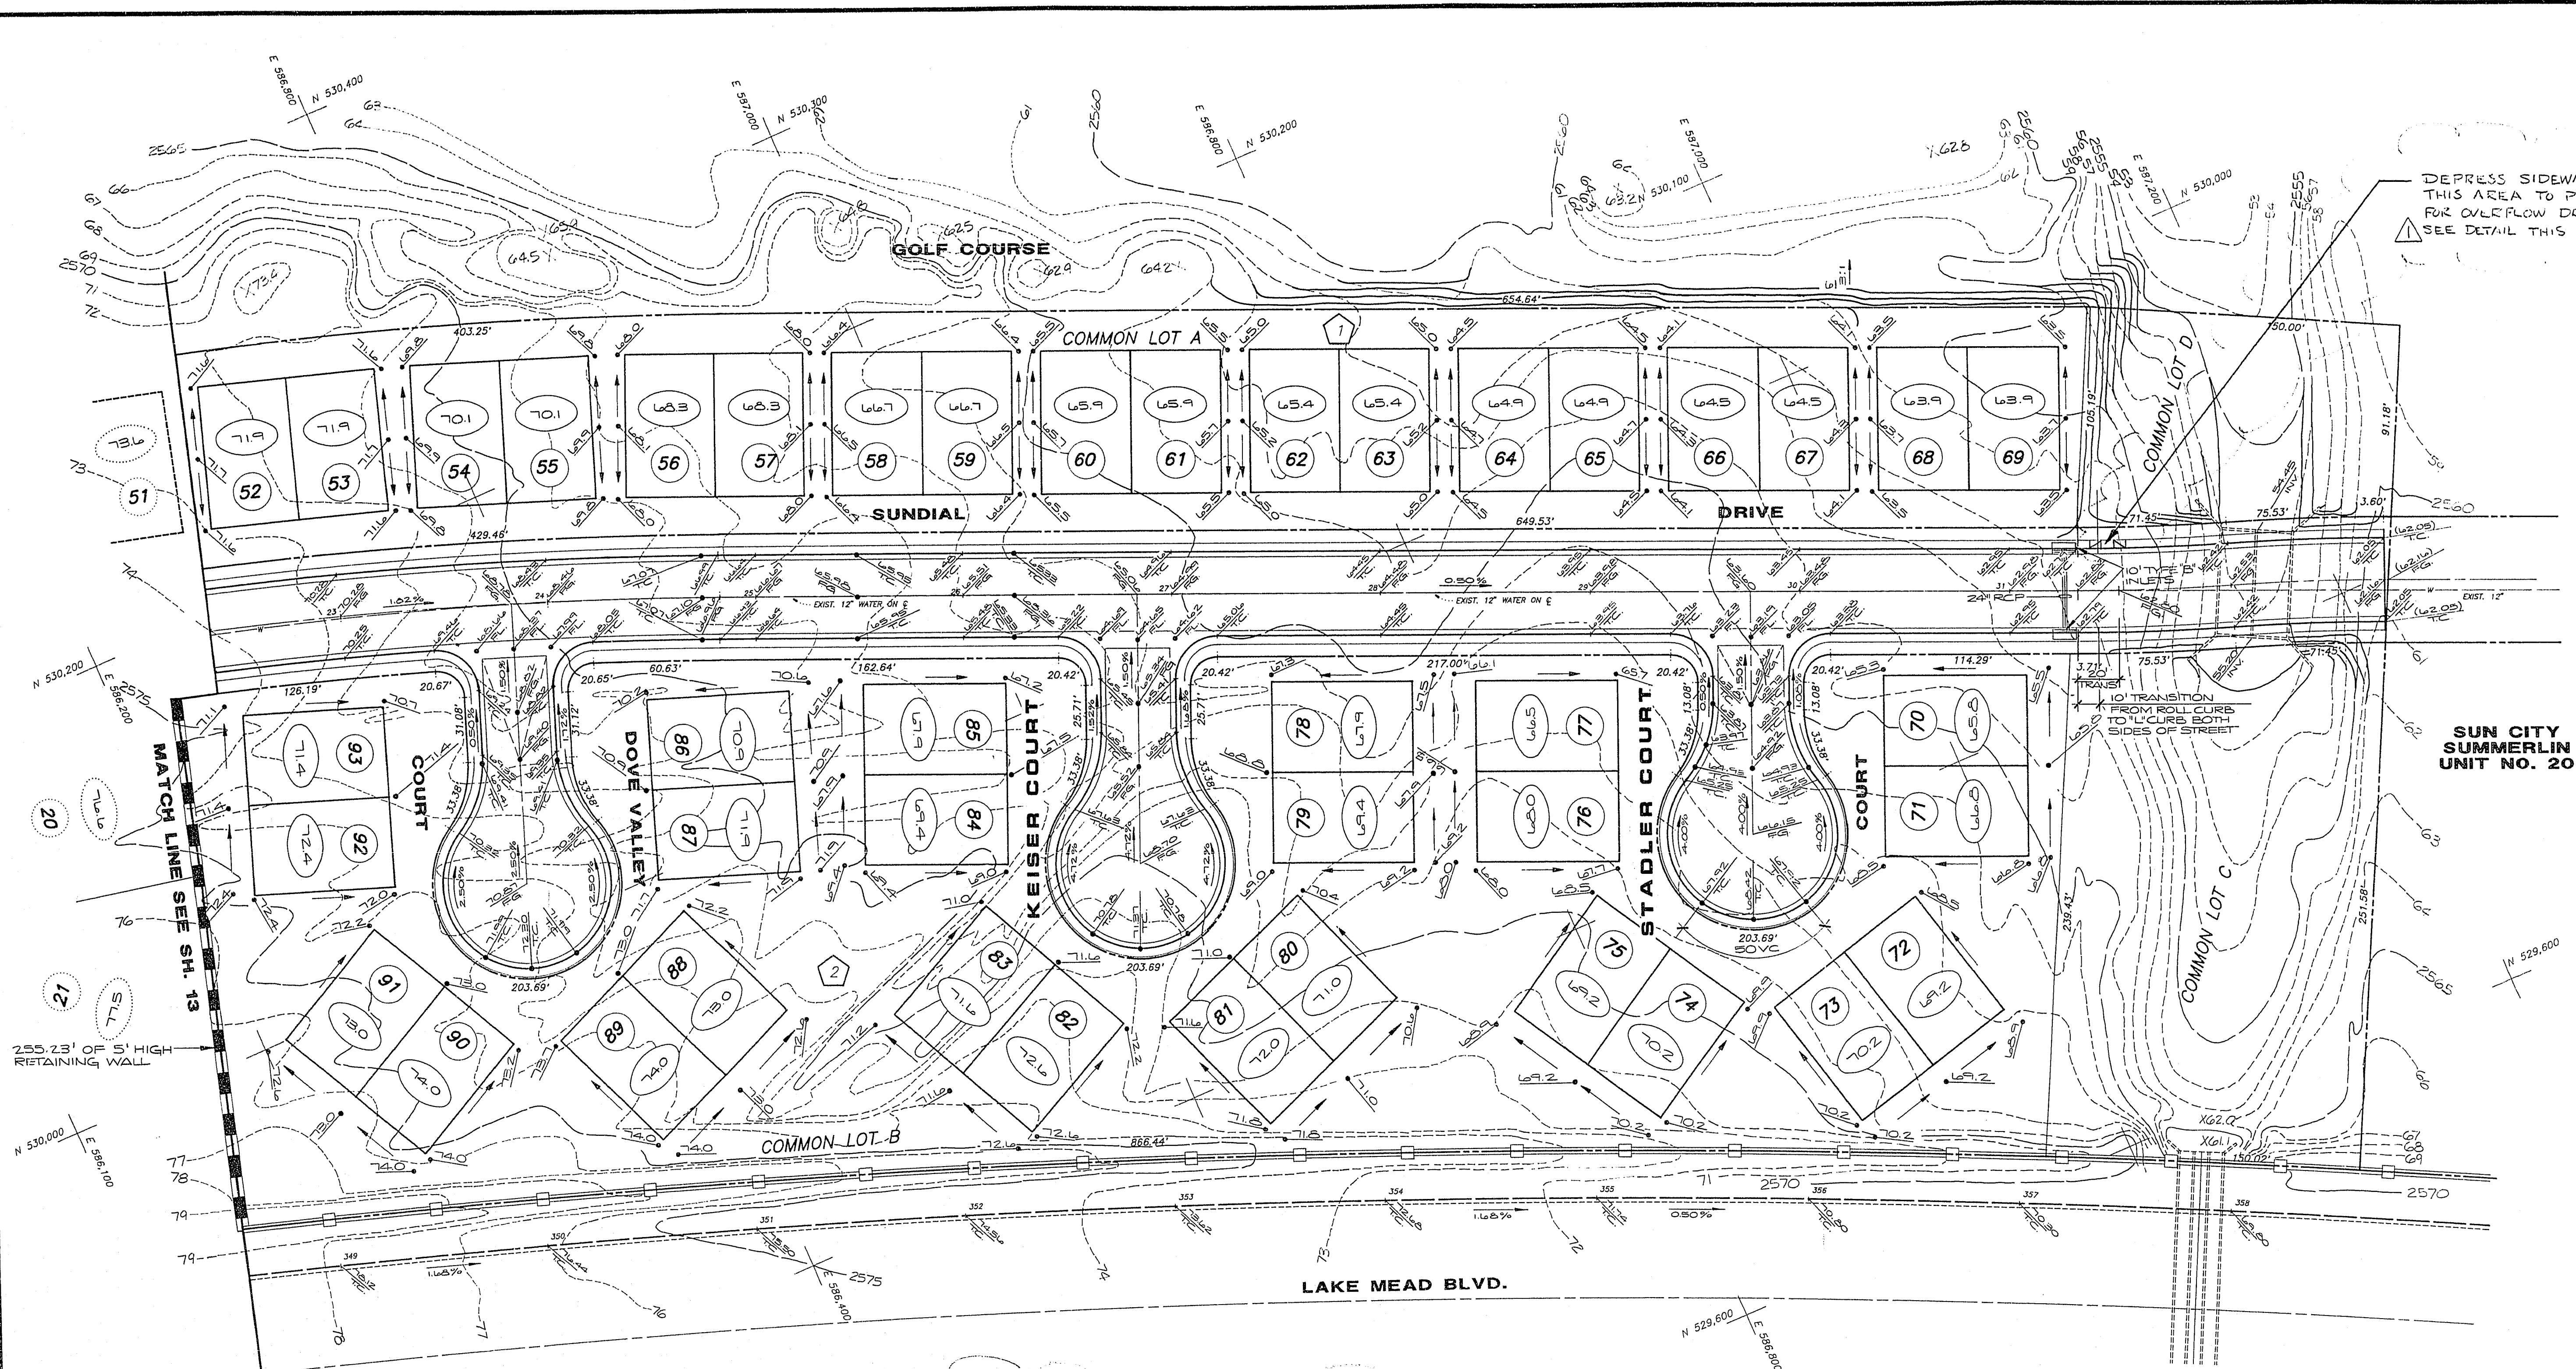

REVISION	DATE	DESCRIPTION
1	12/18/18	ADDED DEPRESSED SIDEWALK
RECOMMENDED BY: MICHAEL D. ROSS
DATE: 12/18/18
PROJECT: SUN CITY SUMMERLIN UNIT NO. 20
SHEET: 14 OF 17 SHEETS

G.C. WALLACE, INC.
Engineering/Architecture

DEL E. WEBB COMMUNITIES, INC.
SUN CITY SUMMERLIN UNIT NO. 21
GRADING PLAN III

12-9-28 109Y-4003-21