
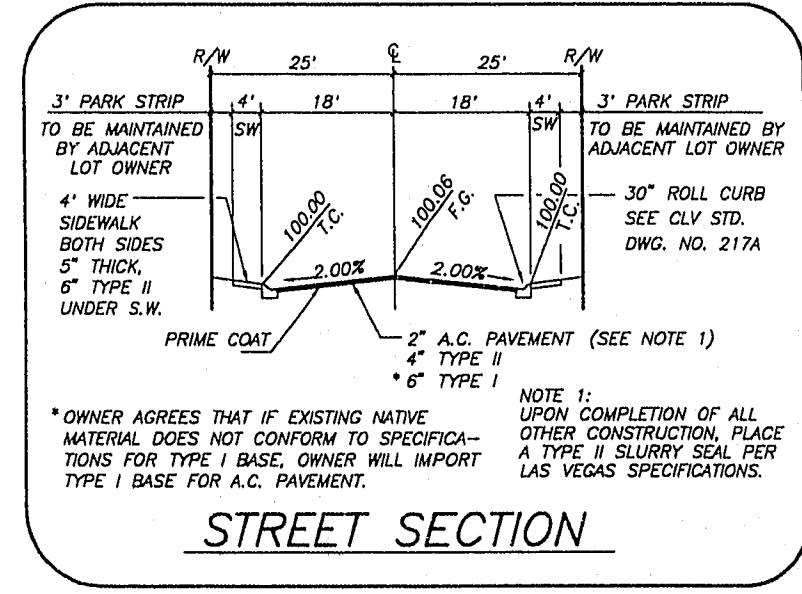
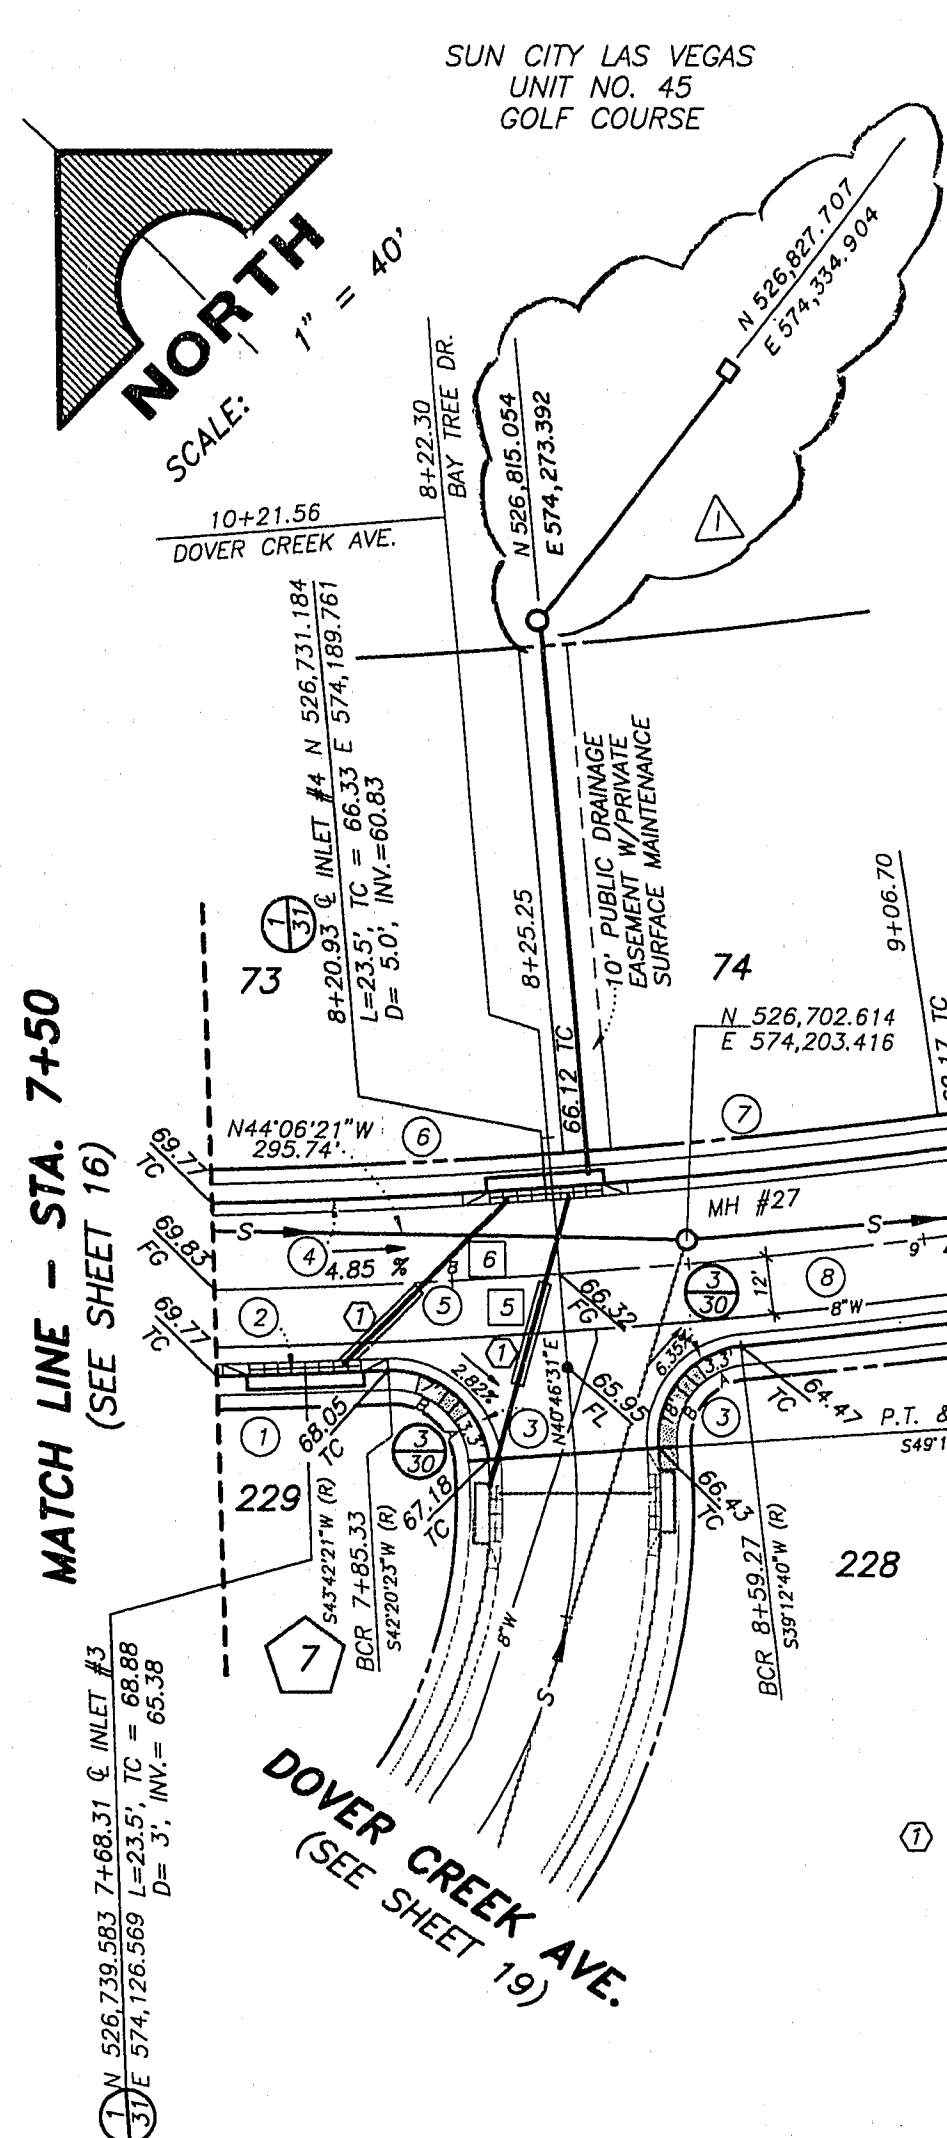


JOB NO. 701.244 PLOTTED 07/05/96 10:27 am DRAWING: C:\91\PLANS\149-17 BP: cfp

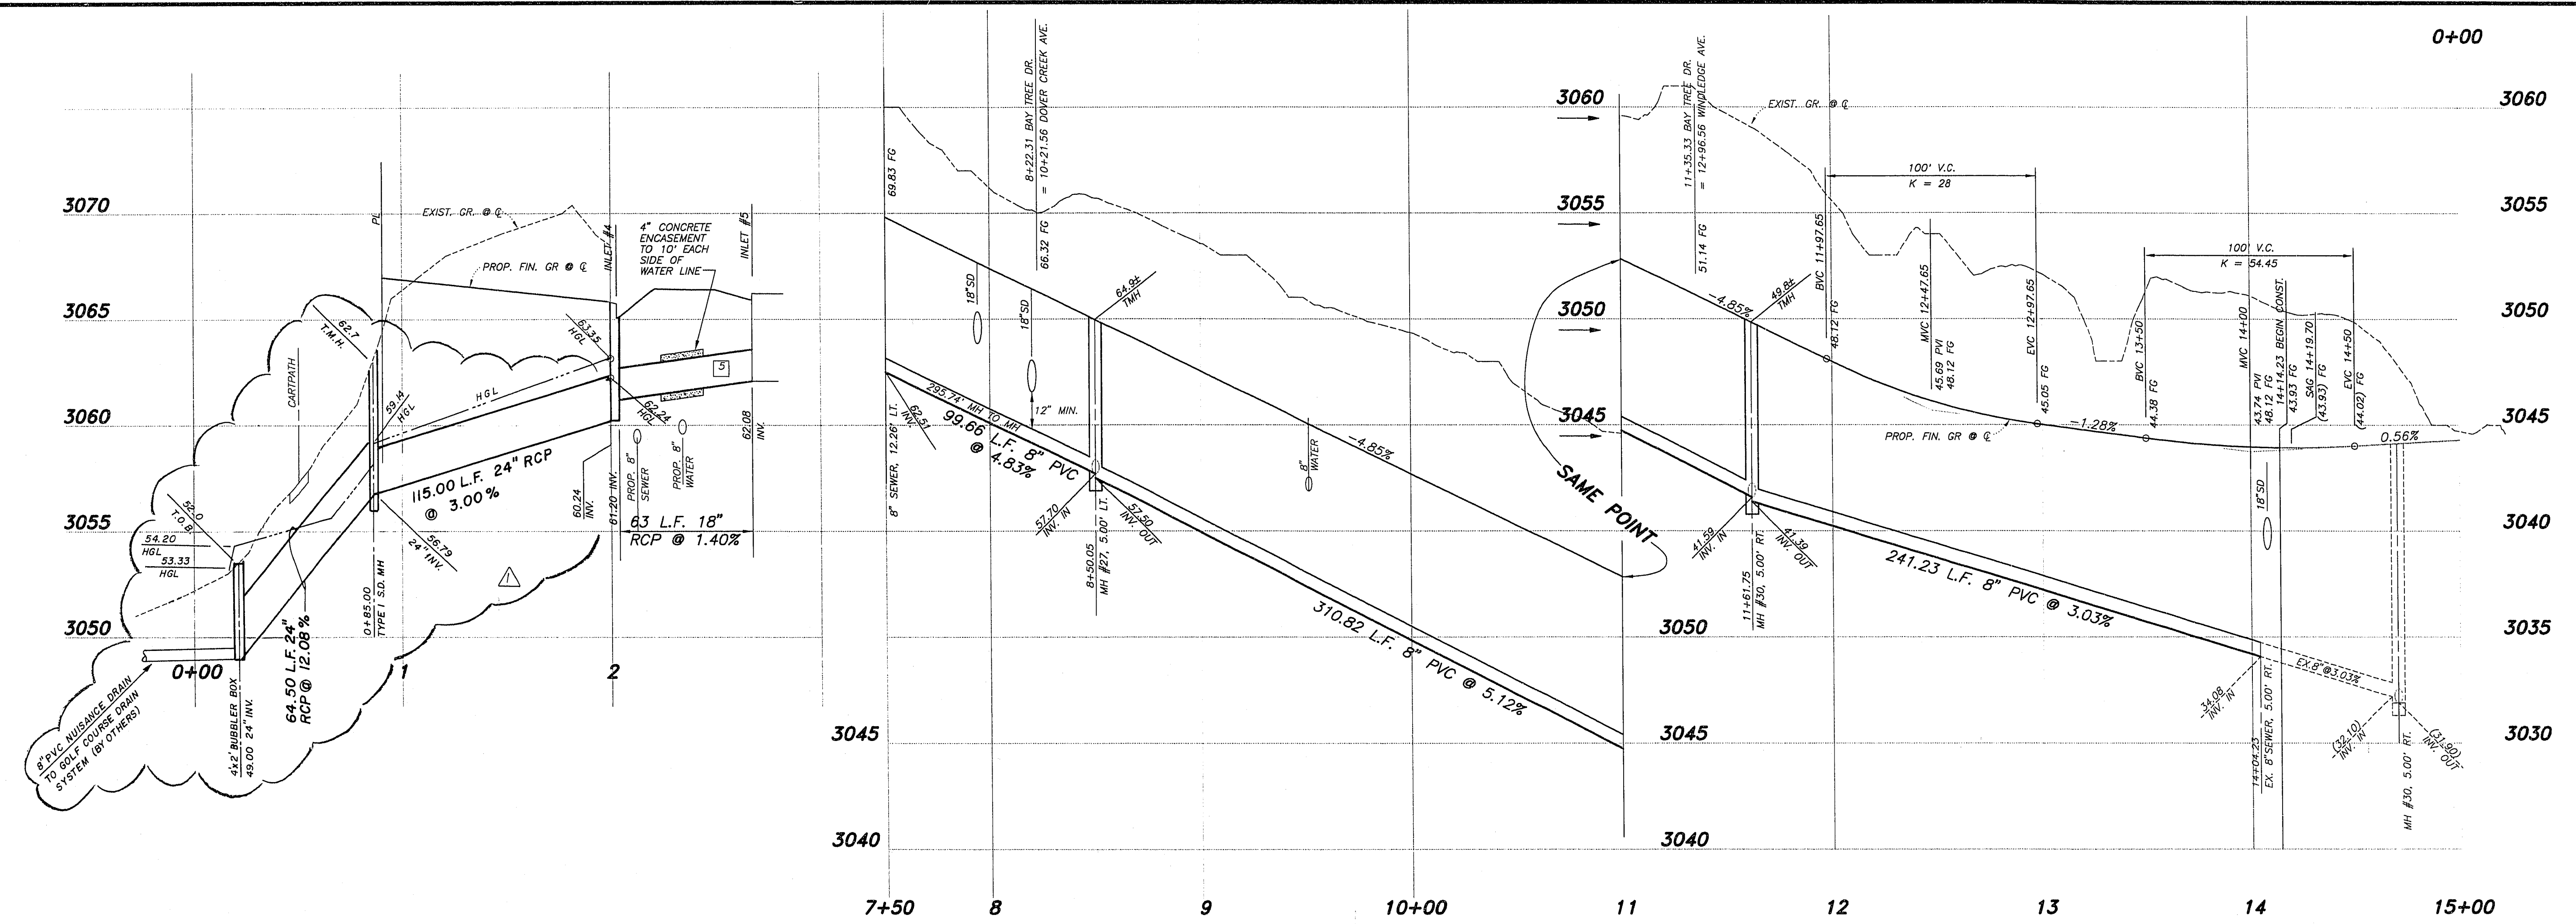


PROFILE
 SCALE: HORIZ. 1" = 40'
 VERT. 1" = 4'

STORM DRAIN LINE TABLE


LINE	BEARING	DISTANCE
5	S60°54'19"W	62.78'
6	N89°33'00"W	48.29'
9	S67°10'13"W	32.36'

CENTER LINE & BCR CURVE TABLE

CURVE	DELTA	RADIUS	LENGTH	TANGENT
1	03°39'46"	1,372.00'	87.71'	43.87'
2	09°03'59"	1,372.00'	217.10'	108.78'
3	88°26'09"	20.00'	30.87'	19.48'
4	30°06'01"	1,336.00'	701.87'	359.23'
5	12°11'42"	1,354.00'	288.19'	144.64'
6	03°26'47"	1,336.00'	80.36'	37.52'
7	07°01'04"	1,336.00'	165.84'	83.03'
8	05°27'13"	1,372.00'	130.59'	65.35'
9	30°06'01"	1,354.00'	711.32'	364.07'
10	05°22'58"	948.00'	105.61'	53.86'
11	04°03'04"	984.00'	69.57'	34.80'
12	05°43'46"	966.00'	147.18'	73.73'
13	02°20'49"	20.00'	32.24'	20.64'
14	28°33'53"	966.00'	498.46'	254.91'
15	04°15'27"	984.00'	73.12'	36.58'
16	07°48'11"	948.00'	129.11'	64.65'
17	13°22'43"	966.00'	328.77'	164.96'
18	06°23'33"	948.00'	105.77'	52.94'
19	14°11'44"	948.00'	234.88'	118.04'
20	26°02'09"	984.00'	447.14'	227.50'
21	07°43'13"	984.00'	135.65'	66.36'
22	01°27'13"	966.00'	24.51'	12.25'
23	01°29'30"	984.00'	25.62'	12.81'
24				

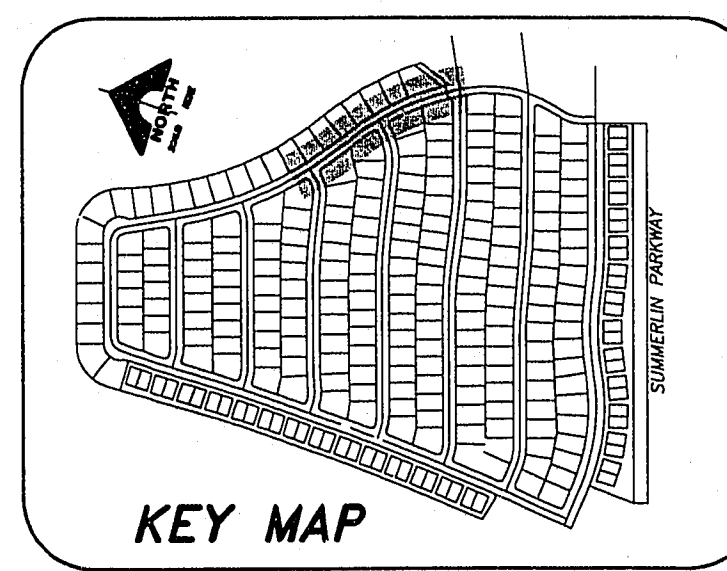

REV.	DATE	DESCRIPTION	C.L.V.	DATE
1	09/26/96	REV. STA. DRAIN OUTFALL	SONNY W. NEAL	10/11/96
2	10/11/96		SONNY W. NEAL	10/11/96

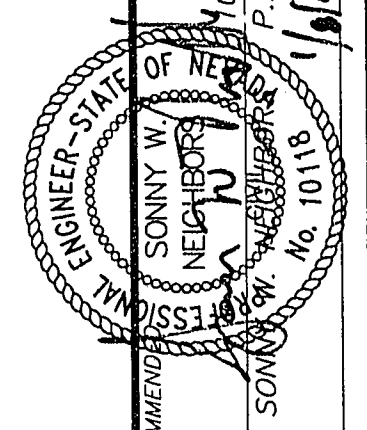

G. C. WALLACE, INC.
 Engineering/Architecture
 1555 SOUTH RAINBOW BLVD./LAS VEGAS, NEVADA 89102

DEL WEBB COMMUNITIES, INC.
 SUN CITY SUMMERLIN - UNIT NO. 49
 BAY TREE DRIVE

SHEET
 17

10-12-56 107Y-4141-49