
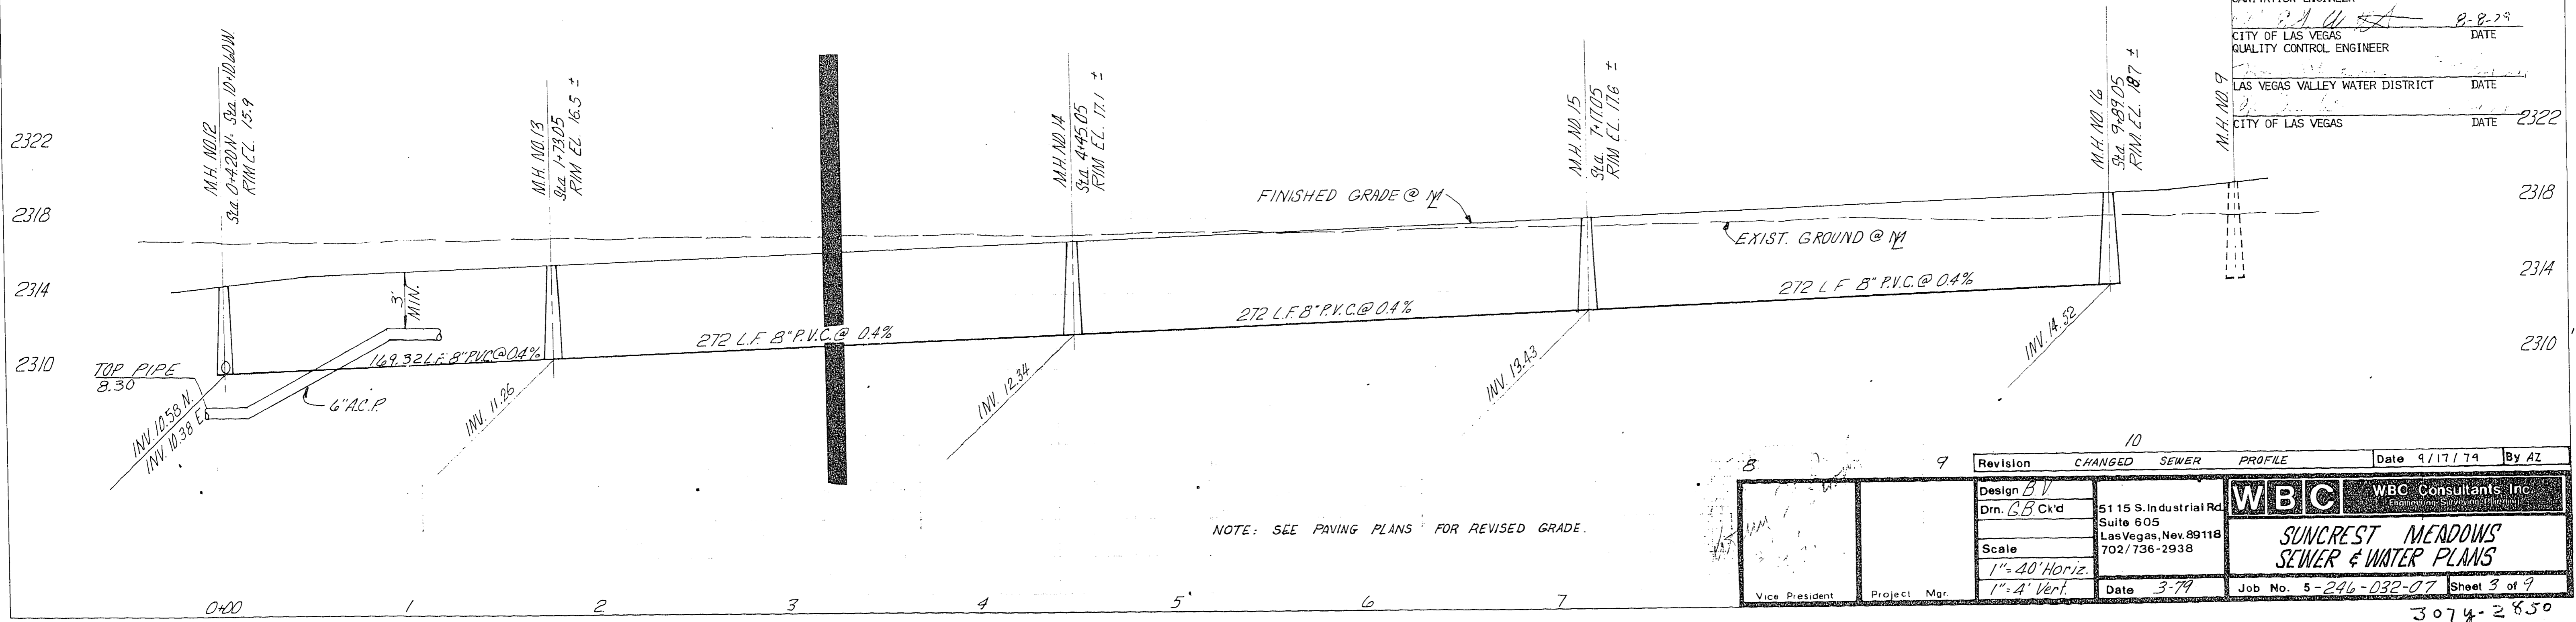


PHASE 2 IS NOT A PART OF PLAT AS APPROVED BY CITY COMMISSION

DATE	
BY	
PLAN	SURVEYED, ALIGNED, CHECKED, NOTE BOOK, RT OF WAY CHECKED, NO.

DATE	
BY	
PROFILE	SURVEYED, GRADES CHECKED, NOTE BOOK, STRUCTURE NOTATIONS CHECKED, NO.

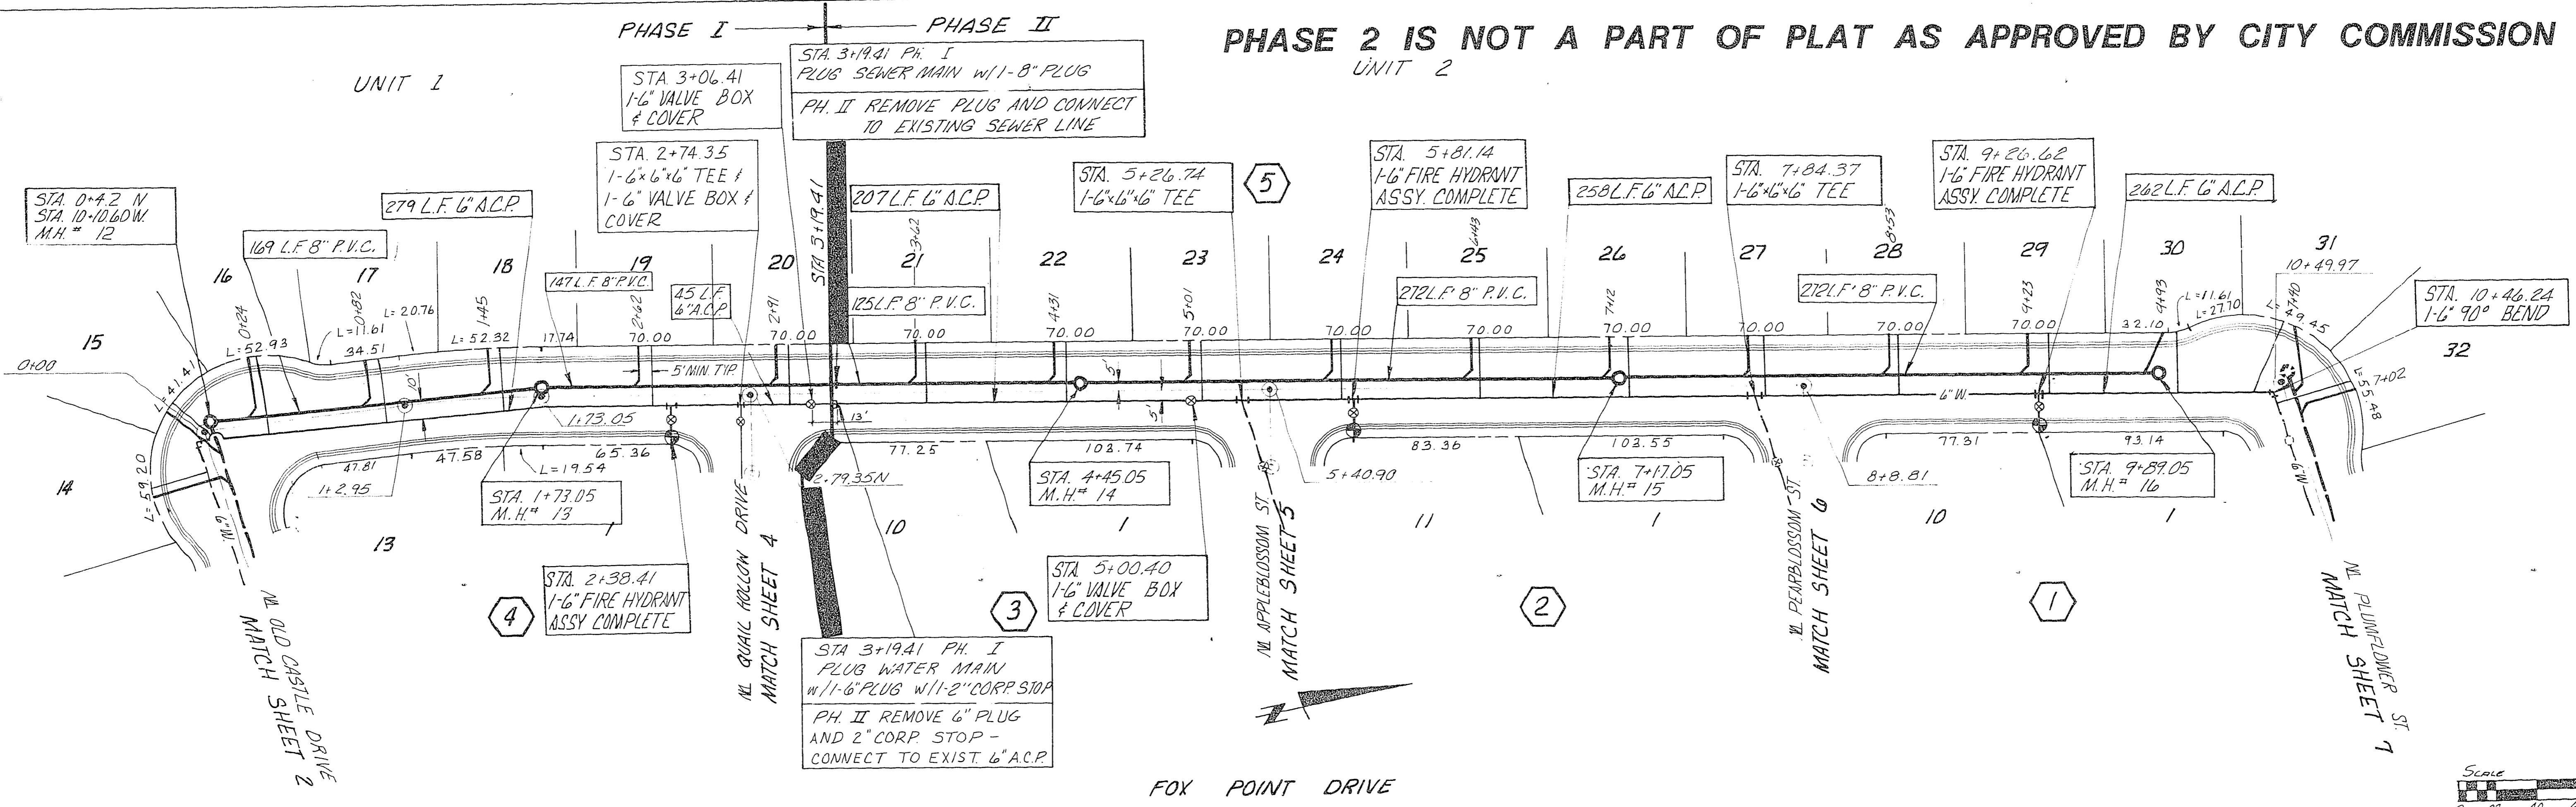

APPROVALS:

CITY OF LAS VEGAS CITY ENGINEER	DATE
CITY OF LAS VEGAS FIELD OPERATION ENGINEER	DATE
CITY OF LAS VEGAS SANITATION ENGINEER	DATE
CITY OF LAS VEGAS QUALITY CONTROL ENGINEER	DATE
LAS VEGAS VALLEY WATER DISTRICT	DATE
CITY OF LAS VEGAS	DATE 2322

Revision	CHANGED SEWER PROFILE	Date	9/17/79	By	AZ
Design BV					
Dwn. GB Ckd					
Scale	1" = 40' Horiz. 1" = 4' Vert.	Date	3-79	Job No.	5-246-032-07
5115 S. Industrial Rd. Suite 605 Las Vegas, Nev. 89118 702/736-2938		WBC WBC Consultants Inc. Engineering, Surveying, Planning			
SUNCREST MEADOWS SEWER & WATER PLANS		Sheet 3 of 9			

3074-2850