

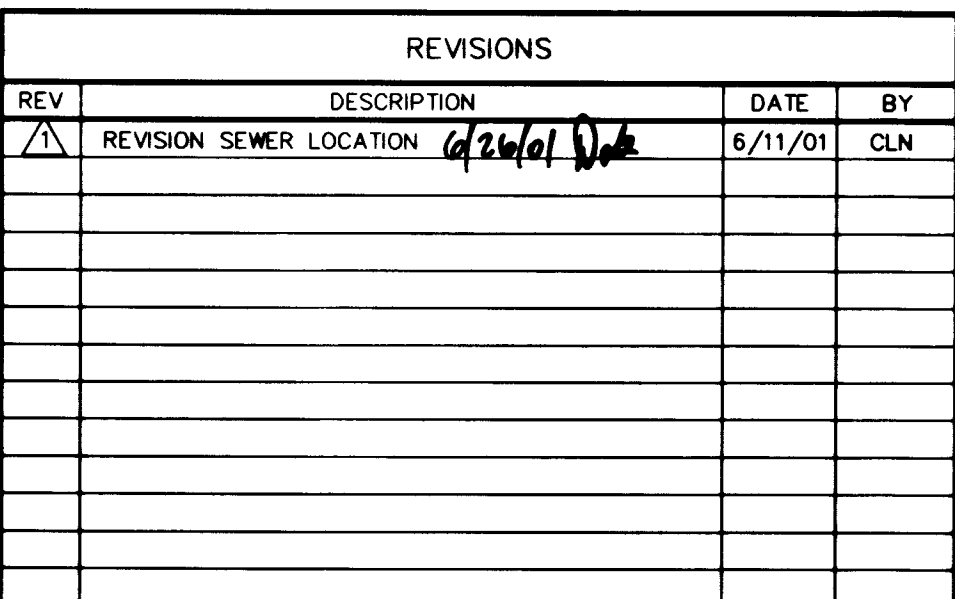


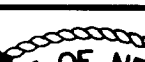


	CASE PROJECT NO. 11/13
CSO REQUEST APPROVED BY:	DATE:
CCLN CCLN CCLN	DATE:
BIR DOCUMENT 000045	DATE:

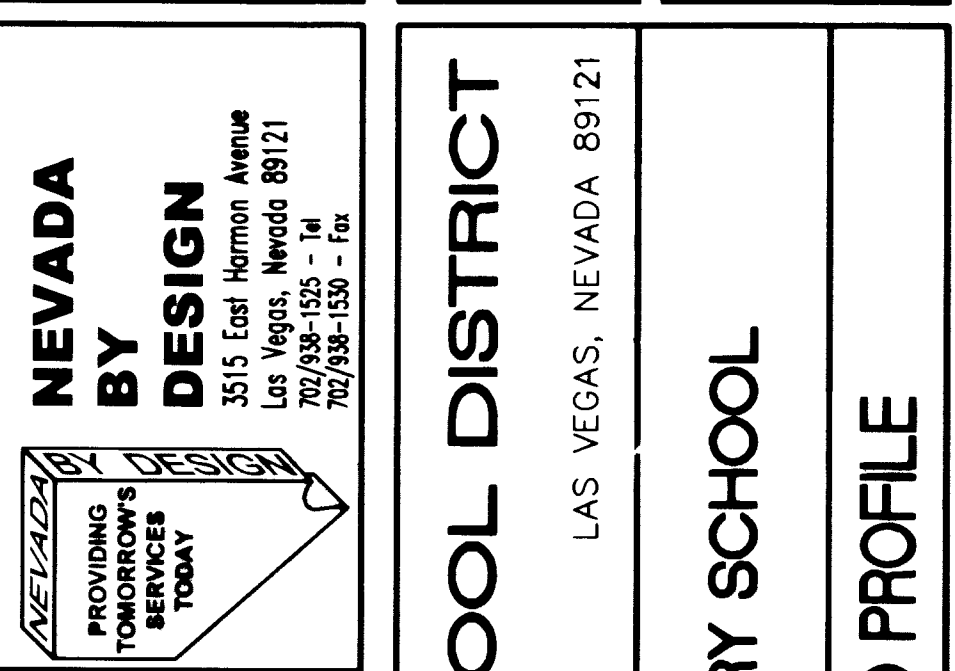

JWA ARCHITECTURE STUDIOS 100150 CONTINENTAL CROSS DRIVE LAS VEGAS, NEVADA 89144 (702)791-1000	CLARK COUNTY SCHOOL DISTRICT CONSTRUCTION MANAGEMENT 4828 PEARL ST.	SUNRISE ACRES ELEMENTARY	SANITARY SEWER PLAN AND
--	---	--	---------------------------------------

SHEET NO. C4.03 SHEET 13 of 26 DRAWING NUMBER 715-134	Replot
	715-134

CLV BM 2LV0136W4: RIVET & PLATE IN TOP OF CURB,
S.E. RETURN, STEWART AVENUE AND EASTERN AVENUE.
ELEVATION: 1846.08' (NAVDB8)

S 44°48'20" E, BEING THE GRID BEARING BETWEEN CLARK COUNTY GIS CONTROL POINTS 816 AND 827, AS SHOWN ON A RECORD OF SURVEY IN FILE 88, PAGE 53 OF SURVEYS, OFFICIAL RECORDS, CLARK COUNTY, NEVADA.

Call
Before You
Overhead
1-702-593-6111

Avoid cutting underground utility lines. It's costly.

Call
before you
Dig

1-800-227-2600