




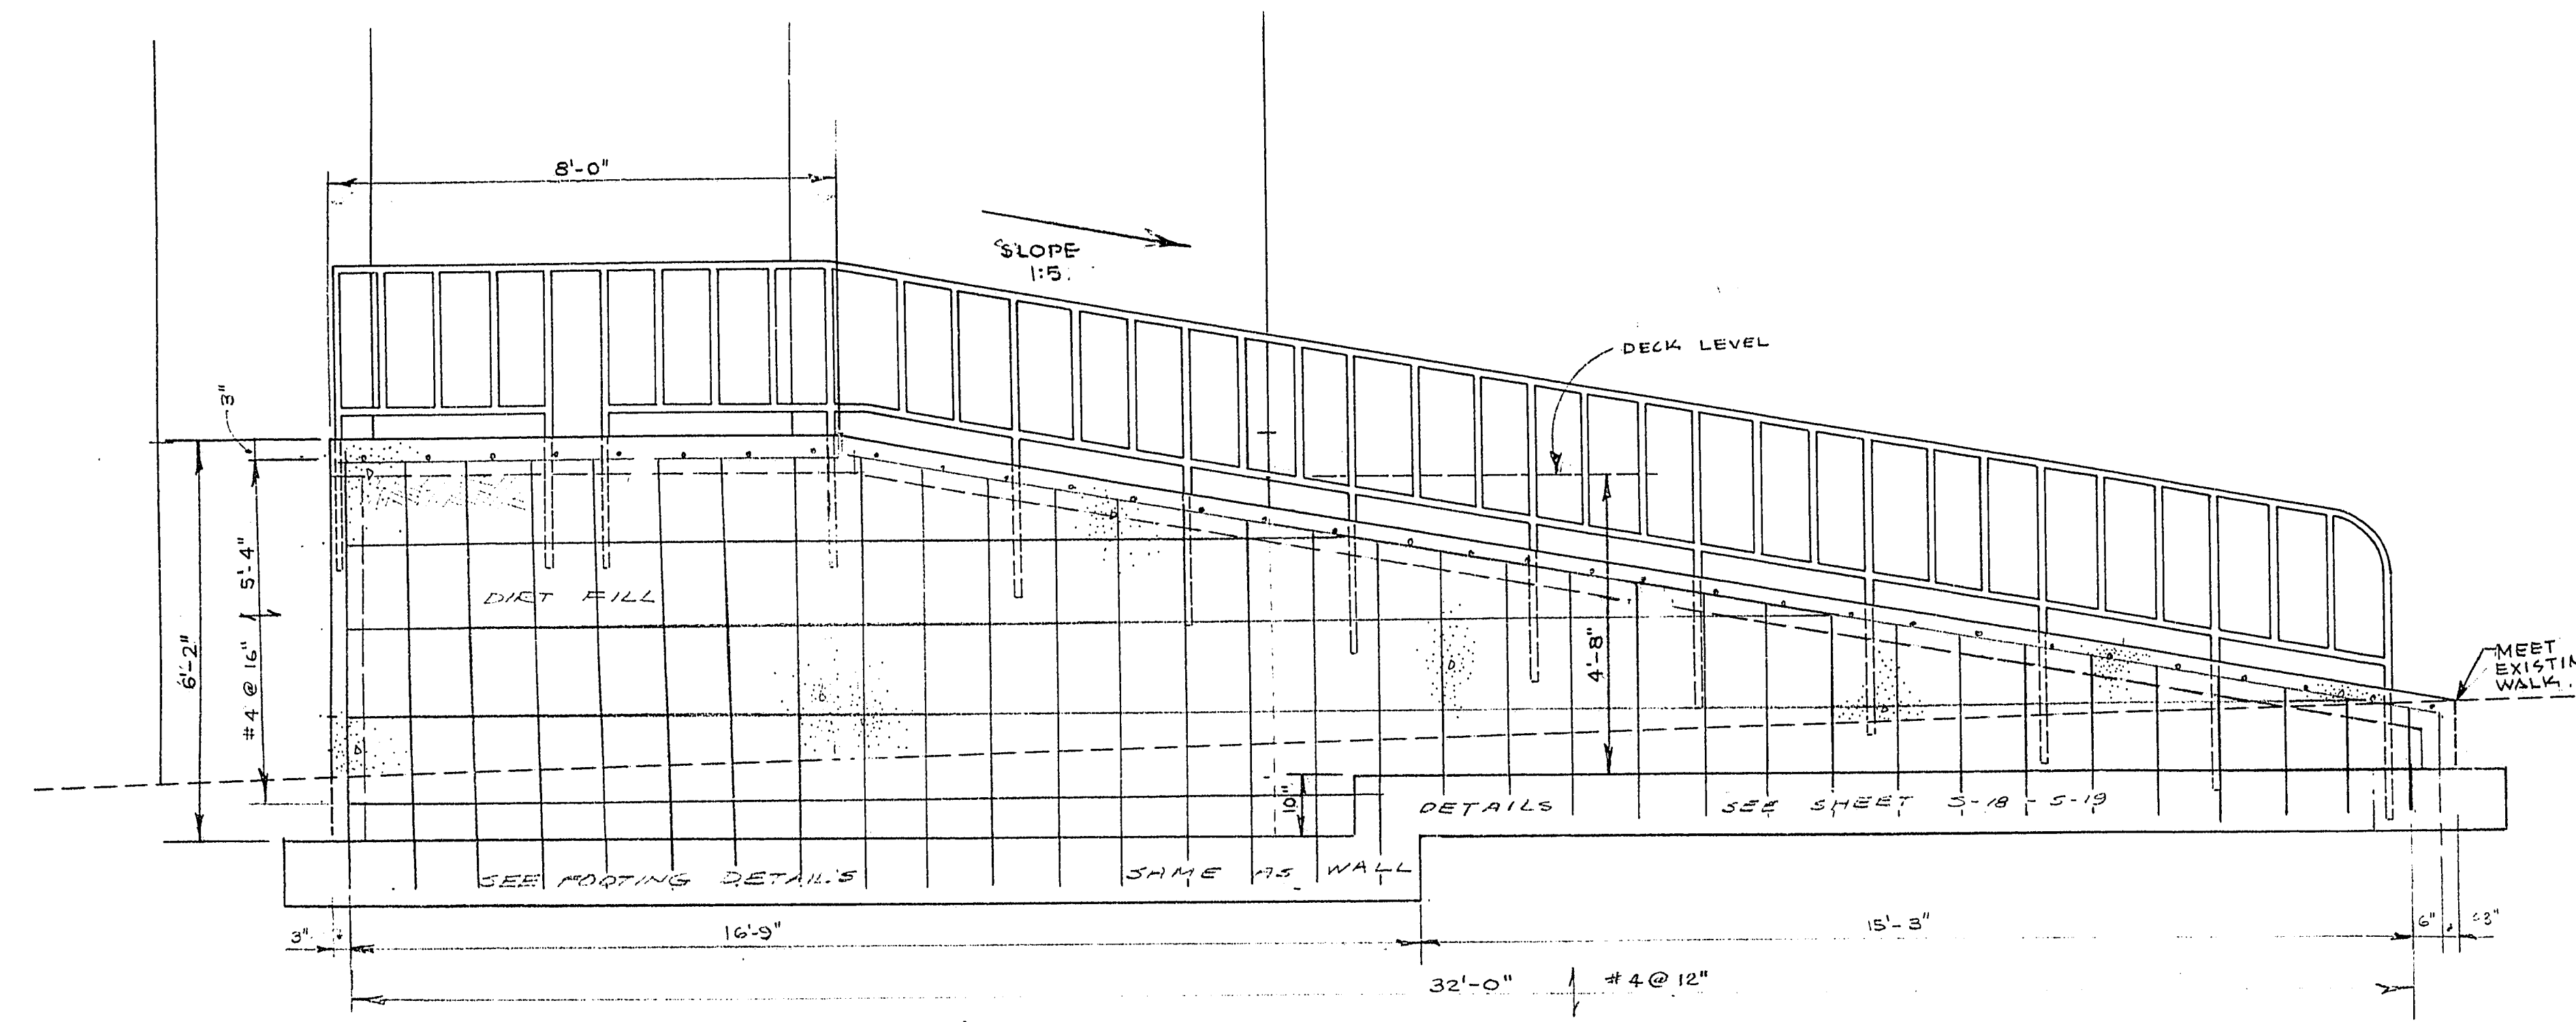




SECTION - RAMP SCALE 1/2" = 1'-0"

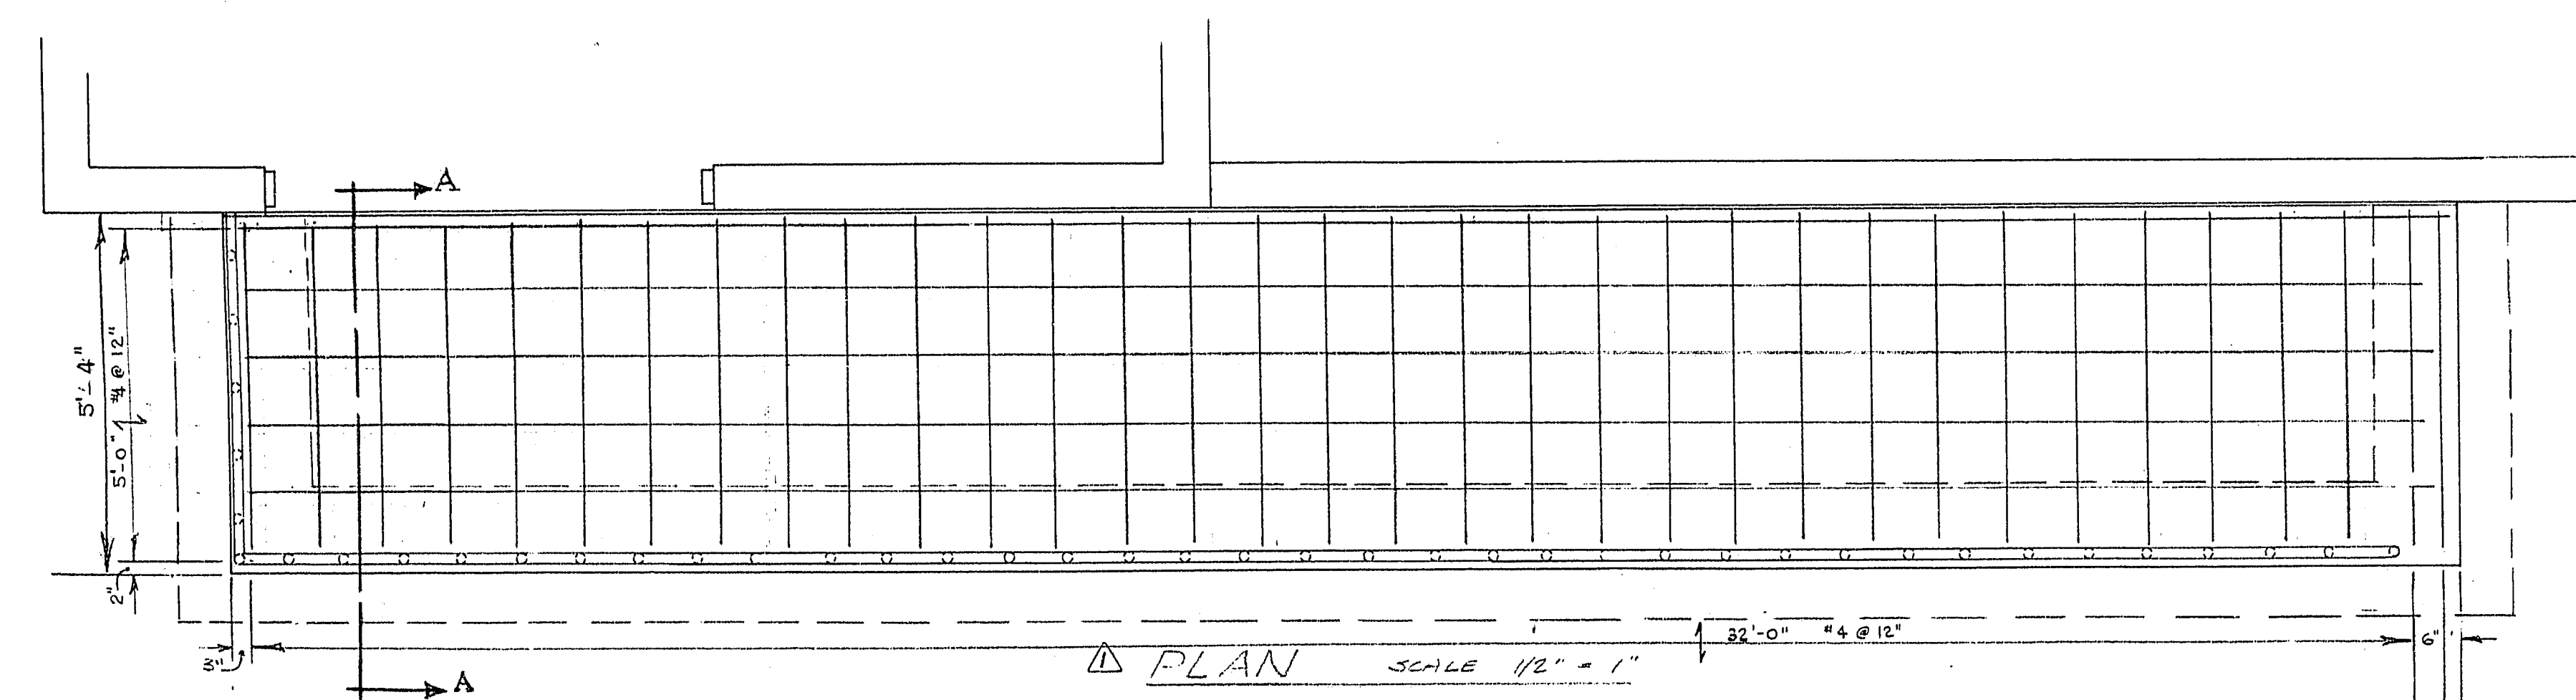


PLAN SCALE 1/2" = 1'-0"

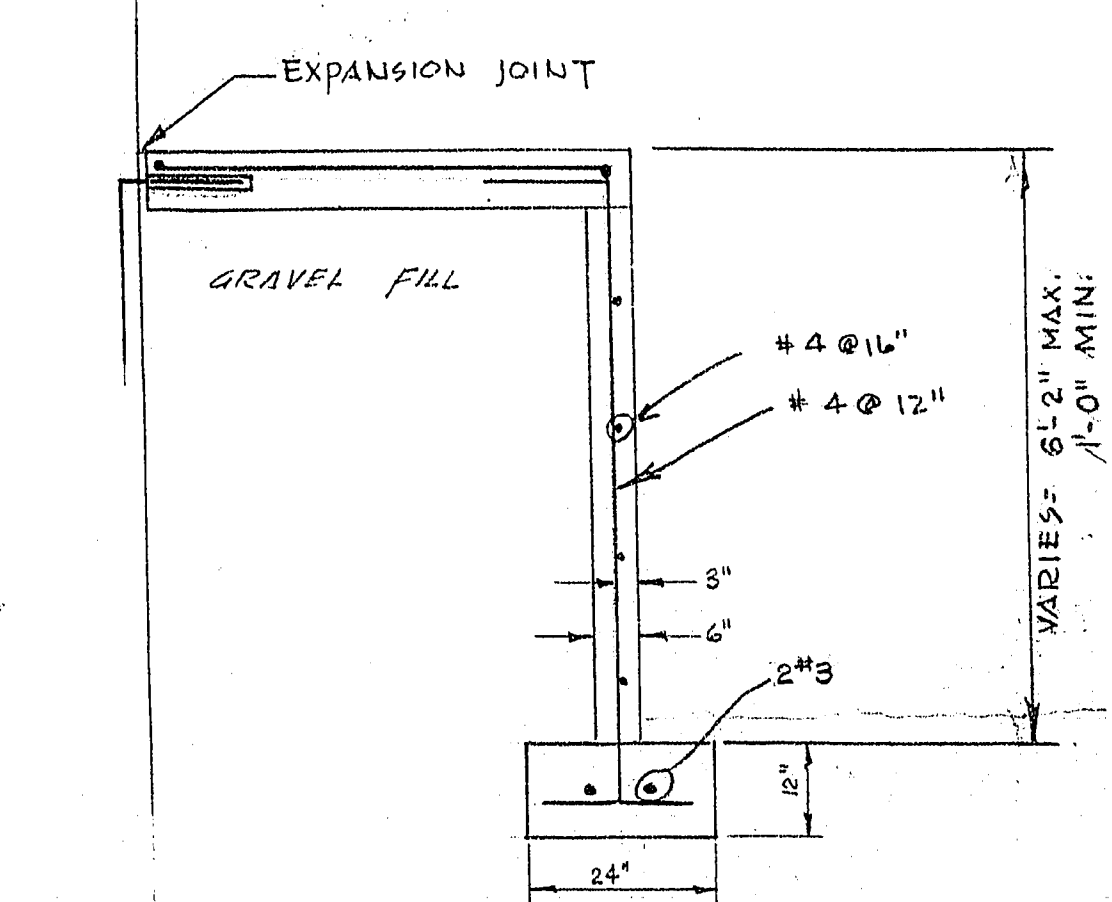

SECTION A-A SCALE 1/2" = 1'-0"

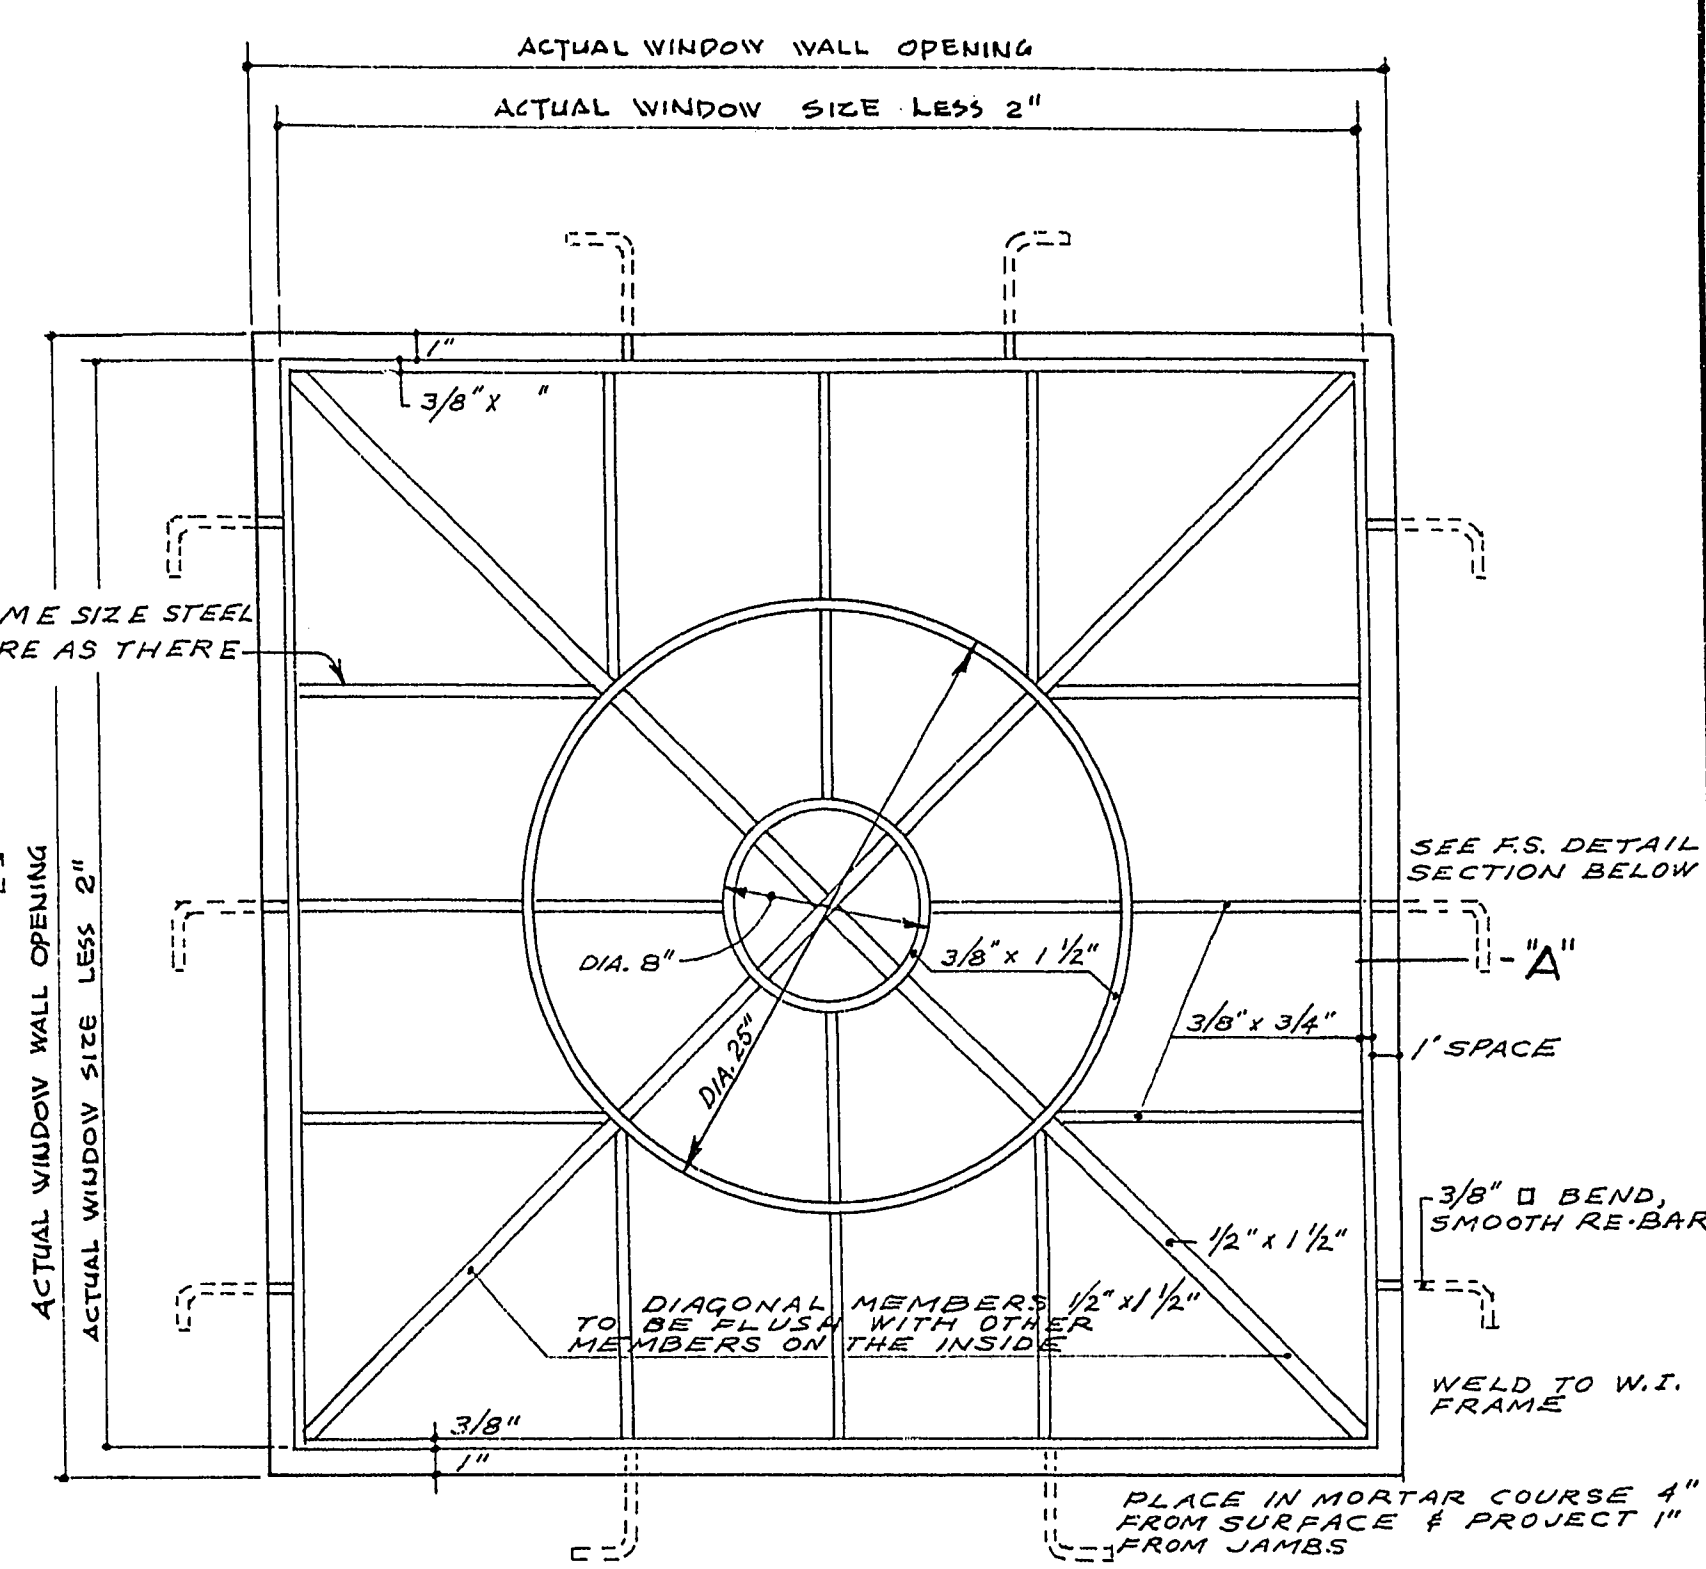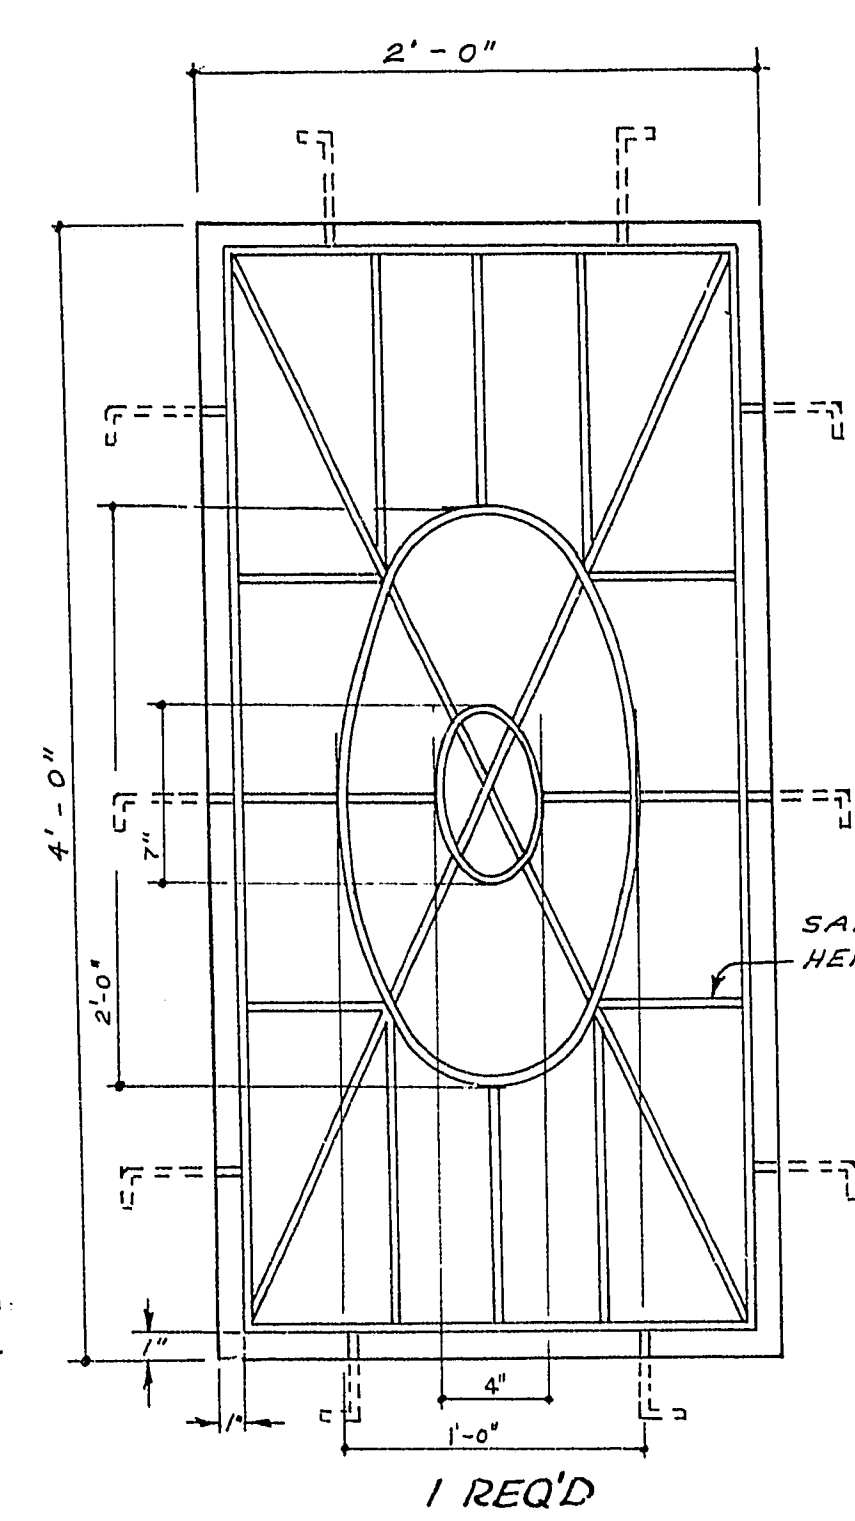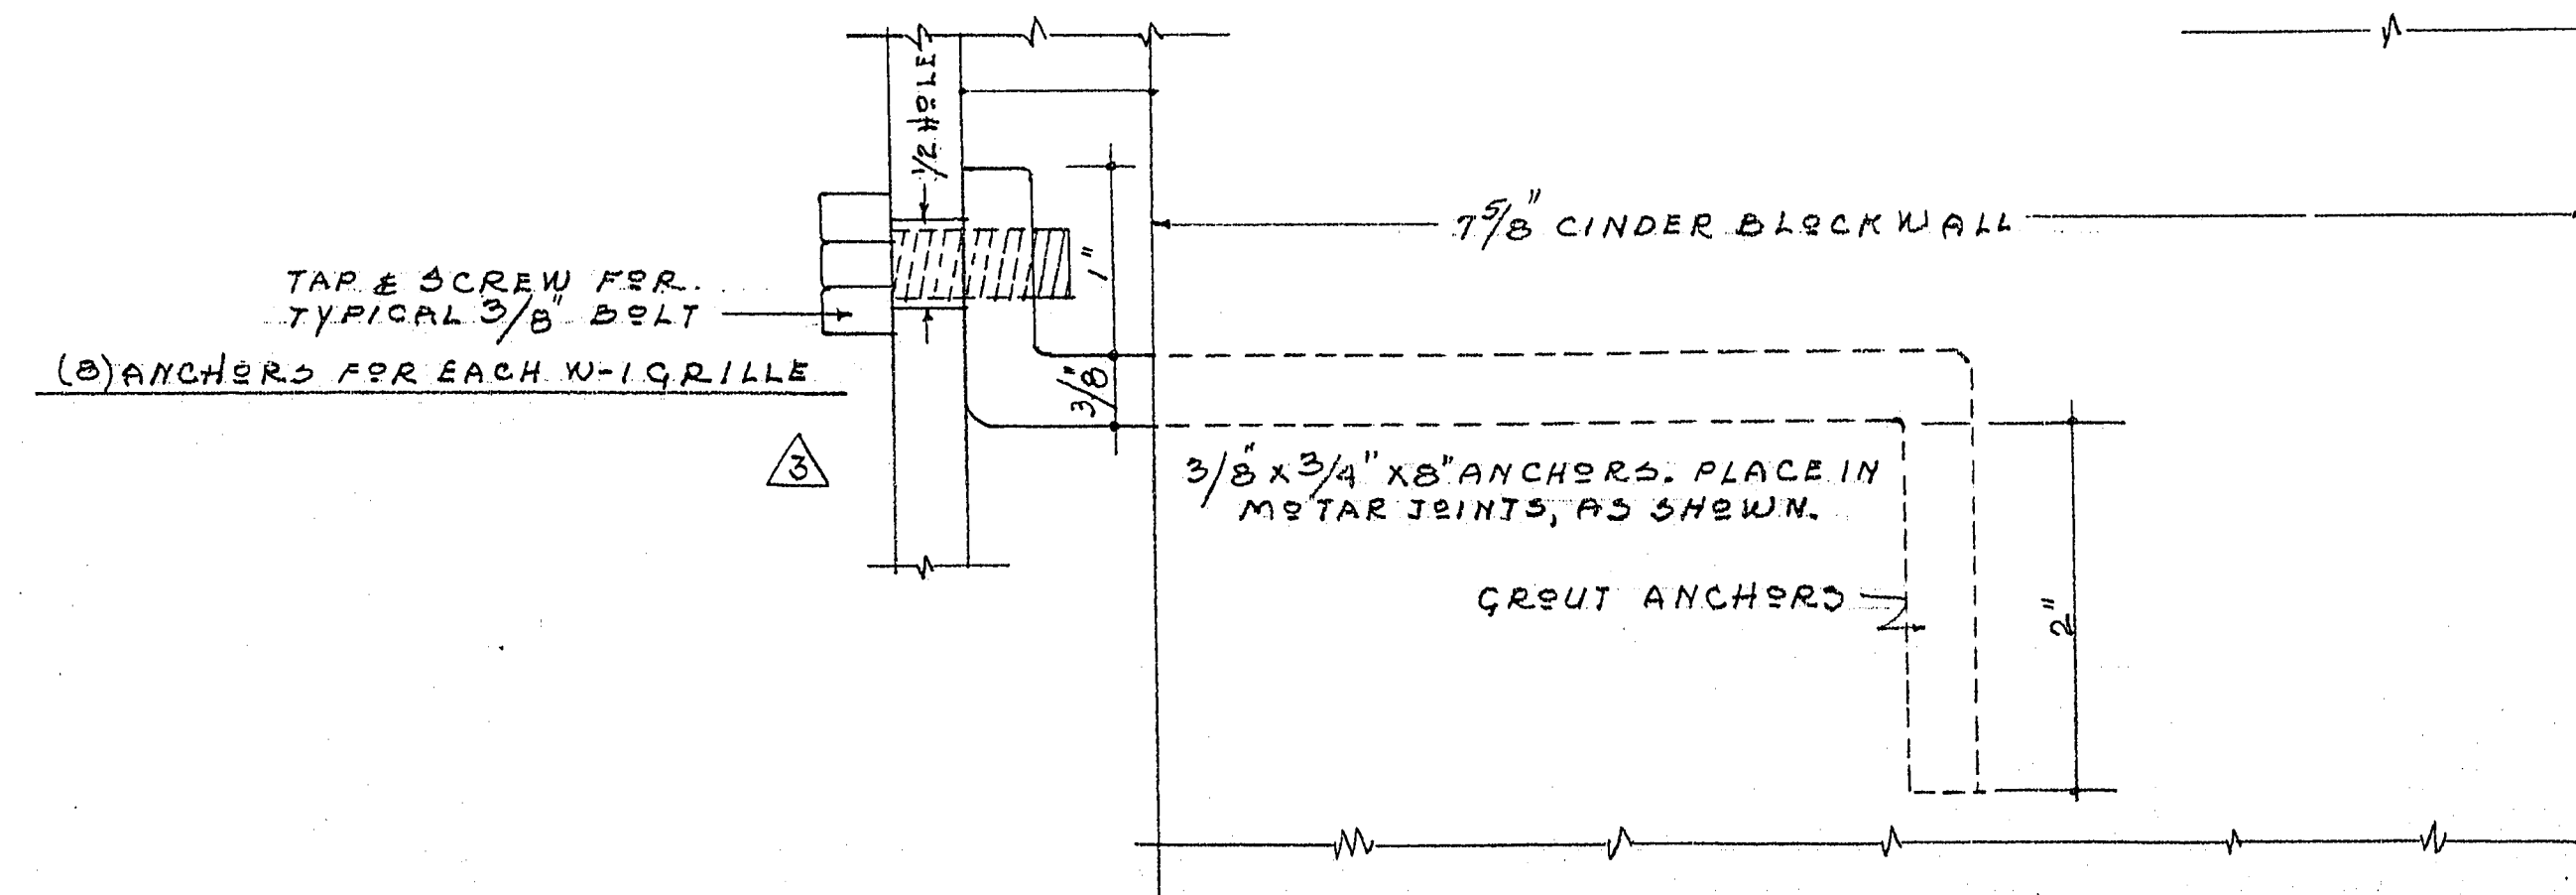

ELEVATION SCALE 1/2" = 1'-0"
WROUGHT IRON WINDOW (OFFICE) PROTECTOR

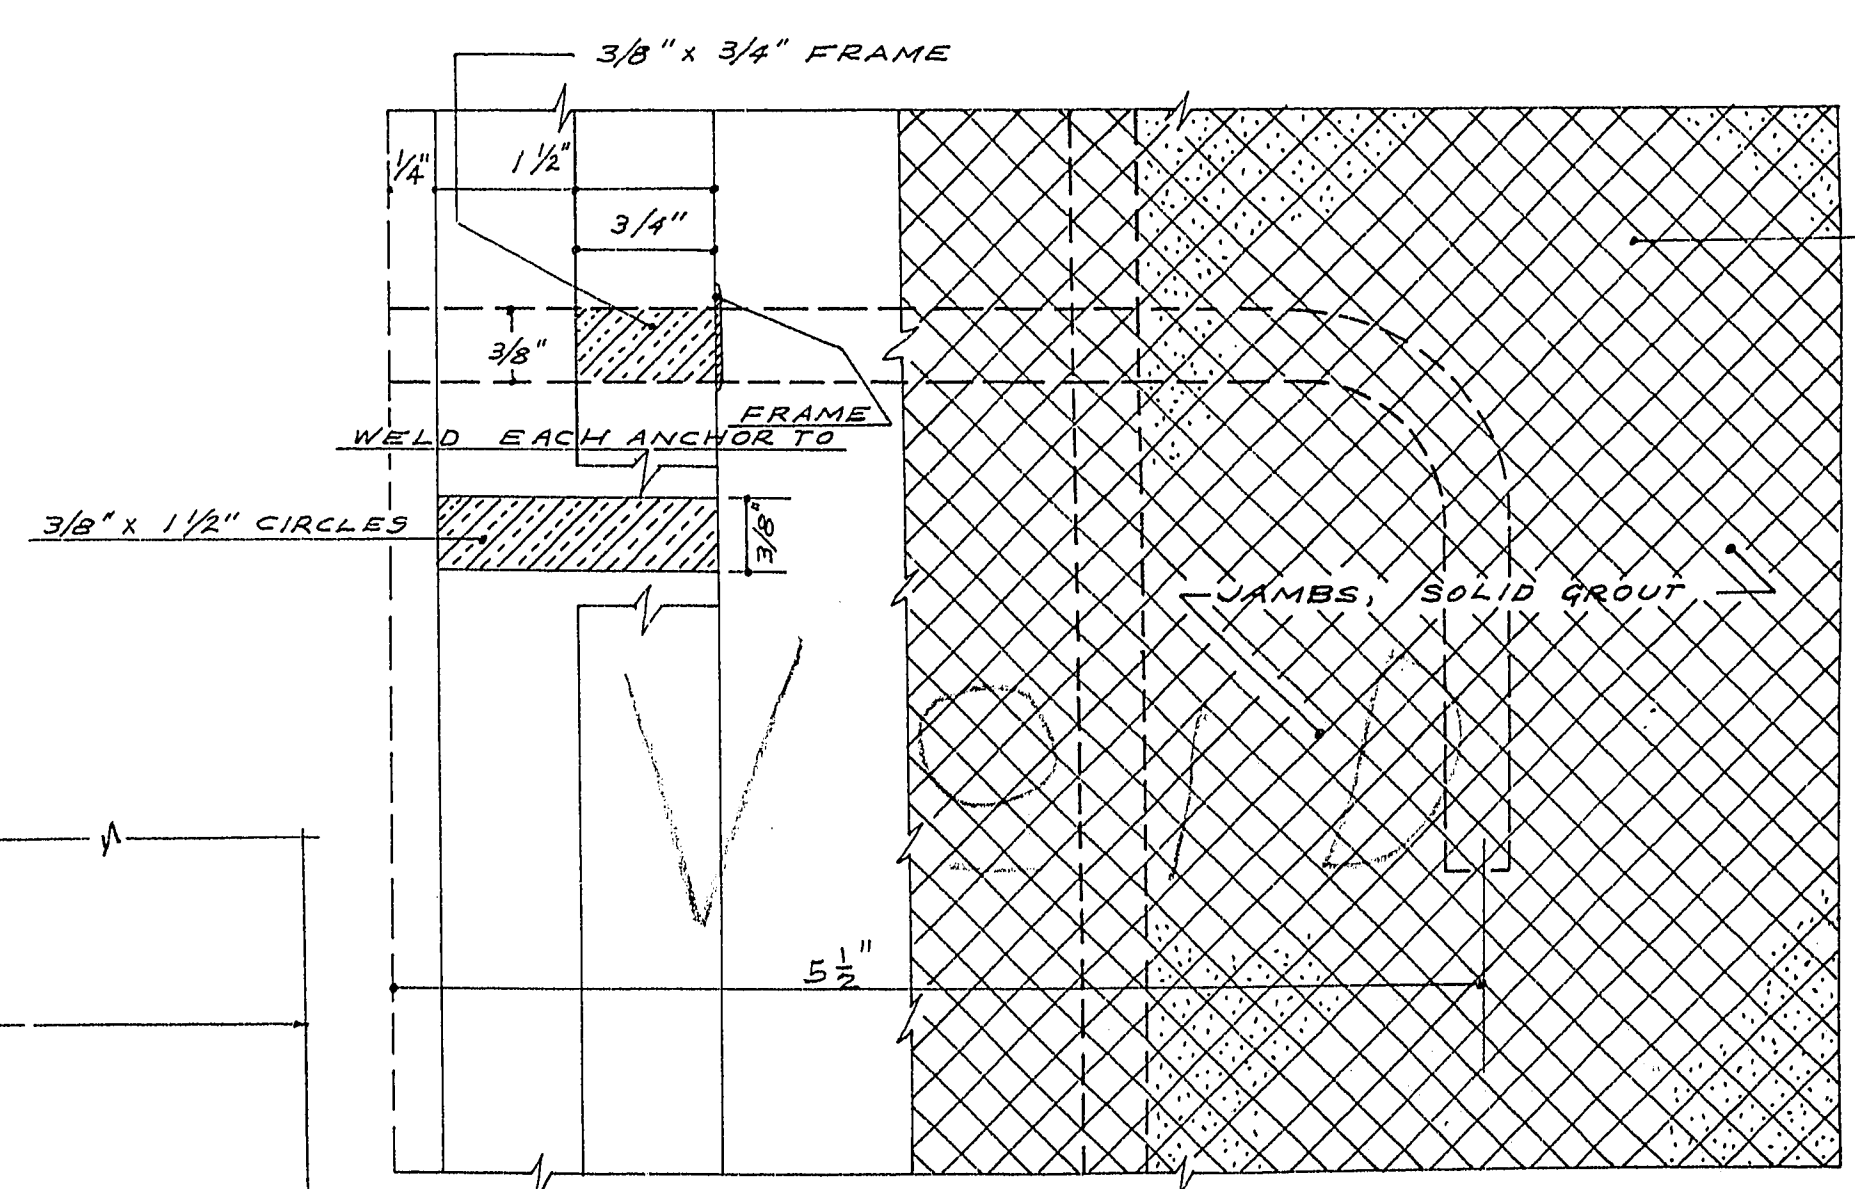

SECTION 3
TAKEN AT "A"
SCALE: FULL SIZE

APPROVED		DATE	
RT	BY	DATE	
4	DR	12/12/68	
1	CHK	12/13/68	
2	FIELD	12/14/68	
3	SERV		
	UTIL		

REVISION NO.	DESCRIPTION	BY	DATE	APPROVAL
1	YSL/DAD SECTION 3 MADE NEW DETAIL	H.H.W.		
2	ADDED SECTION 1-A	W.H.	12-26-68	
3	ADDED RE-BARS & DIMENSIONS TO RAMP & PLAN SECTION	W.H.	12-26-68	

CONTRACT
DRAWING
DEC 13 1968

CITY OF LAS VEGAS NEVADA			
DEPARTMENT OF PUBLIC WORKS			
SERVICES DIVISION			
SWIMMING POOL & FILTER BUILDING FOR GARSIDE • SCHOOL			
400 TORREY PINES DRIVE, LAS VEGAS, NEVADA			
W.O. NO. 3000	F.B.K. NO.	DATE	DRAWING NO.
SC. (H)	SC. (V)		674-14
DES. HARRY H. WHITELEY - A.I.A.		12-11-68	FILE NO.
APPROVED BY DIRECTOR OF PUBLIC WORKS		12/13/68	SHEET A-16 OF 26