

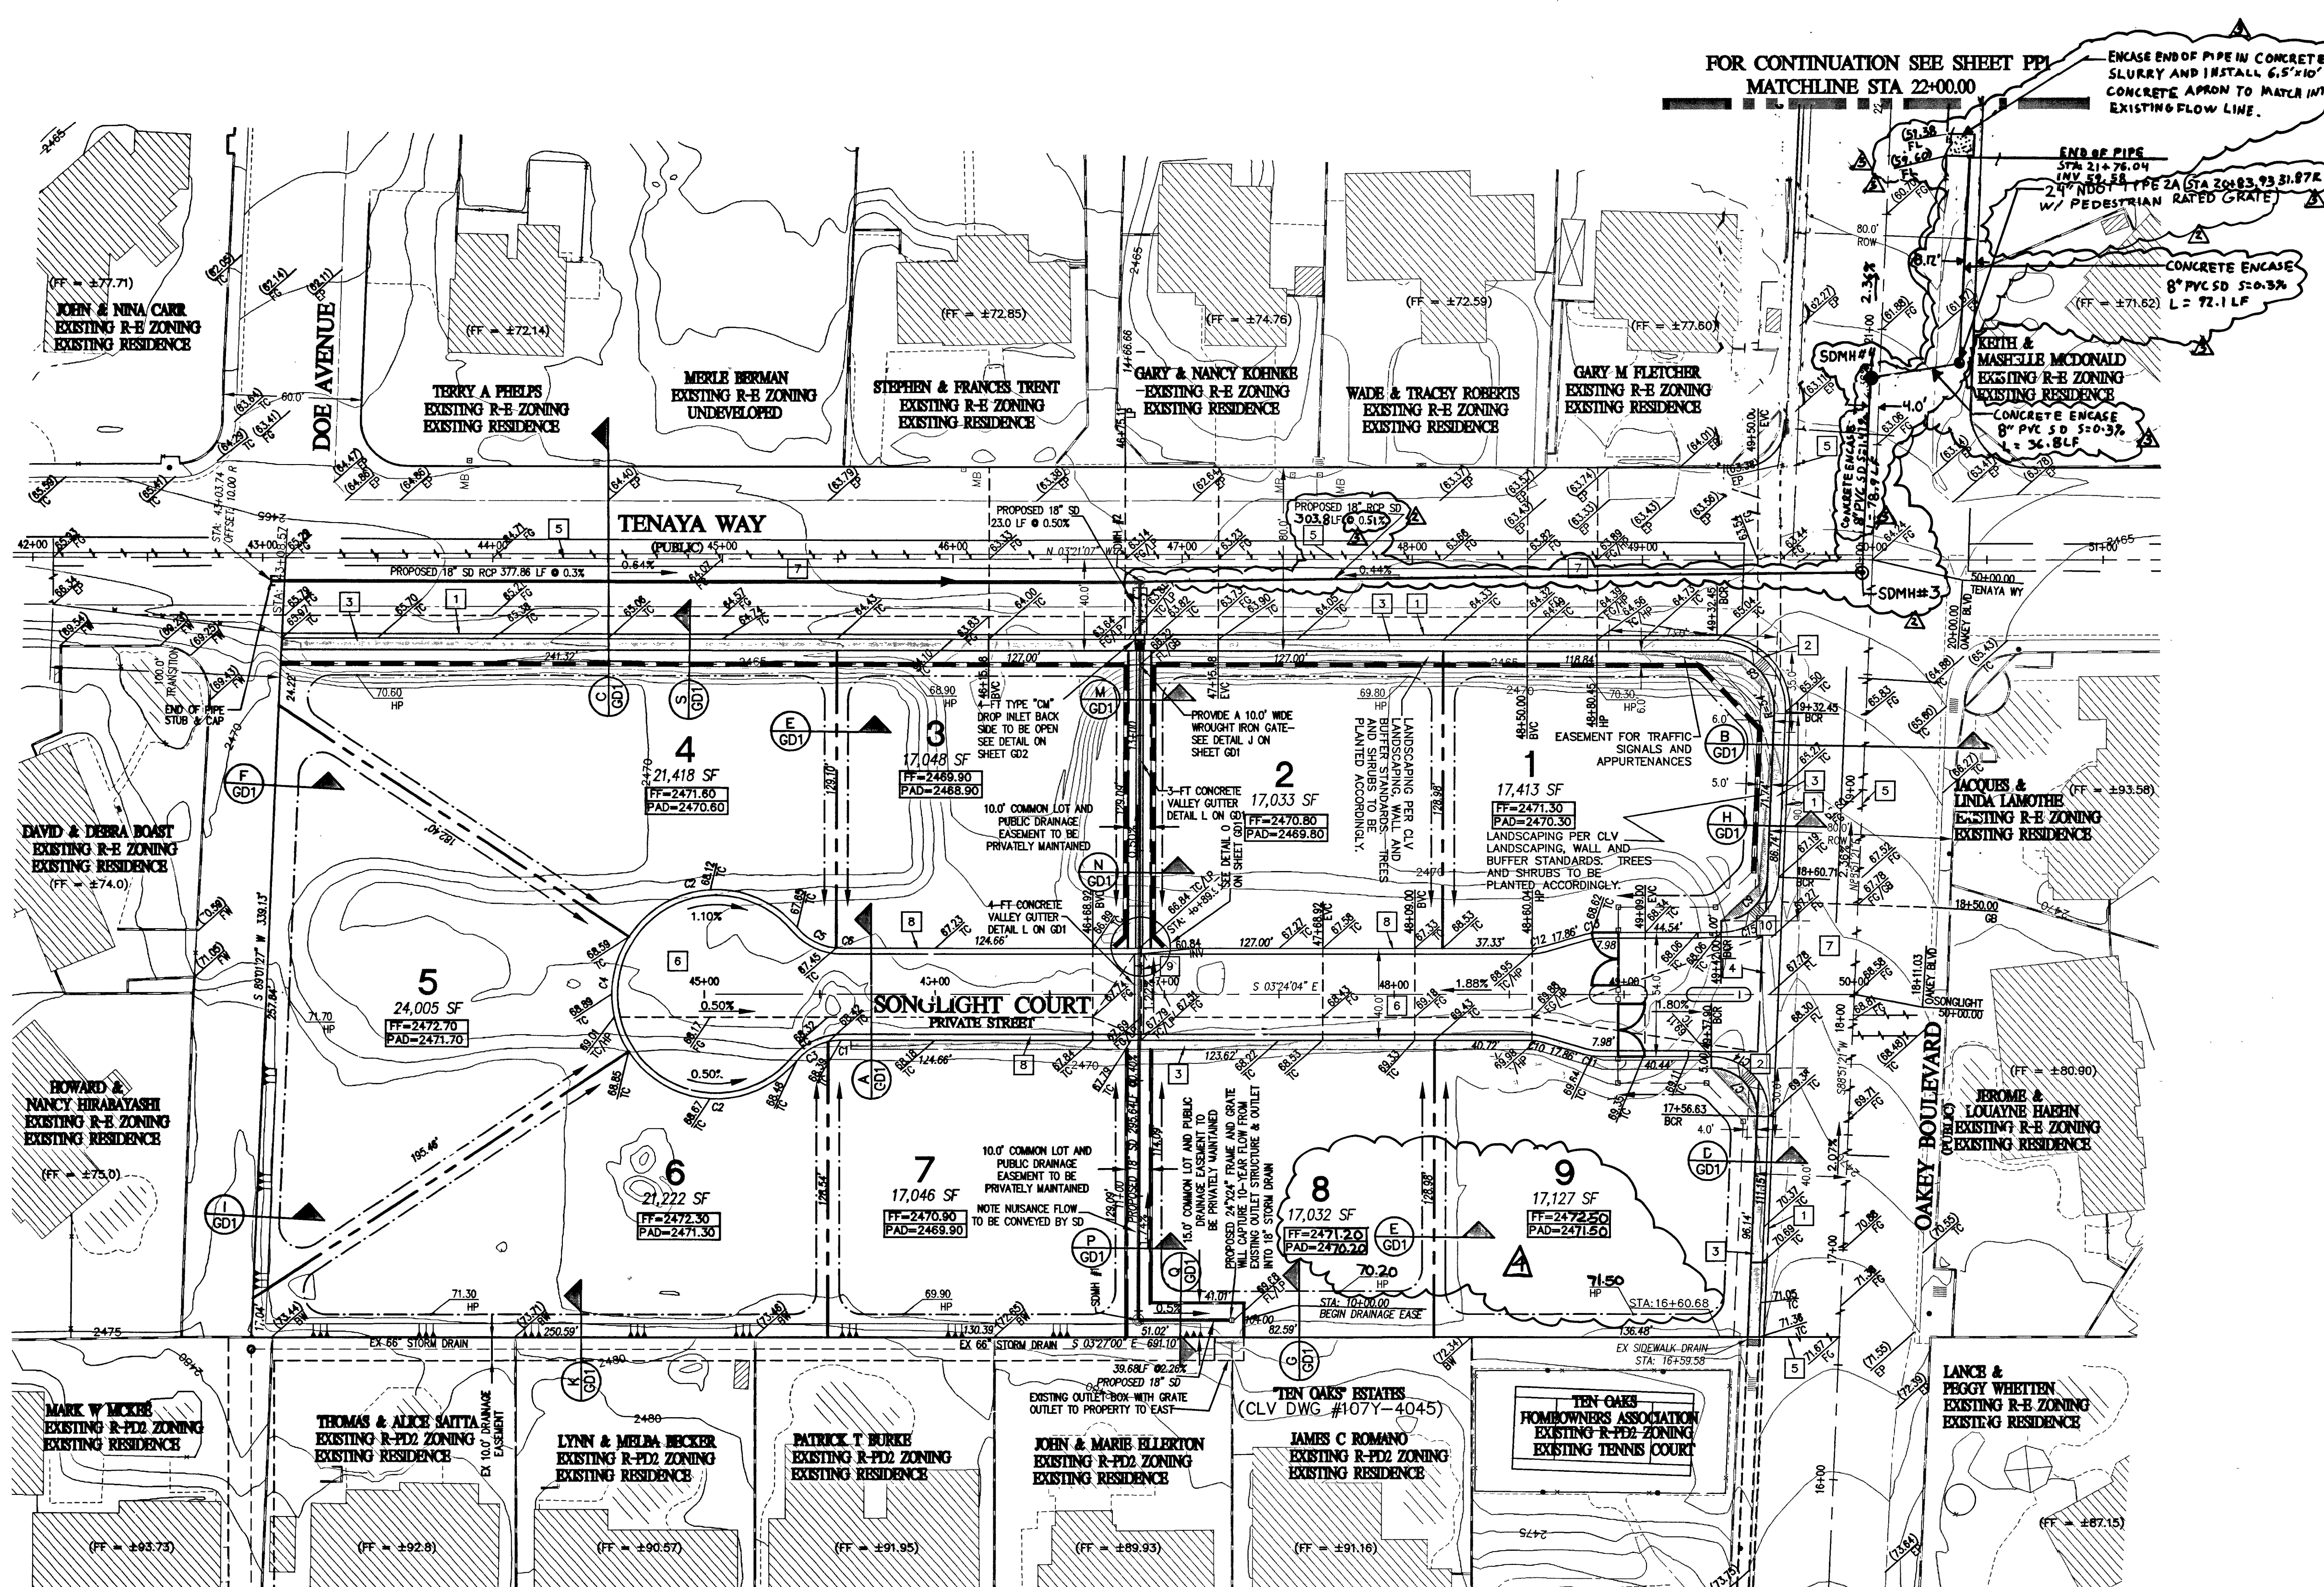


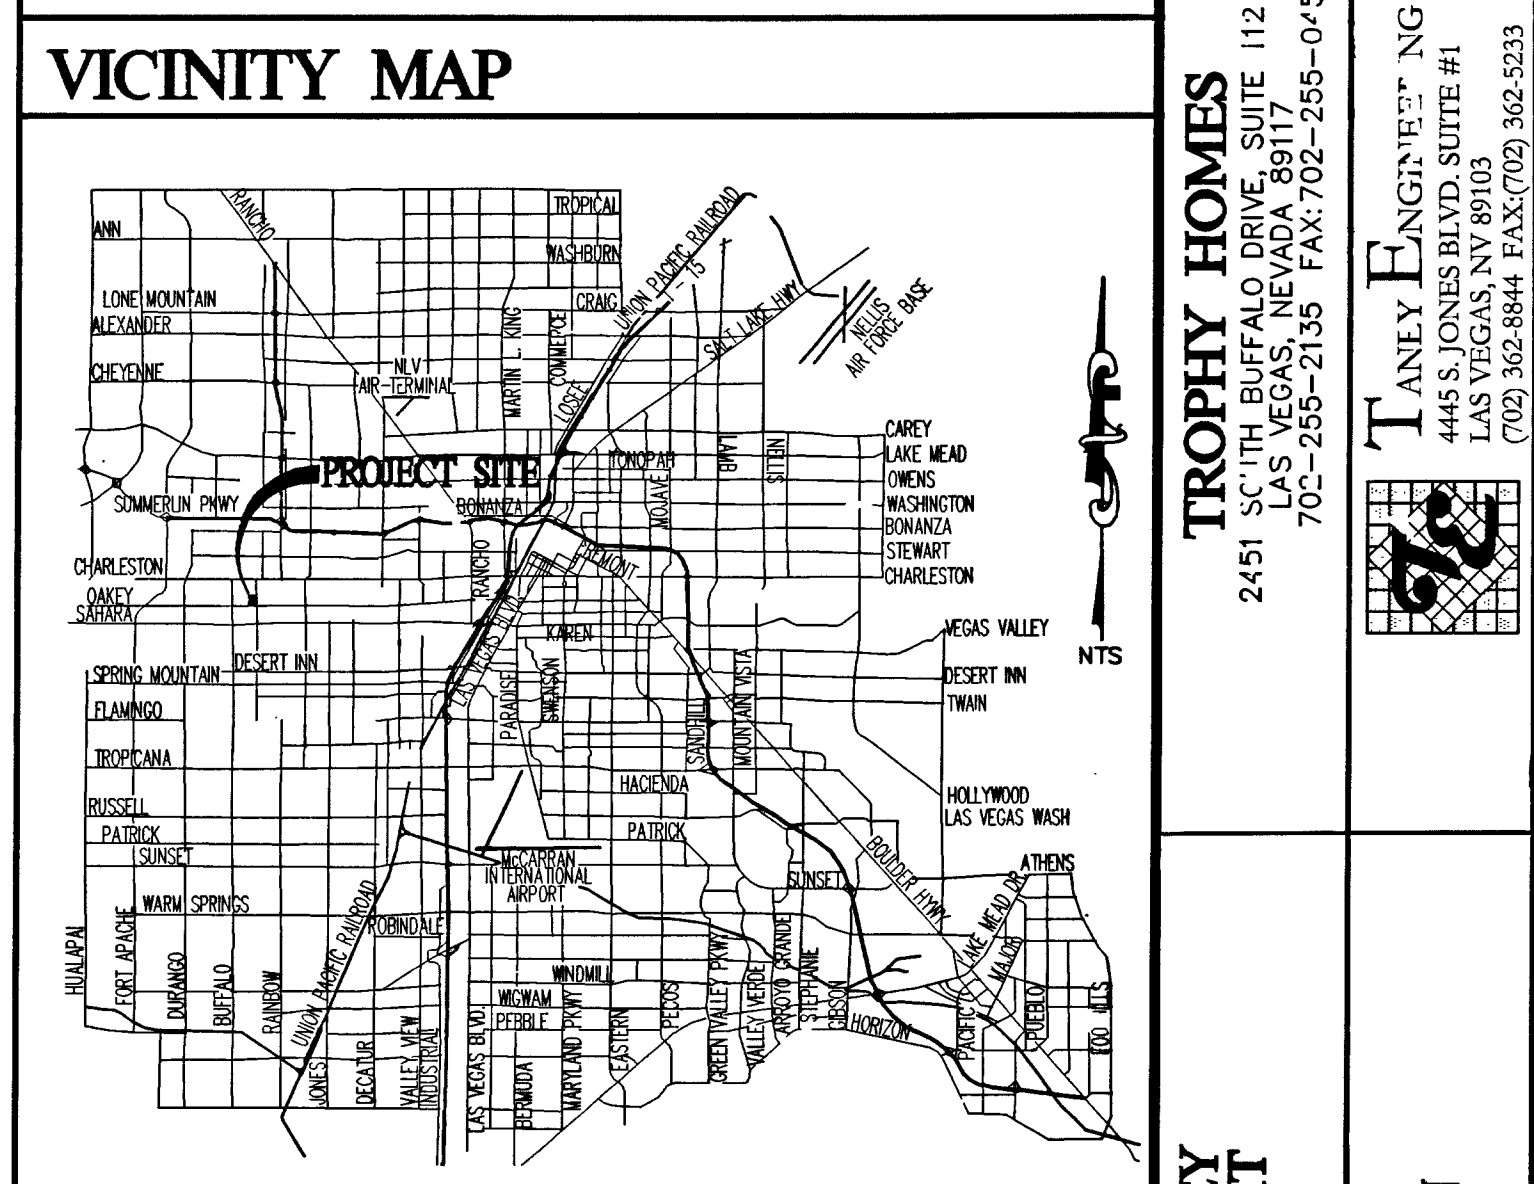

LEGEND

DESIGN ELEVATION 10.00
EXISTING ELEVATION (10.00)
SCARP (SLOPE VARIES)
EXISTING CONTOUR (1' INTERVAL)
EXISTING CONTOUR (5' INTERVAL)
DIRECTION OF FLOW
RETAINING WALL
CMU WALL
CENTERLINE
RIGHT-OF-WAY
CUT LINE-ASPHALT
PROPOSED SIDEWALK
PROPERTY LINE
STORM DRAIN CONCRETE ENCASEMENT

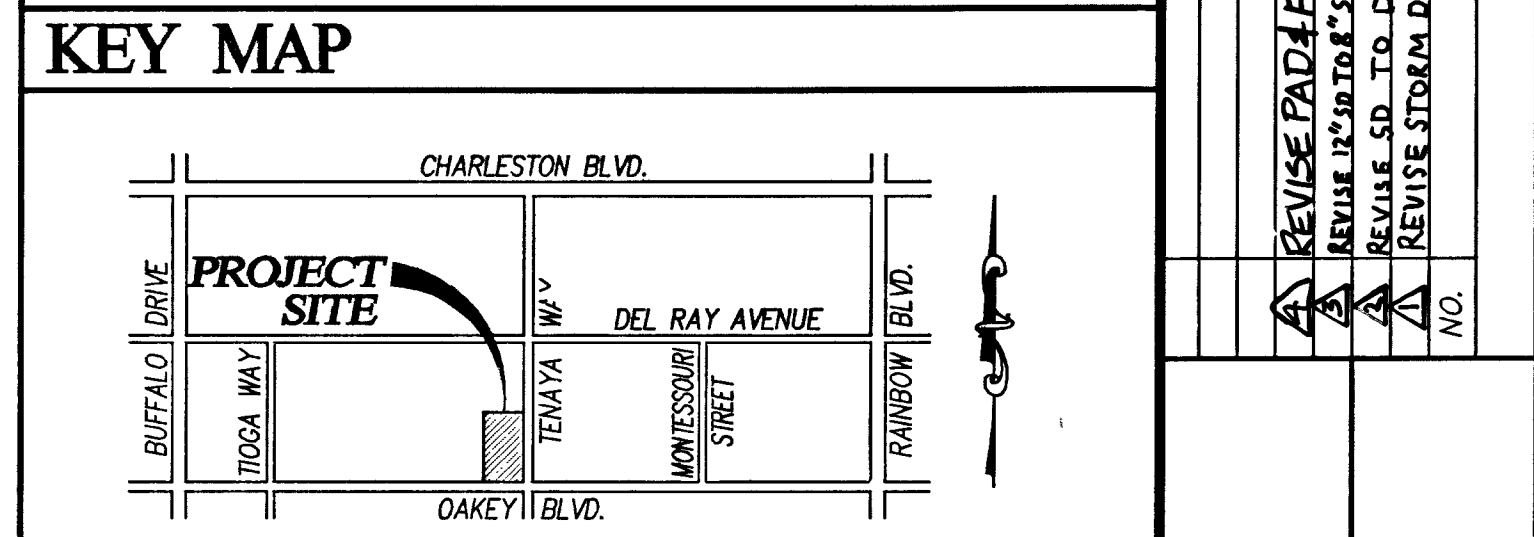

- ### NOTES
1. THE ENGINEER SHALL BE NOTIFIED IMMEDIATELY OF ANY DISCREPANCY IN THE PLANS OR CONDITIONS IN THE FIELD.
 2. ALL WORK TO BE PERFORMED OUTSIDE OF THE PROJECT BOUNDARY AND ON PRIVATE PROPERTY SHALL NOT BE PERFORMED UNTIL WRITTEN PERMISSION AND EASEMENT HAVE BEEN OBTAINED FROM THE ' SITE OWNER AND GIVEN TO THE CITY OF LAS VEGAS.
 3. ALL STATIONING SHOWN, UNLESS OTHERWISE NOTED, IS CENTERLINE STATIONING.
 4. ALL INTERIOR STREETS PROPOSED HEREIN ARE PRIVATE.
 5. ADD 2400 FEET TO ALL GRADE TAGS TO GET ACTUAL ELEVATION.
 6. FINISH FLOOR ELEVATIONS MUST BE A MINIMUM OF 6" ABOVE CROWN OR ADJACENT TOP OF CURB, WHICHEVER IS GREATER.

ABBREVIATIONS

AC	ASPHALTIC CONCRETE	RT	RIGHT-OF-WAY
BCR	BACK OF CURB	ROW	RIGHT-OF-WAY
BVC	BEGINNING OF VERTICAL CURVE	SS	STORM DRAIN
BM	BENCHMARK	SW	SANITARY SEWER
BW	BOTTOM OF WALL	ST	STATION
CATV	CABLE TELEVISION	STD	STANDARD
CC	CENTERLINE	SVZ	STREET LIGHT
CC	CLARK COUNTY	TC	TIGHT VISIBILITY ZONE

CURVE TABLE

No.	Radius	Delta	Length	Tangent
C1	25.00'	137°42'	5.78'	2.90'
C2	45.00'	107°00'	84.98'	61.50'
C3	25.00'	37°05'	16.19'	8.39'
C4	45.00'	66°30'	52.94'	29.92'
C5	25.00'	44°58'	18.62'	10.35'
C6	25.00'	05°21'	2.34'	1.17'
C7	20.00'	92°15'	32.20'	20.80'
C8	25.00'	92°12'	40.23'	25.94'
C9	25.00'	87°44'	30.63'	19.23'
C10	25.00'	16°43'	7.09'	3.57'
C11	25.00'	16°15'	7.09'	3.57'



PRIVATE STREET NOTE

ALL PRIVATE STREETS ARE P.U.E.'S. PUBLIC SEWER EASEMENTS AND PUBLIC DRAINAGE EASEMENTS TO BE PRIVATELY MAINTAINED.

BENCHMARK

CITY OF LAS VEGAS BENCHMARK 0LV10-4E4
RIVET AND SQUARE ALUMINUM PLATE IN TOP OF CURB AT NORTHWEST CORNER OF BUFFALO AND OAKLEY
NAVD88 ELEVATION= 771.6247 METERS (2531.57 FT) 54999

SCALE

GRAPHIC SCALE
1 inch = 40 ft

EARTHWORK

TOTAL FOR OVERALL DEVELOPMENT: 6,750 CY FILL, 4,500 CY CUT

GEOTECHNICAL

TERRACON
4343 POLARIS AVENUE
LAS VEGAS, NEVADA 89103
702-597-9393
PROJECT NUMBER: 64965201
DATE: JUNE 6, 1996

CONSTRUCTION NOTES

1. 24" L-TYPE CURB & GUTTER (USD #216)
2. SIDEWALK RAMP CASE I, A=8.0', B=8.0' (USD #235)
3. 4" CONCRETE SIDEWALK (USD #234)
4. 8" CROSS GUTTER (PER USD #228)
5. SAWCUT & MATCH EXISTING AC PAVEMENT
6. 2" AC PAVING, 6" MIN TYPE I, 4" MIN TYPE II
7. 4" AC PAVING, 9" MIN TYPE I OR TYPE II
8. 30" ROLL-TYPE CURB & GUTTER (USD #217A)
9. 4" CONCRETE VALLEY GUTTER
10. SIDEWALK RAMP CASE I, A=9.5', B=4.5' (USD #235)

GRADING CERTIFICATION

"THIS GRADING PLAN IS IN COMPLIANCE WITH THE APPROVED DRAINAGE STUDY ON FILE WITH AT THE CITY OF LAS VEGAS PUBLIC WORKS DEPARTMENT"

EDWARD F. TANEY, P.E. #9903 1.14.07 DATE


LEGAL DESCRIPTION

A PORTION OF THE SOUTHEAST QUARTER (SE 1/4) OF THE SOUTHEAST QUARTER (SE 1/4) OF THE NORTHWEST QUARTER (NW 1/4) OF SECTION 3, TOWNSHIP 21 SOUTH, RANGE 60 EAST, M.D.M. APN # 163-03-212-001 THROUGH 163-03-212-009

GRADING PLAN

TENAYA & OAKLEY A PLANNED UNIT DEVELOPMENT


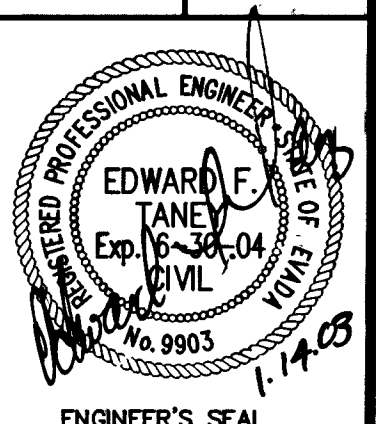

DATE: 03-10-02
SCALE: 1"=40'
JOB NO: TRP-01-003
DESIGNED BY: RDC
DRAWN BY: RDC
SHEET NAME: G1
SHEET: 3 OF 11