


REV	DATE	BY	REVISION
1	2-19-85	DRK	REV. PER CLY REVIEW
2	4/30/85	DRK	REMP 5' STUB FROM FUTURE LATERALS

ENGINEERS & SURVEYORS INCORPORATED
 7022 W. CHARLESTON BLVD.
 LAS VEGAS, NEVADA 89117
 PHONE: 702 / 363-6415

SUBMITTED BY: *[Signature]*
 1/16/85

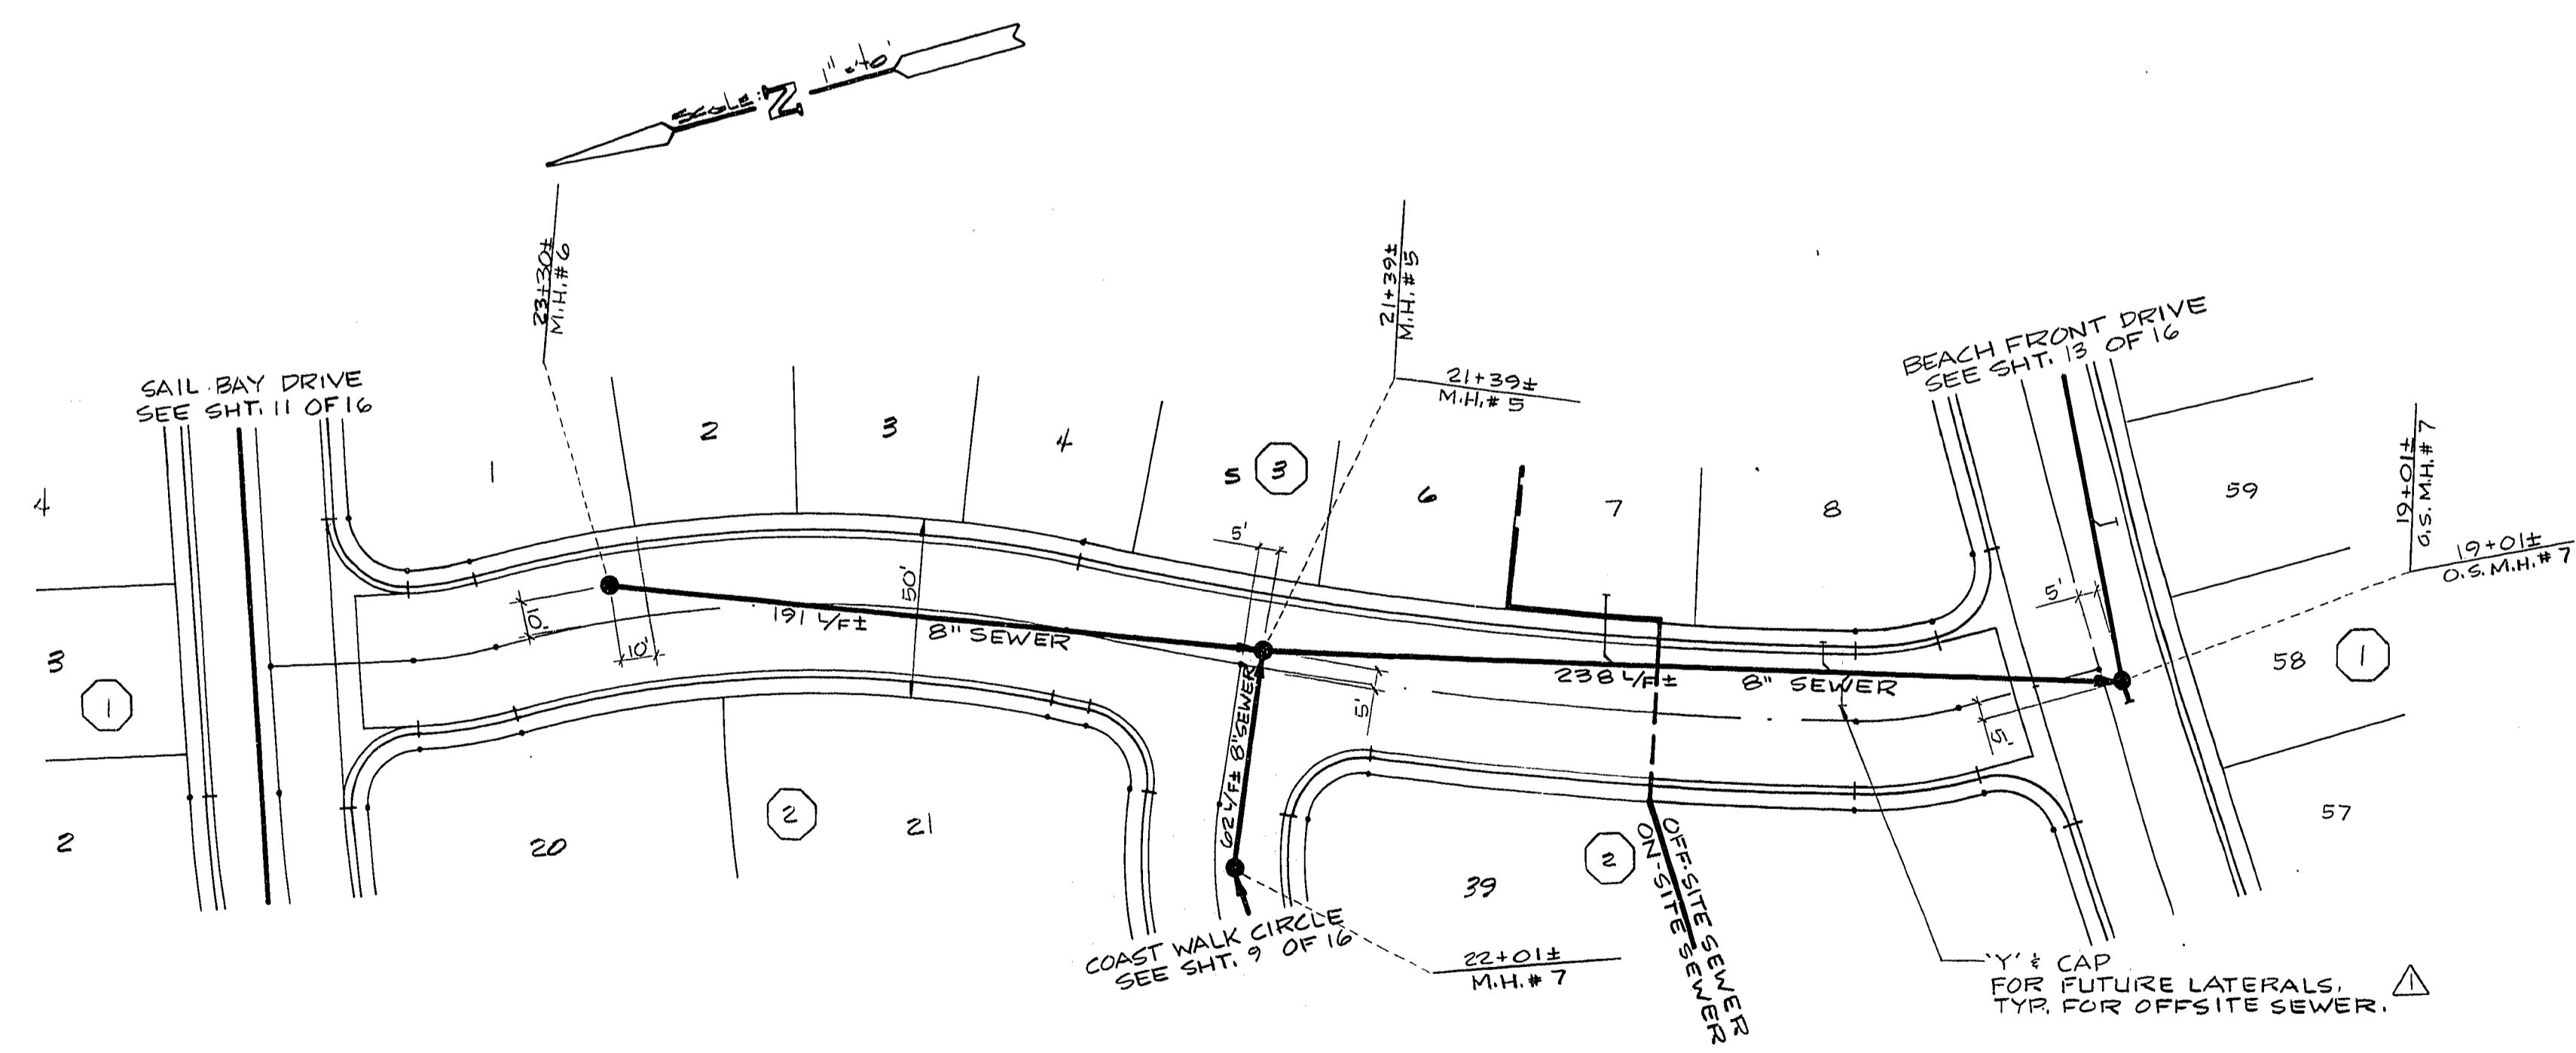

BODEGA BAY STREET

TITLE
 SEWER PLAN & PROFILE
 BODEGA BAY STREET
 PROJECT
 THE BLUFFS UNIT NO. 2

WO NO.	841201-2
BY	D. REED
DATE	12/31/84
SCALE	HORIZ. 1"=40' VERT. 1"=4'

APPROVAL
[Signature]
 CIVIL SANITATION ENGR' R. DATE 6-12-85

SHEET	10
OF 16 SHEETS	10

19-6-204 3074-911-2