

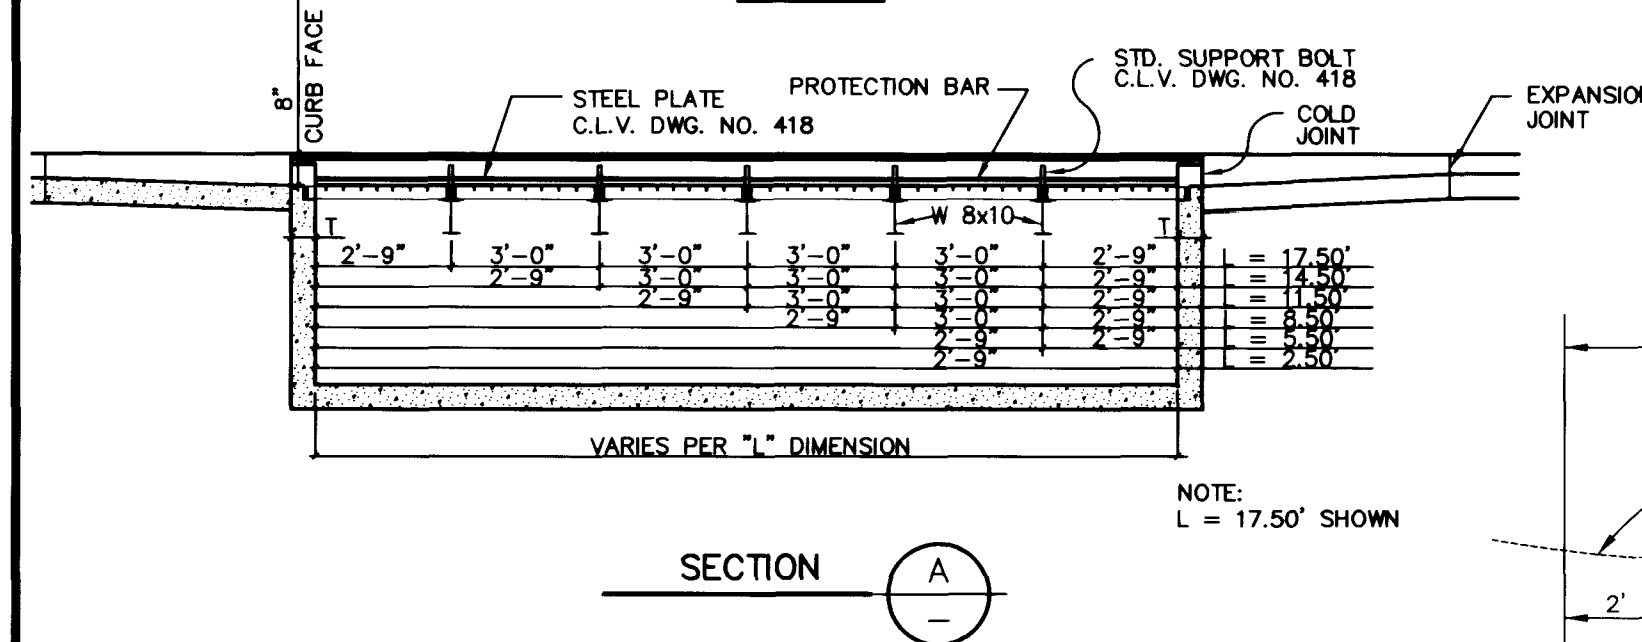


"D"	"T"
2'-0" TO 8'-0"	6"
8'-1" TO 20'-0"	8"

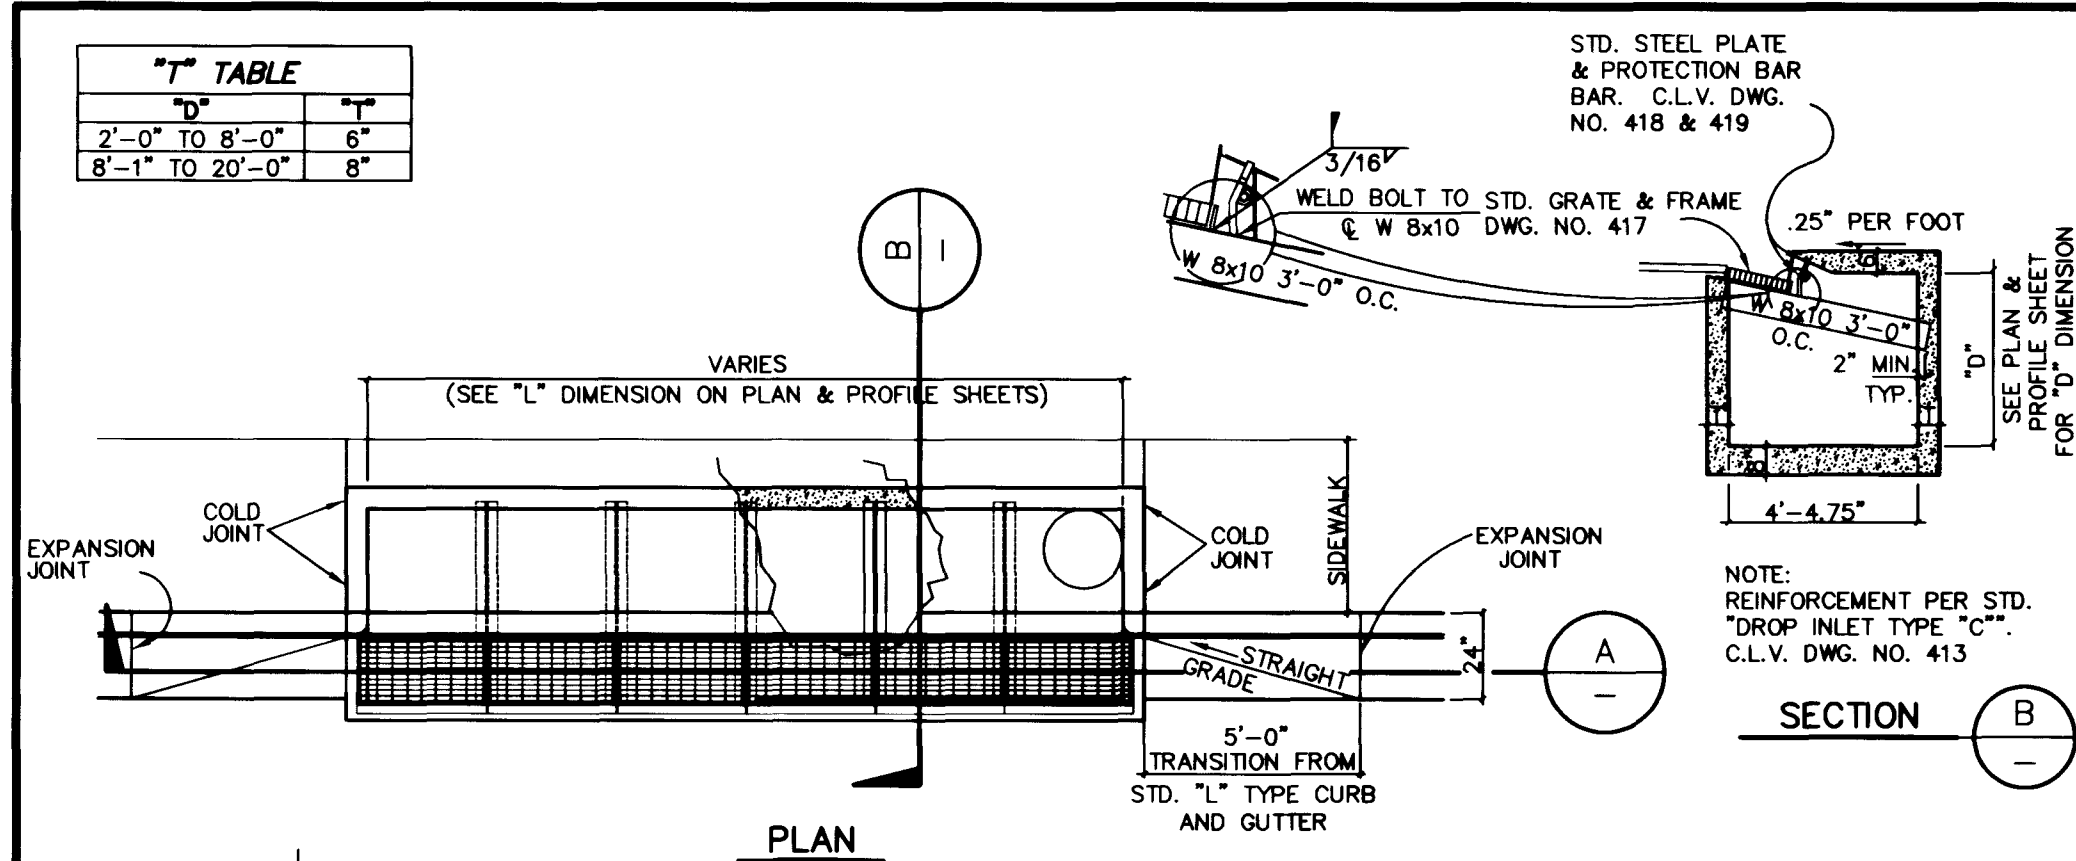


8 MODIFIED TYPE "C" DROP INLET

SCALE:

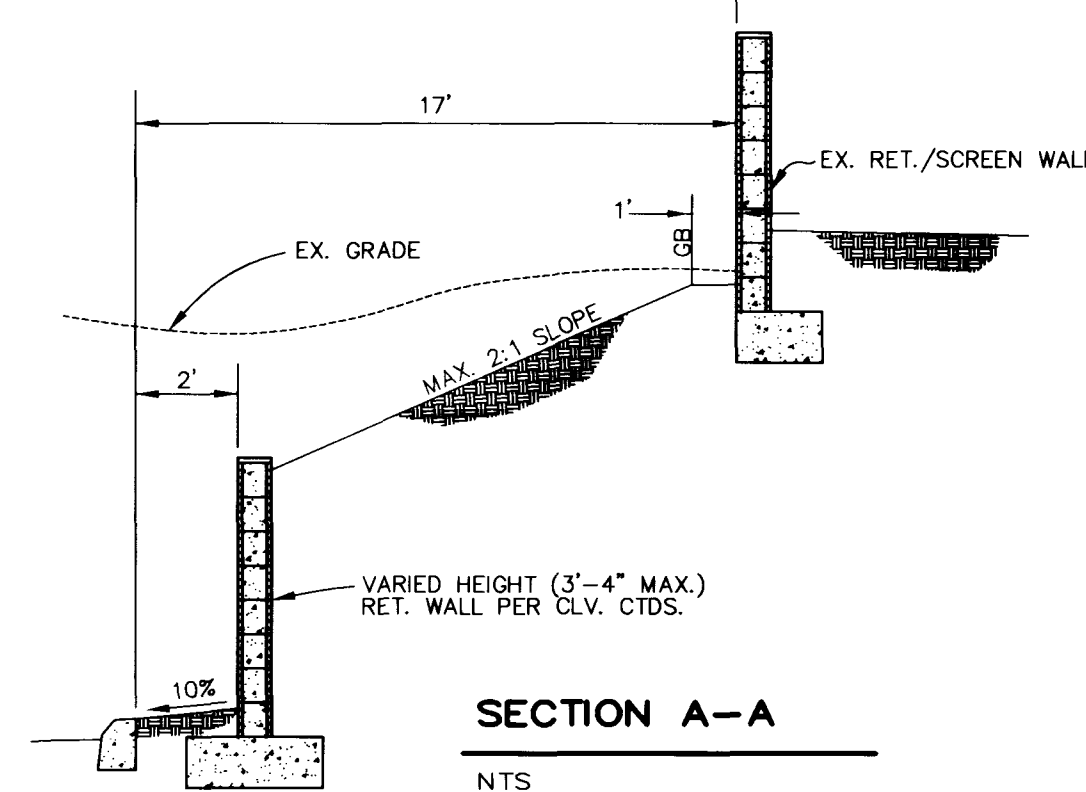


SECTION A-A

SECTION D-D

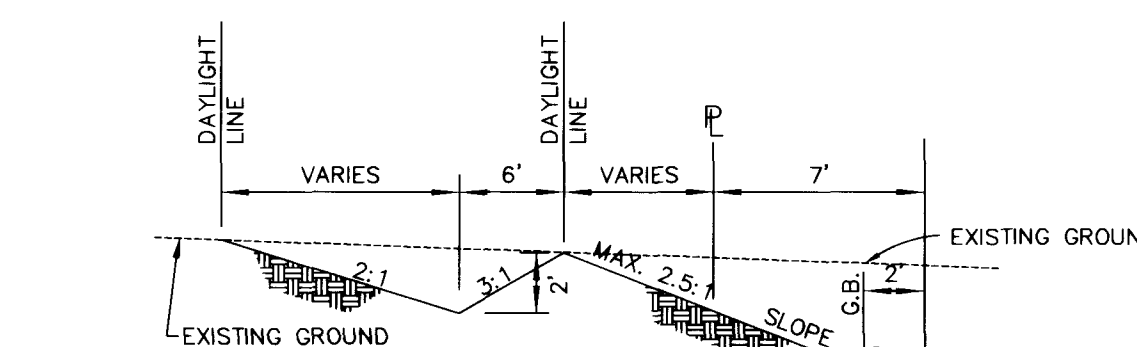


SECTION B-B

NTS

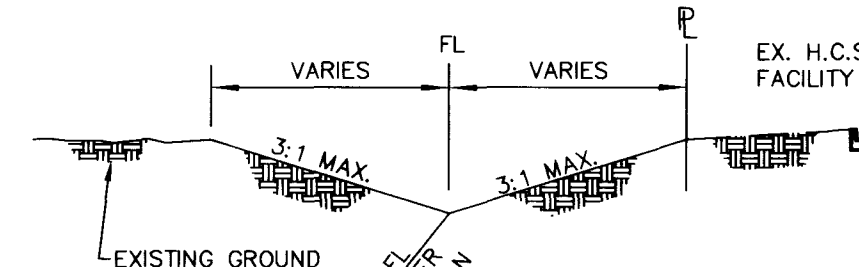


SECTION D-D

NTS

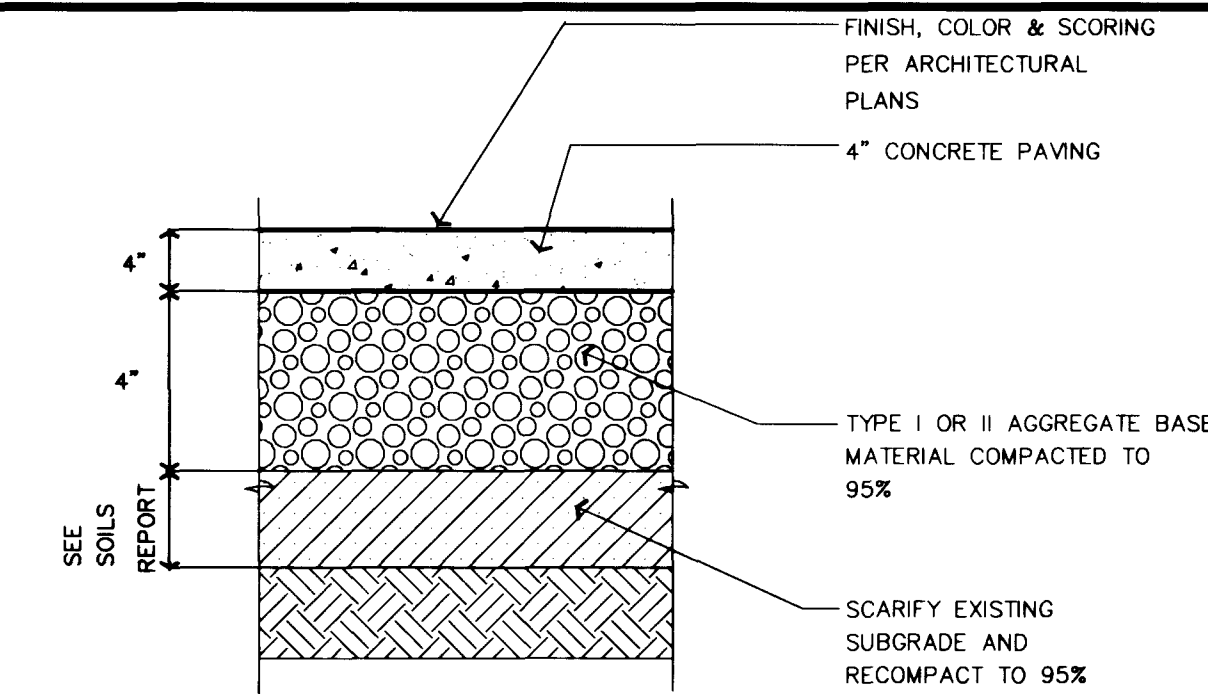


 TYPICAL CONCRETE SECTION

SCALE: 1" = 1'-0"

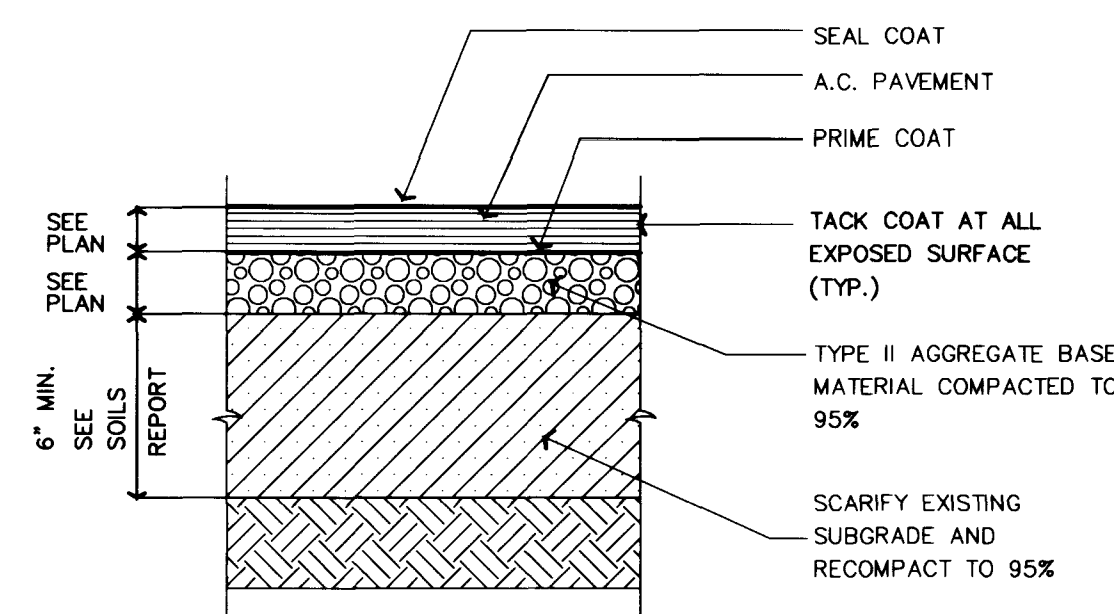
 TYPICAL PAVING SECTION

SCALE: 1" = 1'-0"

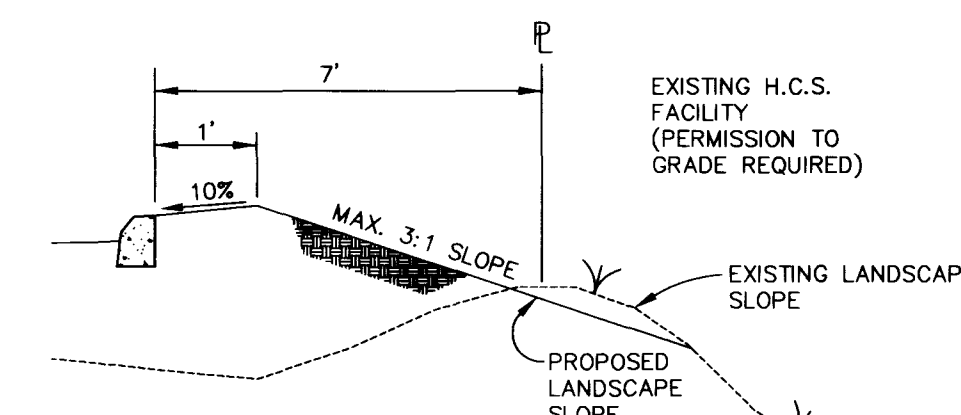


SECTION C-C

NT

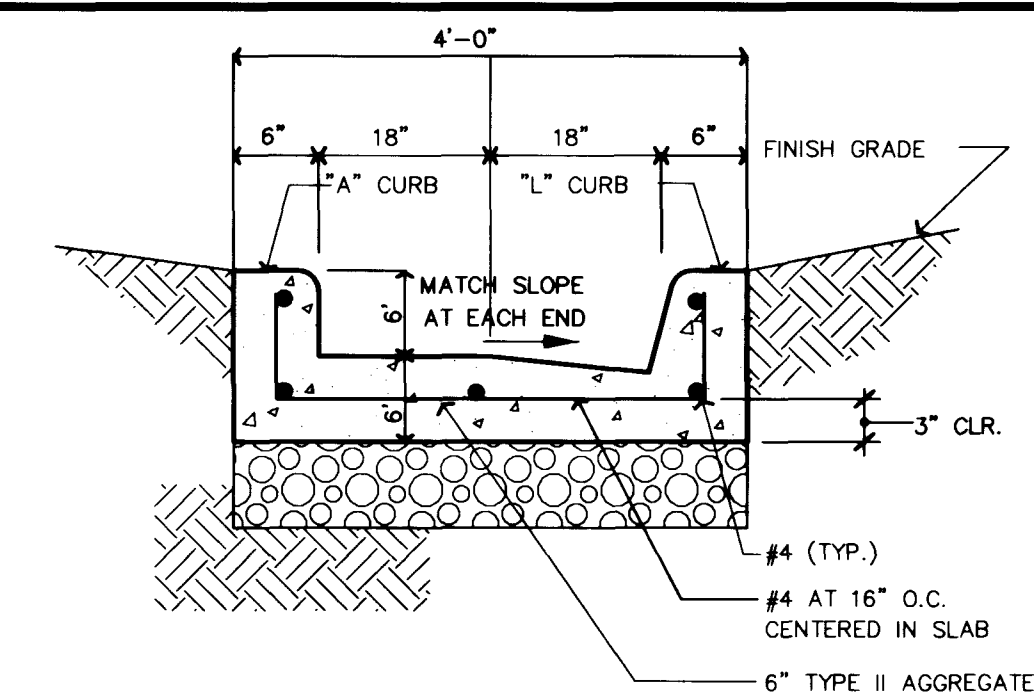


MODIFIED CHANNEL DETAIL

SCALE: N.T.S.

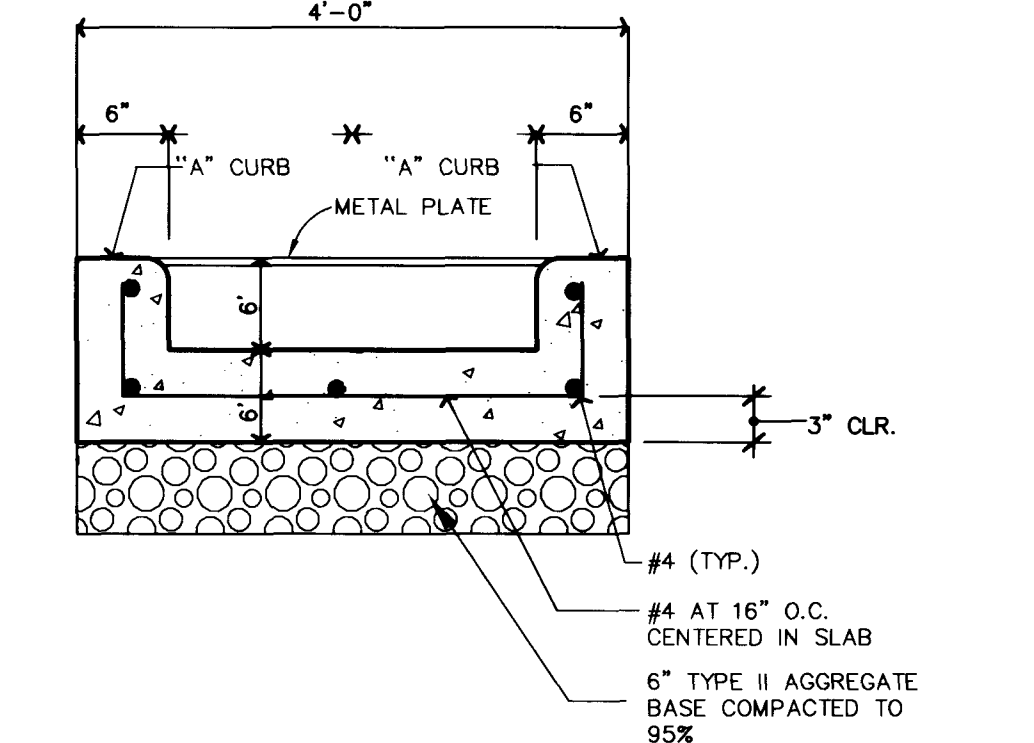


 CHANNEL DETAIL (NOT USED)

SCALE: N.T.S.

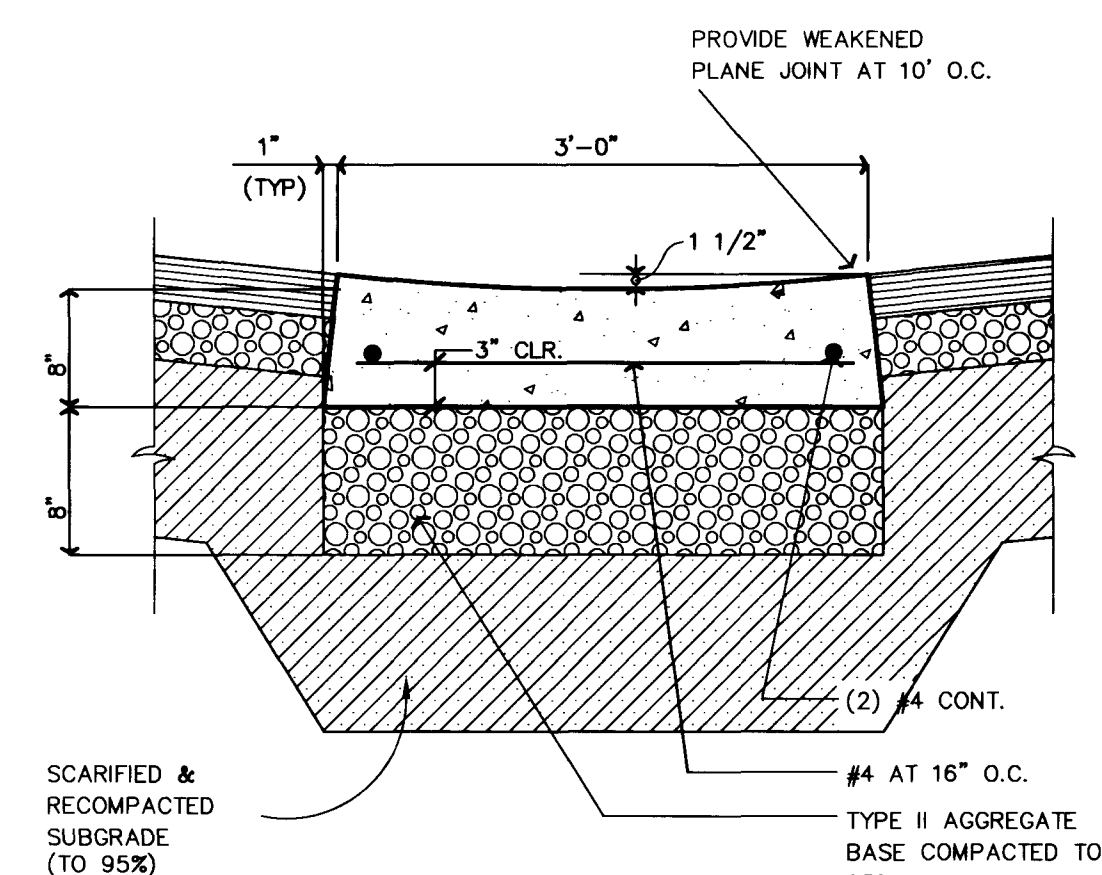

CONCRETE VALLEY GUTTER DETAIL

SCALE: N.T.S.

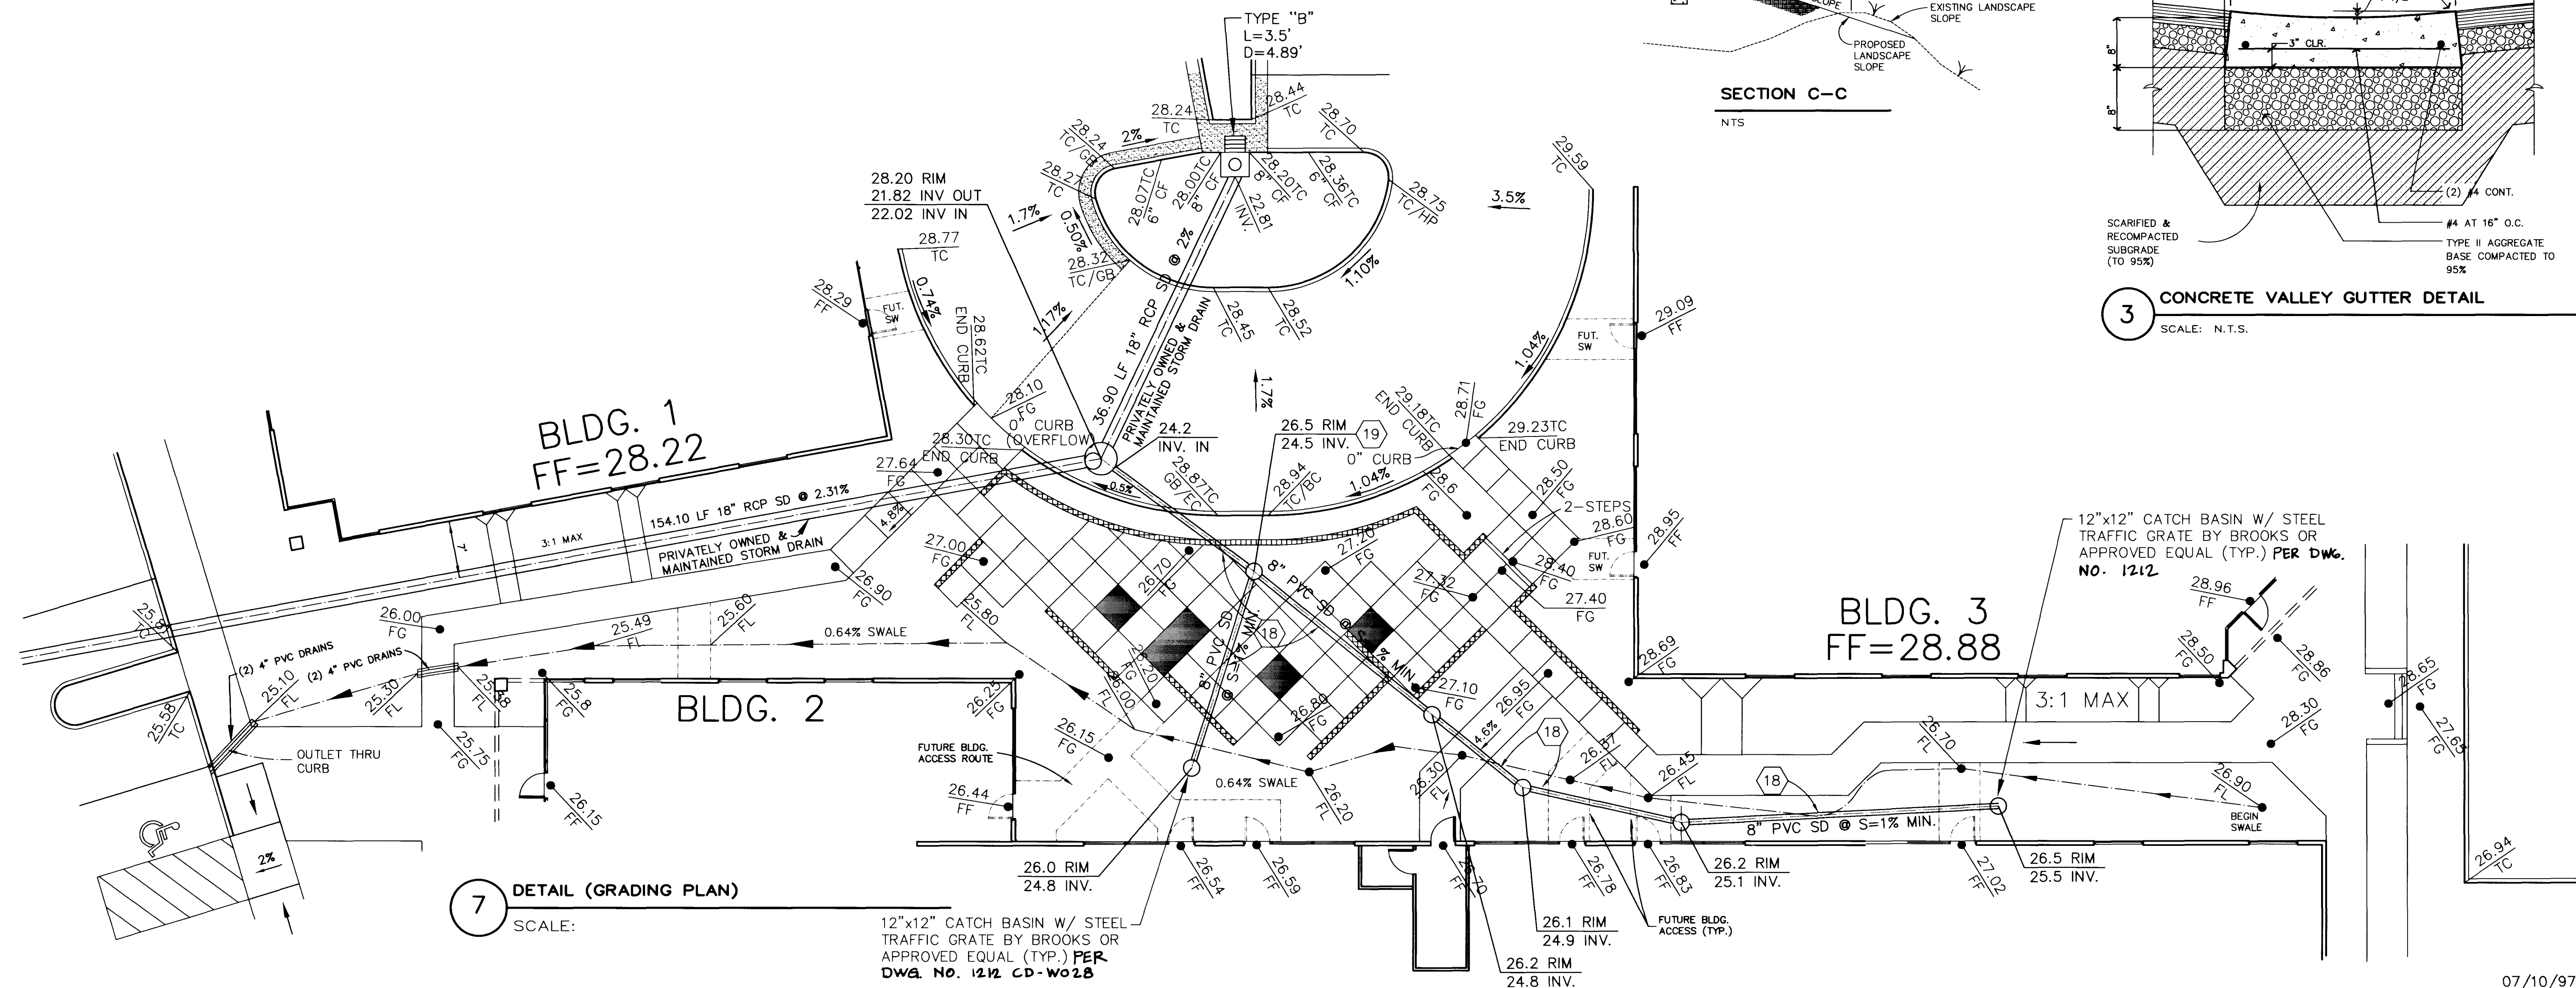

DETAIL (GRADING PLAN)

SCALE:

12"x12" CATCH BASIN W/ STEEL
TRAFFIC GRATE BY BROOKS OR
APPROVED EQUAL (TYP.) PER
DWG. NO. 1212 CD-W028

12"x12" CATCH BASIN W/ STEEL
TRAFFIC GRATE BY BROOKS OR
APPROVED EQUAL (TYP.) PER DWG.
NO. 1212

