


SURVEYOR'S CERTIFICATE

I, ELYN BRENNER, A REGISTERED LAND SURVEYOR, DO HEREBY CERTIFY THAT THE MONUMENTS HAVE BEEN SET AND THE TIES ESTABLISHED AS SHOWN HEREON.

Elyn Brenner 9-28-87
 ELYN BRENNER, R.L.S. DATE
 NEVADA CERTIFICATE NO 5088

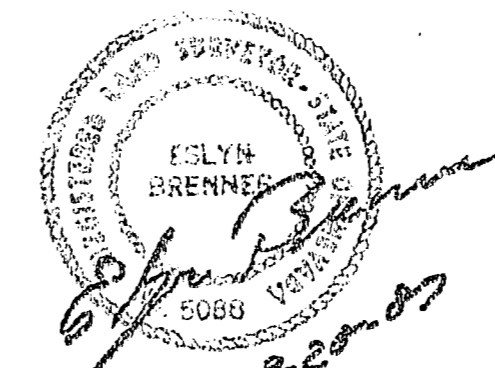

LEGEND

- ⊙ BRASS CAP SET W/RLS 5088 STAMPED ON TOP
- BRASS REFERENCE POINT SET W/DISTANCE STAMPED ON TOP.

NOTE: TIE DIMENSIONS NOT TO SCALE.

	SCALE: 1" = 40'	DESIGNED: <i>W. J. Treacy</i>	SUBMITTED:	APPROVED: DATE	R. A. HOMES THE KNOLLS SUBDIVISION	SHEET 1
REV 1 8-16-87 TL		CHECKED:	RECOMMENDED:	APPROVED: DATE	TIE MAP	OF 1 SHEETS
DATE BY DESCRIPTION						

BRENNER & ASSOCIATES, INC.
 LAND SURVEYORS
 2915 W. CHARLESTON BLVD., LAS VEGAS, NEV. 89102 / (702) 877-0317

4-6-90 2-87 058-1928