
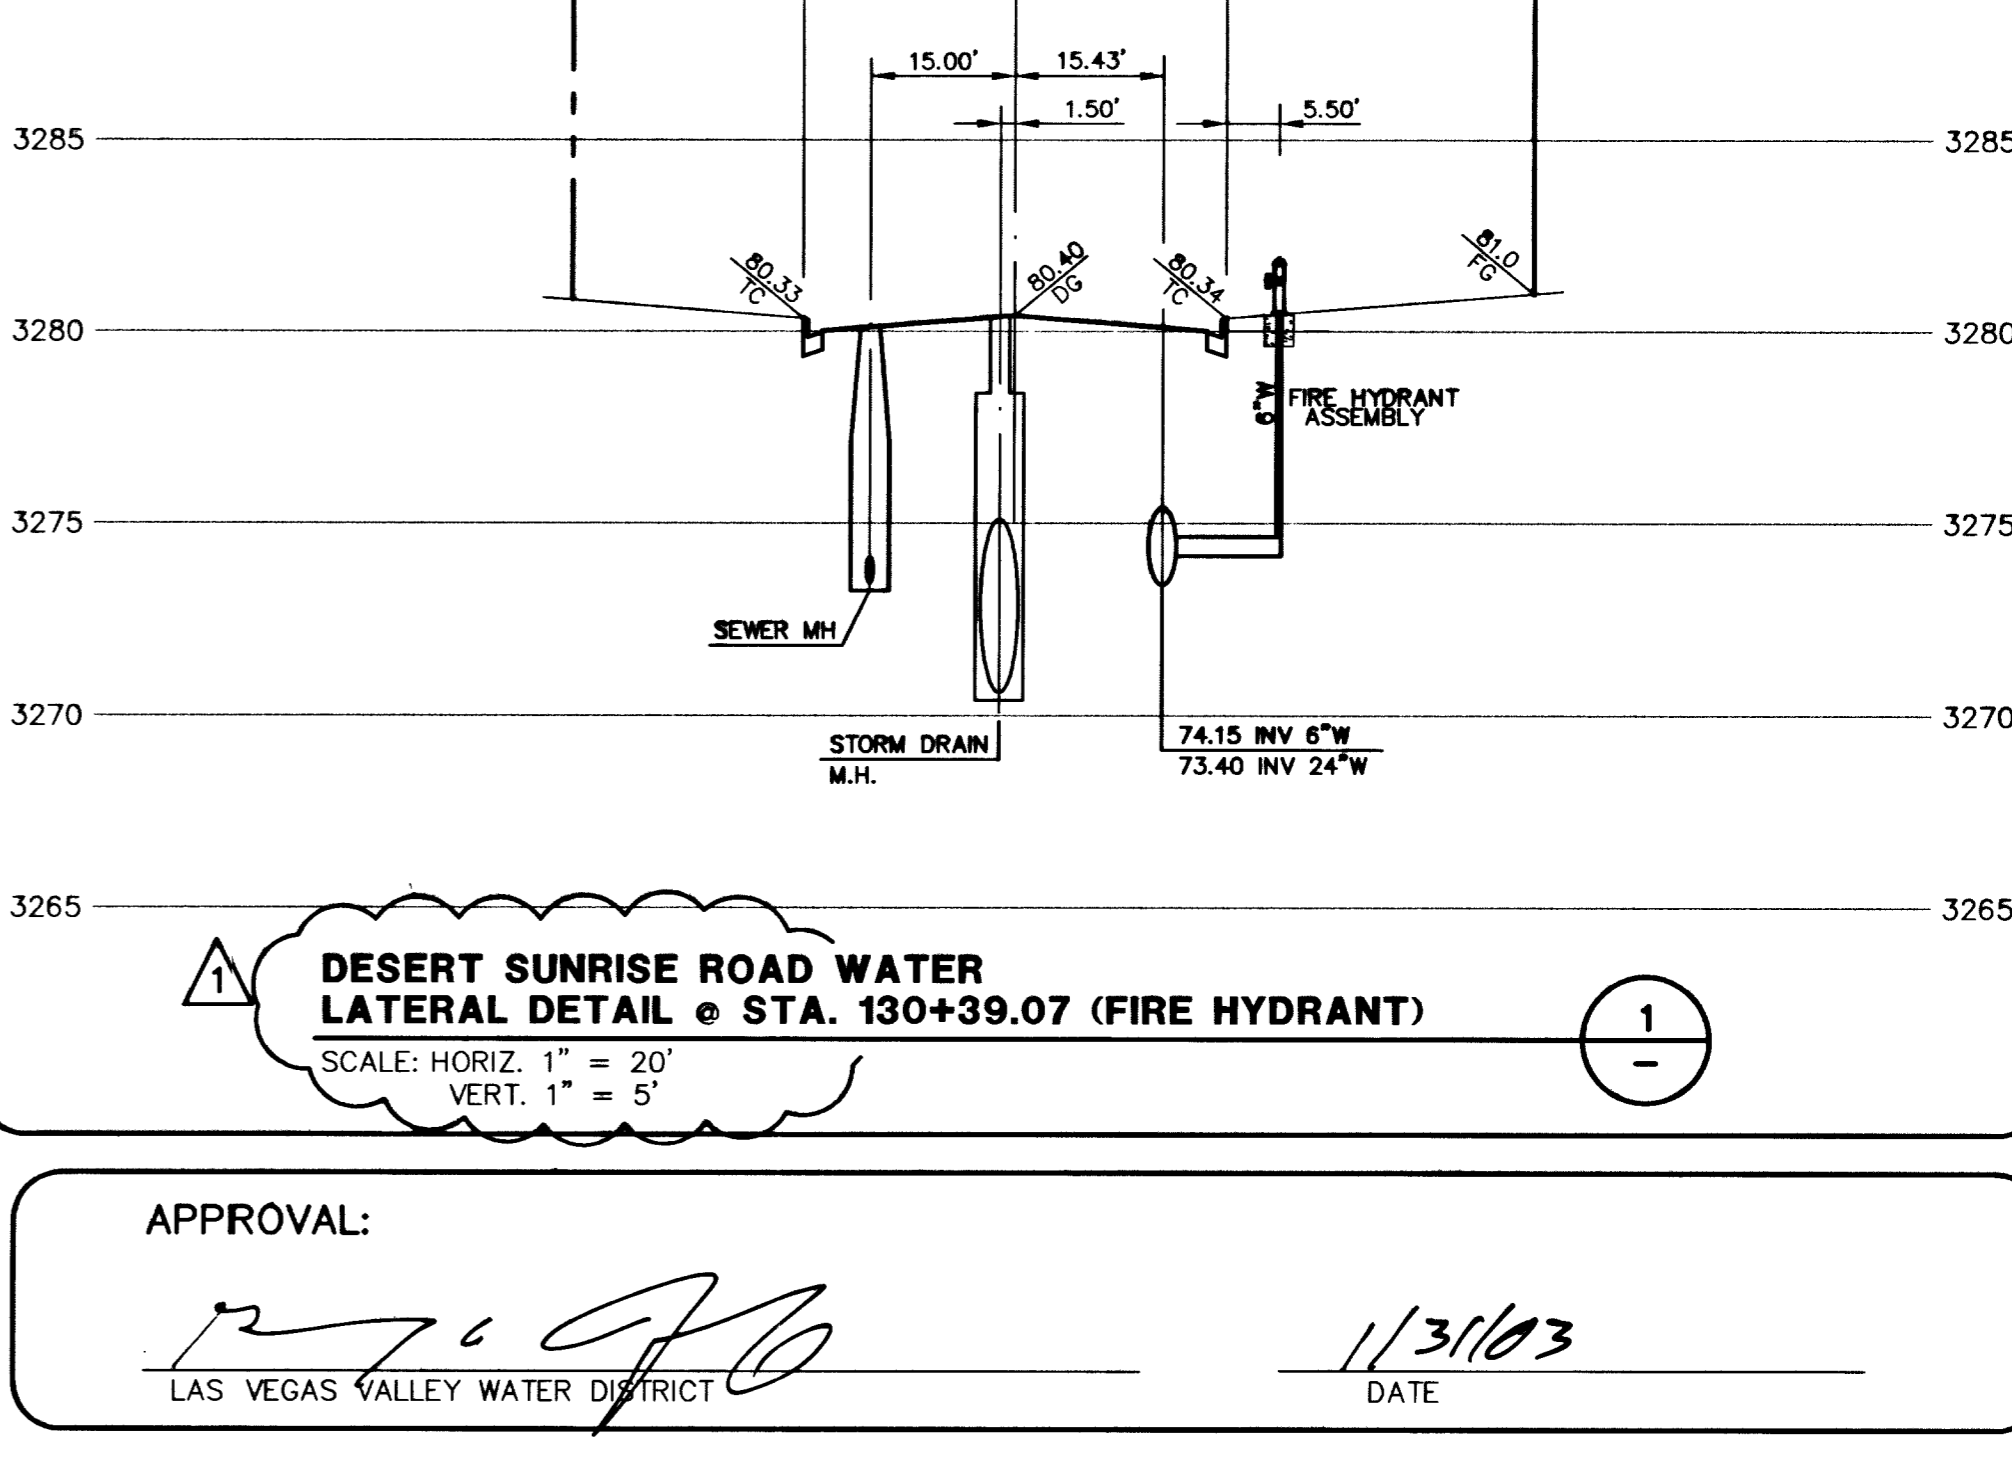
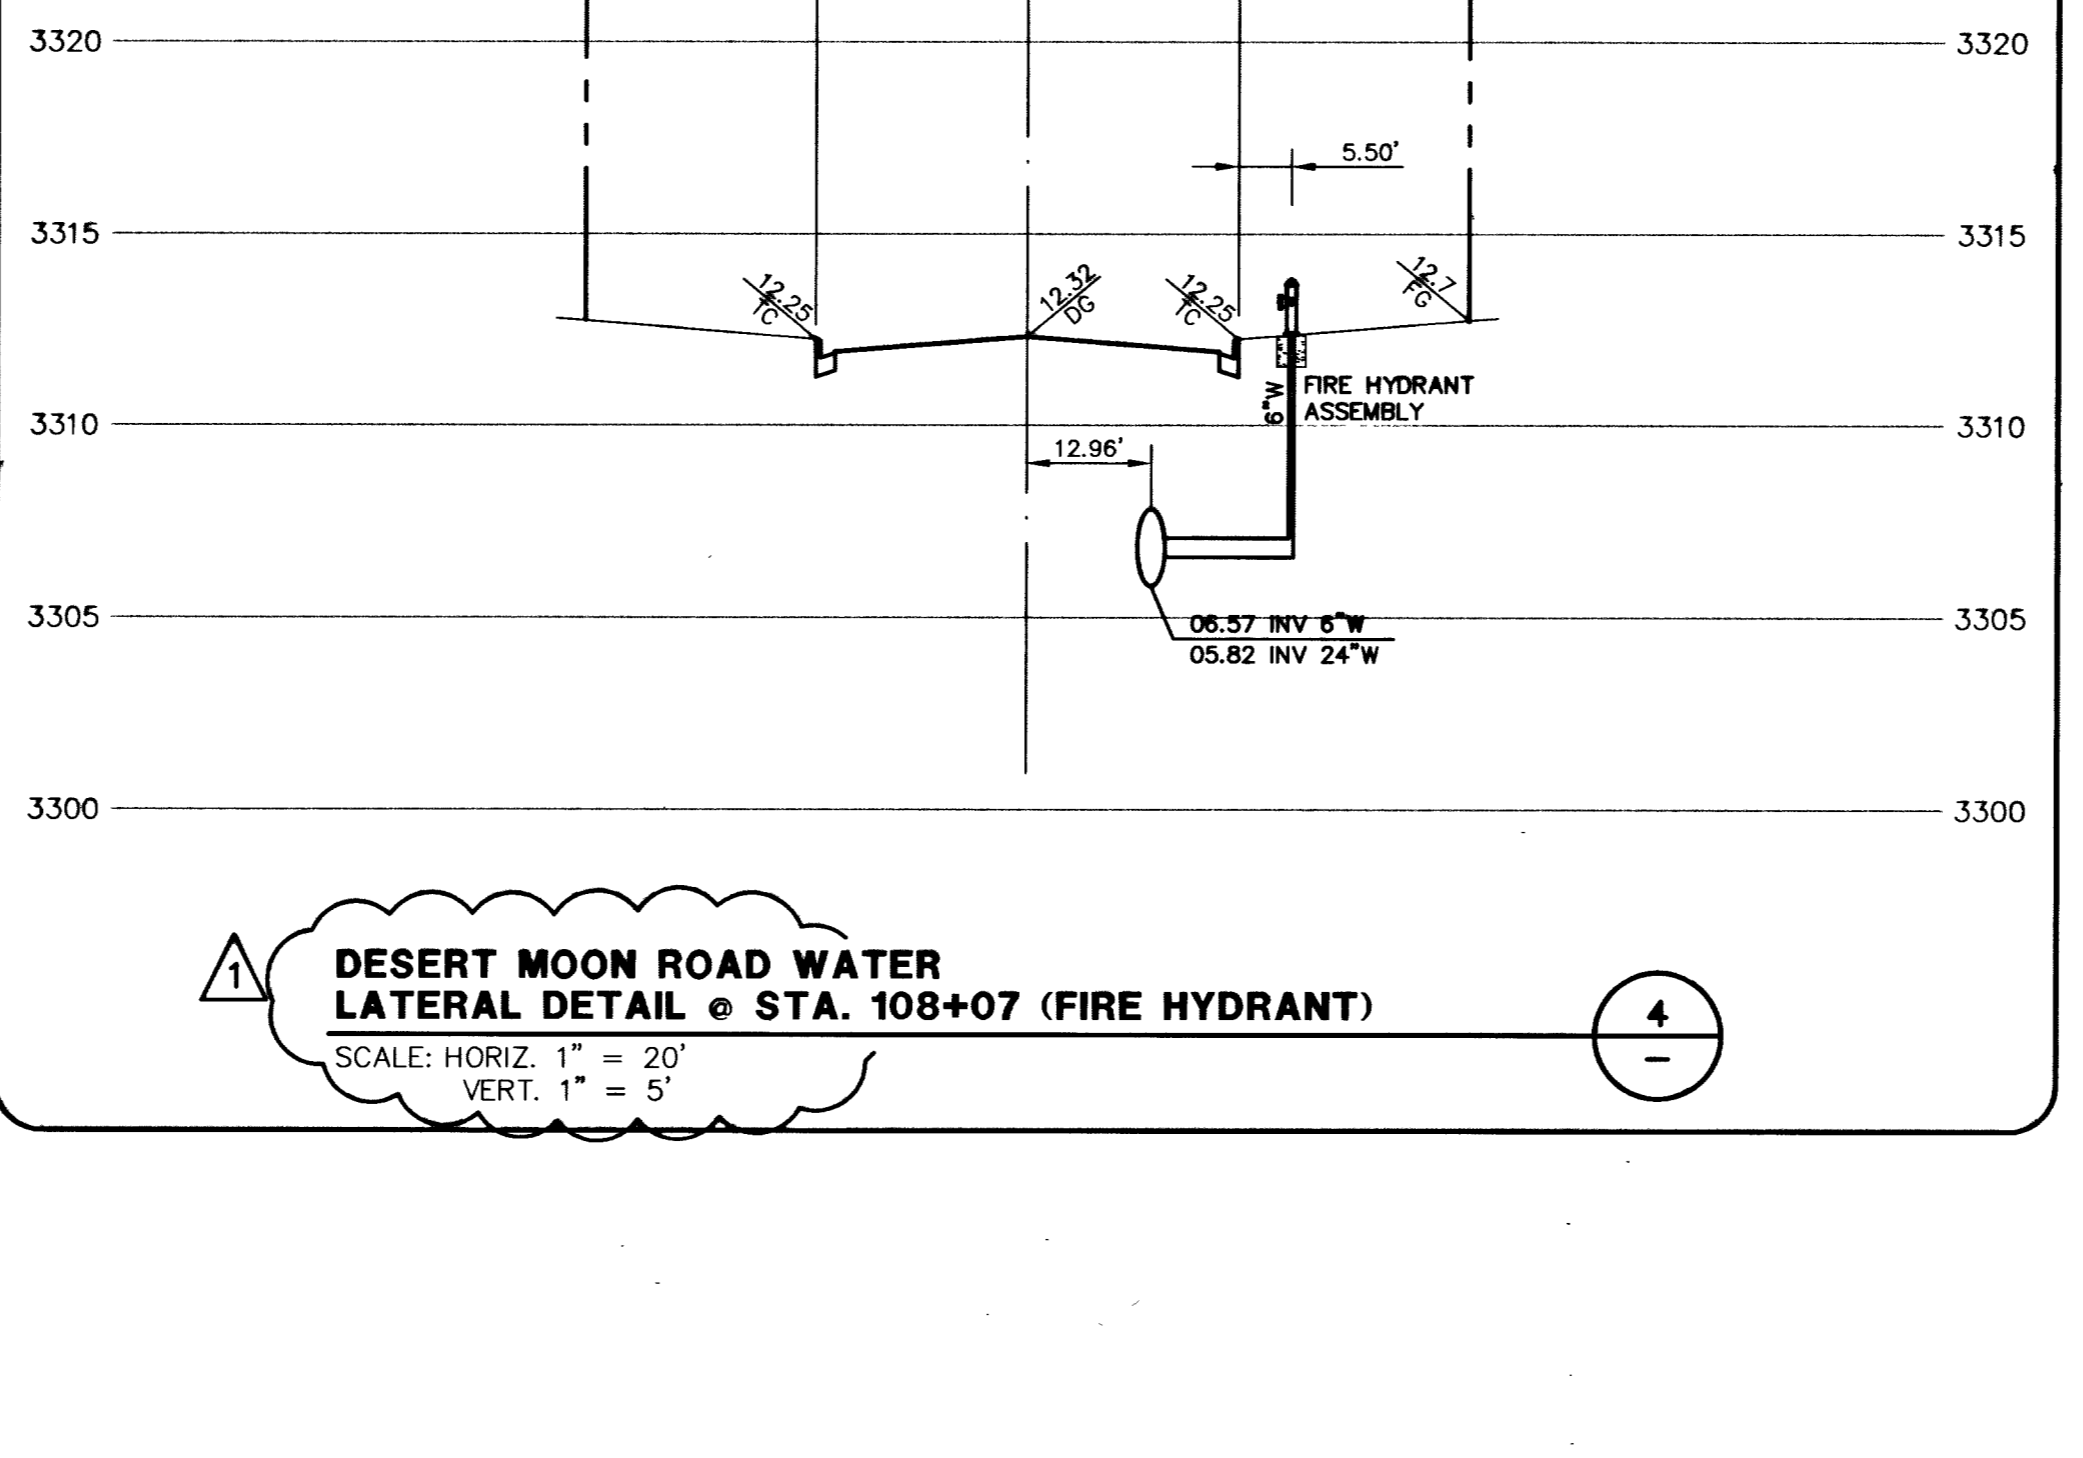
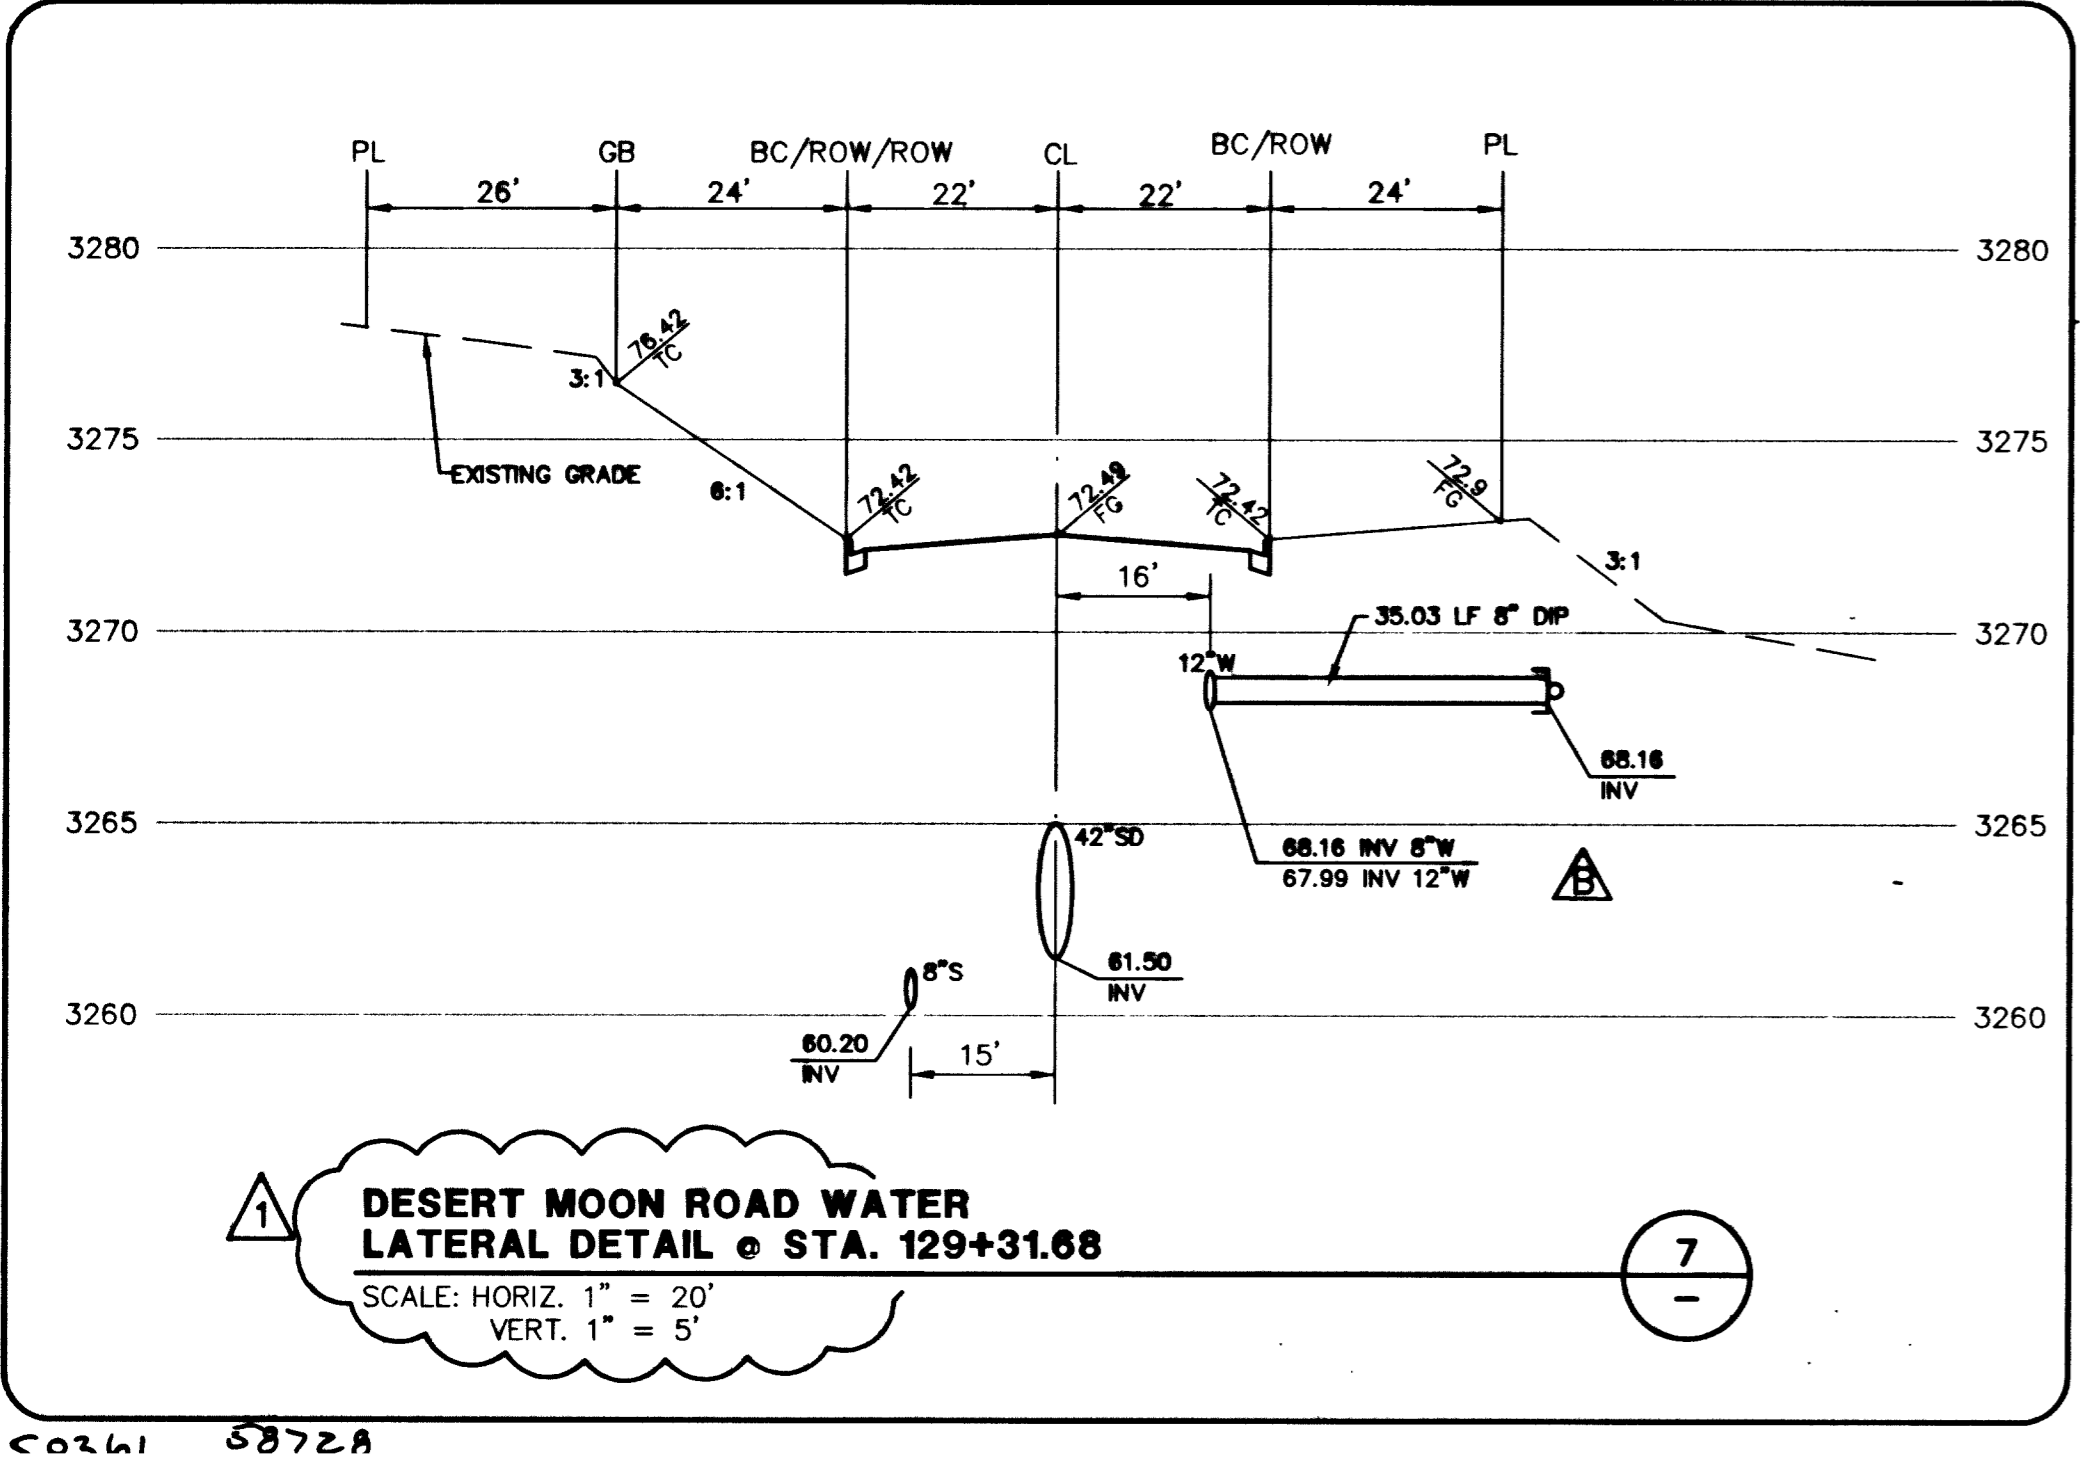
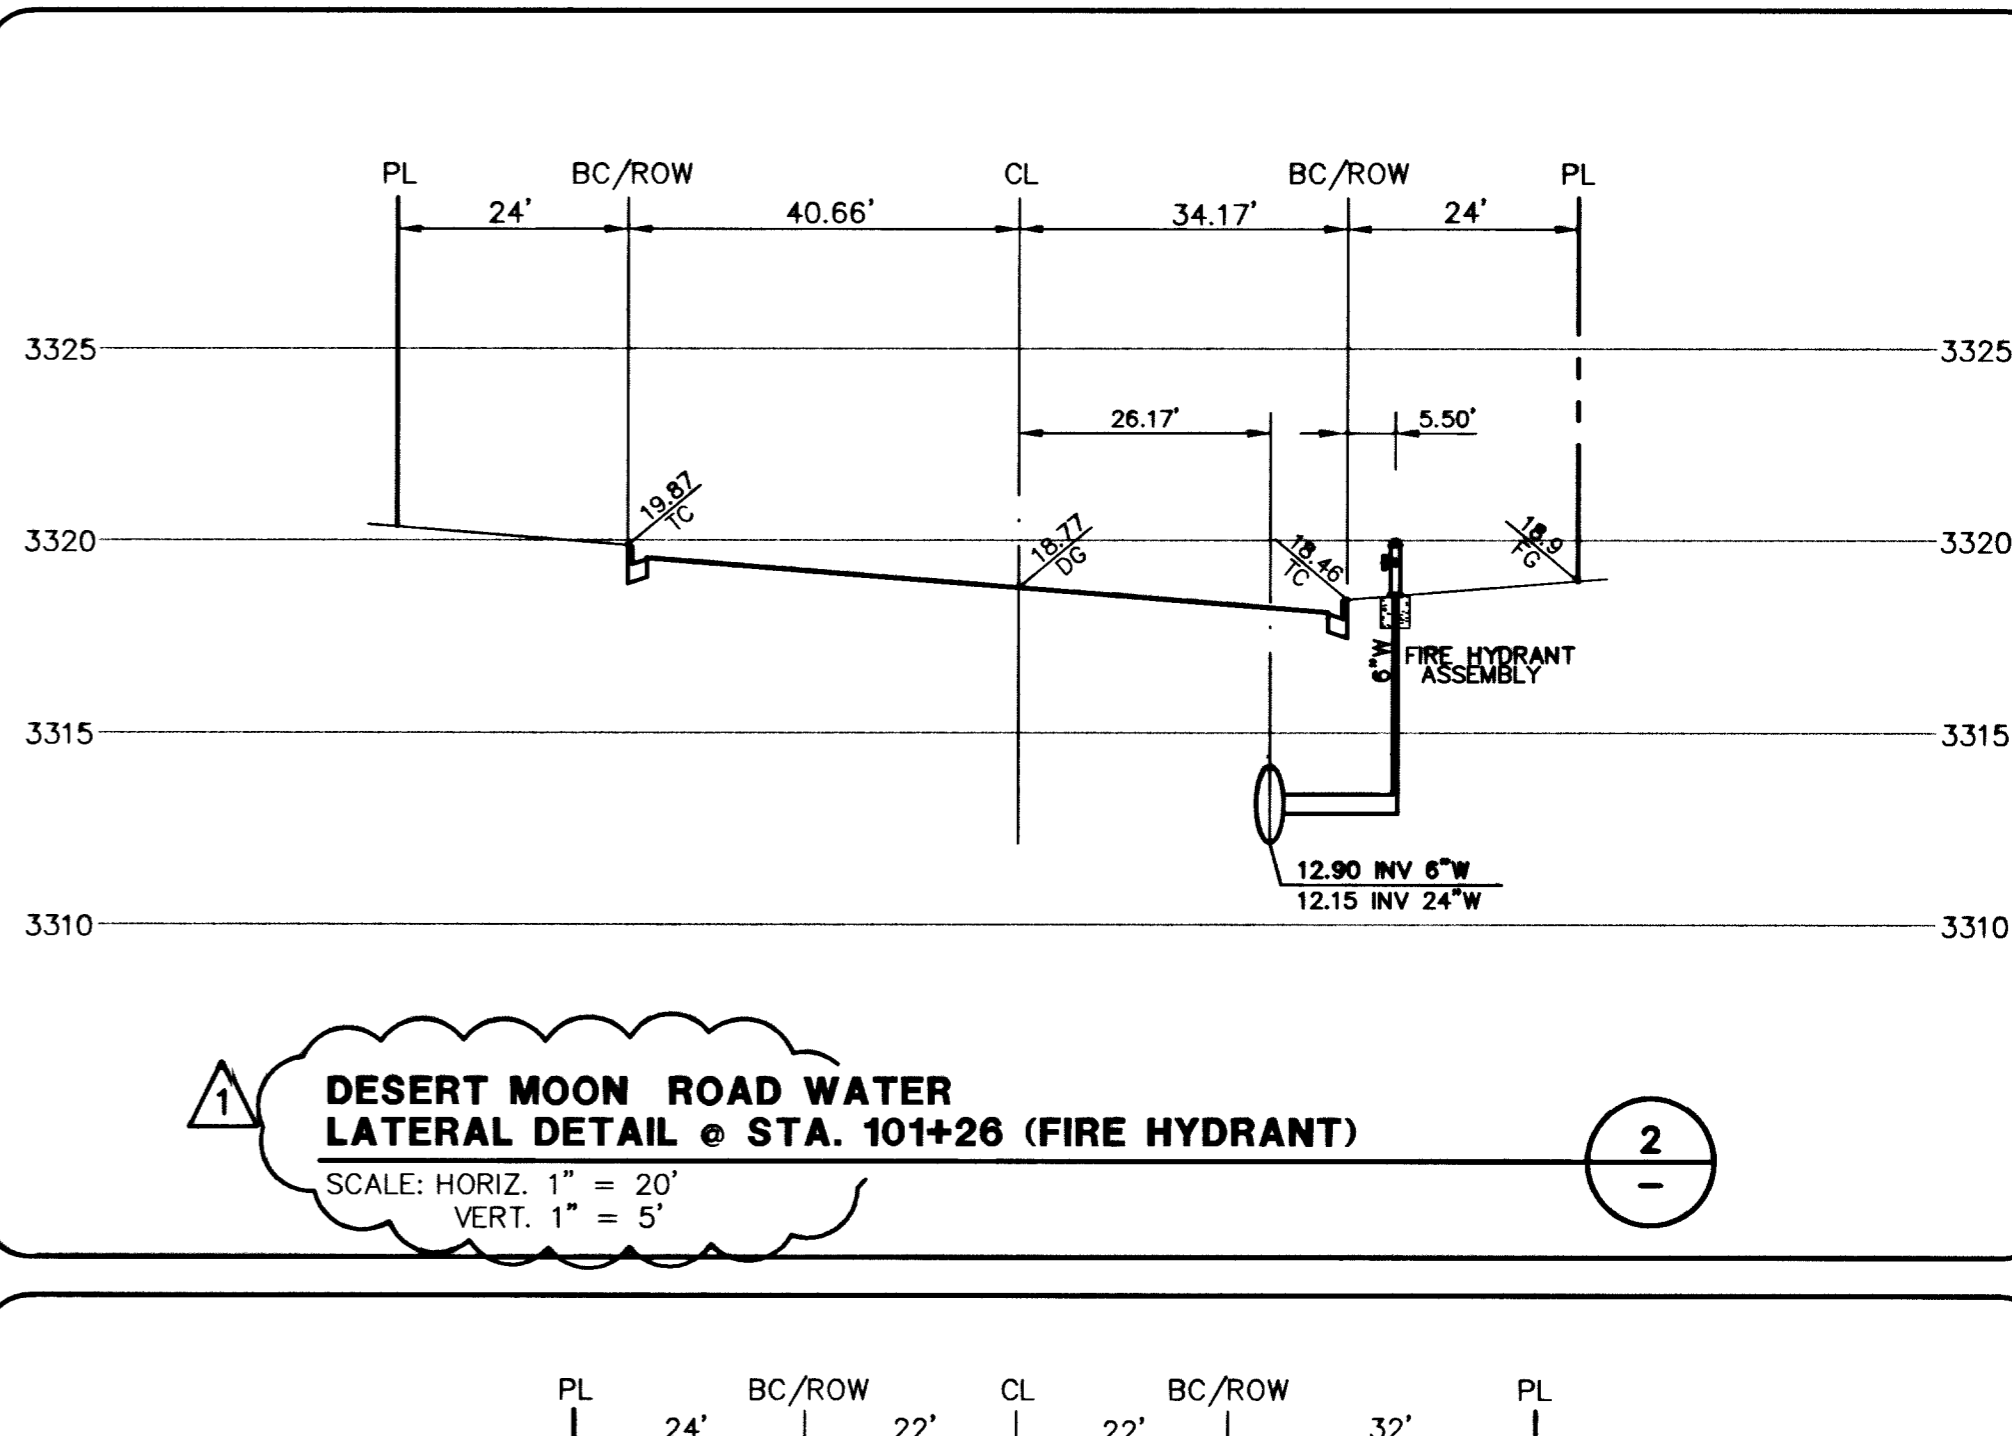
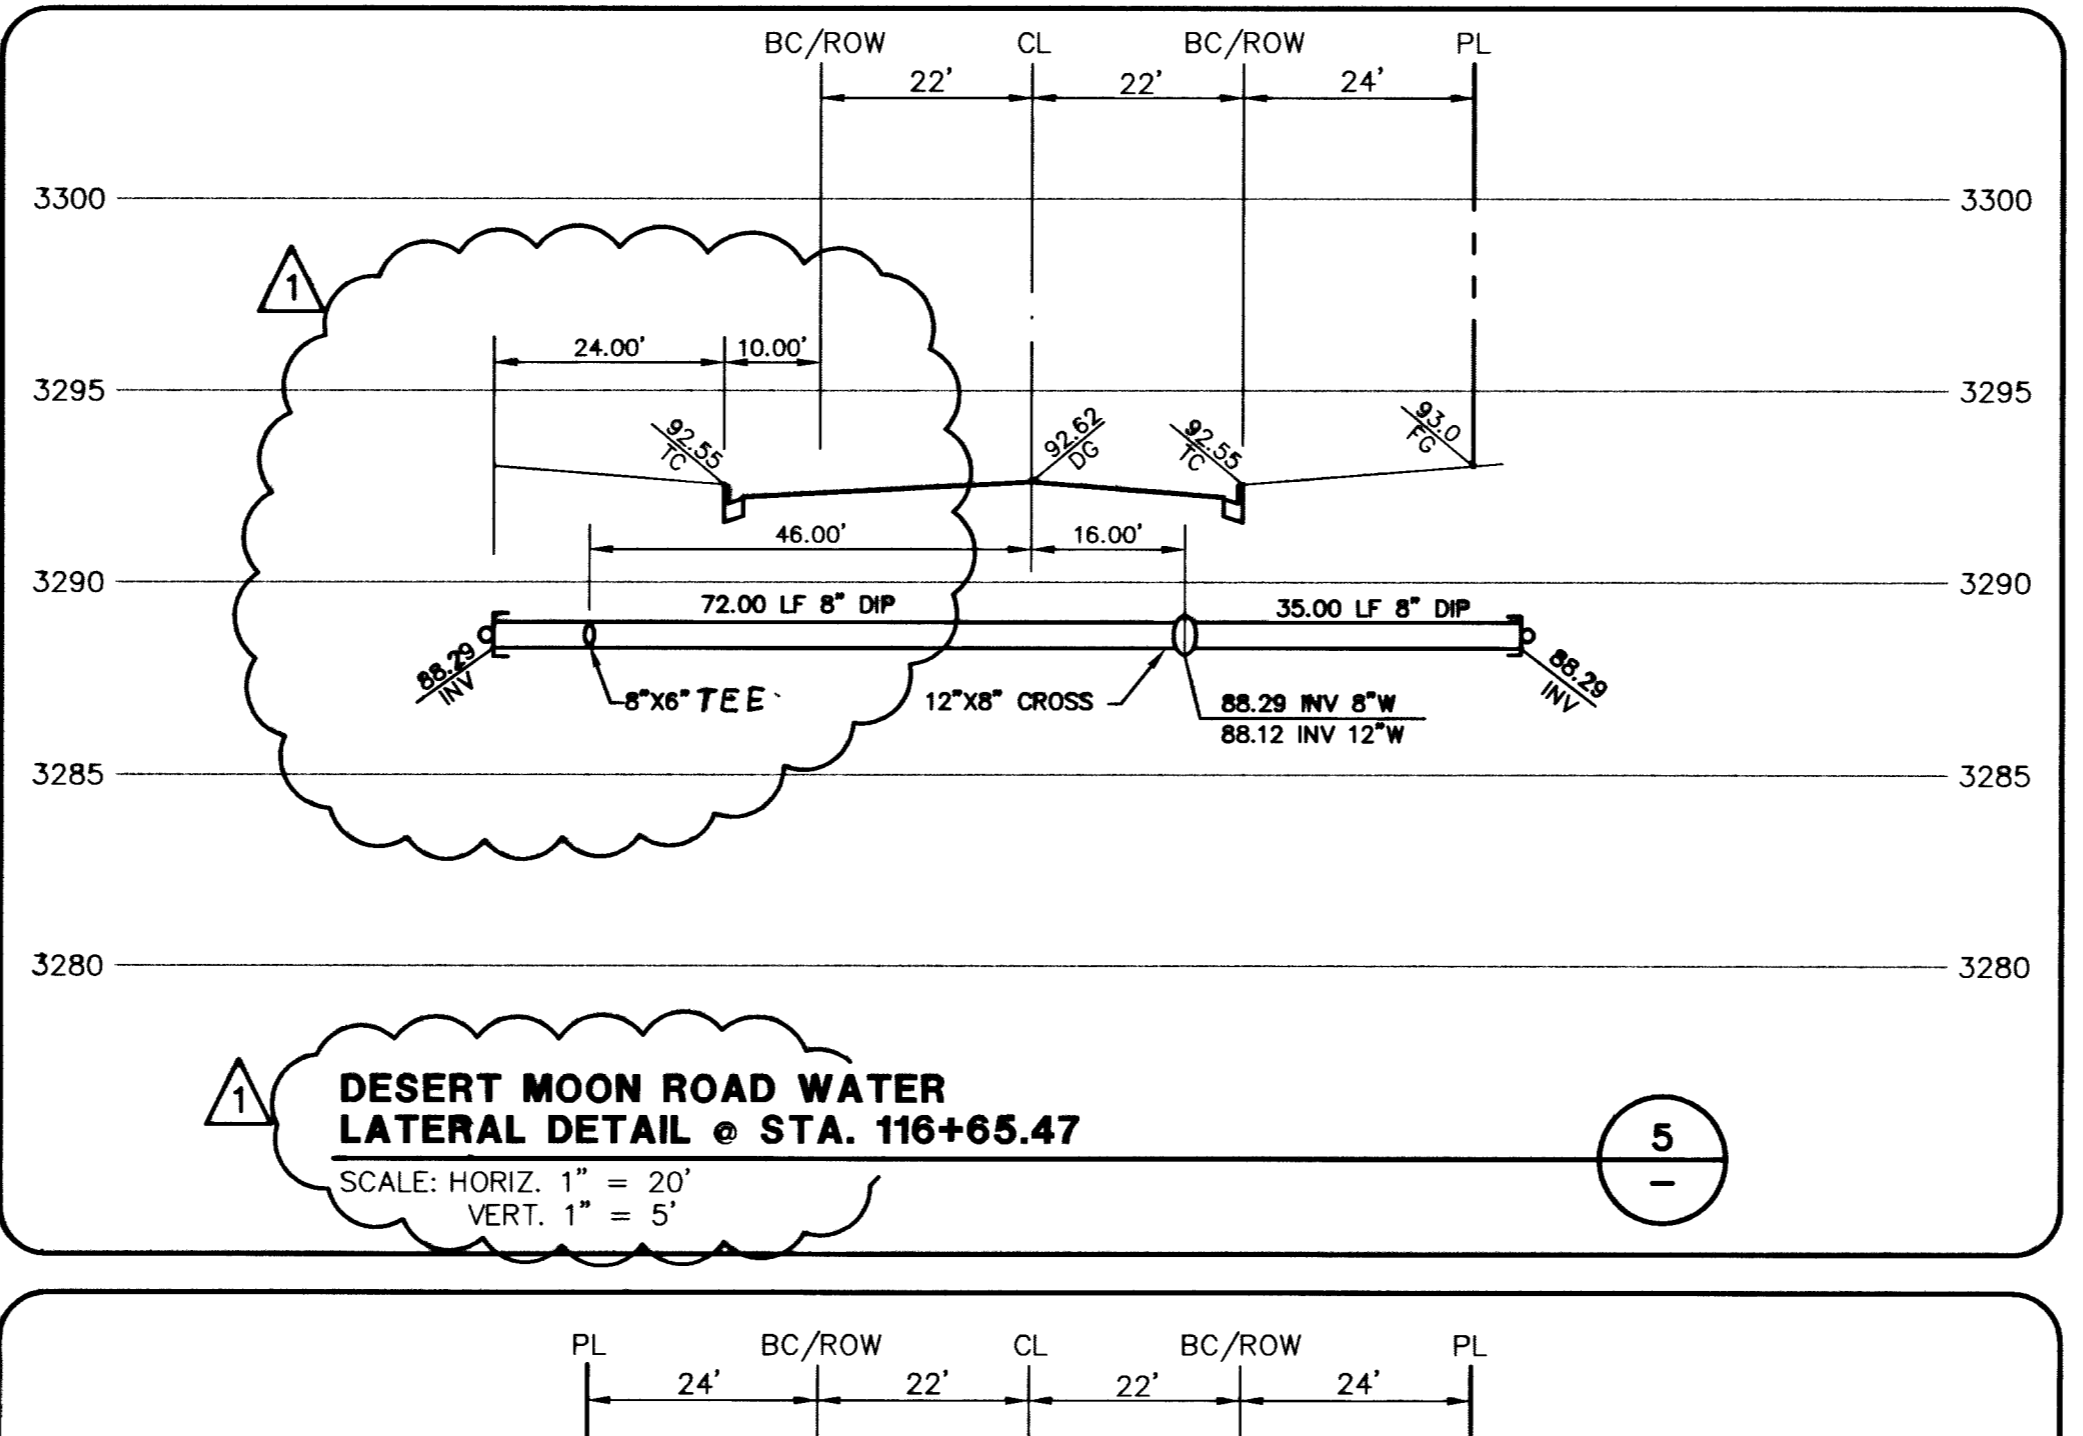
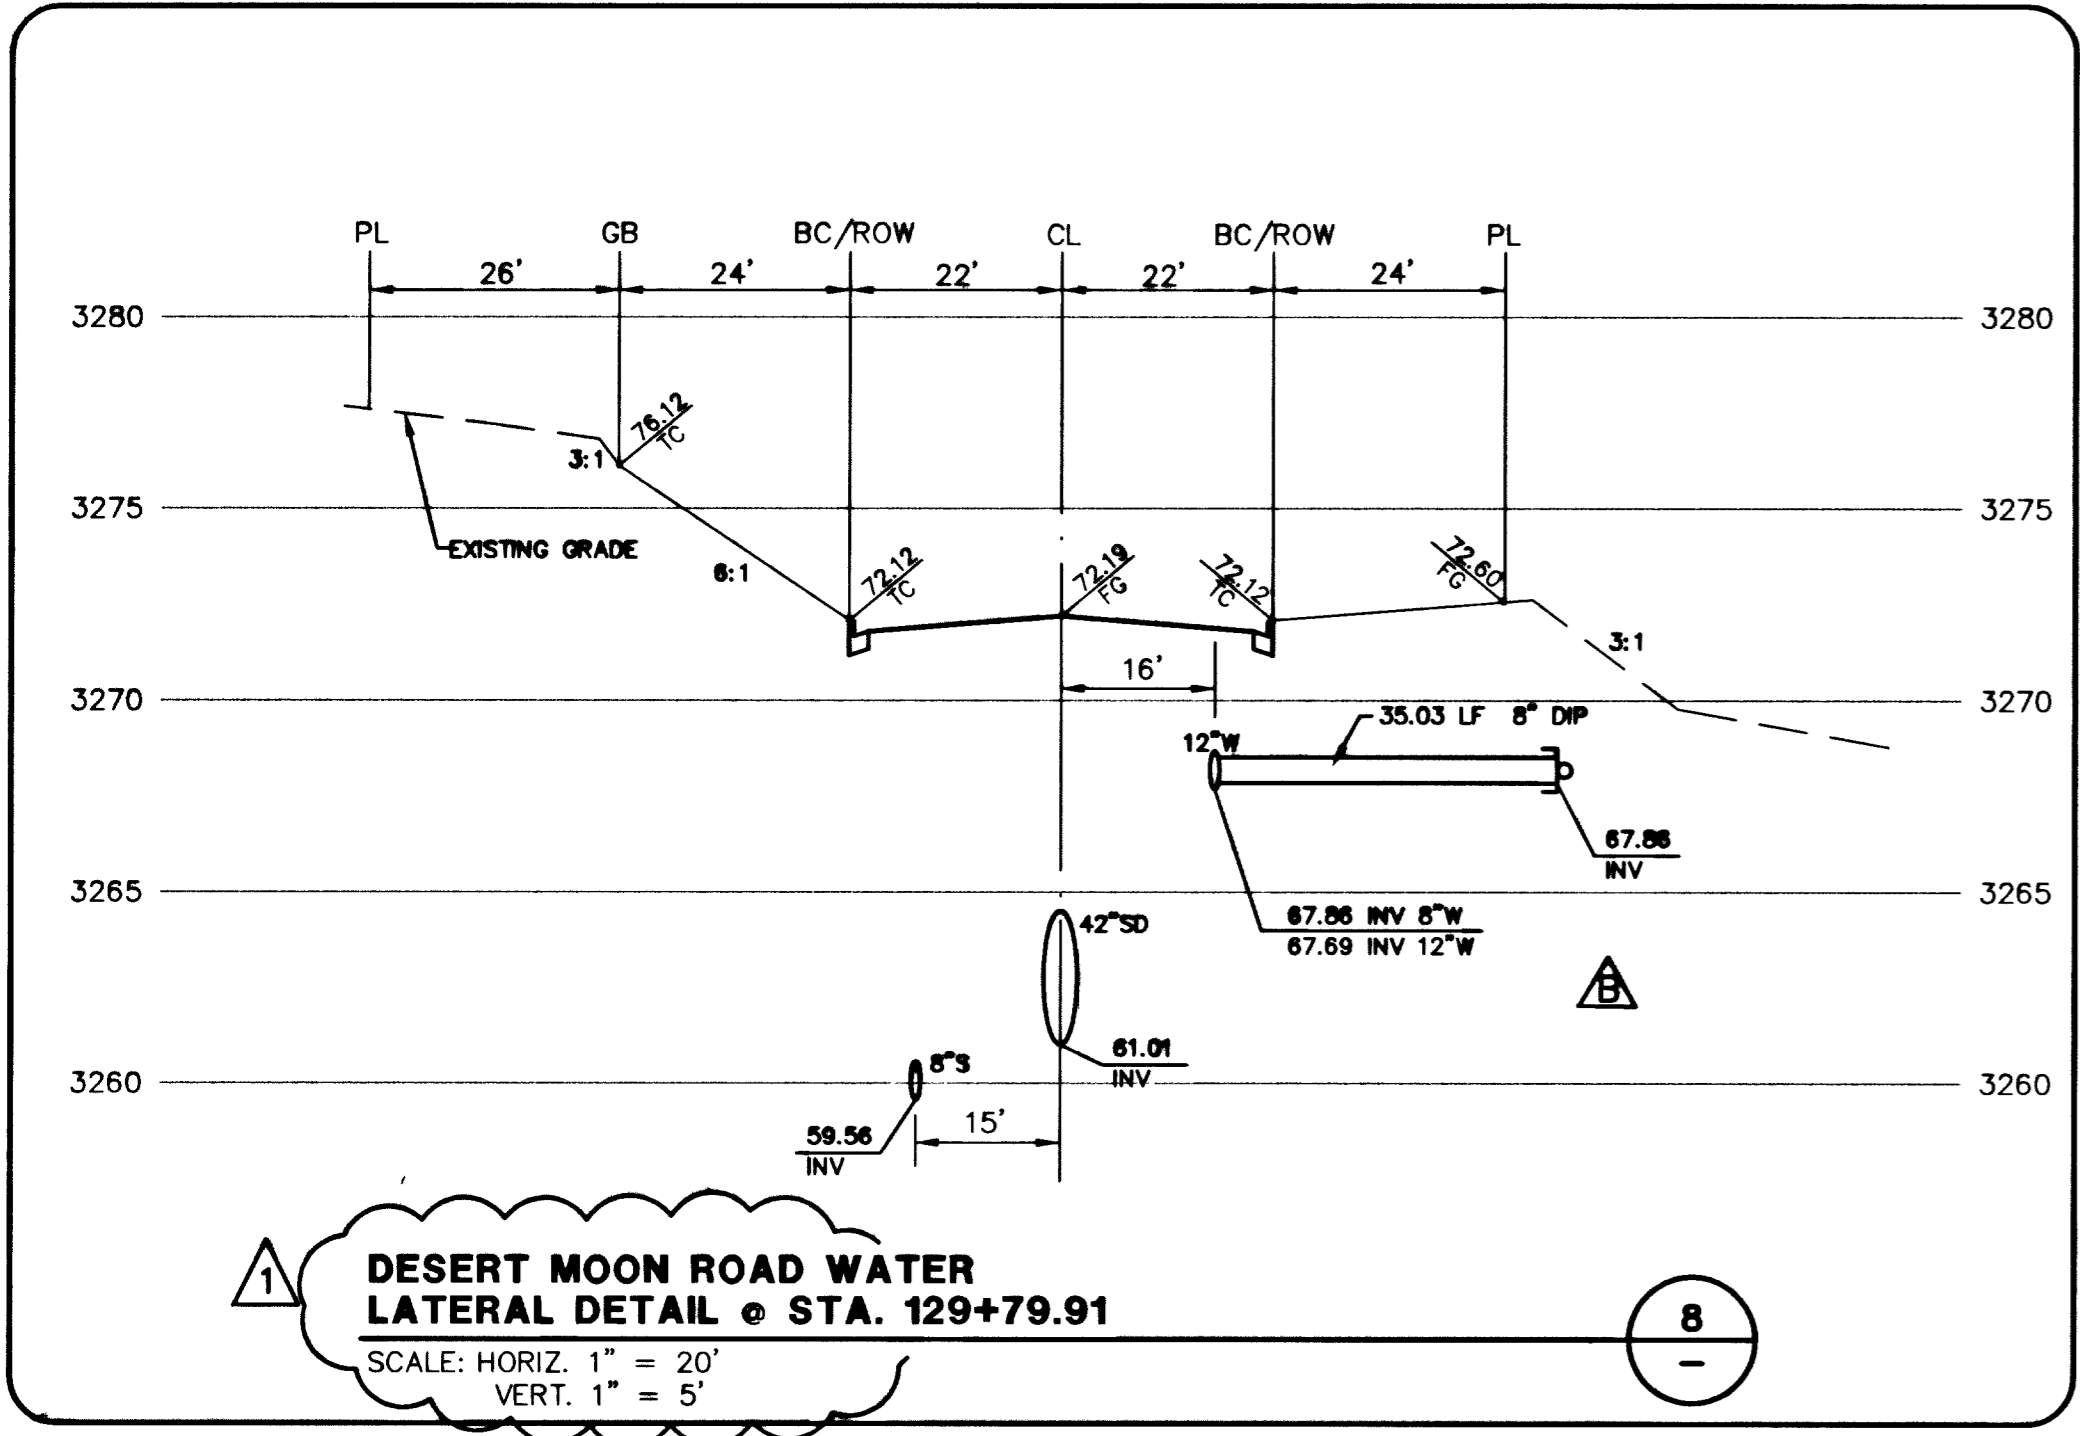
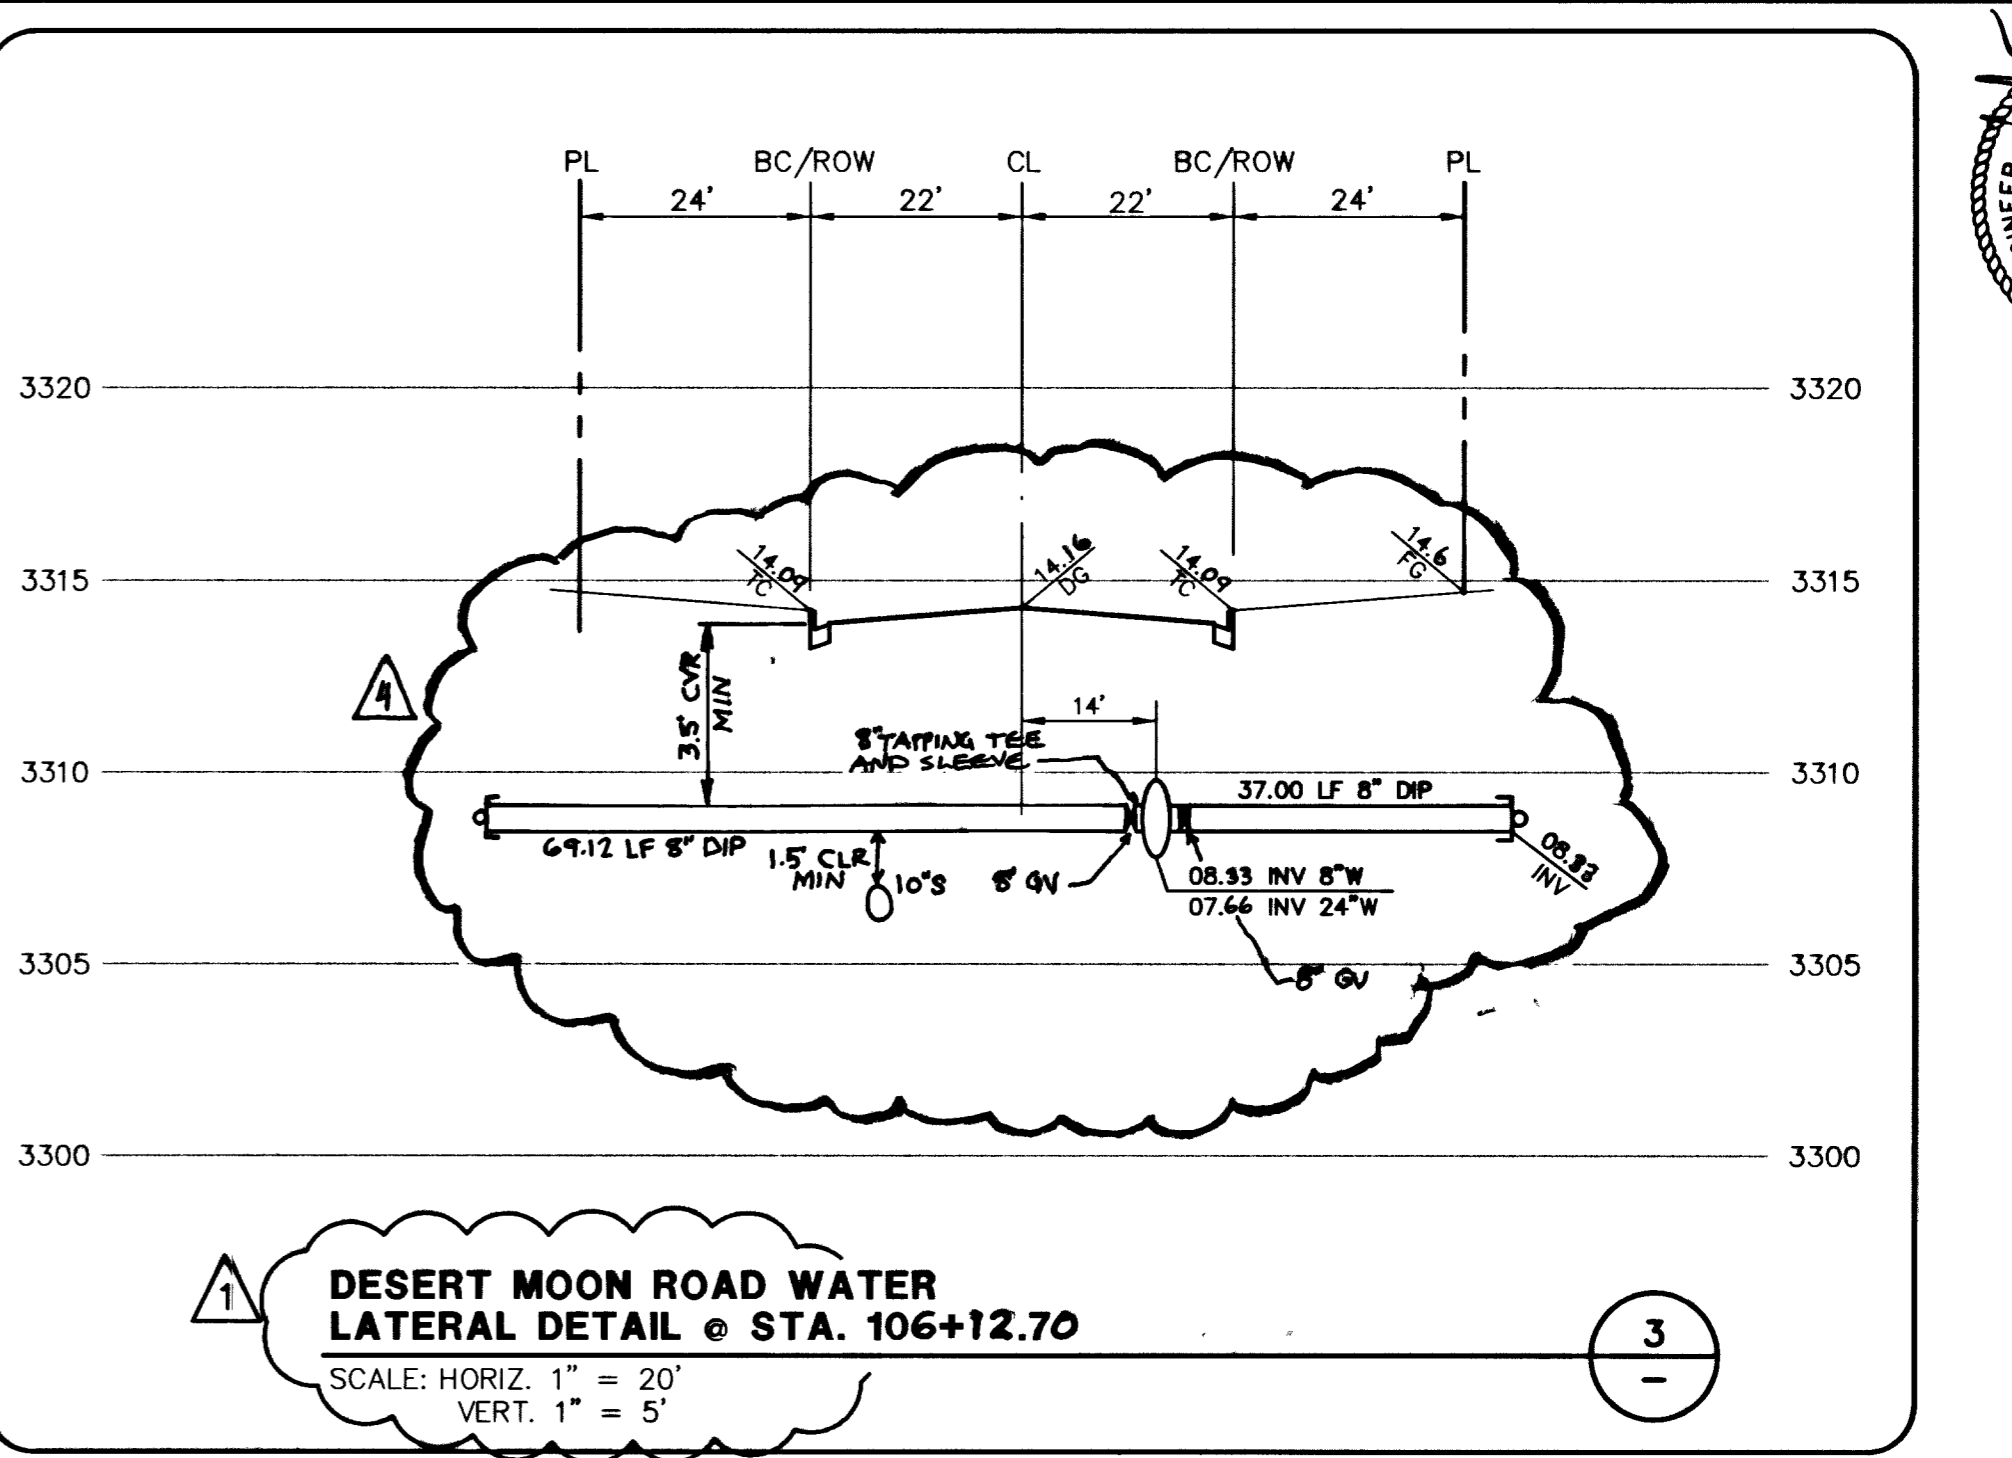
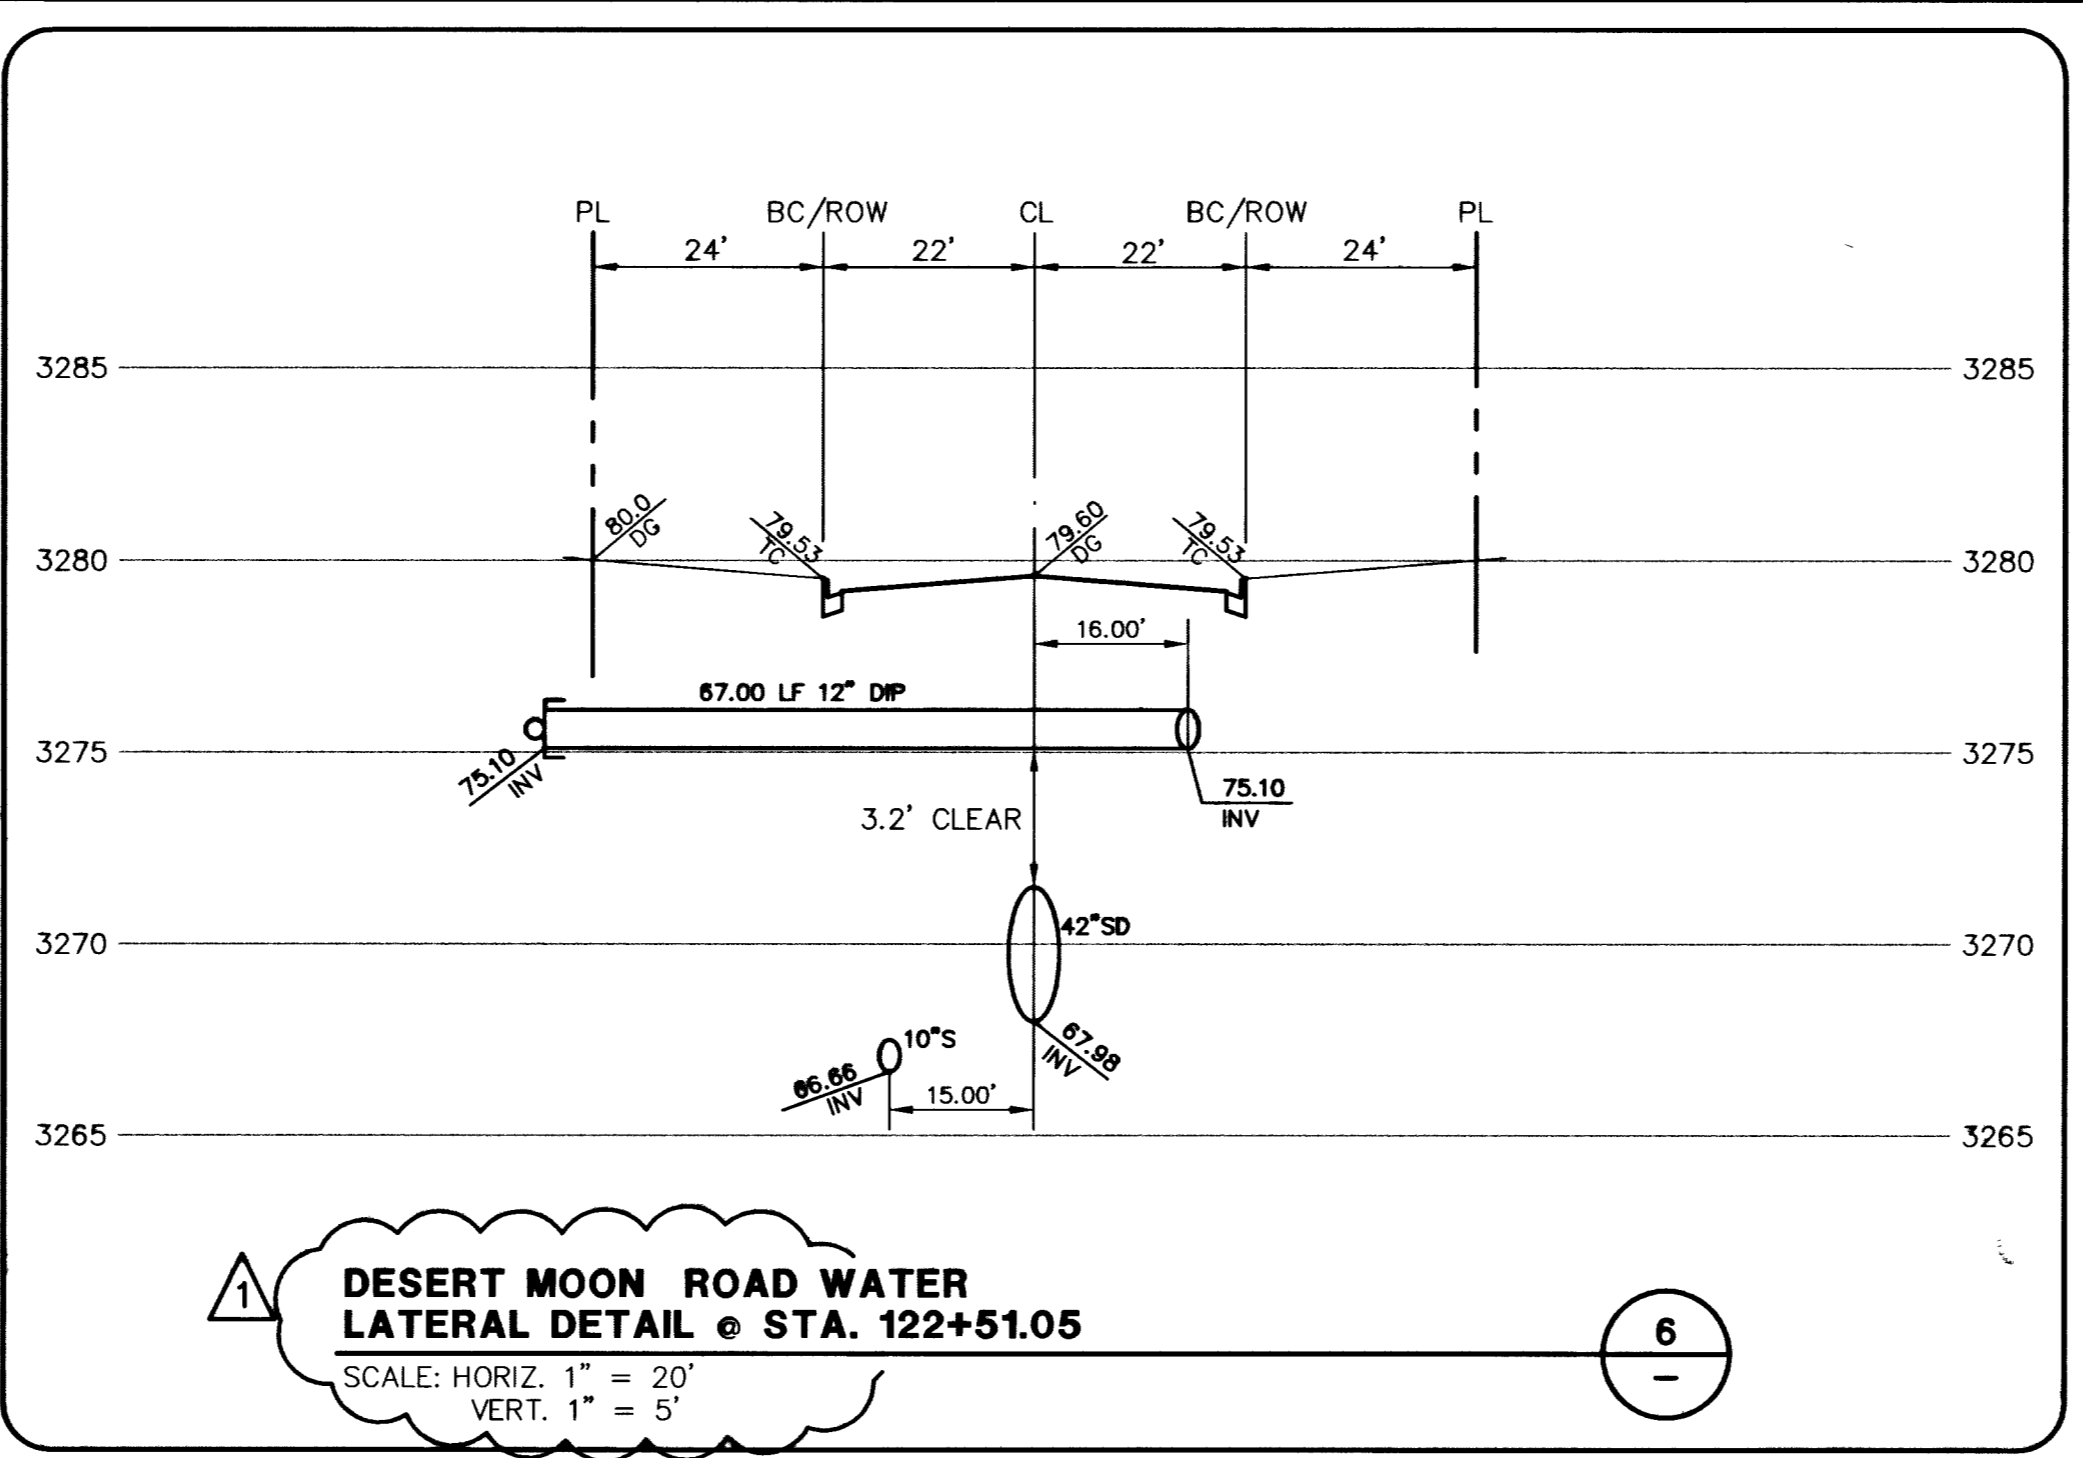


NO.	DATE	DESCRIPTION
1	11/17/03	ISSUE FOR PERMIT
2	11/17/03	CHANGE WATER ALIGNMENT

DESIGN: G. C. WALLACE, INC.
 ENGINEERS/PLANNERS/SURVEYORS
 1555 SOUTH RAINBOW BLVD./LAS VEGAS, NEVADA 89146
 OFFICE: (702) 804-2000, FAX: (702) 804-2899
 SUMMERLIN OFFICE: 10000 CHARLESTON BLVD., STE. 130
 OFFICE: (702) 804-2160, FAX: (702) 804-2295
 F:\N23\Unit 1\Drawings\23A\G03E.dwg

SUMMERLIN
 VILLAGE 23A UNIT 1 IMPROVEMENTS
 LATERAL PROFILES V

SHEET 38
 107-V3574-1
 JOB NO. 62023-221

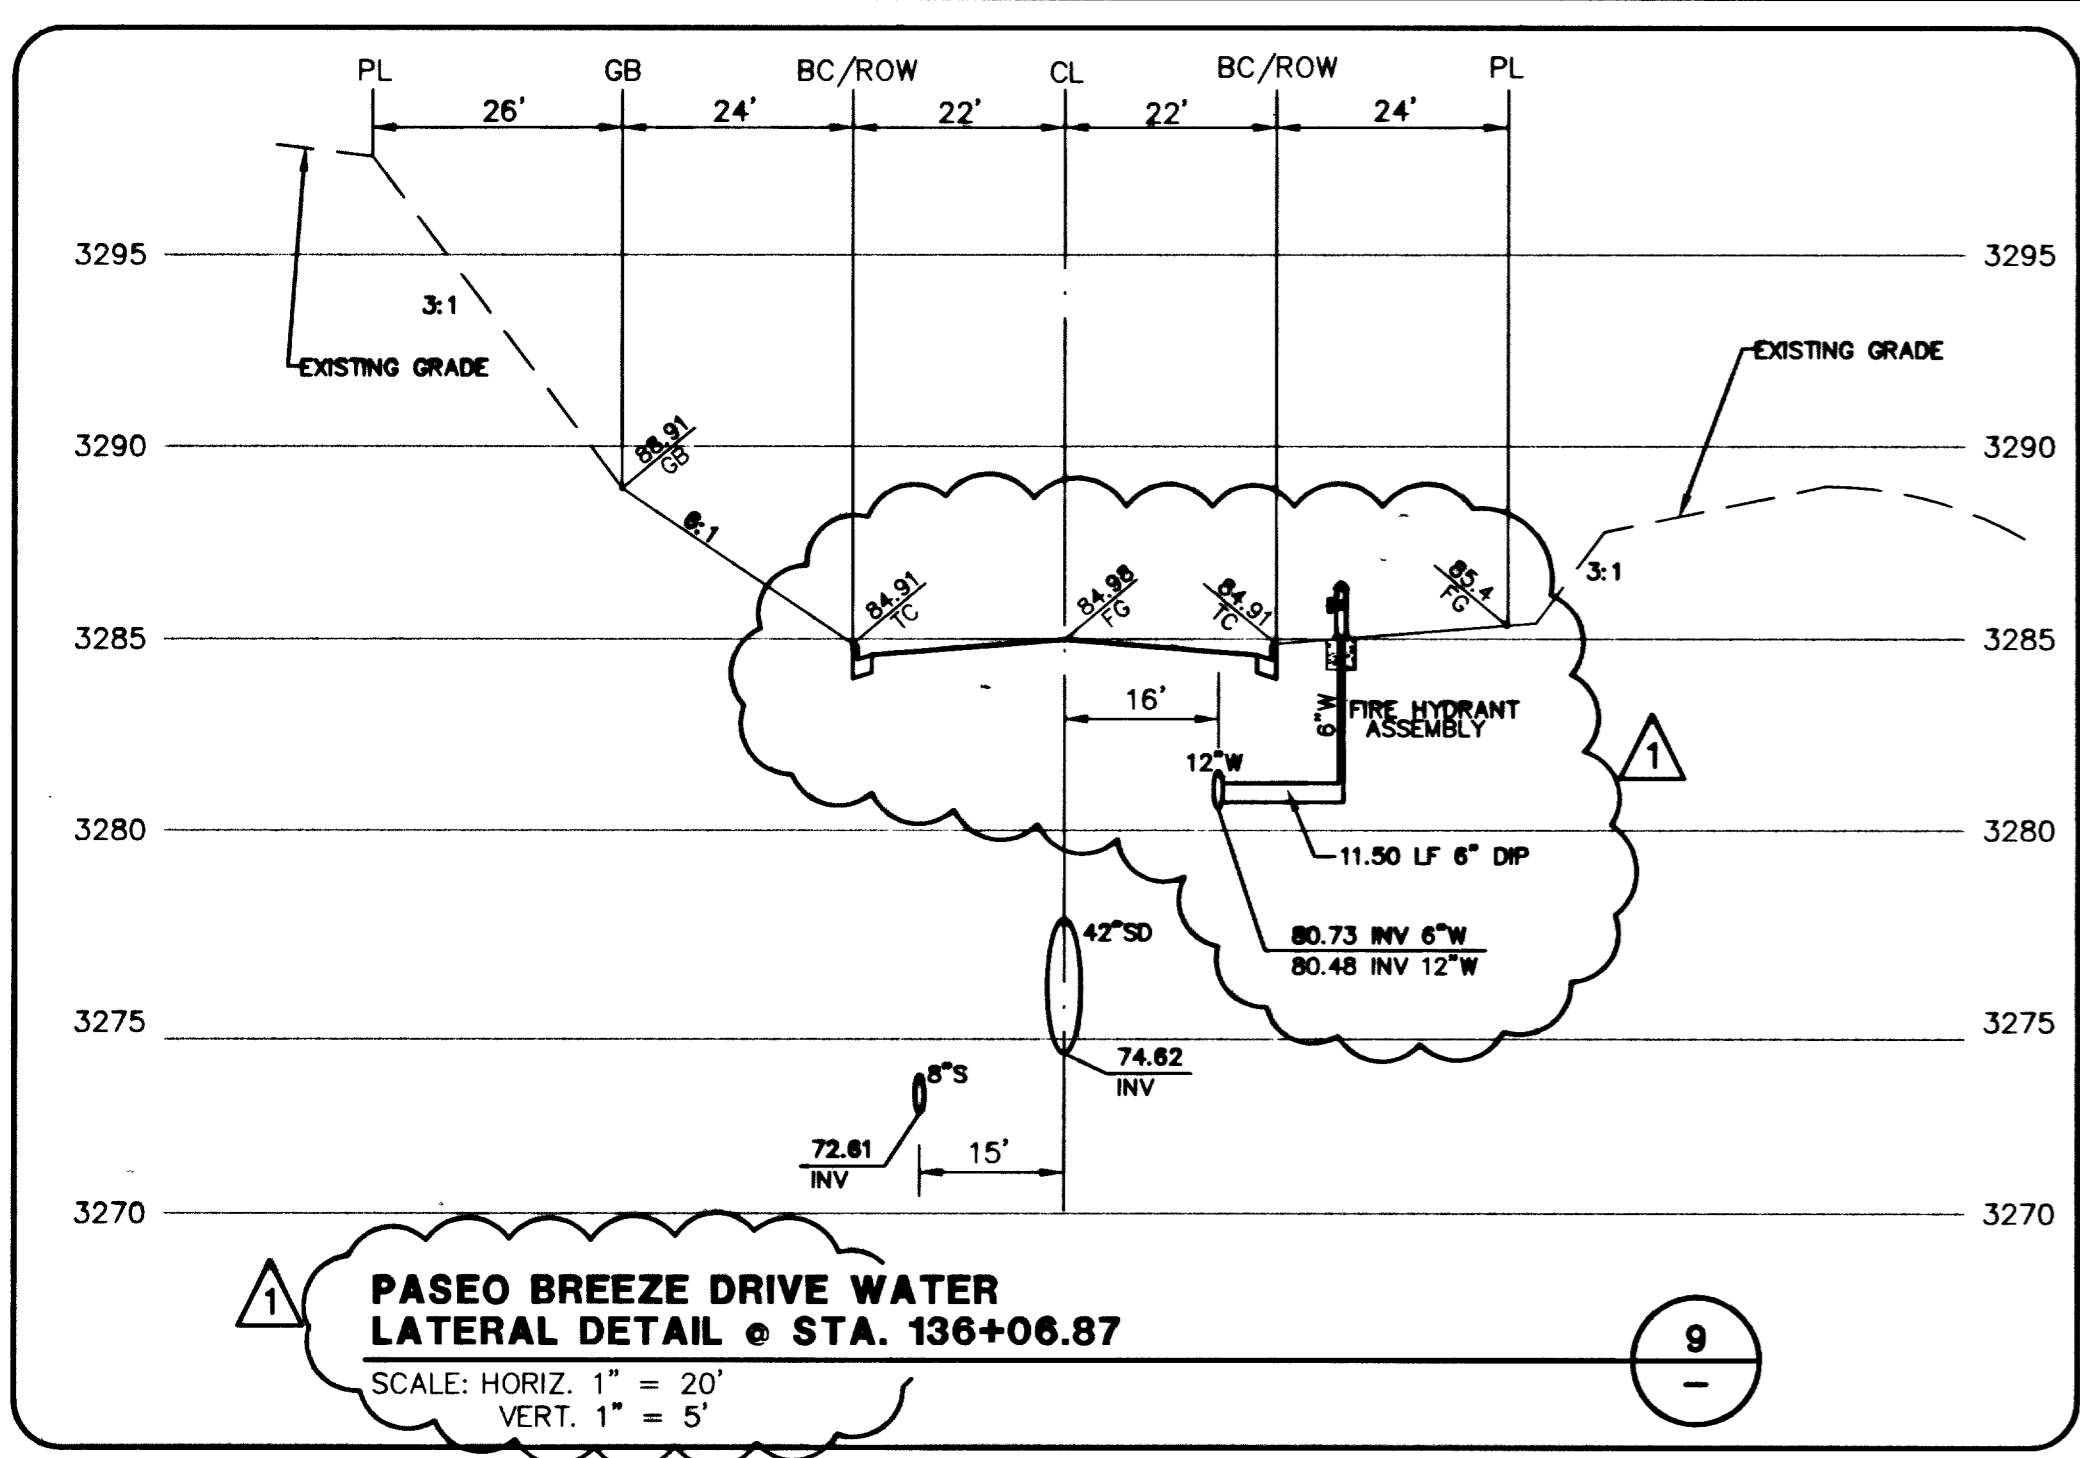

APPROVAL:
 LAS VEGAS VALLEY WATER DISTRICT
 DATE: 11/31/03