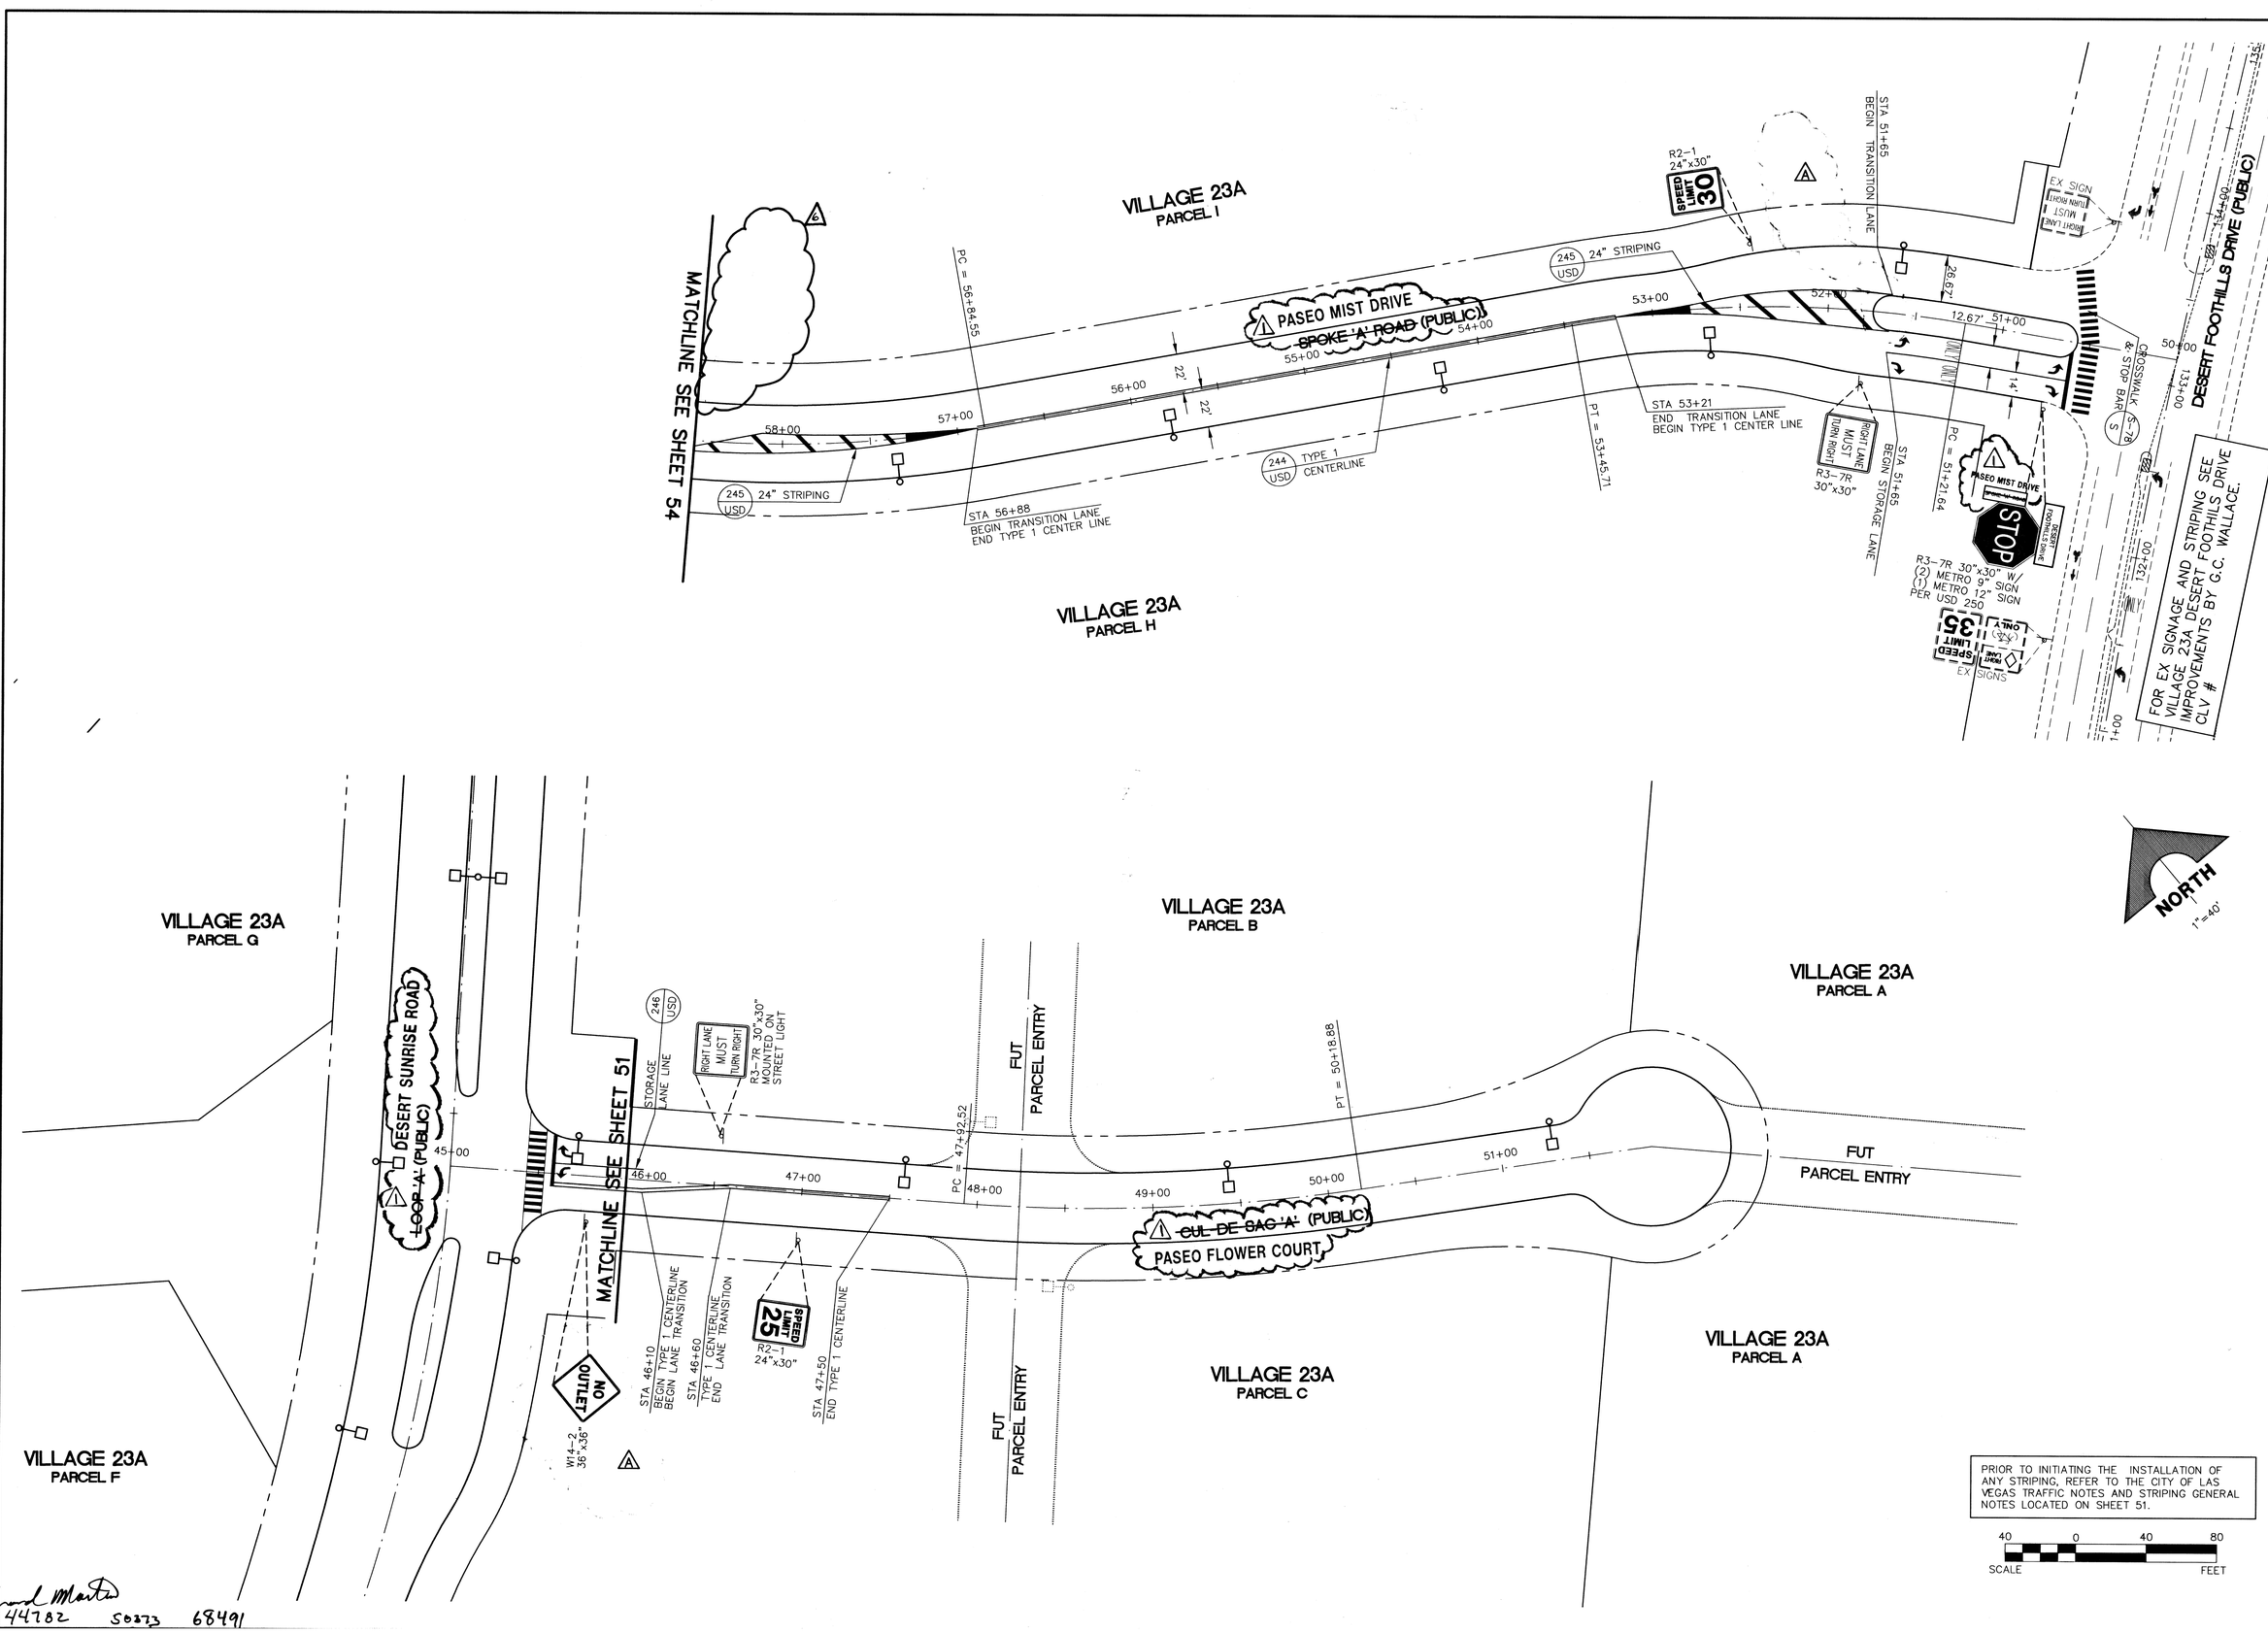

PRIOR TO INITIATING THE INSTALLATION OF ANY STRIPING, REFER TO THE CITY OF LAS VEGAS TRAFFIC NOTES AND STRIPING GENERAL NOTES LOCATED ON SHEET 51.

40 0 40 80
SCALE FEET

REV	DATE	DESCRIPTION	DATE	AGEN.	APP	DATE	CKW.	APP
1	5/4/01	REVISE STREET SIGNAGE						
2	12/12/01	REVISE STREET NAMES	7/9/02	KS		7/9/02	KS	
3	5/9/02	CHANGES TO PLANS PRIOR TO CIV APPROVAL						

DESIGN: JLJ
DRAWN: SDC
CHECK:
ISSUE DATE:
ISSUE EDITOR:
PLOT DATE: 06-24-02
PLOT TIME: 18:30:55
dgardner

G.C. WALLACE, INC.
Engineers/Planners/Surveyors
1555 SOUTH RAINBOW BLVD./LAS VEGAS, NEVADA 89146
OFFICE: (702) 804-2000, FAX: (702) 804-2299
SUMMERLIN OFFICE: 10000 CHARLESTON BLVD., STE. 130
OFFICE: (702) 804-2100, FAX: (702) 804-2295
F:\V23\Unit 1\Ows\Vmp\V23A1e055.dwg

SUMMERLIN
VILLAGE 23A UNIT 1 IMPROVEMENTS
SIGNAGE AND STRIING PLAN V

SHEET 55
107-V35 74-1

JOB NO. 62023.221

44782 50373 68491