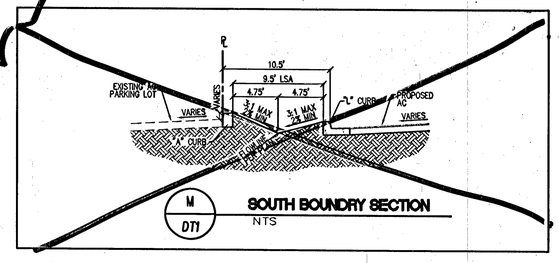

M / DT1 **SOUTH BOUNDRY SECTION**
NTS

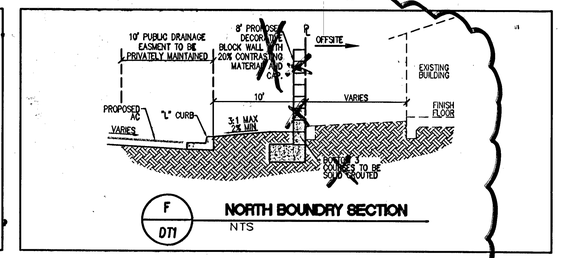

F / DT1 **NORTH BOUNDRY SECTION**
NTS

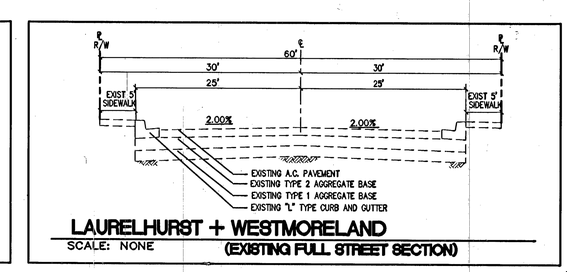

LAURELHURST + WESTMORELAND
SCALE: NONE **(EXISTING FULL STREET SECTION)**

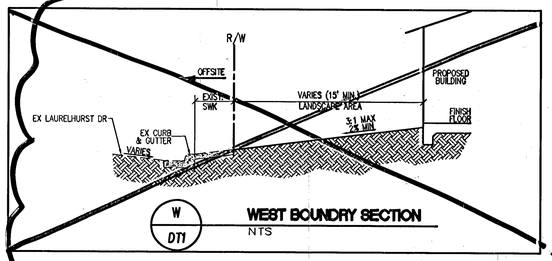

W / DT1 **WEST BOUNDRY SECTION**
NTS

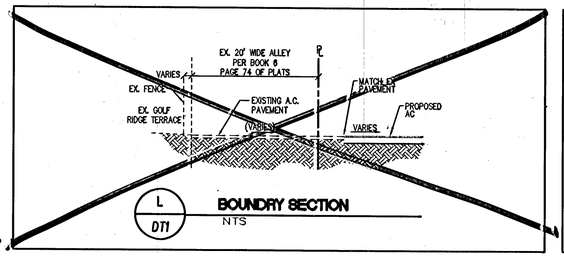

L / DT1 **BOUNDRY SECTION**
NTS

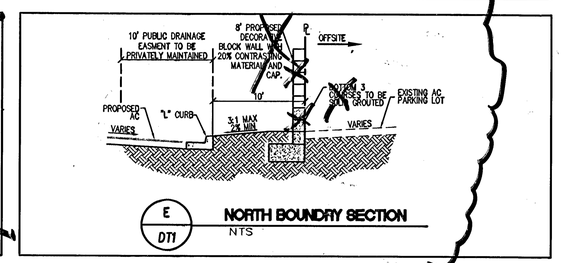

E / DT1 **NORTH BOUNDRY SECTION**
NTS

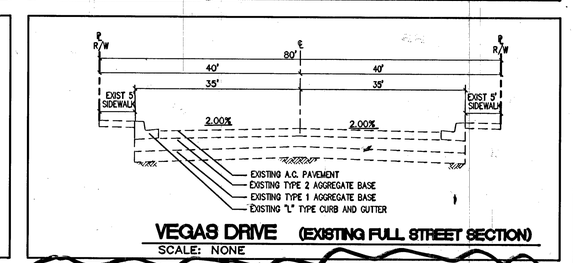

VEGAS DRIVE **(EXISTING FULL STREET SECTION)**
SCALE: NONE

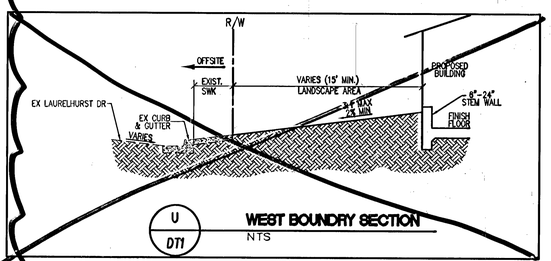

U / DT1 **WEST BOUNDRY SECTION**
NTS

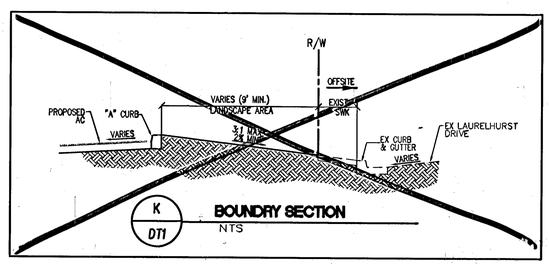

K / DT1 **BOUNDRY SECTION**
NTS

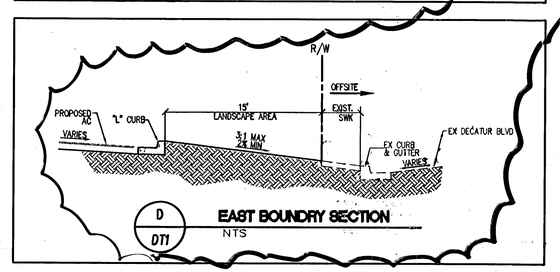

D / DT1 **EAST BOUNDRY SECTION**
NTS

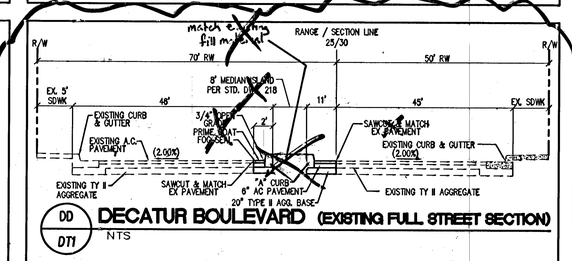

DD / DT1 **DECATUR BOULEVARD** **(EXISTING FULL STREET SECTION)**
NTS

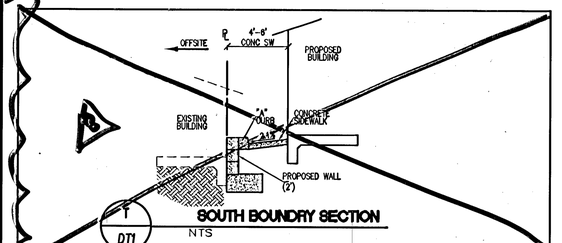

T / DT1 **SOUTH BOUNDRY SECTION**
NTS

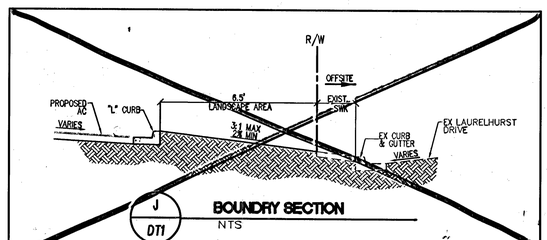

J / DT1 **BOUNDRY SECTION**
NTS

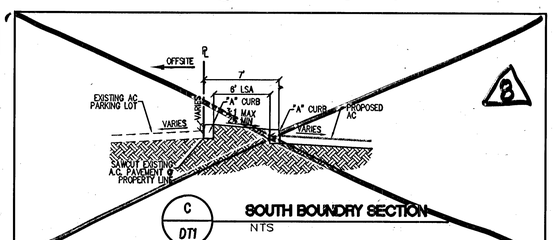

C / DT1 **SOUTH BOUNDRY SECTION**
NTS

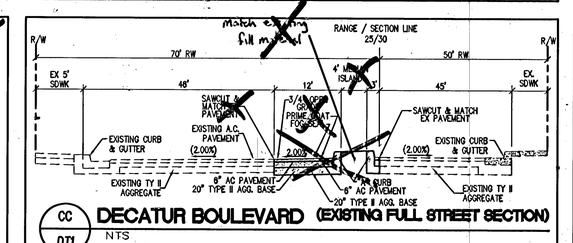

CC / DT1 **DECATUR BOULEVARD** **(EXISTING FULL STREET SECTION)**
NTS

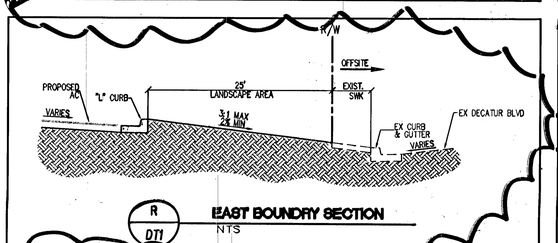

R / DT1 **EAST BOUNDRY SECTION**
NTS

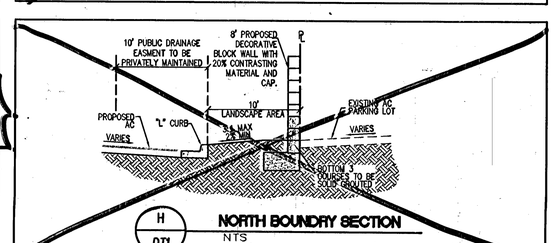

H / DT1 **NORTH BOUNDRY SECTION**
NTS

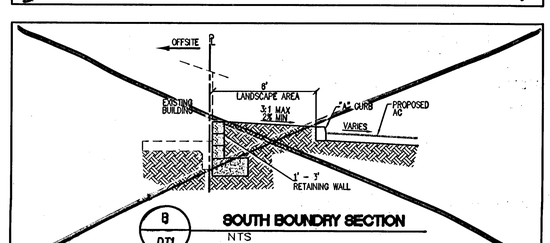

B / DT1 **SOUTH BOUNDRY SECTION**
NTS

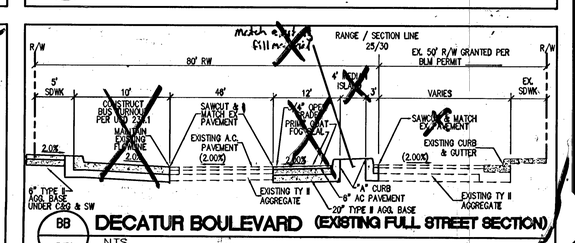

BB / DT1 **DECATUR BOULEVARD** **(EXISTING FULL STREET SECTION)**
NTS

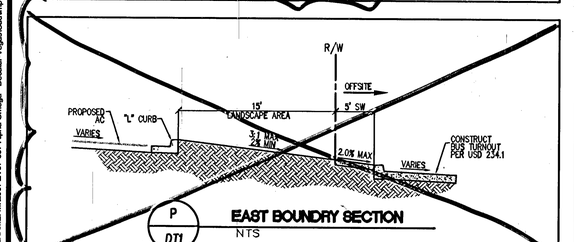

P / DT1 **EAST BOUNDRY SECTION**
NTS

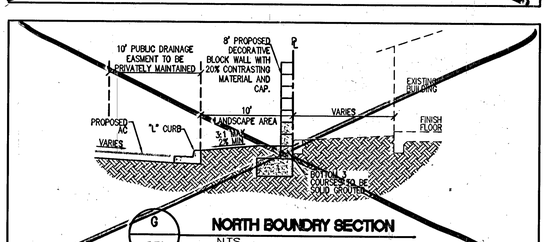

G / DT1 **NORTH BOUNDRY SECTION**
NTS

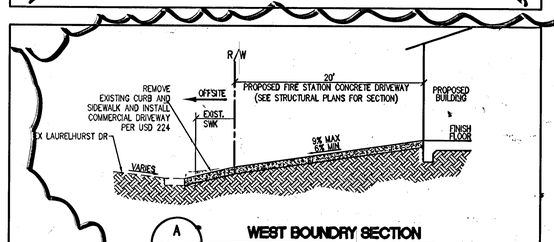

A / DT1 **WEST BOUNDRY SECTION**
NTS

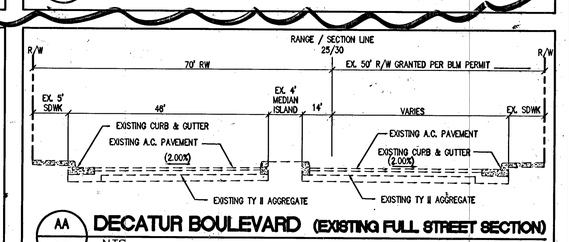

AA / DT1 **DECATUR BOULEVARD** **(EXISTING FULL STREET SECTION)**
NTS

REV	REVISION	DATE	BY	APPROVED
A	ELIMINATE ALL IMPROVEMENTS WITH REGAL CONFIGURATION AS PART OF PHASE 1	9-15-10	VB	

ALPHA OMEGA STRATEGIES
4908 CARMEN BOULEVARD, LAS VEGAS, NEVADA 89108
PHONE: (702) 810-9002 FAX: (702) 933-0017

DRC Development Resource Consultants, Inc.
Civil Engineering • Land Surveying • Land Planning
9330 WEST MARTIN AVENUE
LAS VEGAS, NV 89148
PHONE (702) 270-6119 - FAX (702) 270-4899

THE RESIDENCES @ VILLAGE SQUARE

DETAIL SHEET 1

H-29988

DRAWN BY:	BWD
DESIGNED BY:	CWC
CHECKED BY:	DPW
PROJECT NO:	LV07-537

PROFESSIONAL ENGINEER — STATE OF NEVADA — DENNIS P. WERTZLER — EXP. 6/30/10 — CIVIL — No. 11970

11/4/09

SHEET **DT1**
7 OF 29 SHEETS

DRAWING NO. 107Y4973

124798
20611
RCom

FILENAME: M:\2007\LV07-537 Alpha Omega - Decatur-Vegas\Cad\dmp plans\LV07-537DT.dwg, LAST SAVED ON: Sep 15 2009 10:56am PLOTTED BY: TIM, ON: Oct 19 2009 12:42pm