
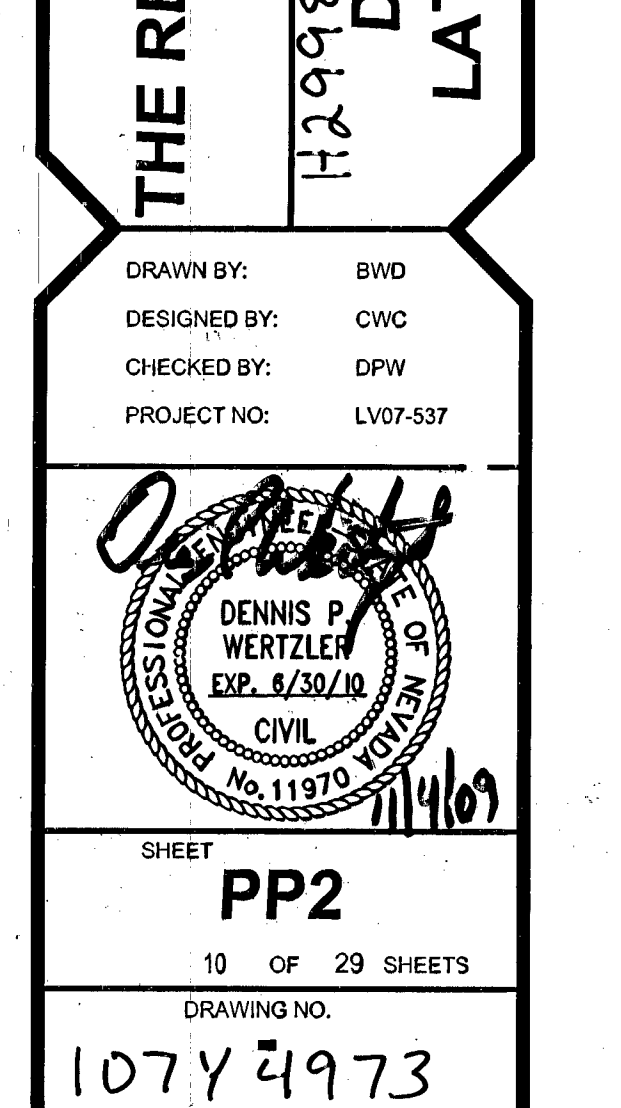
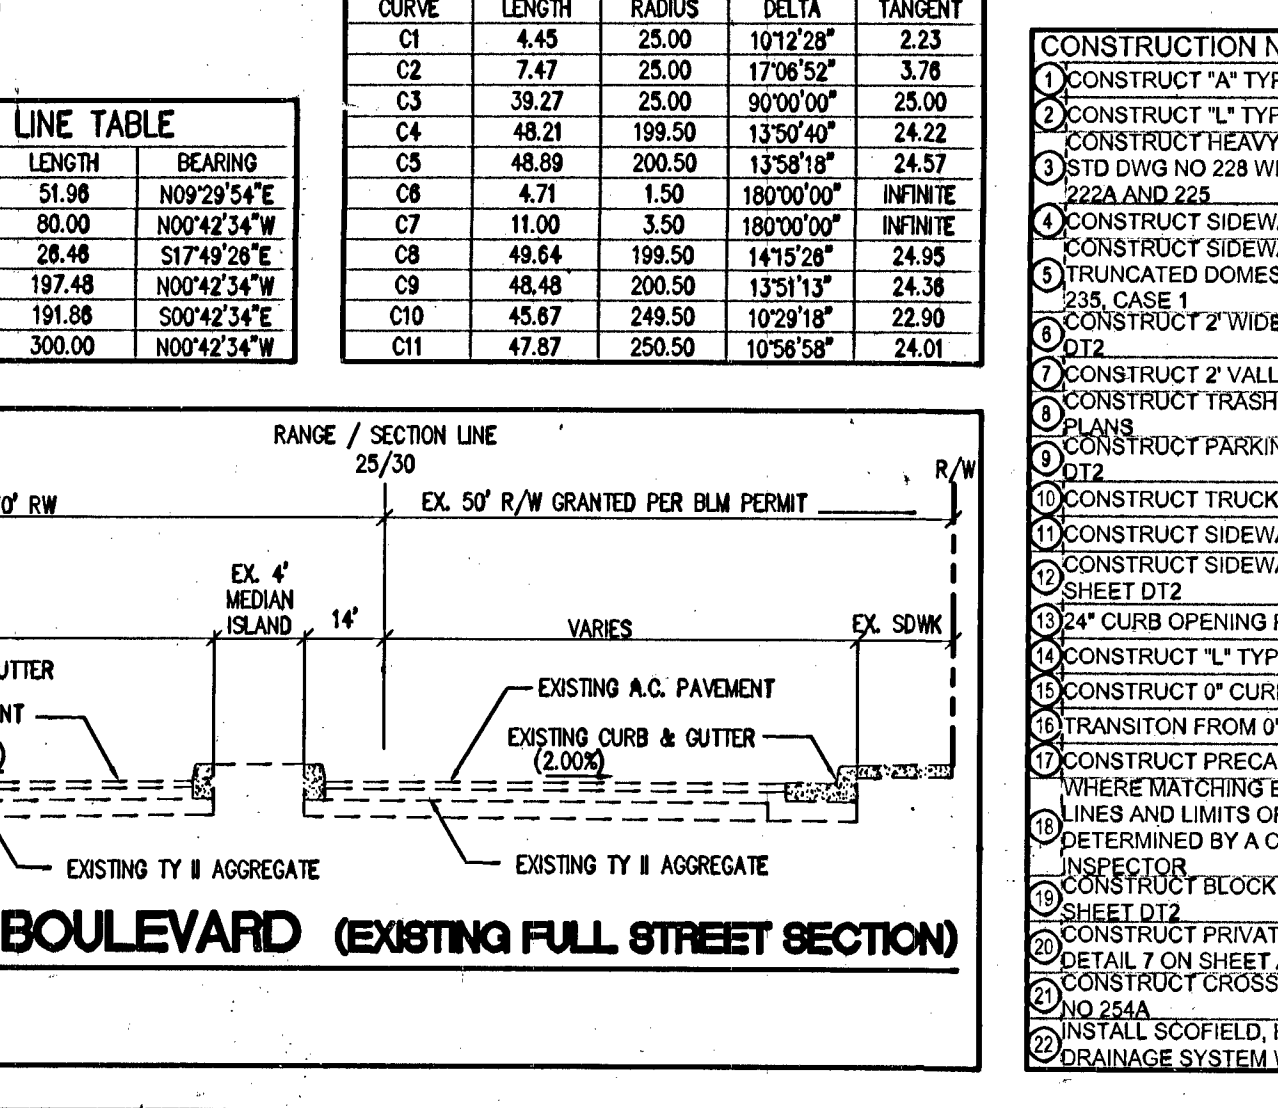
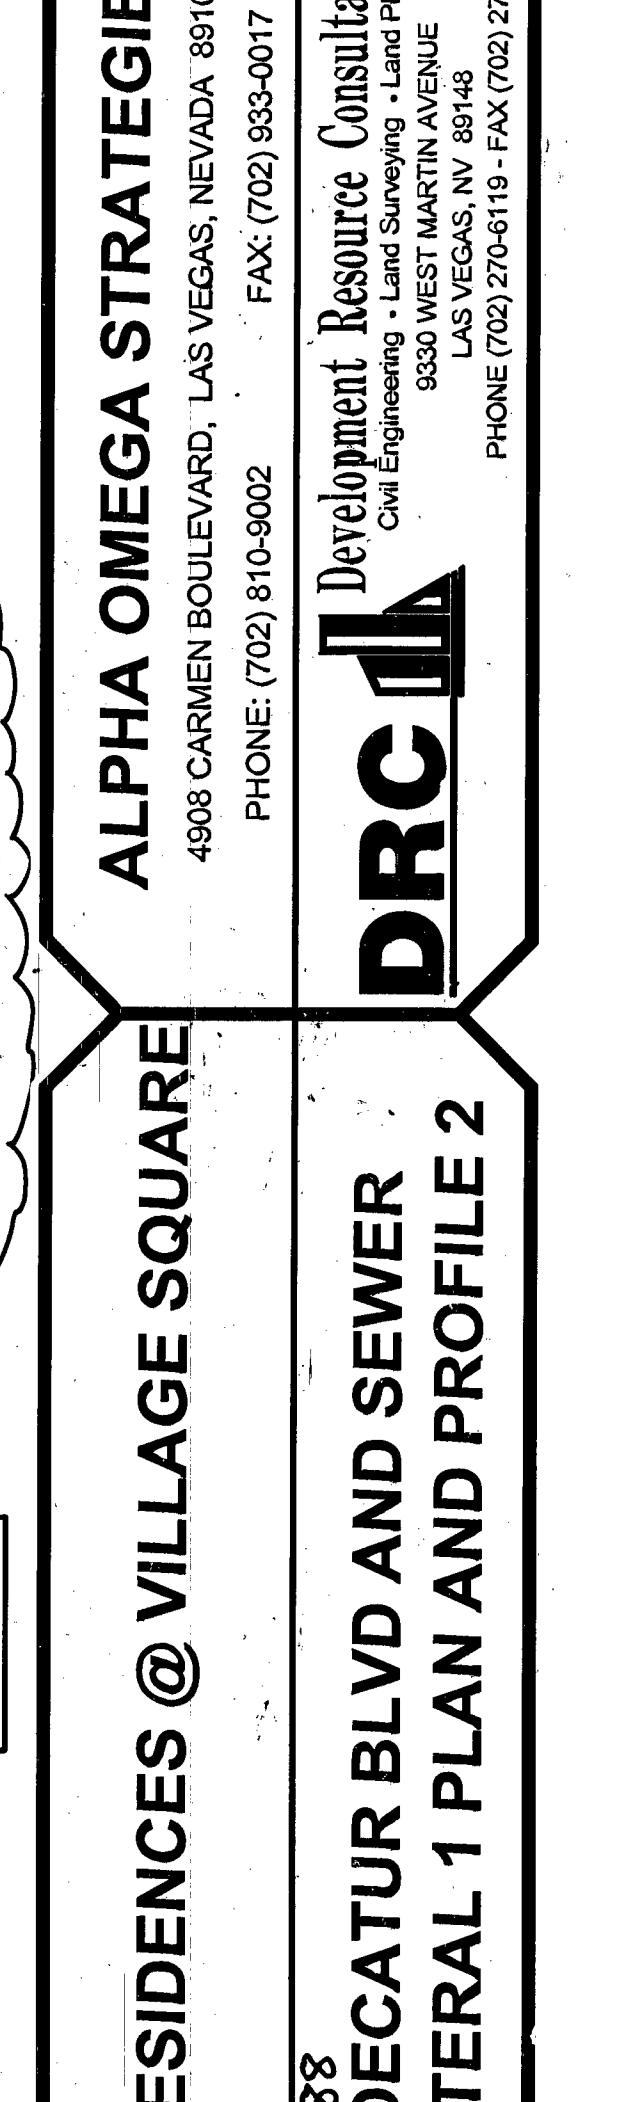
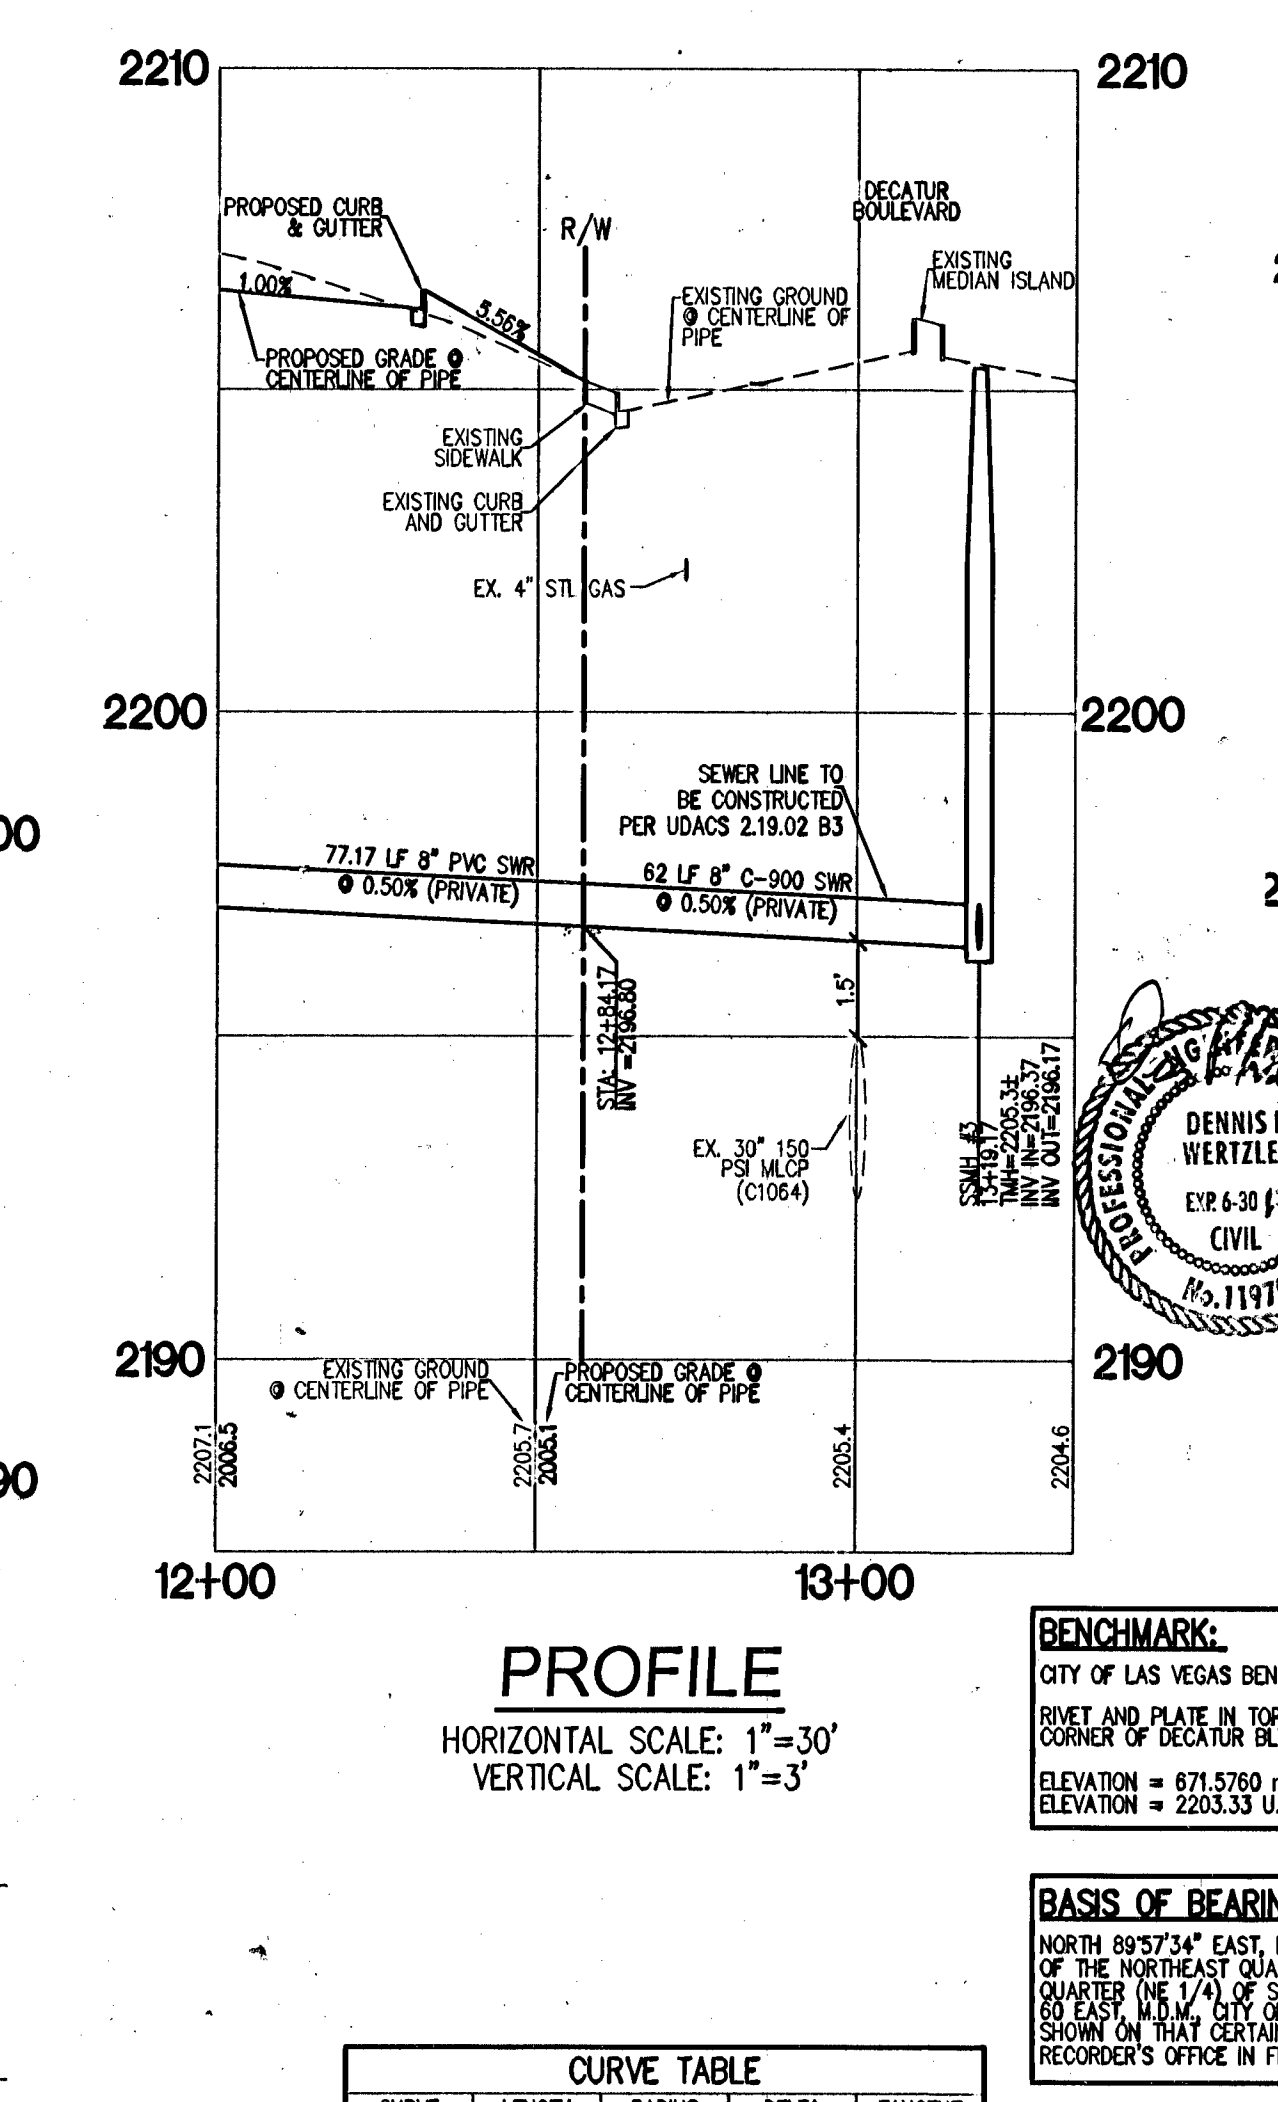
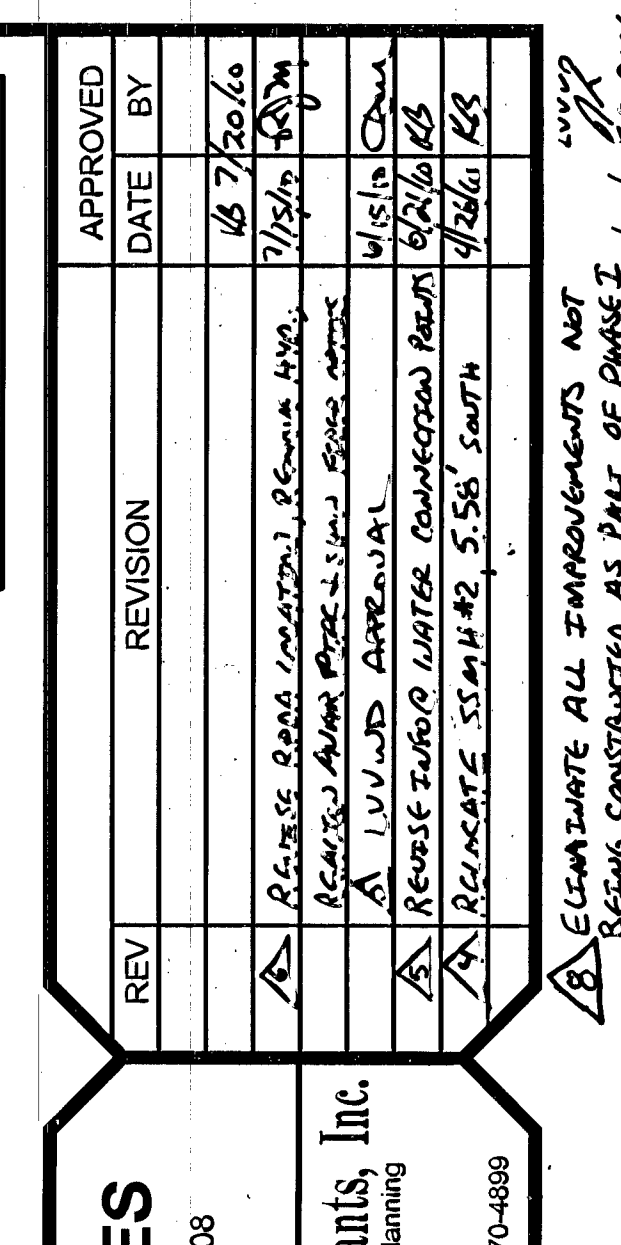


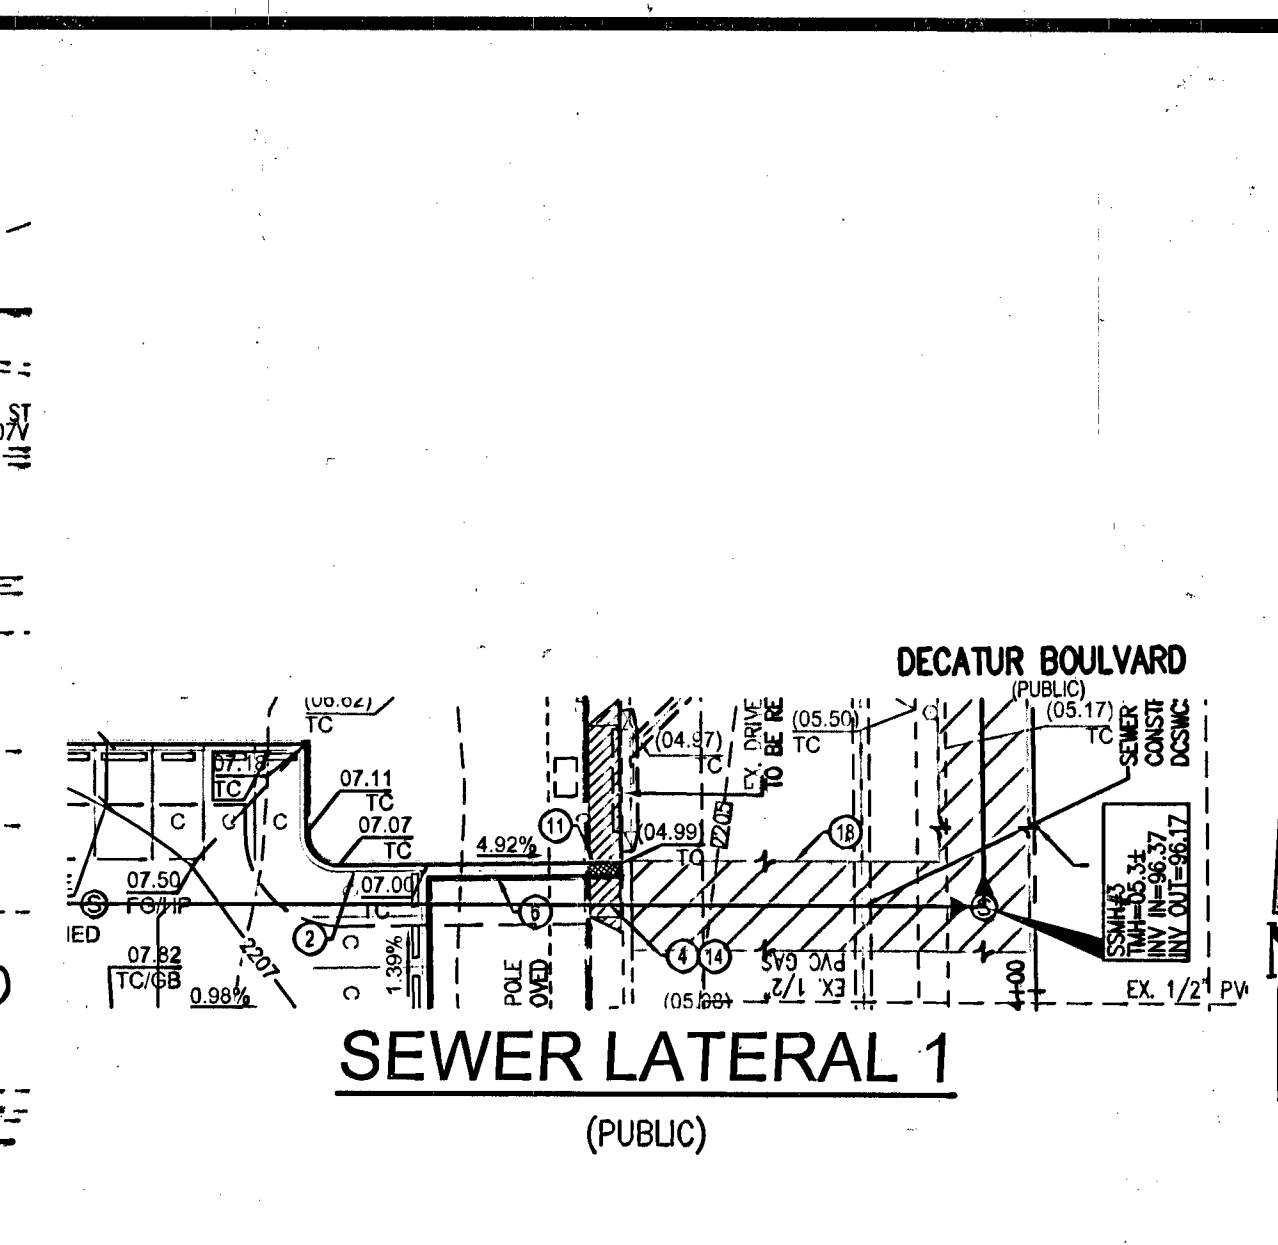

124800
124365
123905
122637
121907
120614
P. 6 am

FILENAME: M:\2007\L\07-537 Alpha Omega - Decatur-Vegas\Cadump plans\L\07-537 PP.dwg; LAST SAVED ON: Oct 19 2008 11:58am PLOTTED BY: TIM, ON: Oct 19 2008 12:55pm

DISCLAIMER NOTE:

UTILITY LOCATIONS HEREON ARE APPROXIMATE ONLY. IT SHALL BE THE CONTRACTOR'S RESPONSIBILITY TO DETERMINE THE EXACT HORIZONTAL AND VERTICAL LOCATION OF ALL EXISTING UNDERGROUND OR OVERHEAD UTILITIES PRIOR TO ANY CONSTRUCTION. NO REPRESENTATION IS MADE THAT ALL EXISTING UTILITIES ARE SHOWN OR ASSUMED TO BE SHOWN. THE CONTRACTOR ASSUMES NO RESPONSIBILITY FOR UTILITIES NOT SHOWN OR UTILITIES NOT SHOWN IN THEIR PROPER LOCATION. CONTRACTOR TO NOTIFY ENGINEER OF ANY CHANGES OR DISCREPANCIES.

Call before you Overhead

1-702-593-8111

NEVADA POWER ENVIRONMENT AND
NATURAL RESOURCES DEPARTMENT

811 or
1-800-297-2600



Call before you UnderGround

1-702-229-6811

Call before you Overhead

Avoid overhead power line contact. It's costly.

Call before you UnderGround

Avoid cutting underground utility lines. It's costly.

AVOID HITTING UNDERGROUND TRAFFIC SIGNAL SYSTEMS AND STREET LIGHT SYSTEM COMPONENTS IT'S COSTLY

R/W

70' RW

EX. 5' SWMK

48'

EXISTING CURB & GUTTER

EXISTING A.C. PAVEMENT (2.00%)

EX. 4' MEDIAN ISLAND

14'

VARIES

EX. 50' R/W GRANTED PER BUM PERMIT

EX. 50' SWMK

EXISTING CURB & GUTTER

EXISTING A.C. PAVEMENT (2.00%)

EXISTING TY II AGGREGATE

EXISTING TY II AGGREGATE

AA

DTI NTS

DECATUR BOULEVARD (EXISTING FULL STREET SECTION)

BENCHMARK:


ELEVATION = 2203.33 U.S. SURVEY FEET (NAVD83 PUBLISHED)

BASIS OF BEARINGS:

NORTH 89°57'34" EAST, BEING THE BEARING OF THE NORTH LINE
OF THE NORTHEAST QUARTER (NE 1/4) OF THE NORTHEAST

APPROVAL:


Don Shuck 02/04/10

PROJECT #115549

DATE

No.	GRADE (X) B' TO A'	"A"(FT) MIN.	"B"(FT) MIN.
(1)	-8 TO -5.01	4.5'	21.5'
(2)	-5 TO -4.01	4.5'	15.0'
(3)	-4 TO -3.01	4.5'	12.0'
(4)	-3 TO -2.01	4.5'	9.5'
(5)	-2 TO 2	8.0'	8.0'
(6)	2.01 TO 3	9.5'	4.5'
(7)	3.01 TO 4	12.0'	4.5'
(8)	4.01 TO 5	15.0'	4.5'
(9)	5.01 TO 6	21.5'	4.5'

P.T.

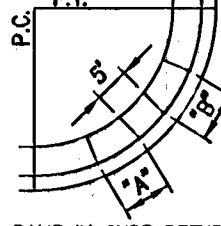

RAMP IN CURB RETURN

NOTE:
B TO A = NEGATIVE (-)
A TO B = POSITIVE (+)

SIDEWALK RAMP

PER STD. DWG. NO. 235 - CASE 1

LEGEND:

FINISH FLOOR ELEVATION 05.50

PAV ELEVATION 03.7

BOUNDARY _____

RIGHT OF WAY _____

FLOWLINE _____

EXISTING CONTOUR _____

PROPOSED CONTOUR _____

ADA ACCESS ROUTE _____

ELEVATION 3.60

EDGE OF PAVEMENT _____

PAVEMENT TO BE
SAVED TO BE
REMOVED _____

ABBREVIATIONS:

ADI AREA DRAIN INLET

ER END RETAINING CONSTRUCTION

FG FINISH GRADE

FL FLOW LINE

GB GRADE BREAK


LSA LANDSCAPE AREA

SD STORM DRAIN

TC TOP OF CURB

TOP TOP OF FOOTING

TRC TOP OF ROLL CURB

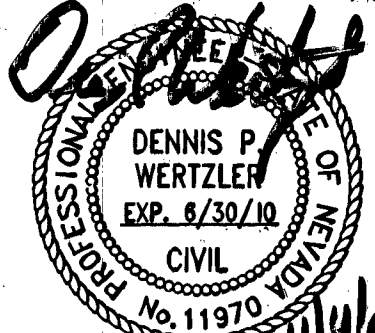DRAWN BY:	BWD
DESIGNED BY:	CWC
CHECKED BY:	DPW
PROJECT NO:	LV07-537
	
SHEET	
PP2	
10 OF 29 SHEETS	
DRAWING NO.	

