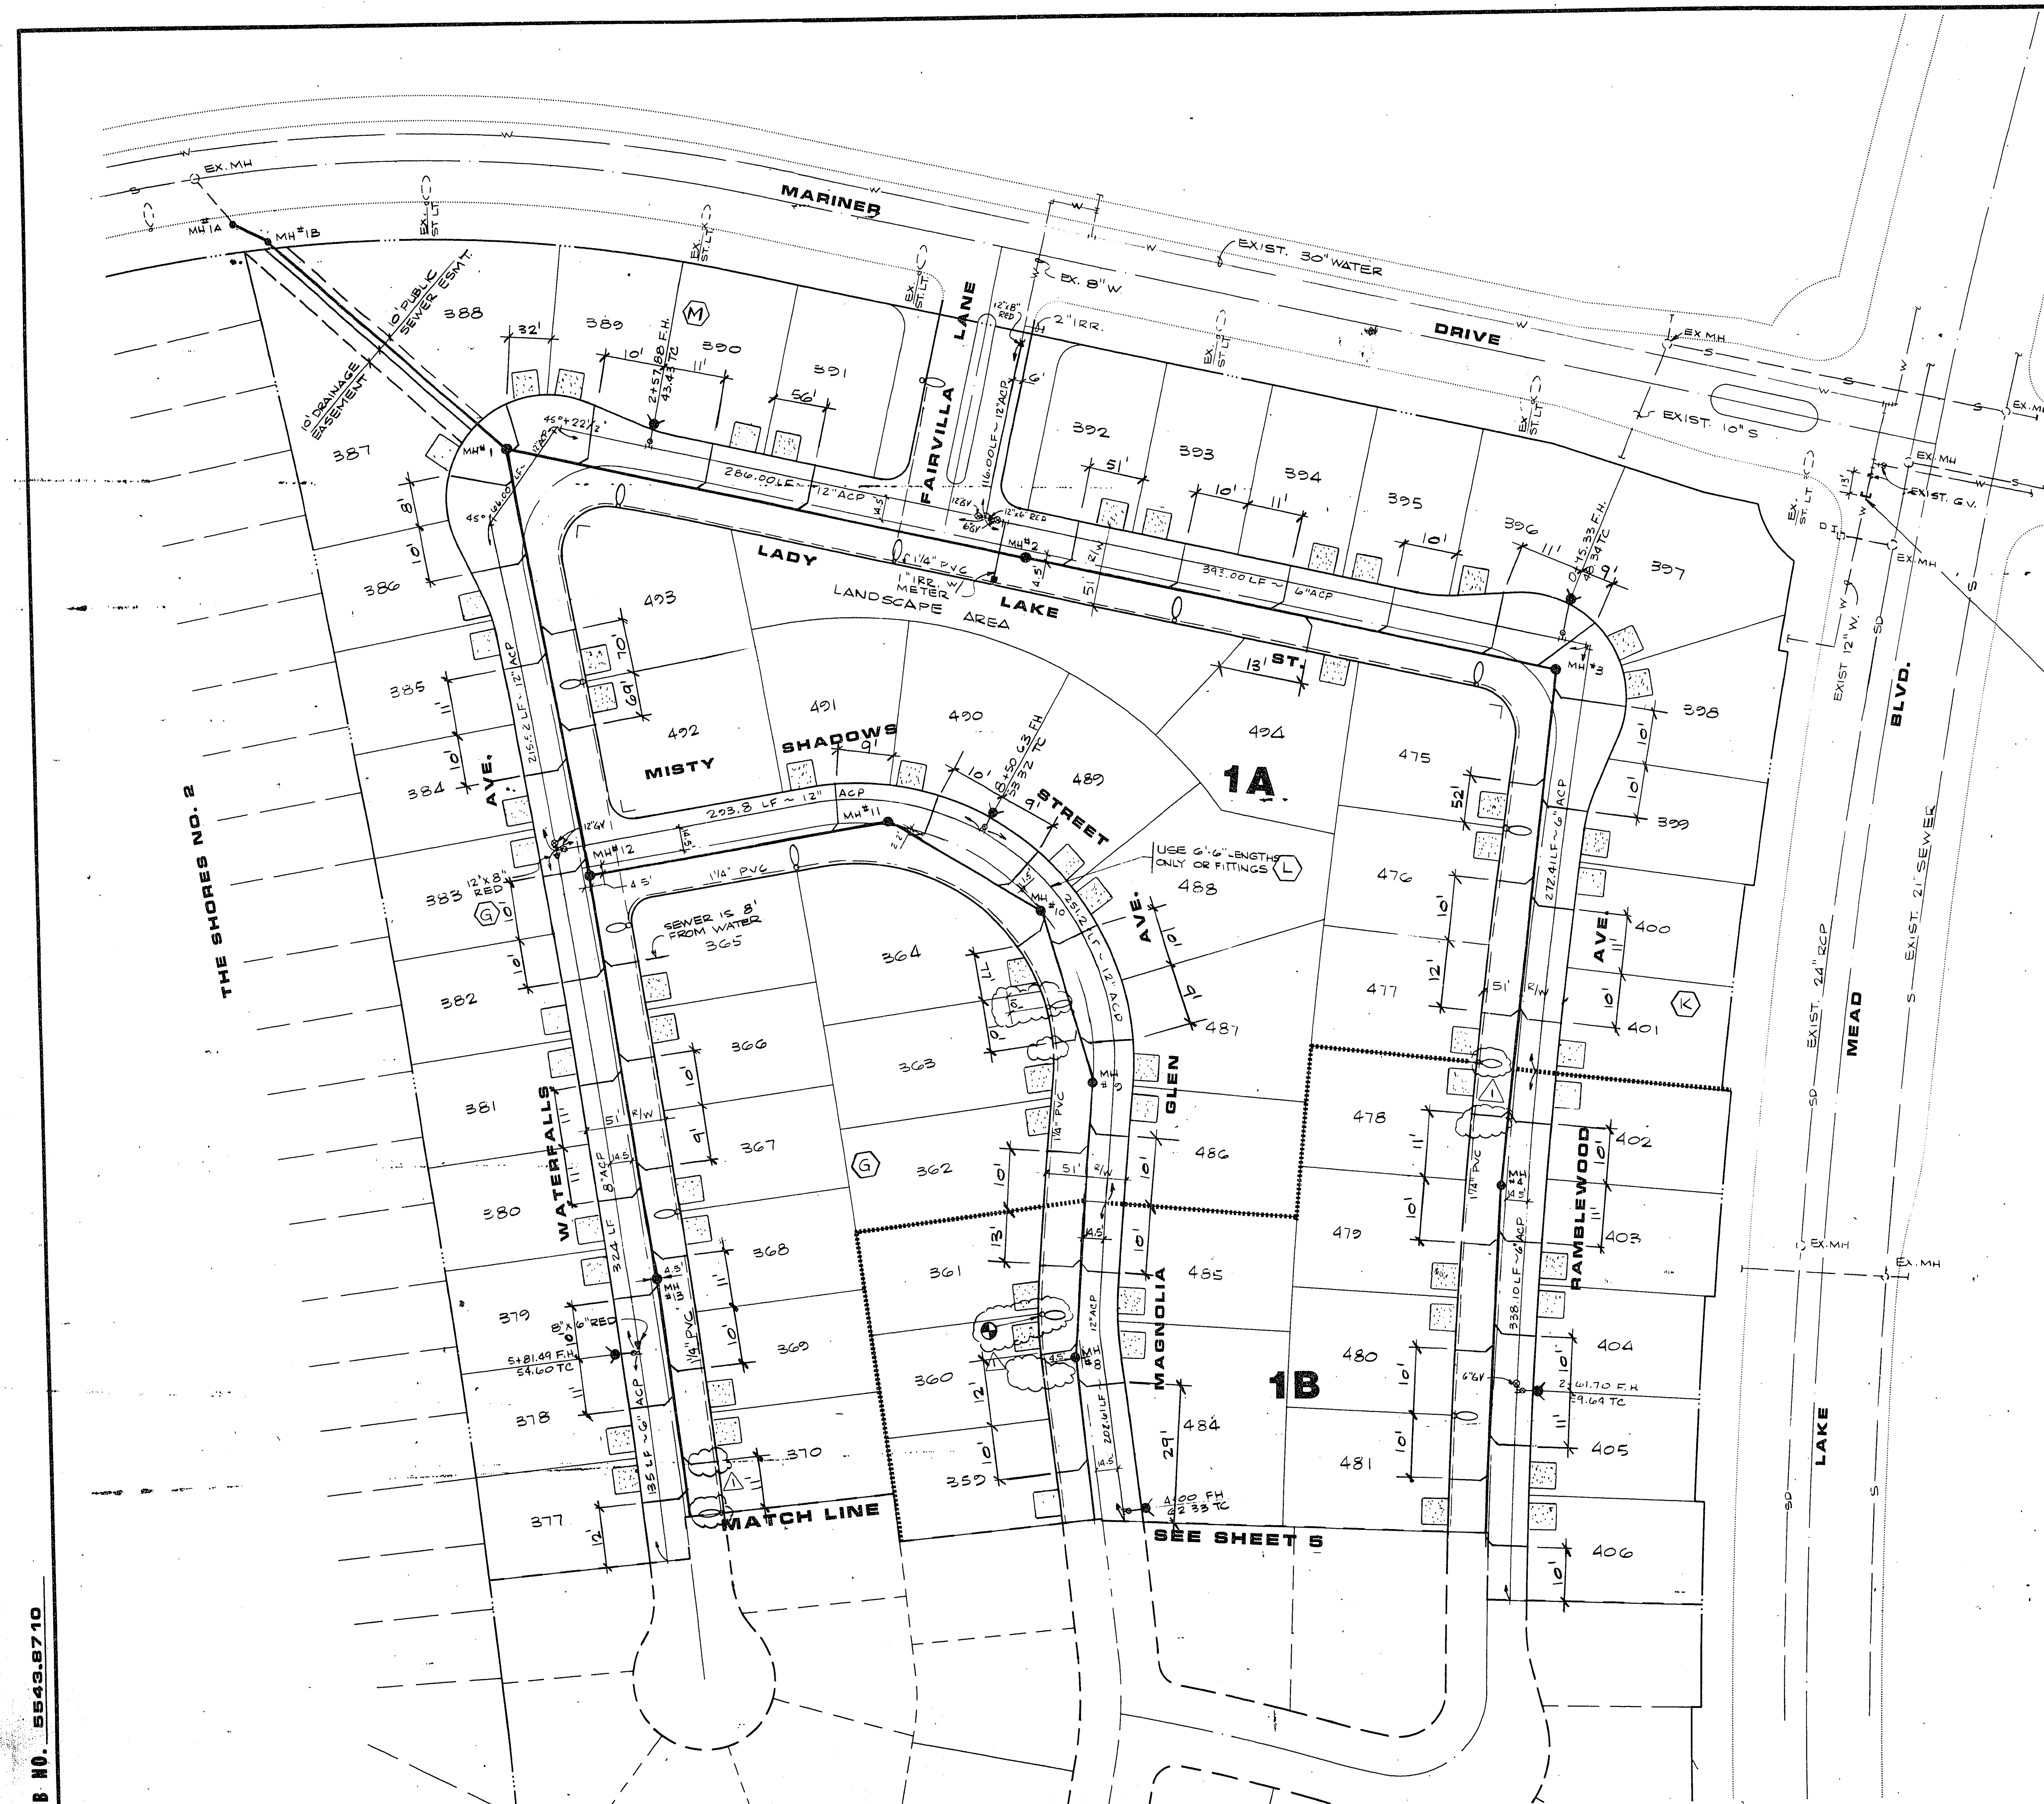

NORTH 1"=50'

ABANDONED VALVES

The Contractor shall abandon all existing valves where shown on the drawings by removing a minimum of the top 12 inches of the valve box and then filling the remaining portion of the valve box with concrete having a compressive strength of at least 2,000 psi. All valves to be abandoned shall be abandoned in the closed position unless shown otherwise on the drawings. The Contractor shall then backfill and repave the area disturbed during abondonment of the valve in accordance with the most current draft or edition of Uniform Standard Specifications for Public Works Construction Offsite Improvements Clark County area.

CAP EXISTING PIPE

(A) The Contractor shall cut the existing pipe where shown on the drawing and install a mechanical joint cap. Where a joint or coupling in the existing pipe is uncovered at the cut and cap locations, the installation of a cap or plug may be permitted, with District approval.

(B) The Contractor shall install a concrete thrust block in accordance with the provisions of the District's Standard plate No. 5 at all installed caps and / or plugs.

APPROVED FOR CONSTRUCTION: SHORES 1A, 1B, 1C, + 1D
L.V.V.W.D. 9-6-89

REV	DATE	DESCRIPTION
1	3/10/90	RELOCATED STREET LIGHTS
2	6/5/91	AS-BUILT SEWER LAT'S.

RECOMMENDED: DAVID P.N. HUCKLE — 5256 R.E. NO. — 9-6-89 DATE

G.C. WALLACE, INC.
Engineering/Architecture
1555 SOUTH RAINBOW BLVD / LAS VEGAS, NEVADA 89102

LEWIS HOMES OF NEVADA
THE SHORES NO. 1A, 1B, 1C & 1D BY LEWIS HOMES
UTILITY PLAN

SHEET 6 OF 29 SHEETS

JOB NO. 5543.8710

8/84 DIETERICH-POST 6532B

"As Built" 3074-4066-1