


DATE	6/13/13
REV	
DESCRIPTION	
DATE	6/13/13
REV	
DESCRIPTION	
DATE	6/13/13
REV	
DESCRIPTION	







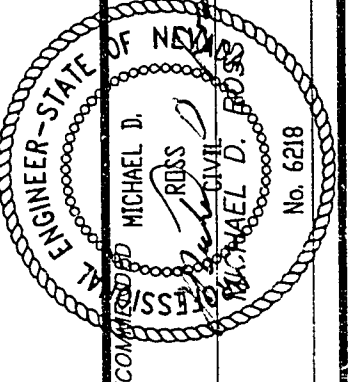


G.C. WALLACE, INC.
Engineering/Architecture
1555 SOUTH RAINBOW BLVD., LAS VEGAS, NEVADA 89102

DEL WEBB COMMUNITIES, INC.
SUN CITY LAS VEGAS
STREET SECTIONS & DETAILS

SHEET
9
OF 10 SHEETS

10-2-17 107-V2119

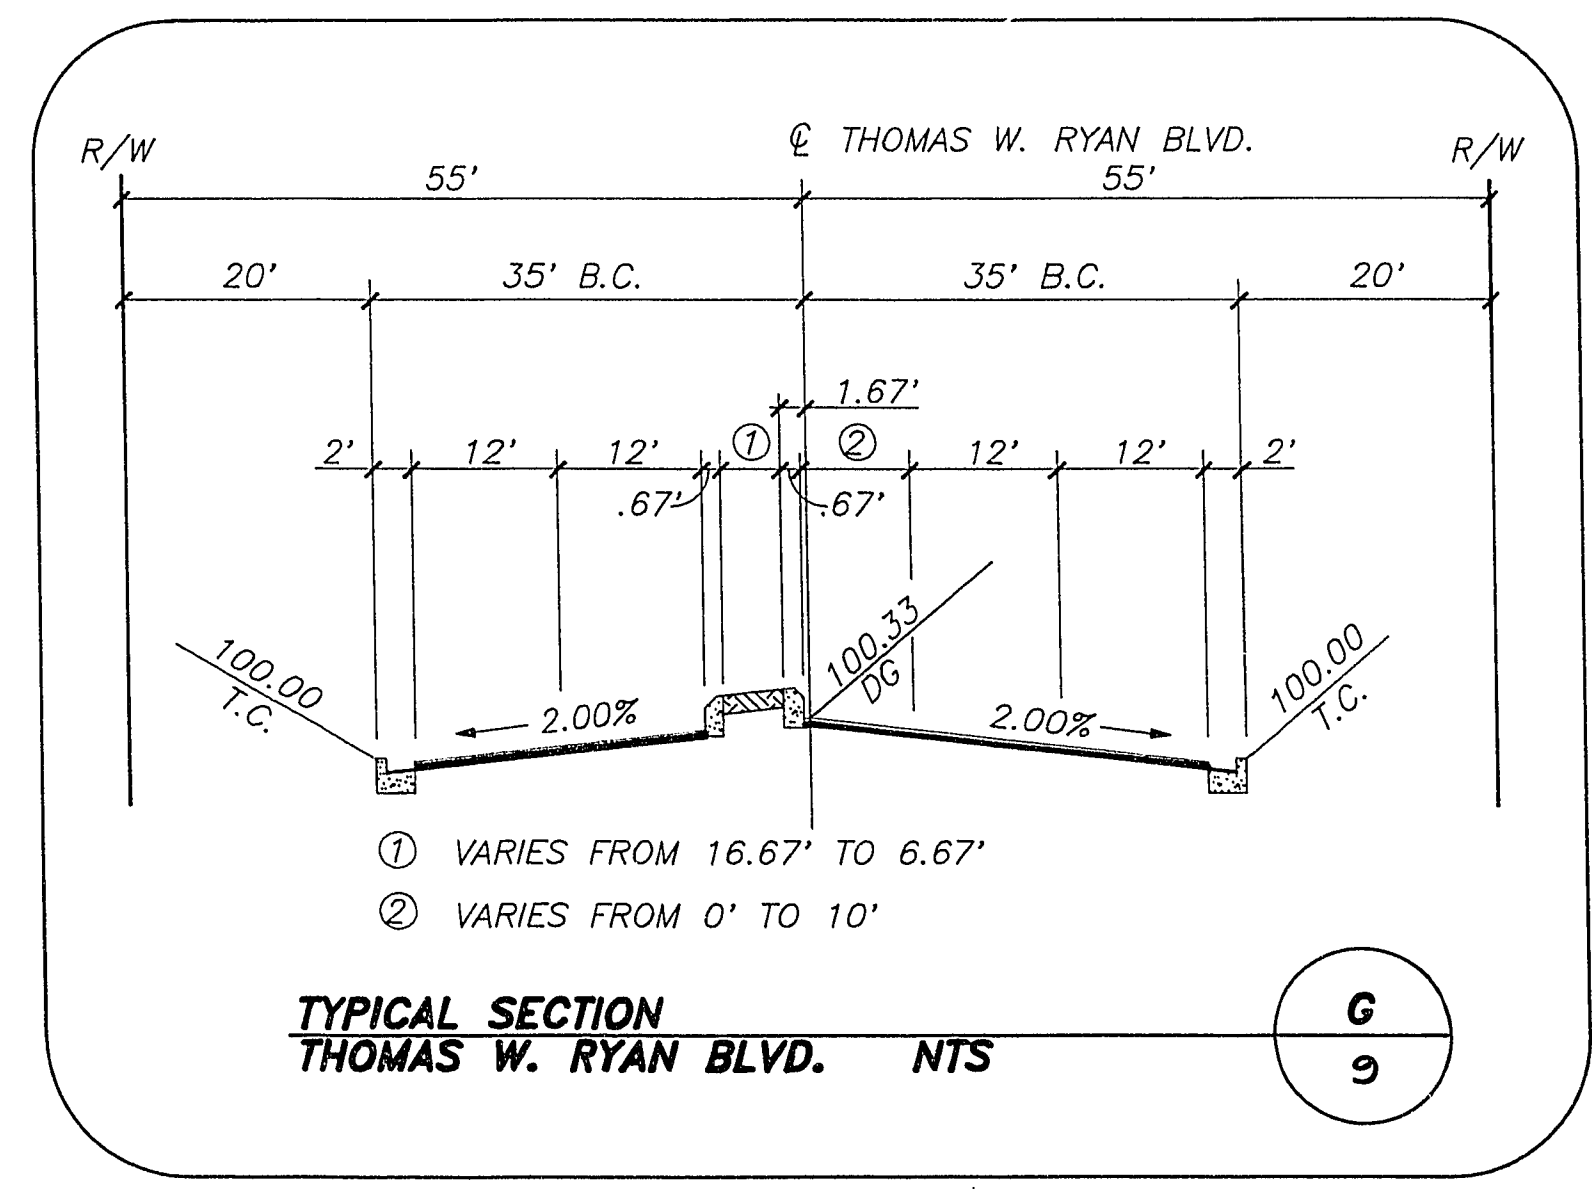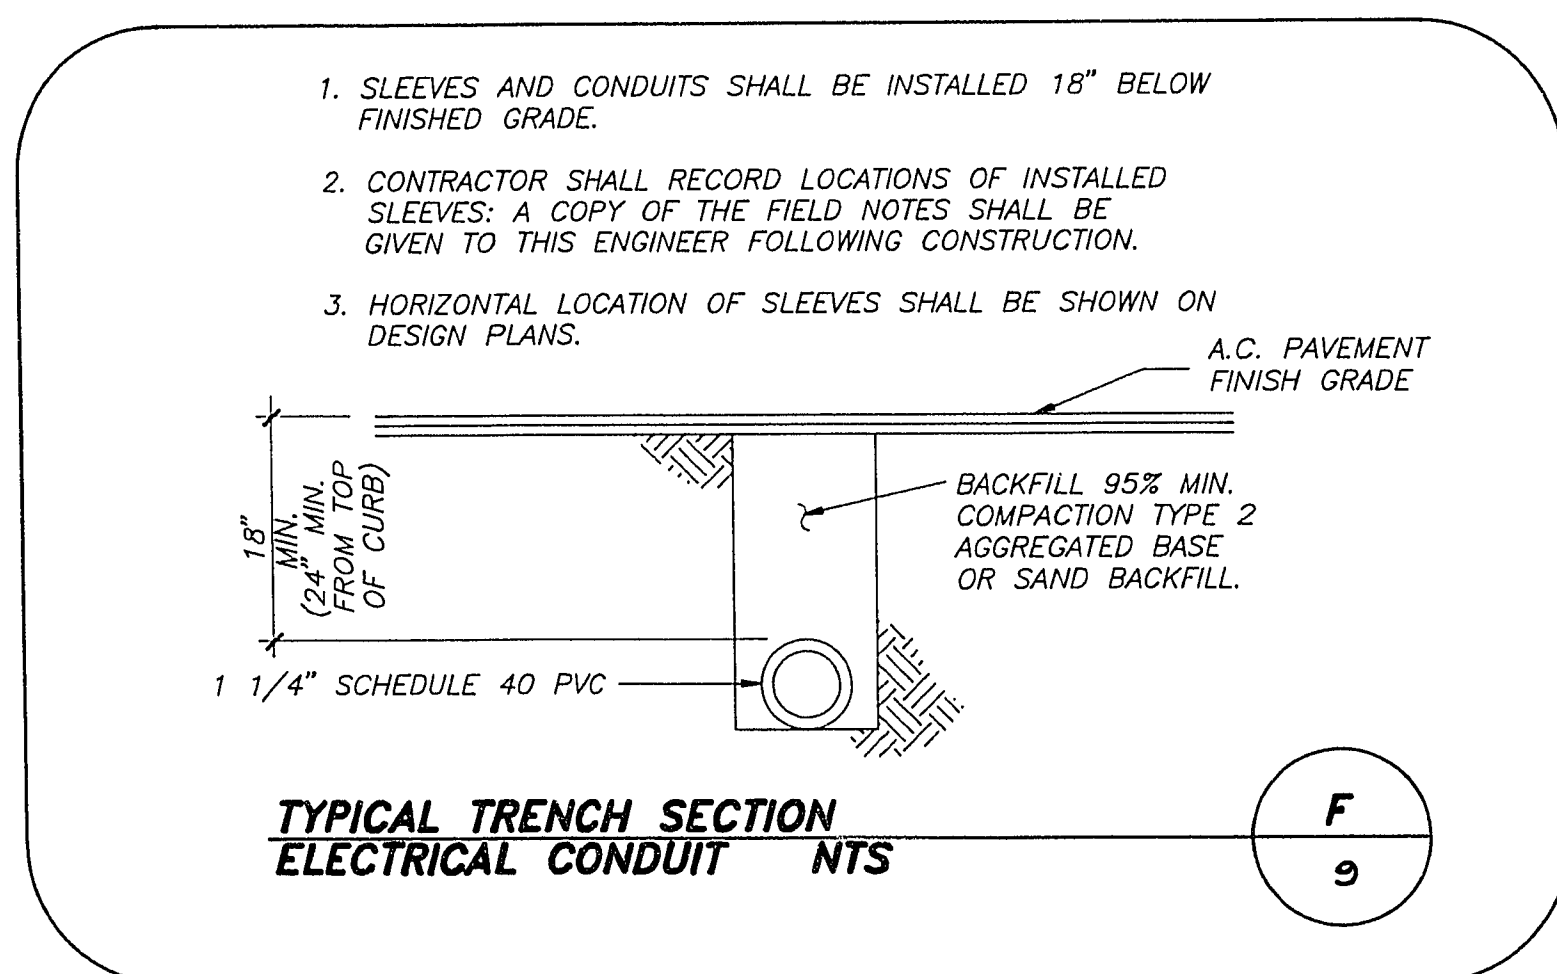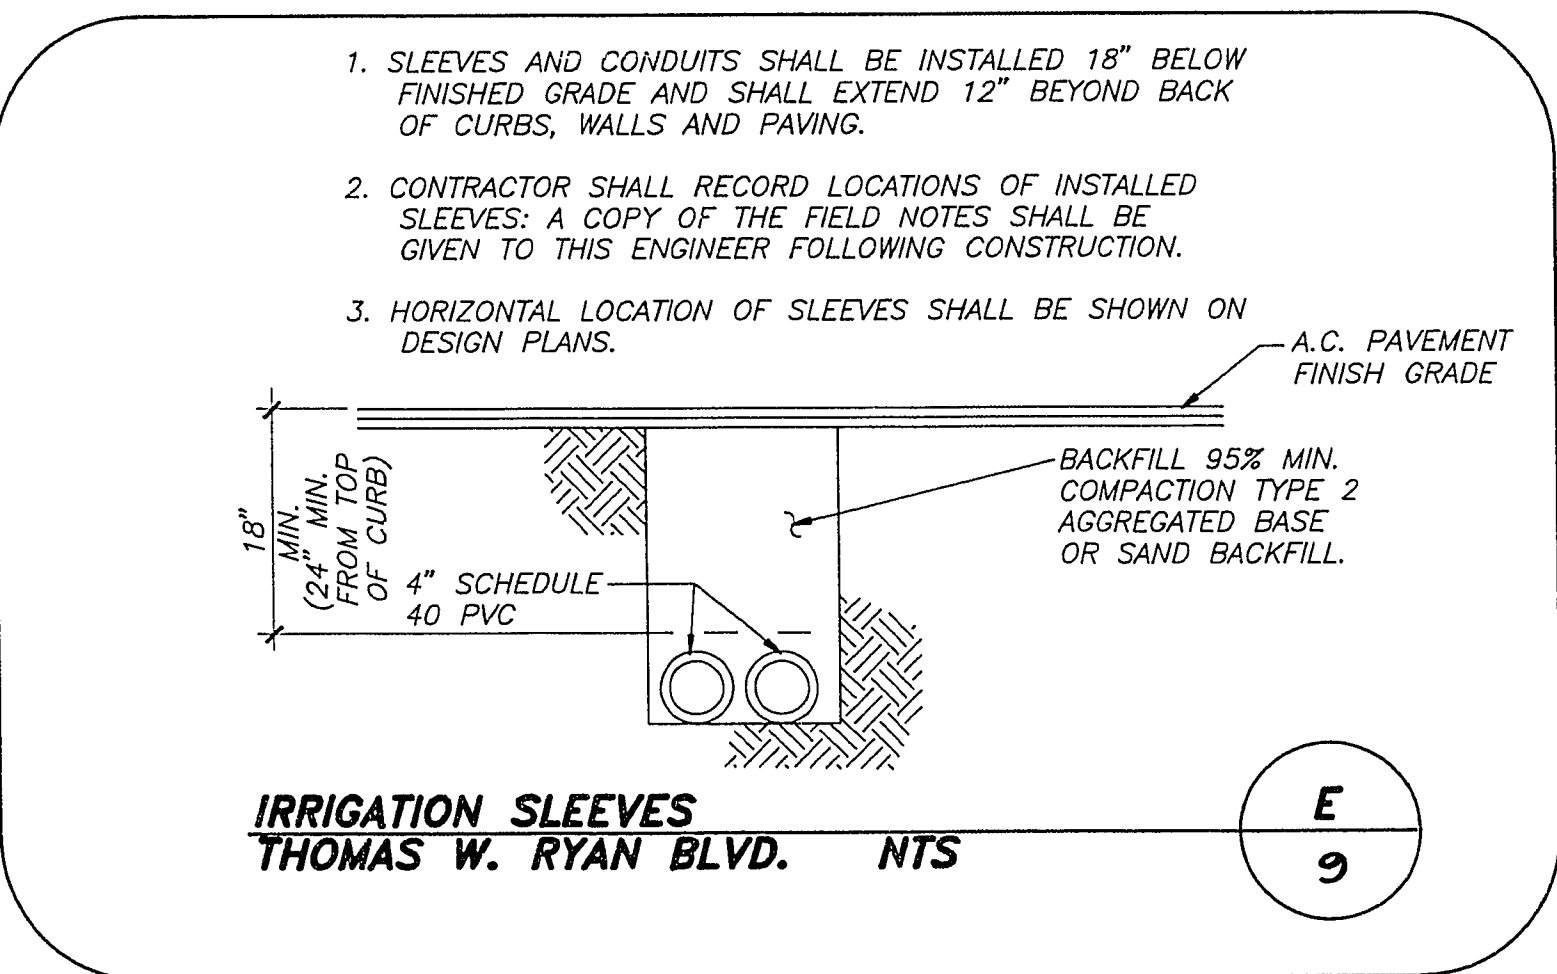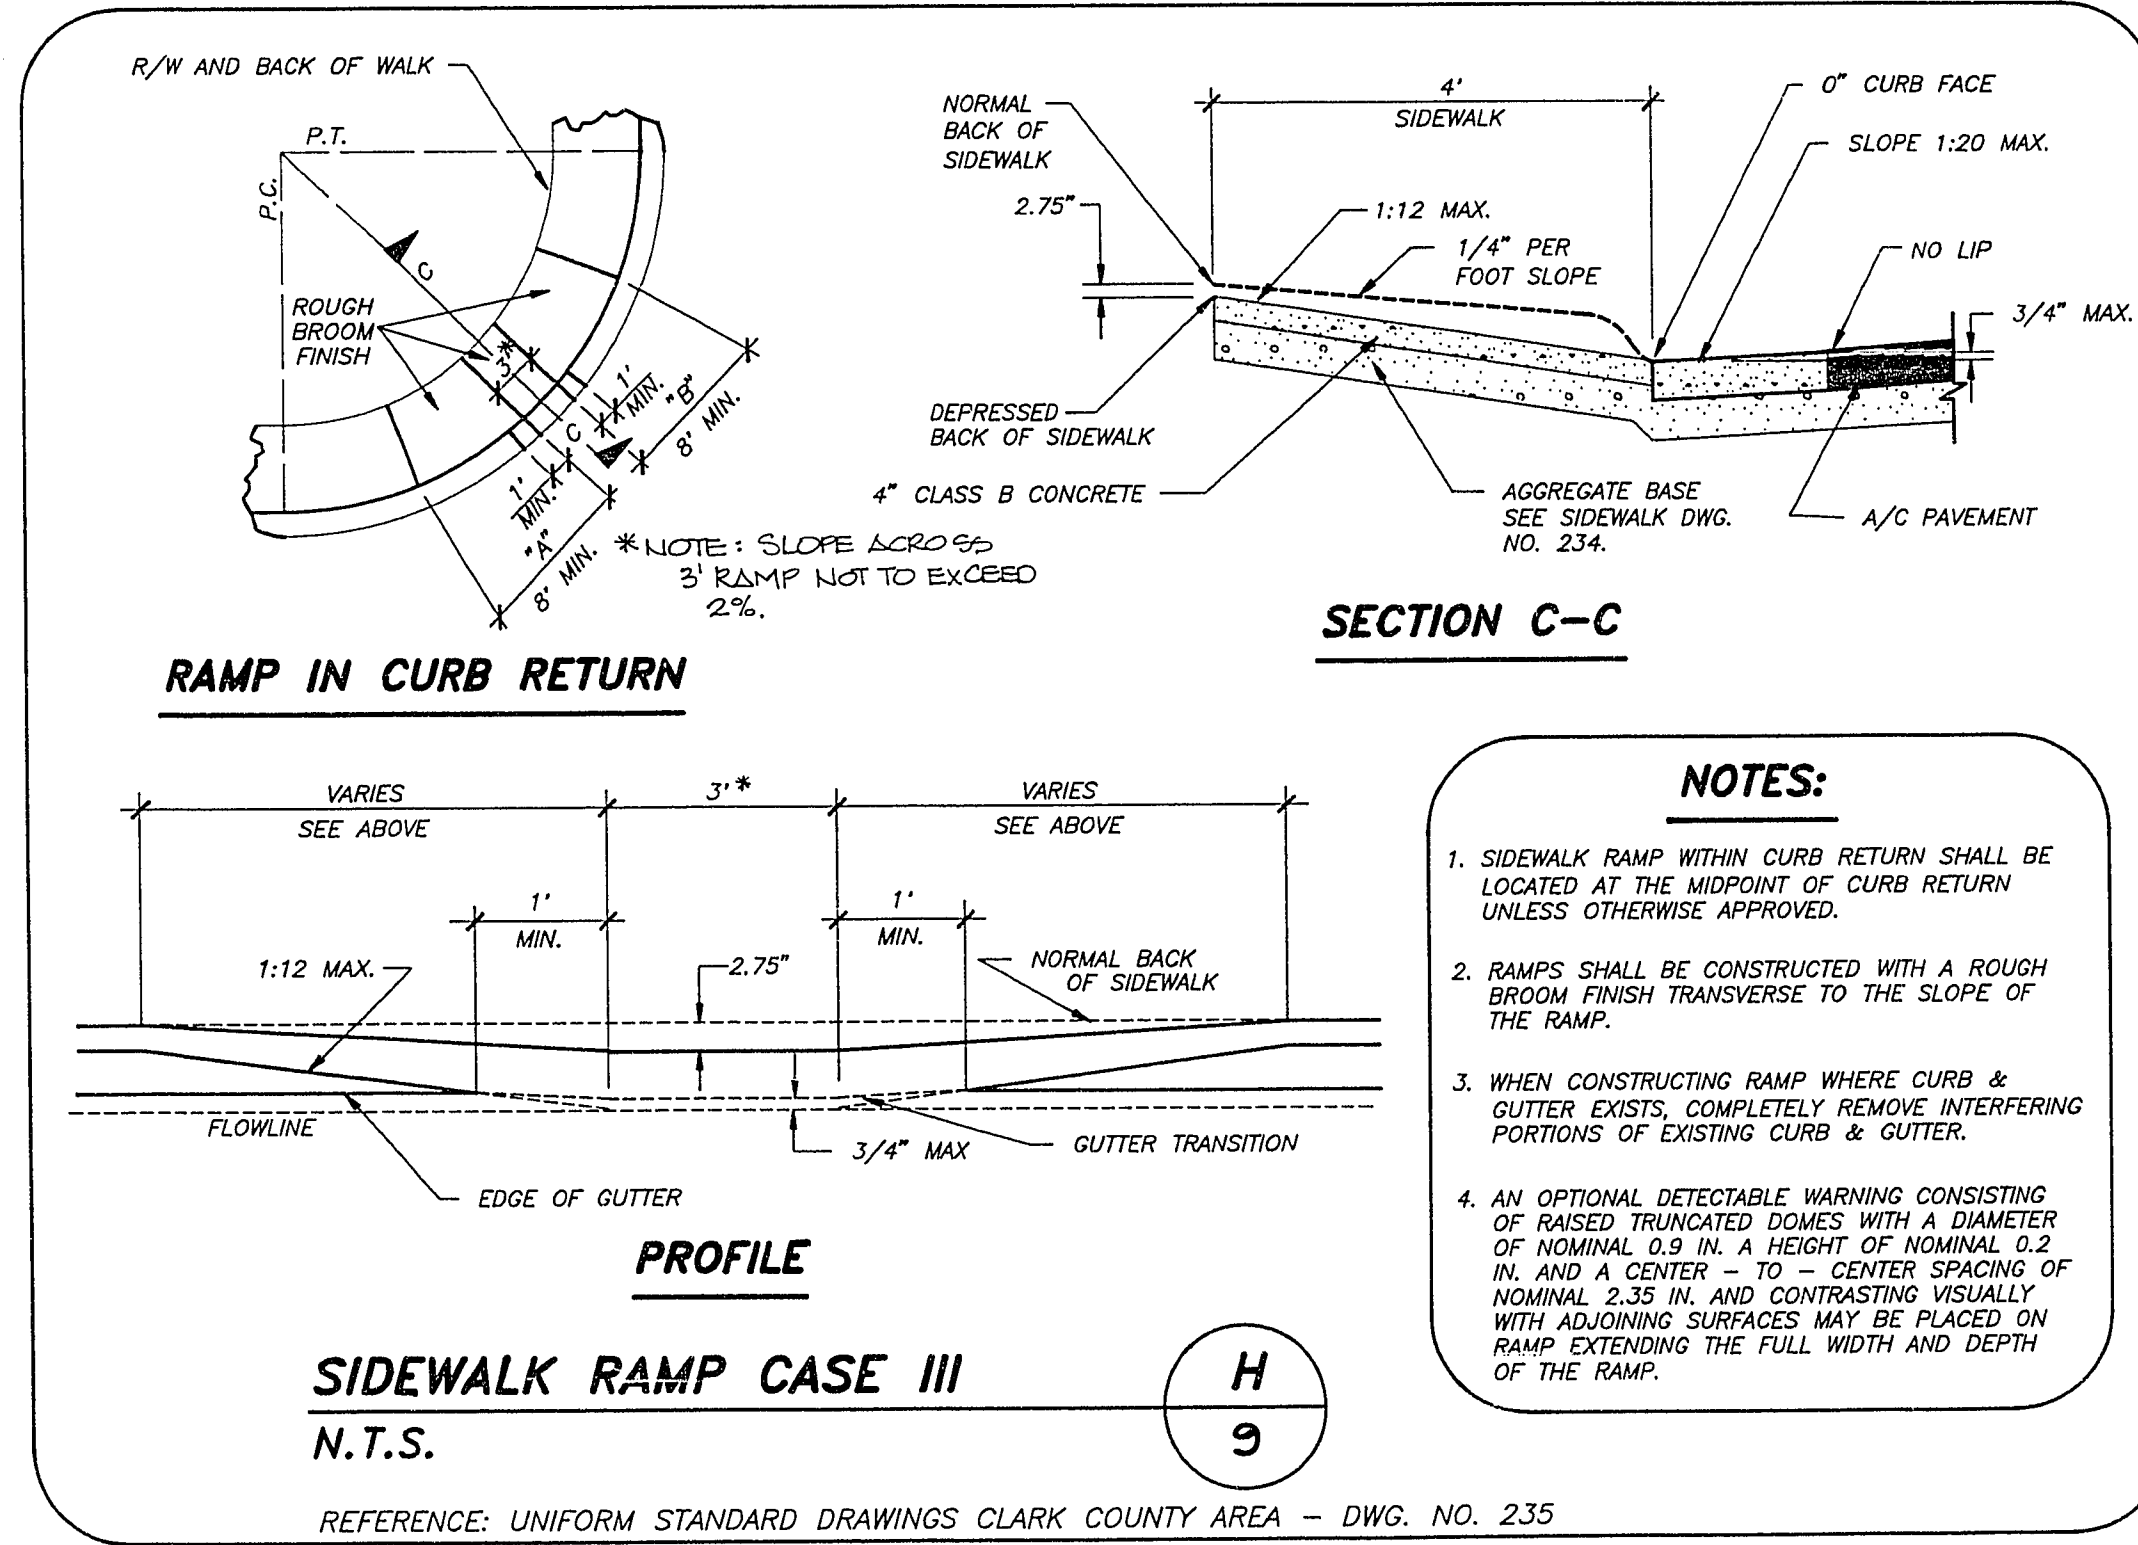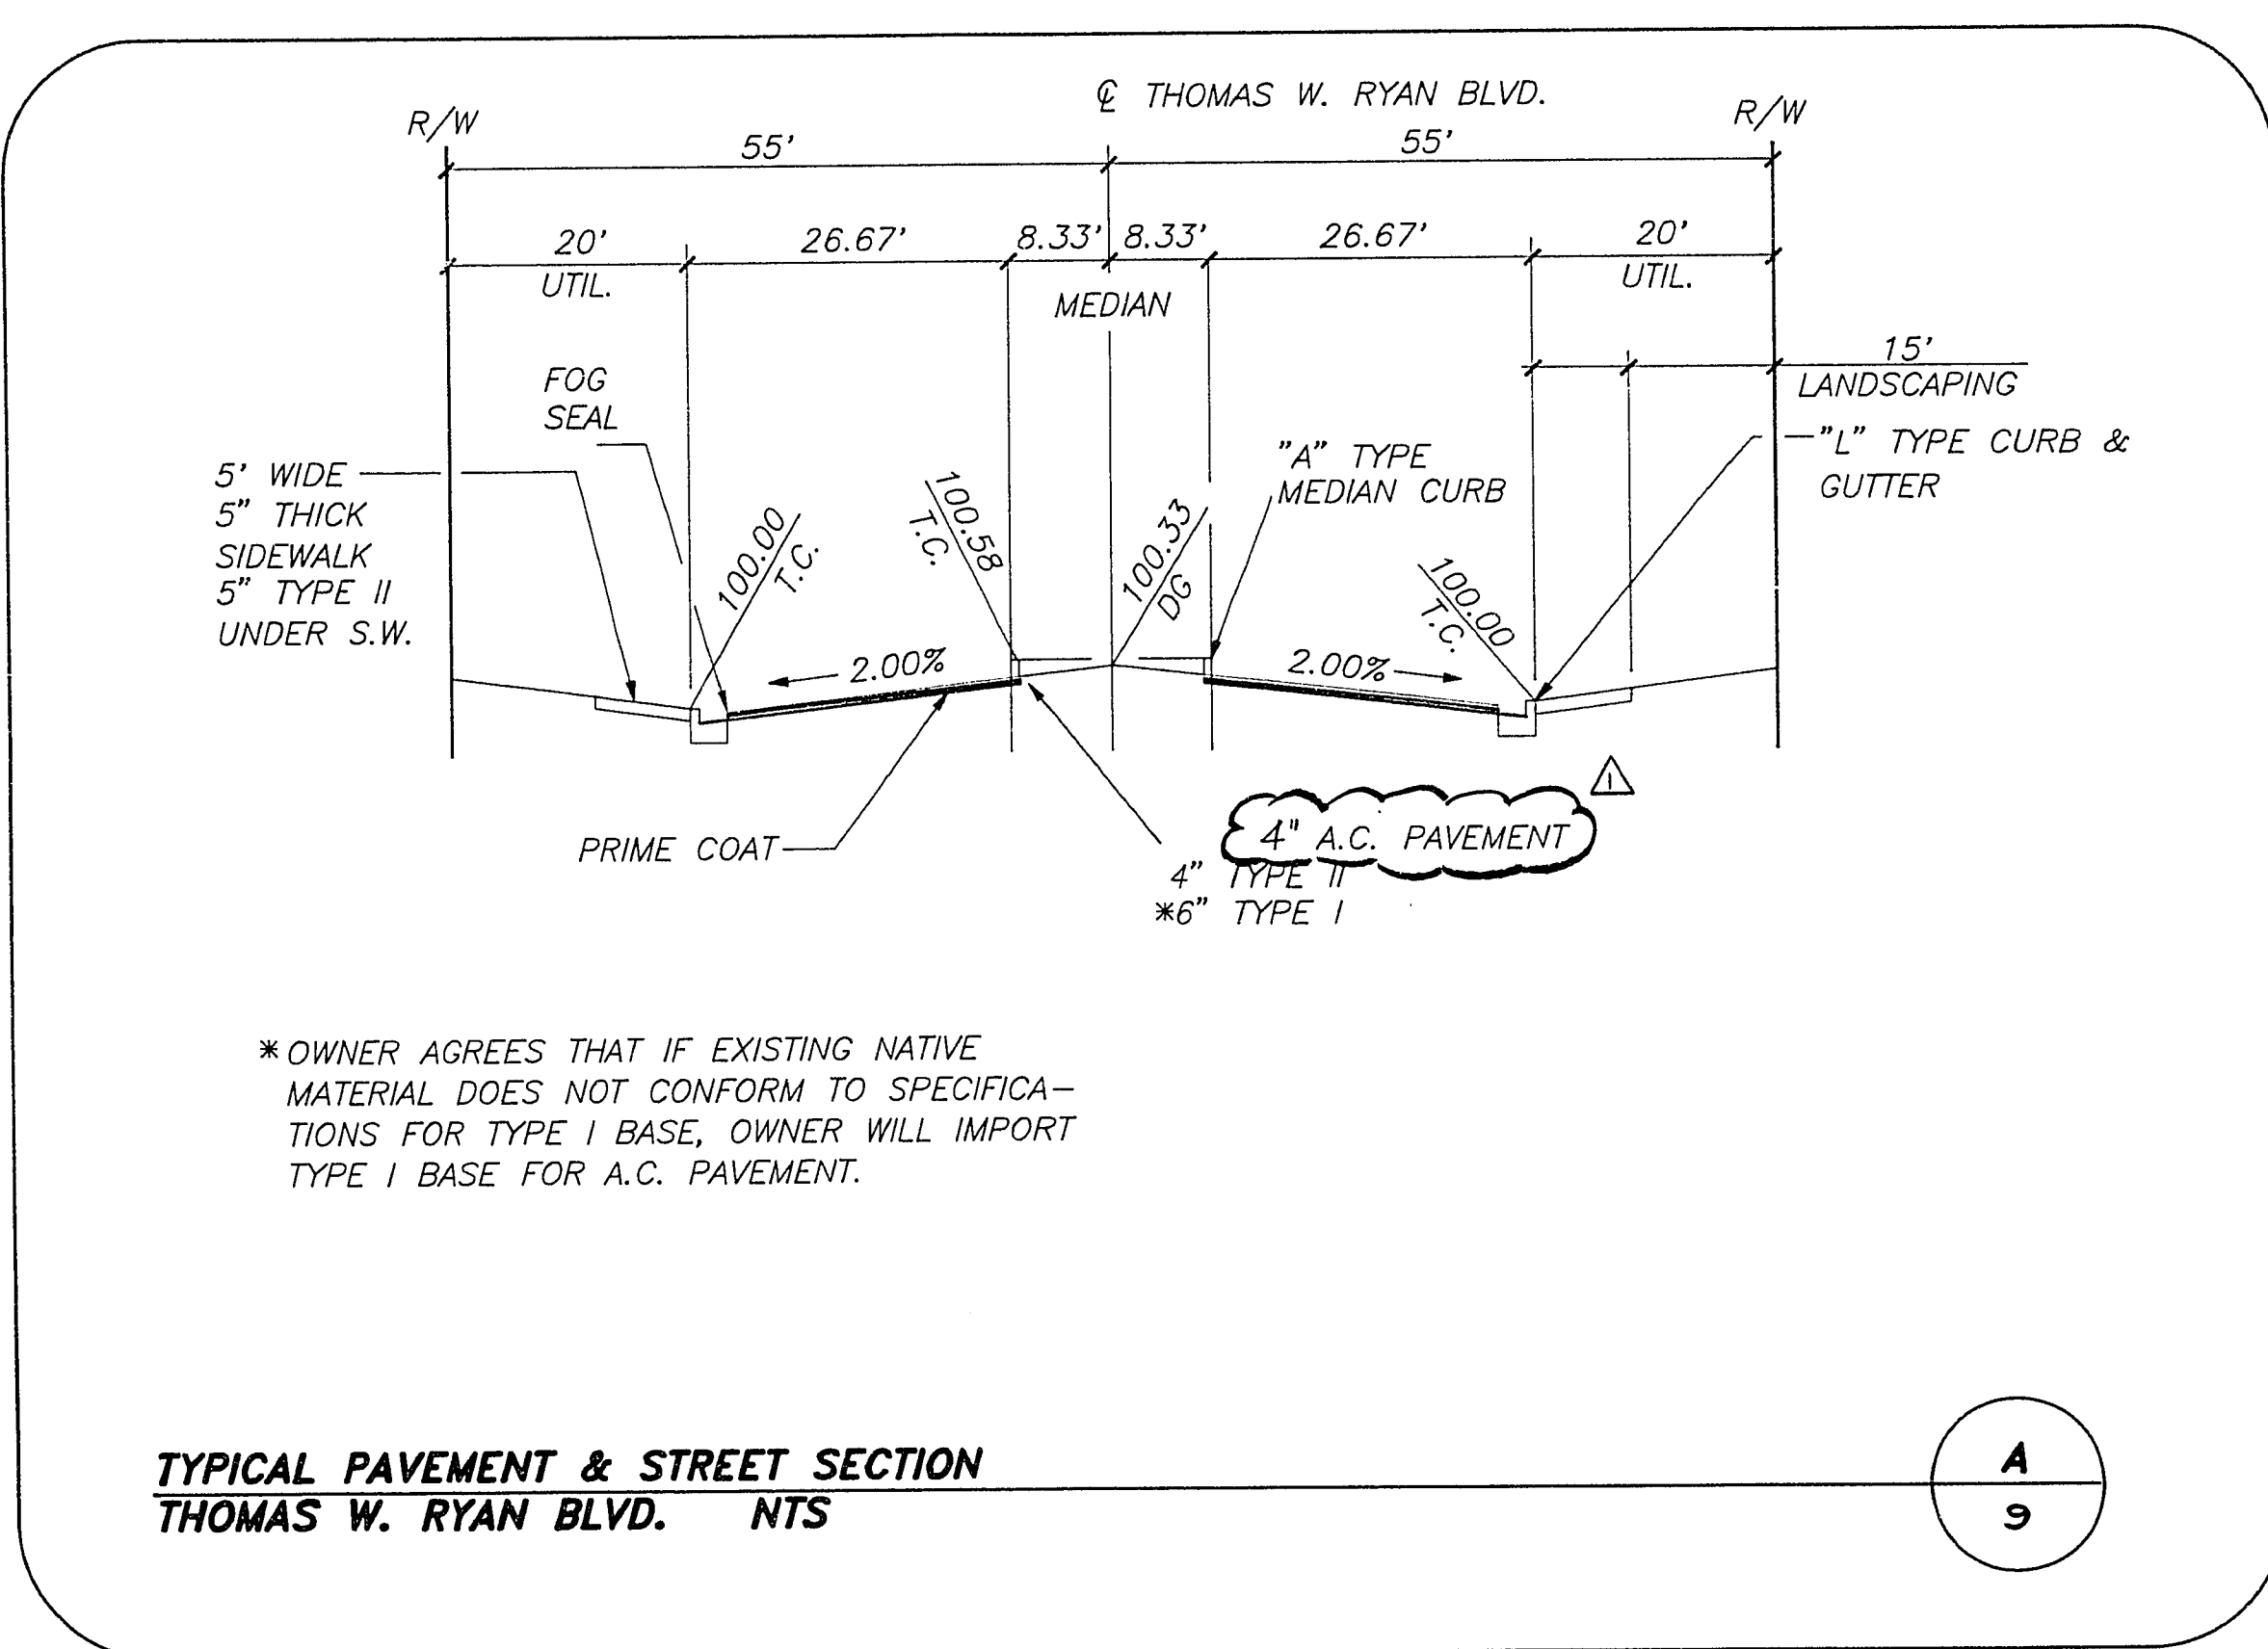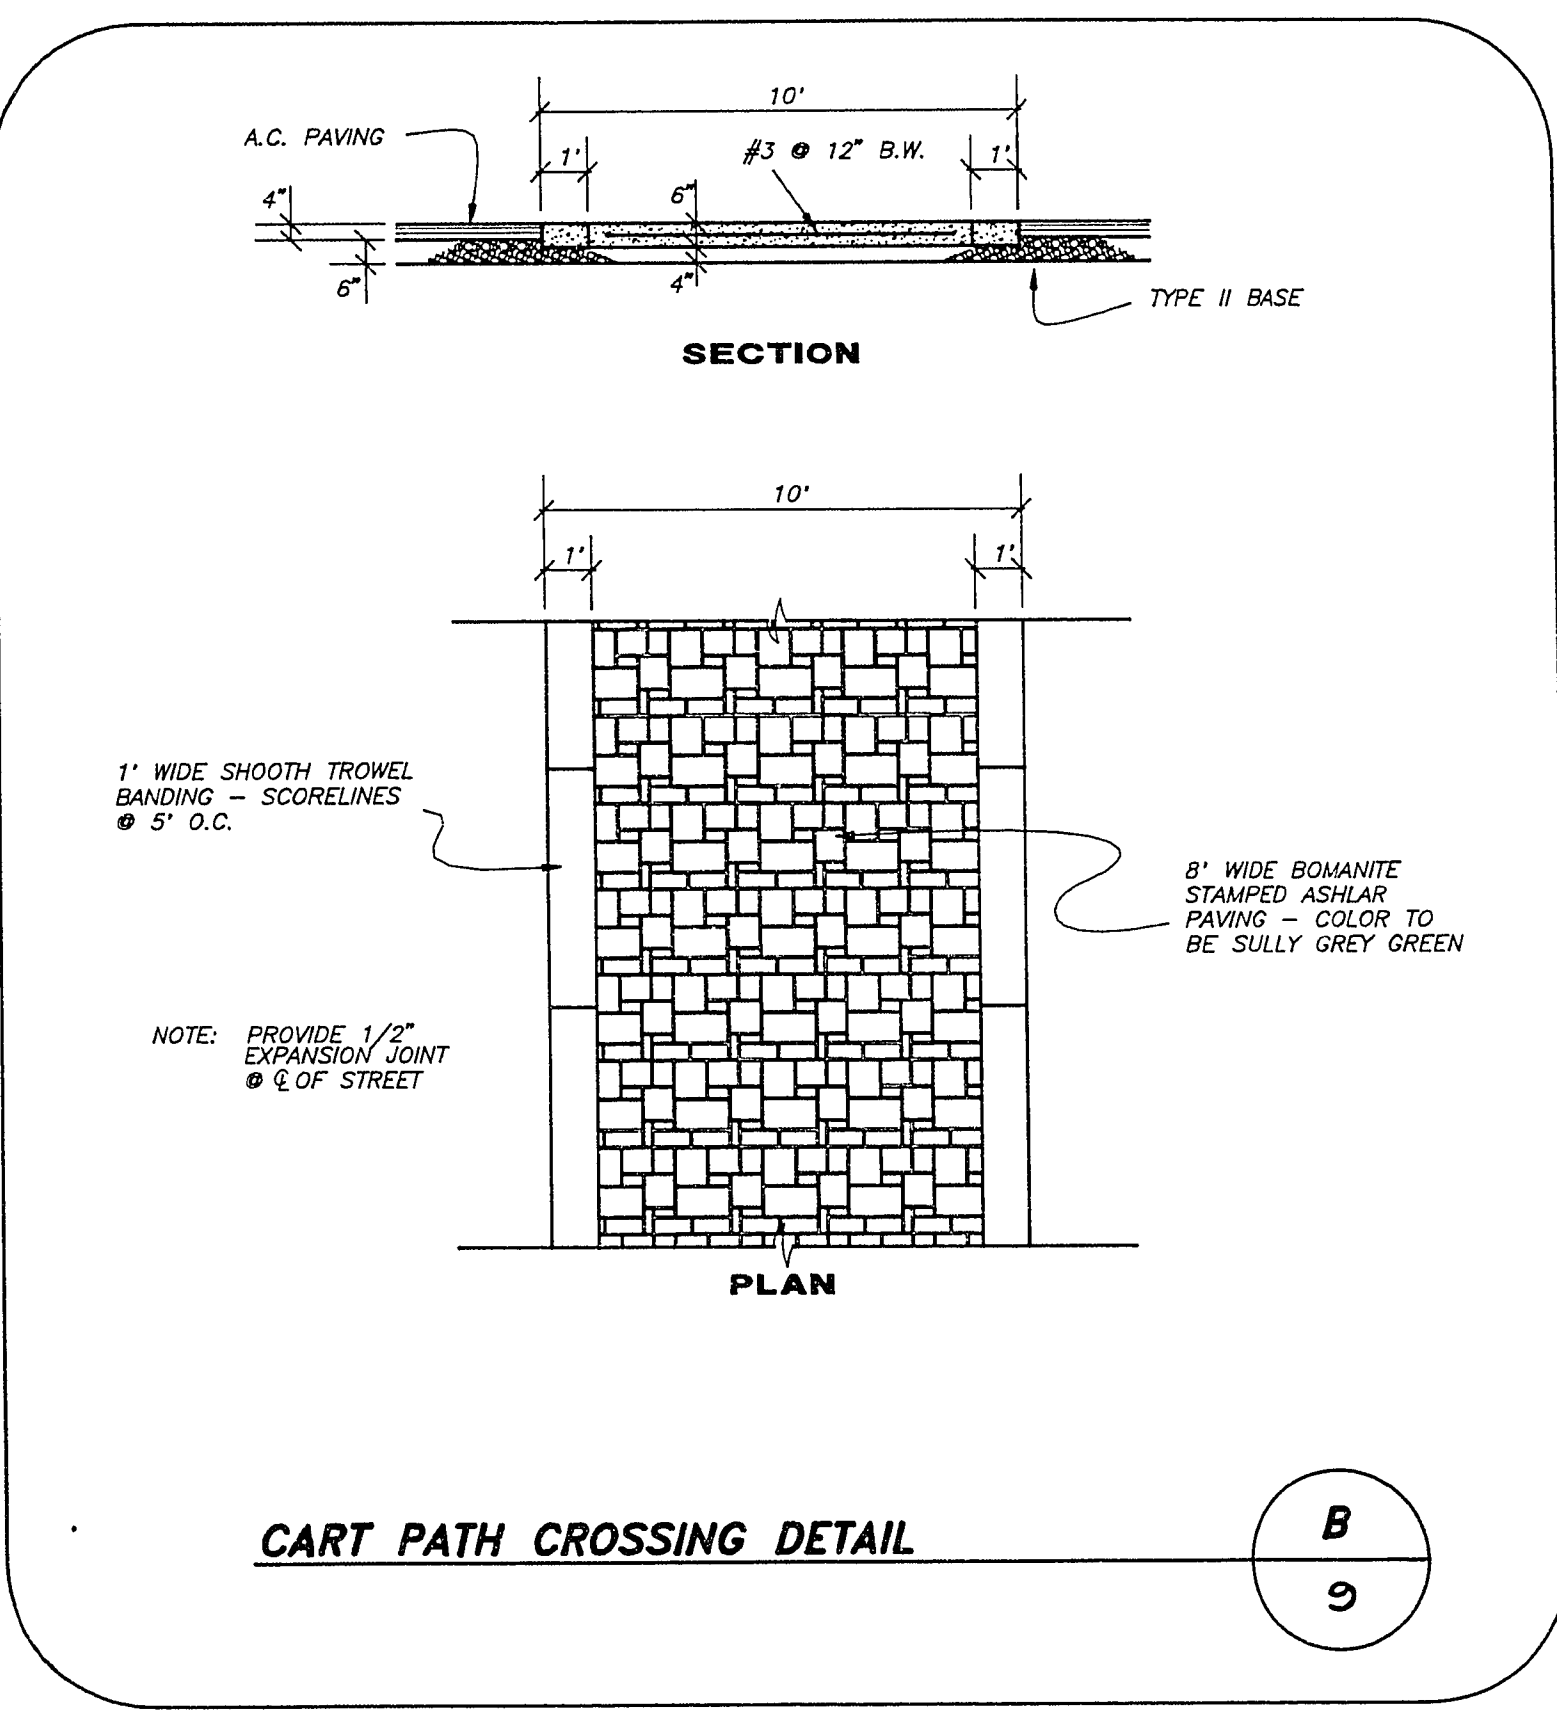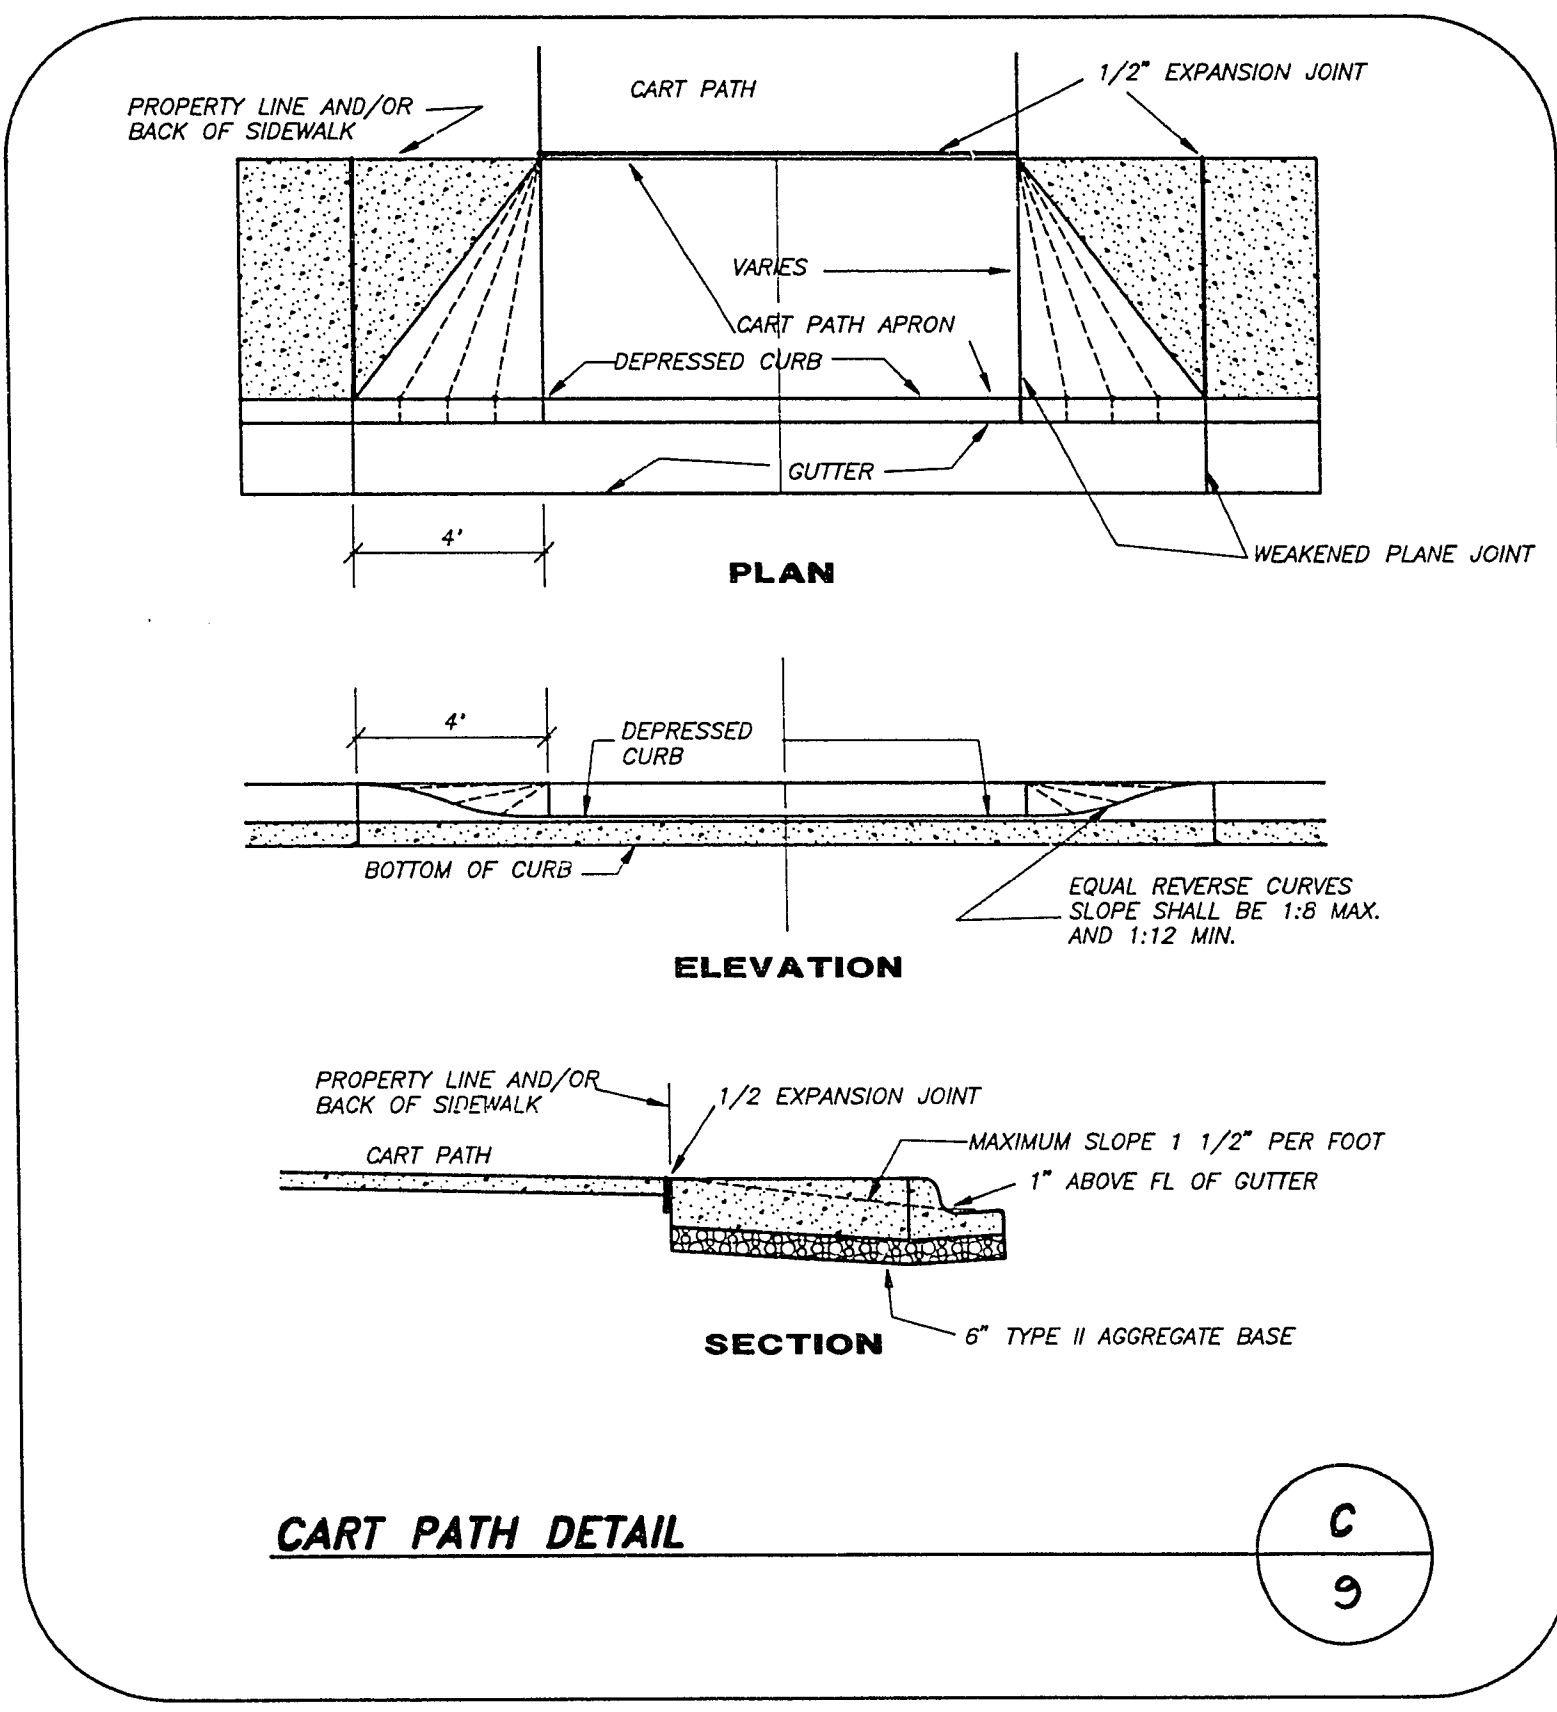

JOB NO. 701.127