


7-2-75

(MEADOWS WEST BUCKSKIN SUBDIVISION)

VICINITY MAP

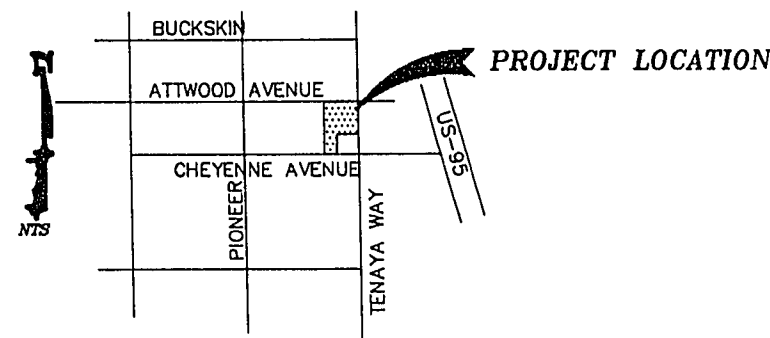

LEGEND:



- FIRE HYDRANT W/ ASSEMBLY
- PROPOSED WATER METER
- PROPOSED 90° BEND
- PROPOSED REDUCER
- PROPOSED TEE
- "C" CHEYENNE AVENUE
- "T" TENAYA WAY

INSTALLATION OF DETECTOR CHECK AND VAULT


The detector check(s) and vault(s) with non-traffic bearing cover(s) shall be installed in accordance with the District's Standard Plate 19 and with standard vault drawing C-475, latest revision.

Any block wall or other fence material shall be designed and constructed around the outside of the easement(s), so as to allow the District direct access to the vault(s) from the adjacent right-of-way.

(APN:280-730-012)
UNDEVELOPED

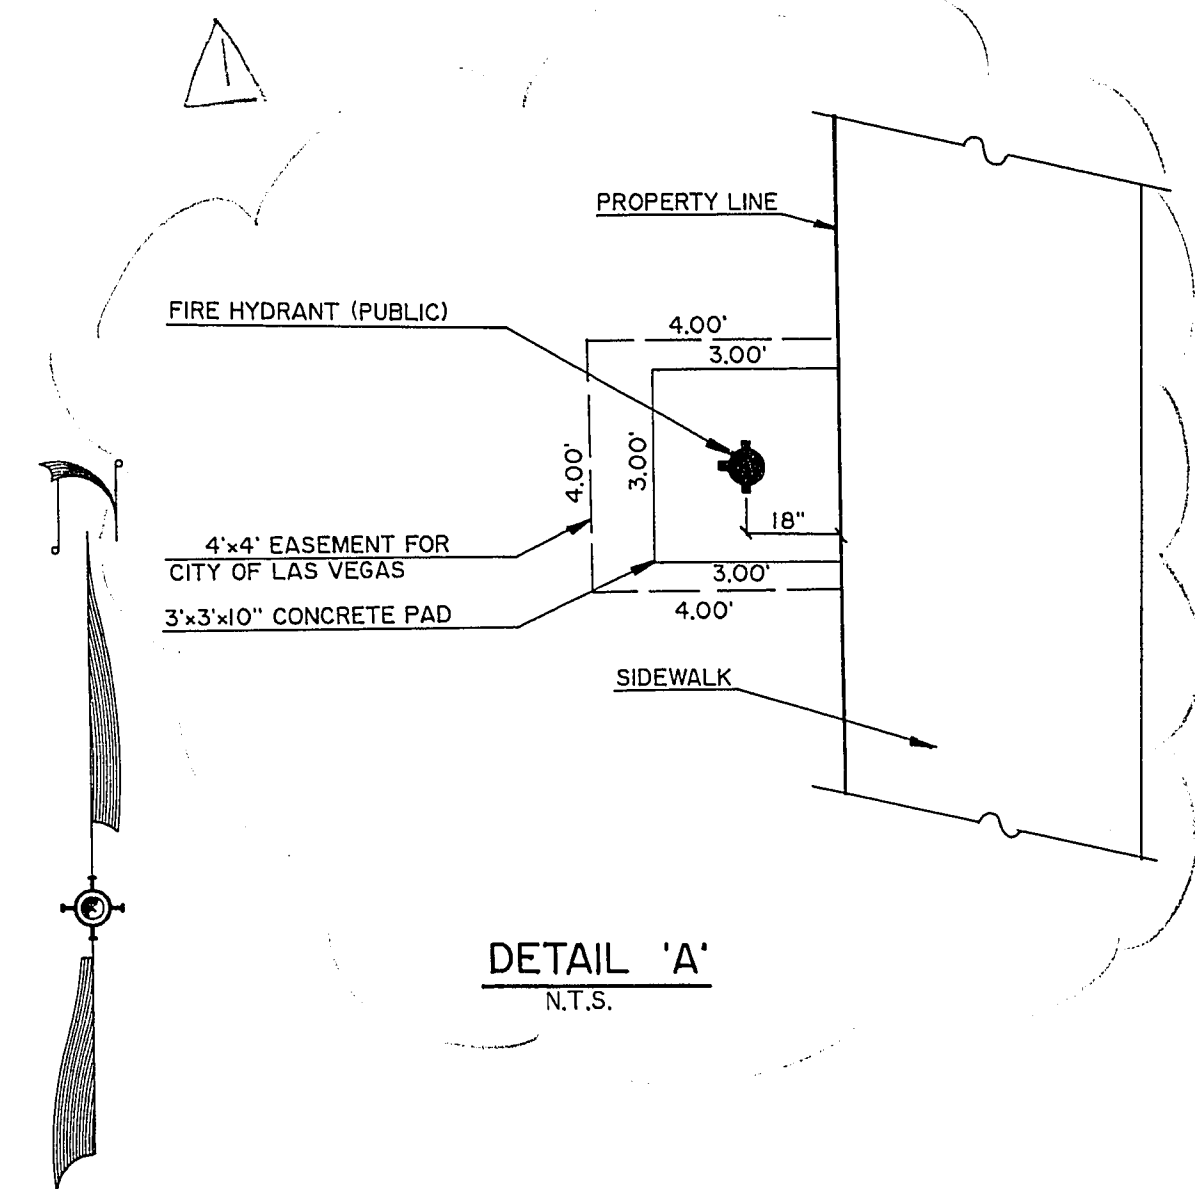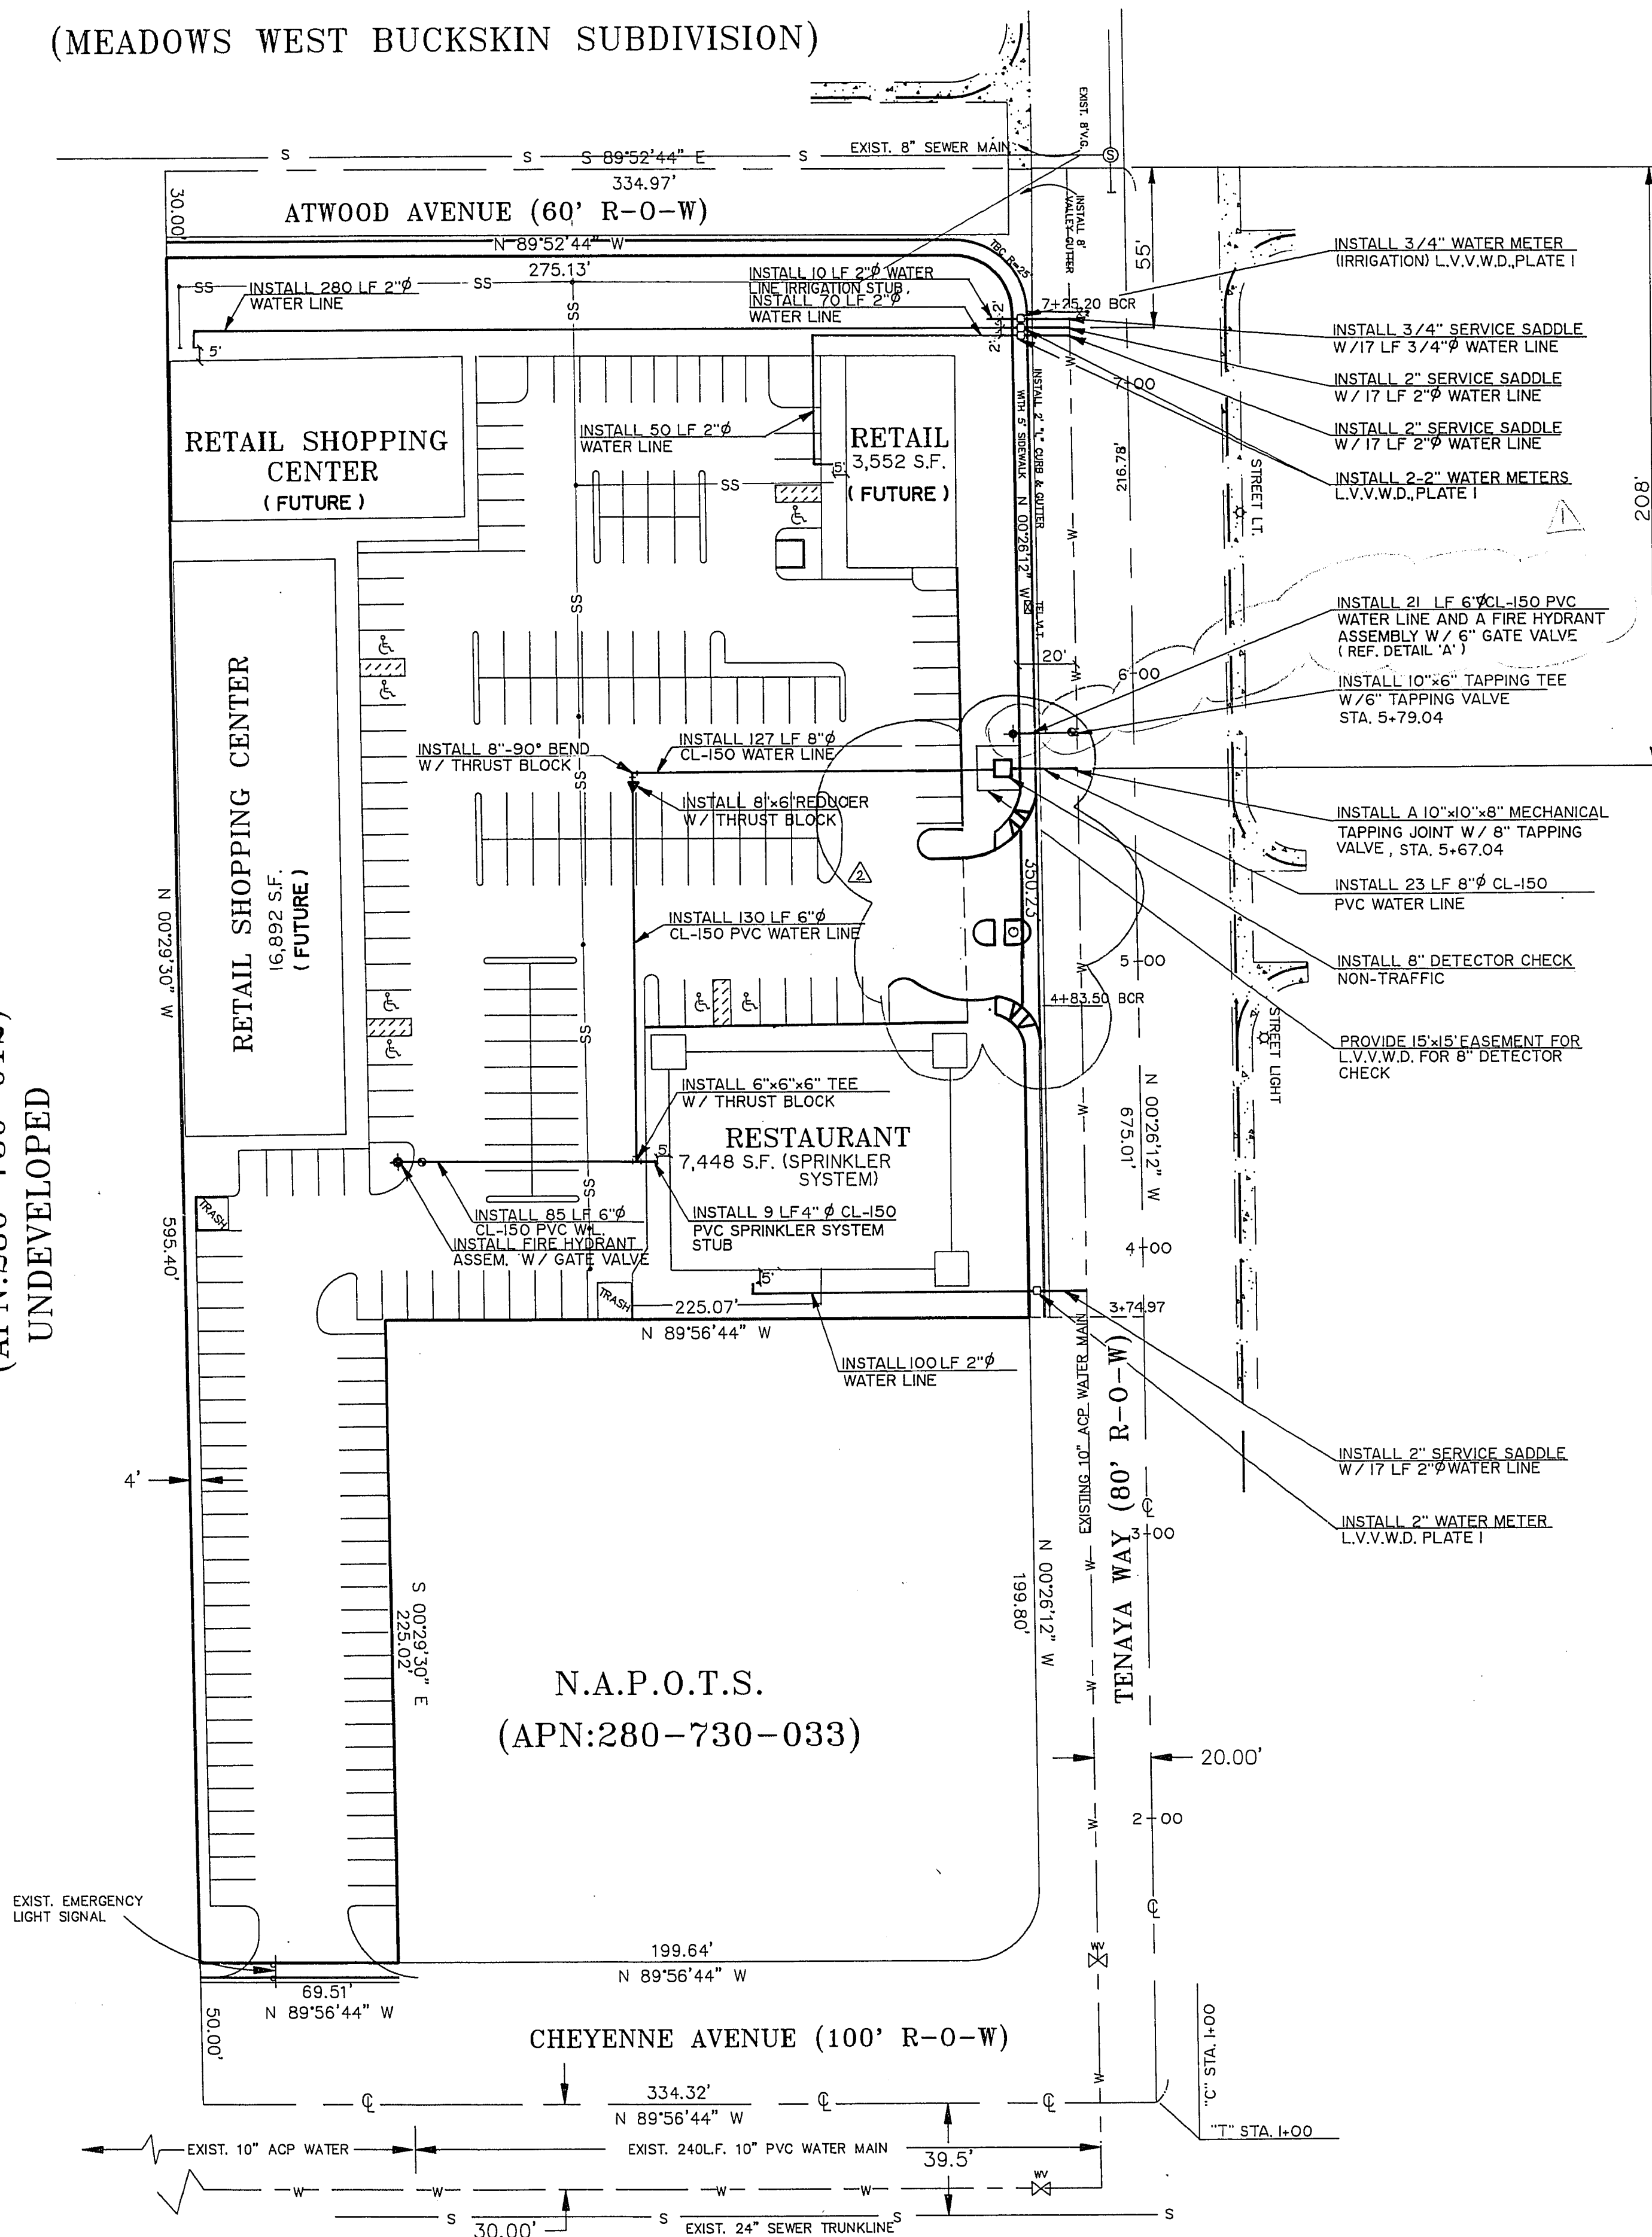

SCALE: 1"=40'

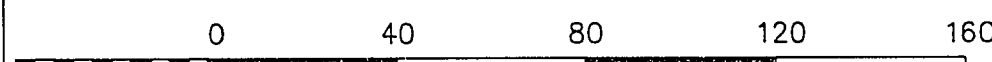

CONTOUR INTERVAL=1.0FT.


ESTIMATED WATER QUANTITIES (PUBLIC)

DESCRIPTION	AMOUNT
3/4" WATER METER	1 EA
2" WATER METER	3 EA
3/4" COPPER LATERAL	17 LF
TYPE K ASTM B88	
2" COPPER LATERAL	51 LF
TYPE K ASTM B88	
MECHANICAL JOINT W/ 8" TAPPING VALVE	1 EA
3/4" SERVICE SADDLE	1 EA
2" SERVICE SADDLE	3 EA
8" DETECTOR CHECK	1 EA
8" CL-150 PVC WATER LINE	23 LF
FIRE HYDRANTS	1 EA
6" GATE VALVE	1 EA
6" CL-150 PVC WATER LINE	24 LF

ESTIMATED WATER QUANTITIES (PRIVATE AND TO BE MAINTAINED BY OWNER)

DESCRIPTION	AMOUNT
8" CL-150 PVC WATER LINE	127 LF
8"-90° BEND W/THRUST BLOCK	1 EA
8"x6" REDUCER	1 EA
6" CL-150 PVC WATER LINE	244 LF
6"x6"x6" TEE W/THRUST BLOCK	1 EA
FIRE HYDRANT W/	1 EA
6" GATE VALVE	
2" COPPER LATERAL	500 LF
3/4" COPPER LATERAL	10 LF
TYPE K ASTM B88	

REVISIONS AS OF 10/29/93
ARE THE RESPONSIBILITY OF
BRET H. WOLZ, P.E.

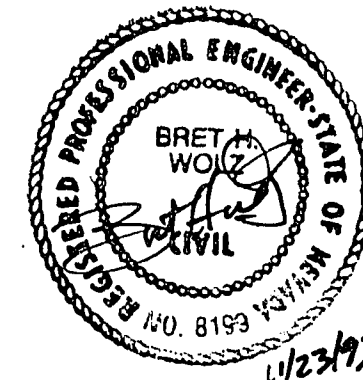


LAS VEGAS FIRE DEPARTMENT

FIRE FLOW REQUIREMENT IS 3000 GALLONS PER MINUTE
AT 20 POUNDS PER SQUARE INCH RESIDUAL.

BASED ON:

SQUARE FOOTAGE SEE PLAN
LARGEST AREA BETWEEN
AREA SEPARATION WALLS 1 HOUR CONSTR.
HEIGHT
TYPE OF CONSTRUCTION WOOD
EXPOSURES
SPRINKLER SYSTEM RESTAURANT
ROOF CONSTRUCTION TRUSS
REVIEWED BY: Restaurant only RB
DATE: 11/17/92

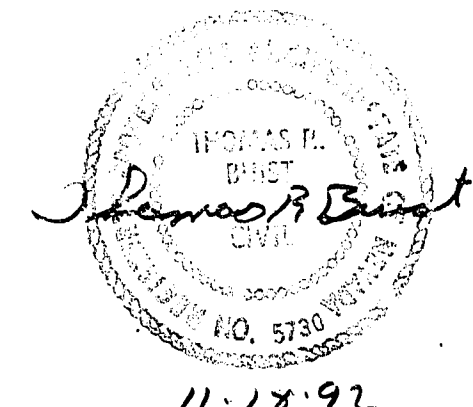

LAS VEGAS VALLEY WATER DISTRICT
DATE 11/23/92

ENGINEERING CORPORATION
CONSULTING ENGINEERS AND SURVEYORS
115 EAST RENO AVENUE, SUITE 42, LAS VEGAS, NEVADA 89101
PHONE: (702) 738-1801 FAX: (702) 738-0622

DESIGNED BY: BRU
DRAWN BY: ACAD
CHECKED BY:
DATE: 10/01/92

" TIERRA DE FLORES "
WATER PLAN
CITY OF LAS VEGAS, CLARK COUNTY AREA, NEVADA

REV.	DATE	DESCRIPTION	BY	APP'D
1	2/1/93	RELOCATE FIRE HYDRANT / PROVIDE 4"x4" EASEMENT FOR CITY OF LAS VEGAS	RAC	BRET H. WOLZ, P.E.
2	11/23/93	REVISED ENTRANCE, ADDED HANDICAP RAMP	K.C.A.	B.H.W.

SCALE: 1"=40'
HORIZ.
VERT.
JOB NO. 70369

SHEET 4 OF 7